




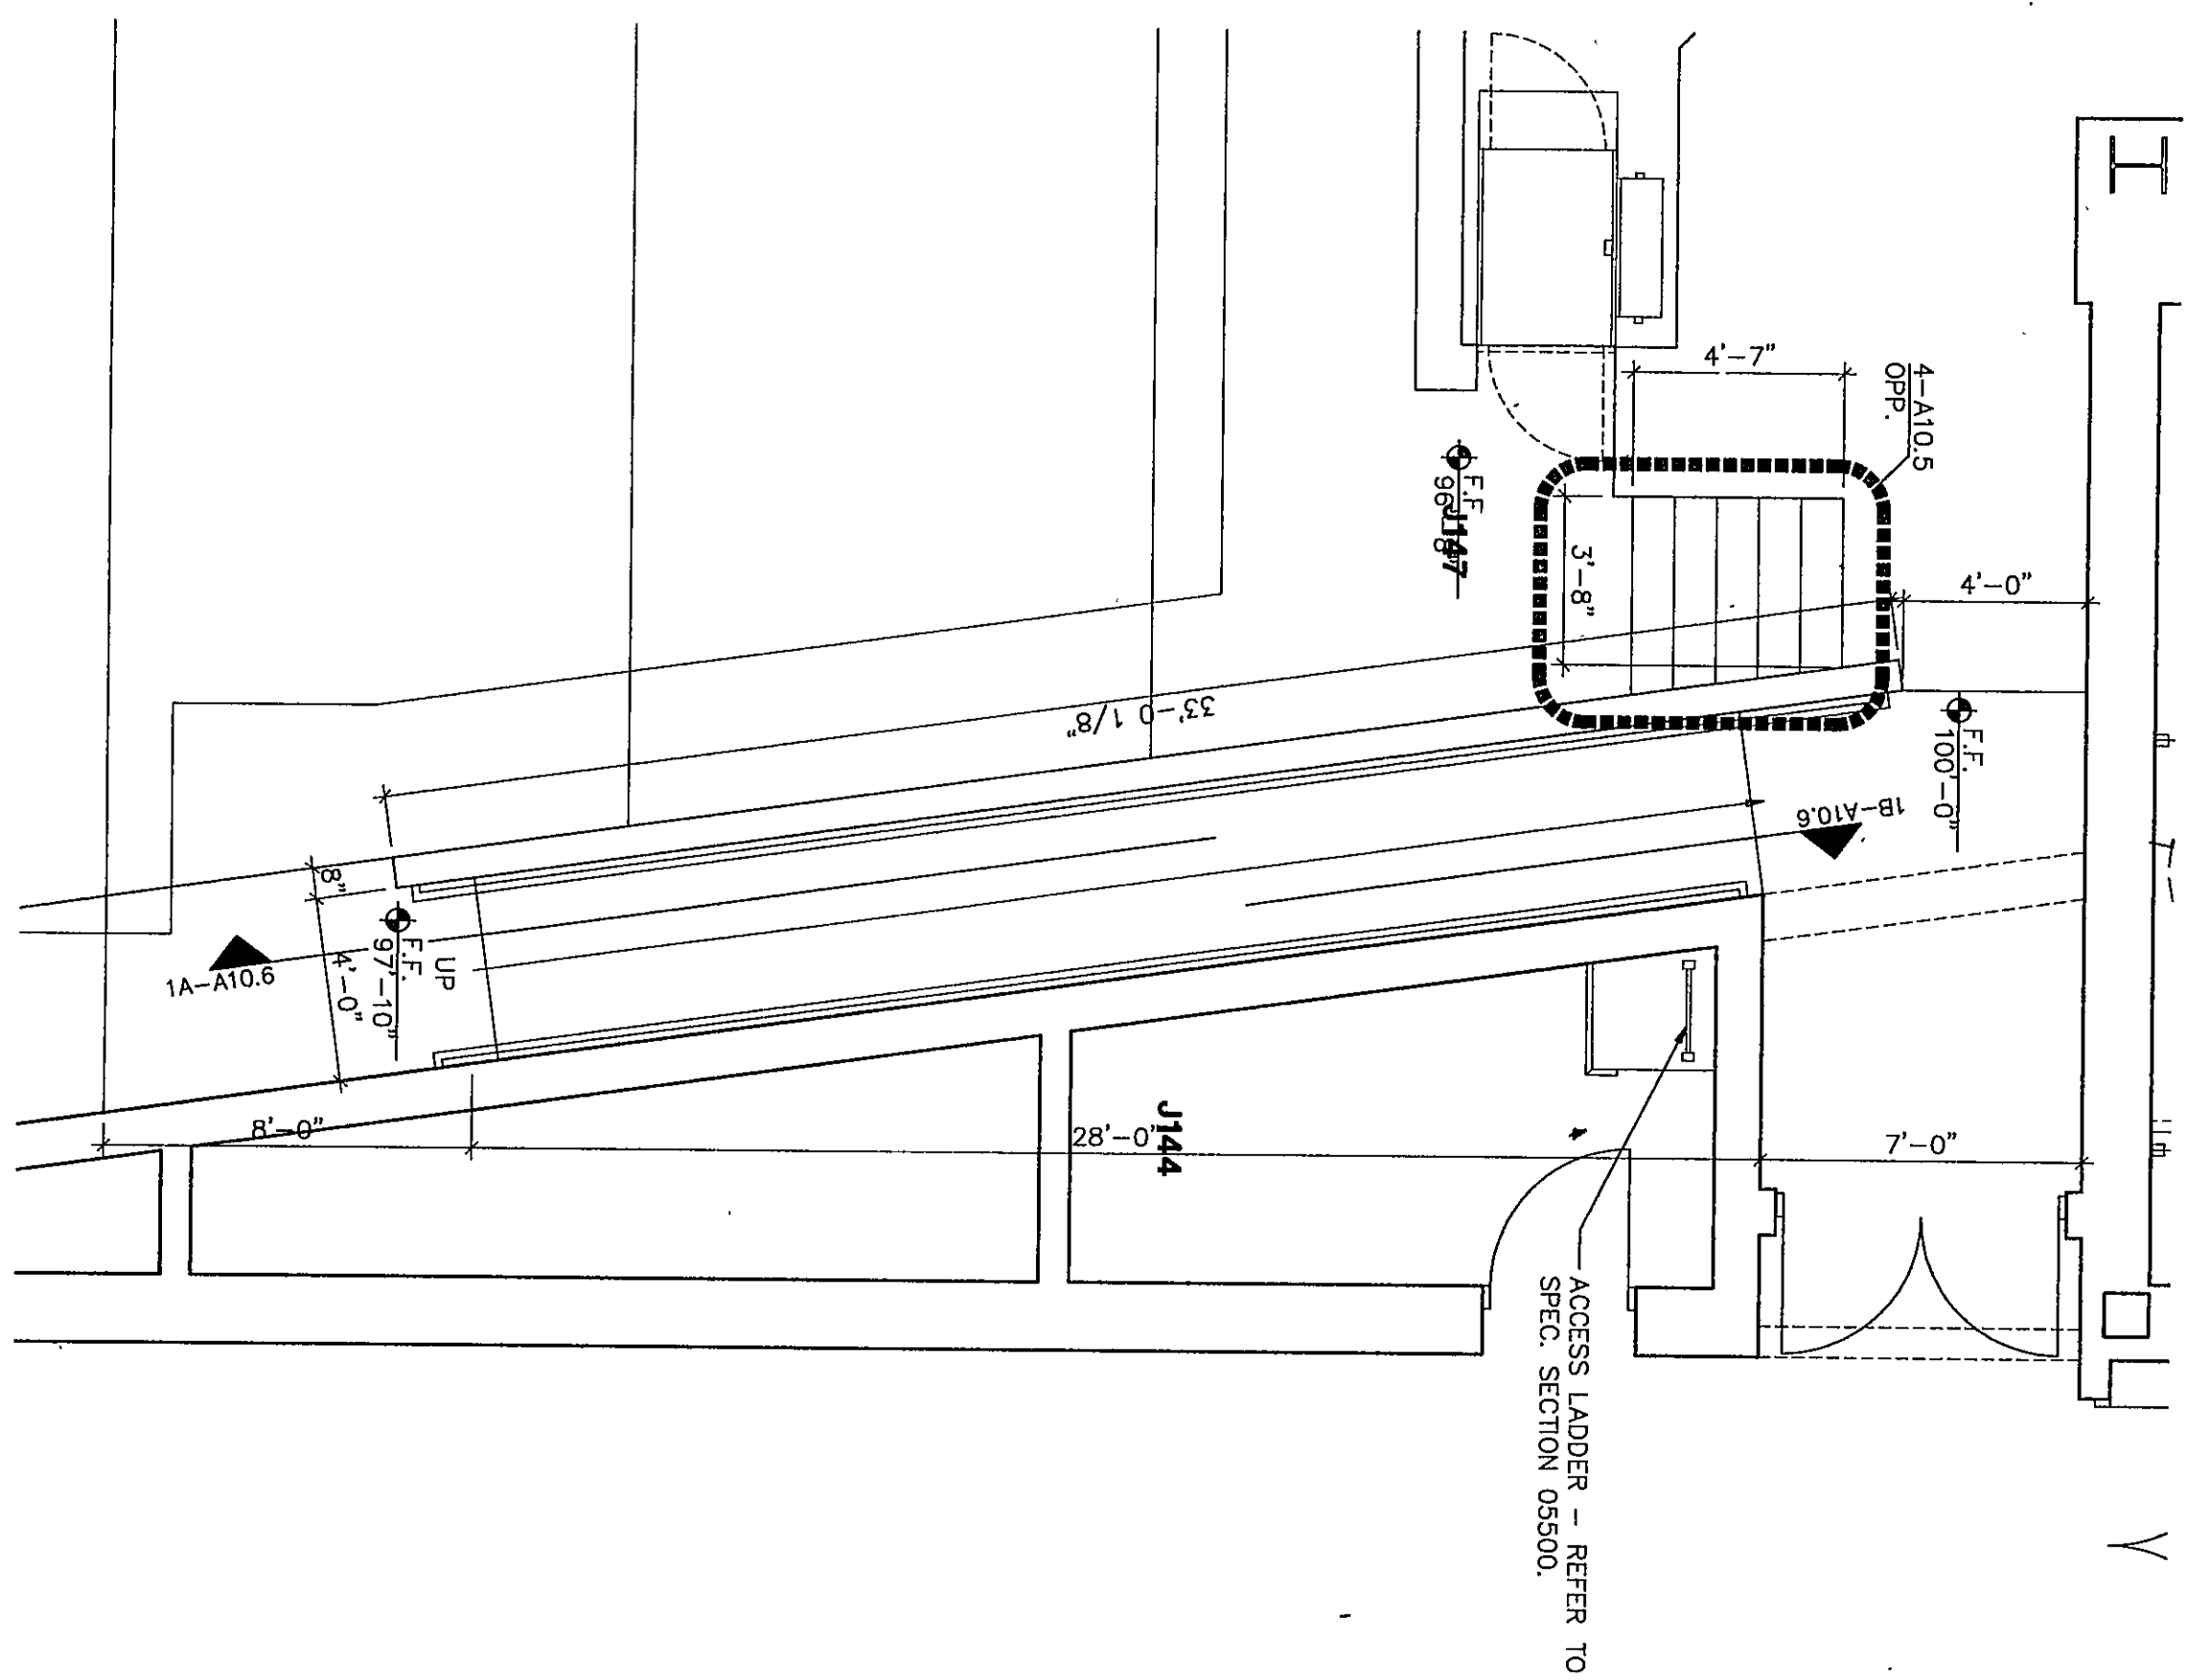


1
RAMP PLAN - UNIT "J"
1/4" = 1'-0"

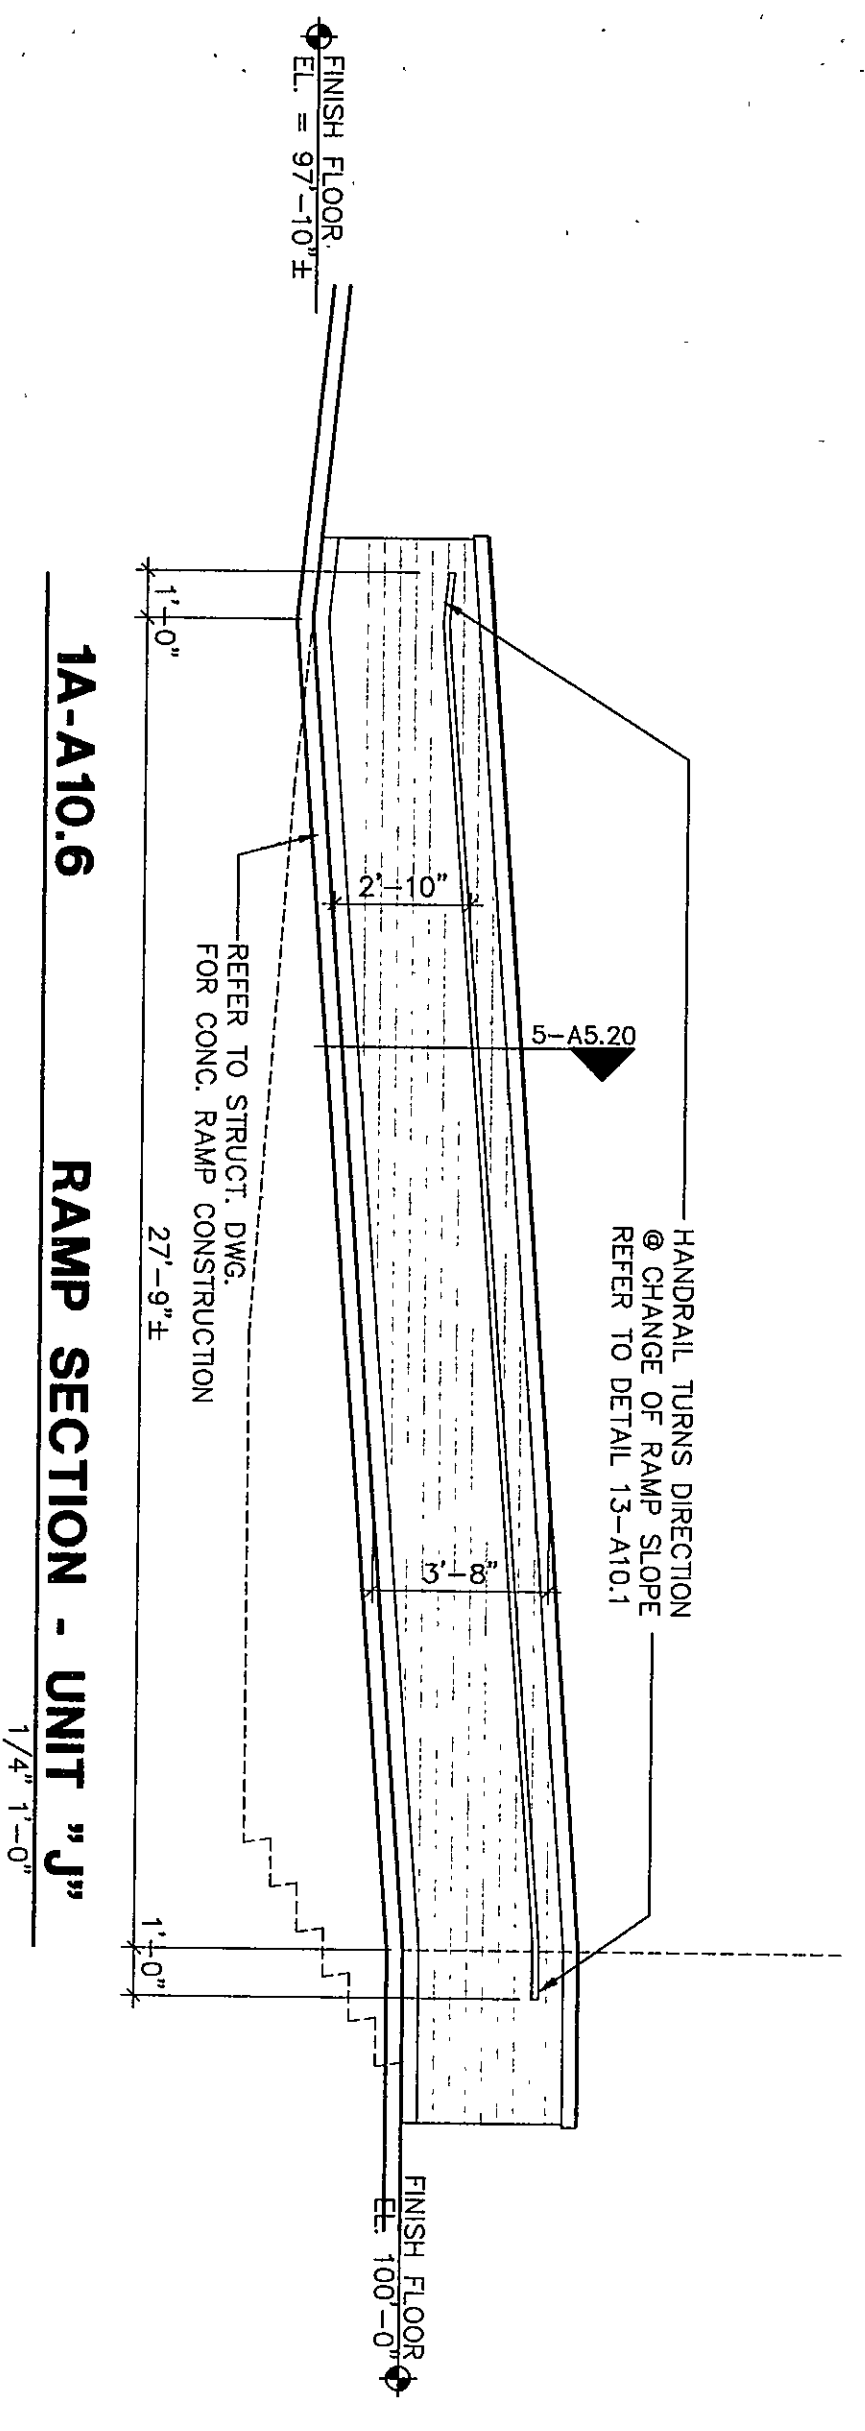


1A-A10.6
RAMP SECTION - UNIT "J"
1/4" = 1'-0"

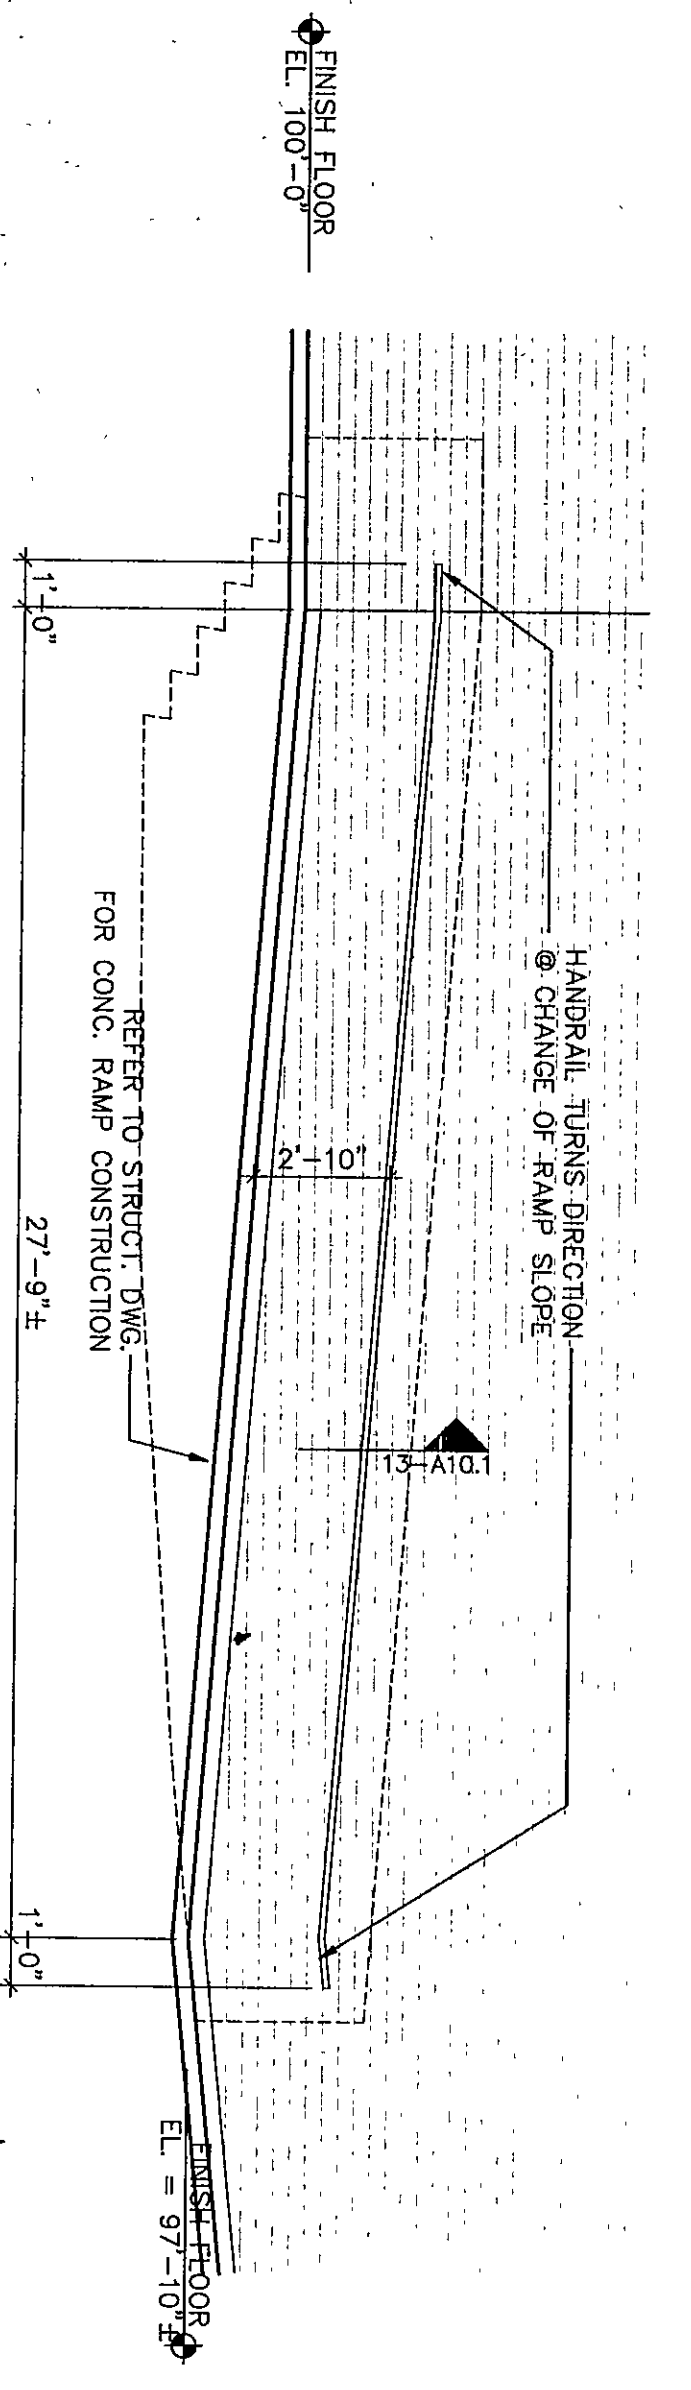


1B-A10.6
RAMP SECTION - UNIT "J"
1/4" = 1'-0"

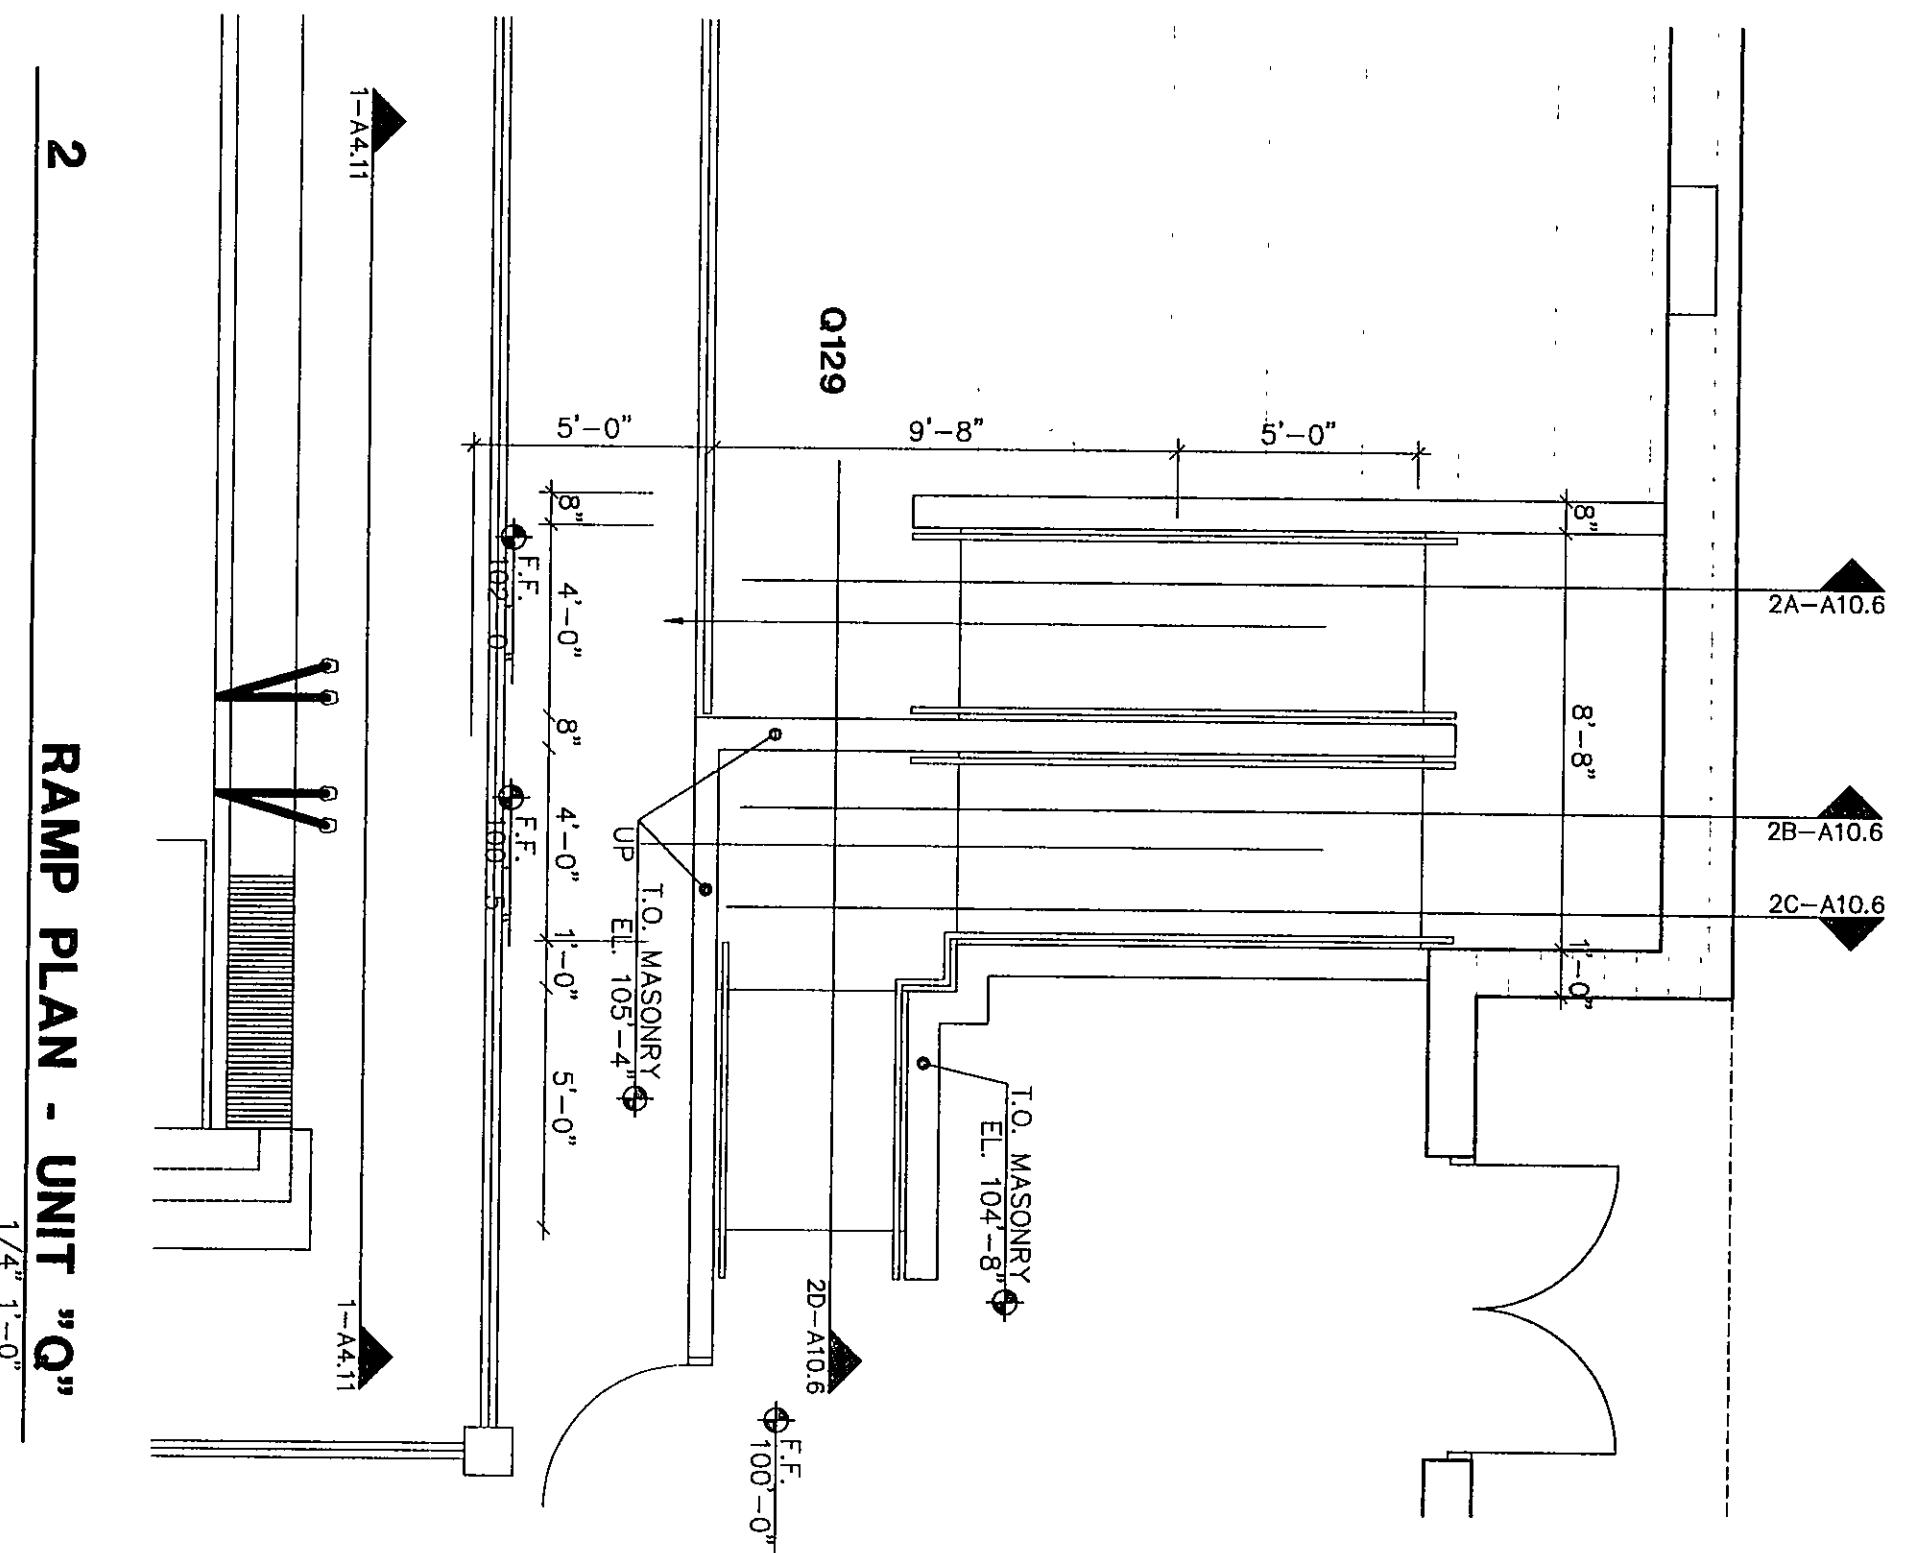


2
RAMP PLAN - UNIT "Q"
1/4" = 1'-0"

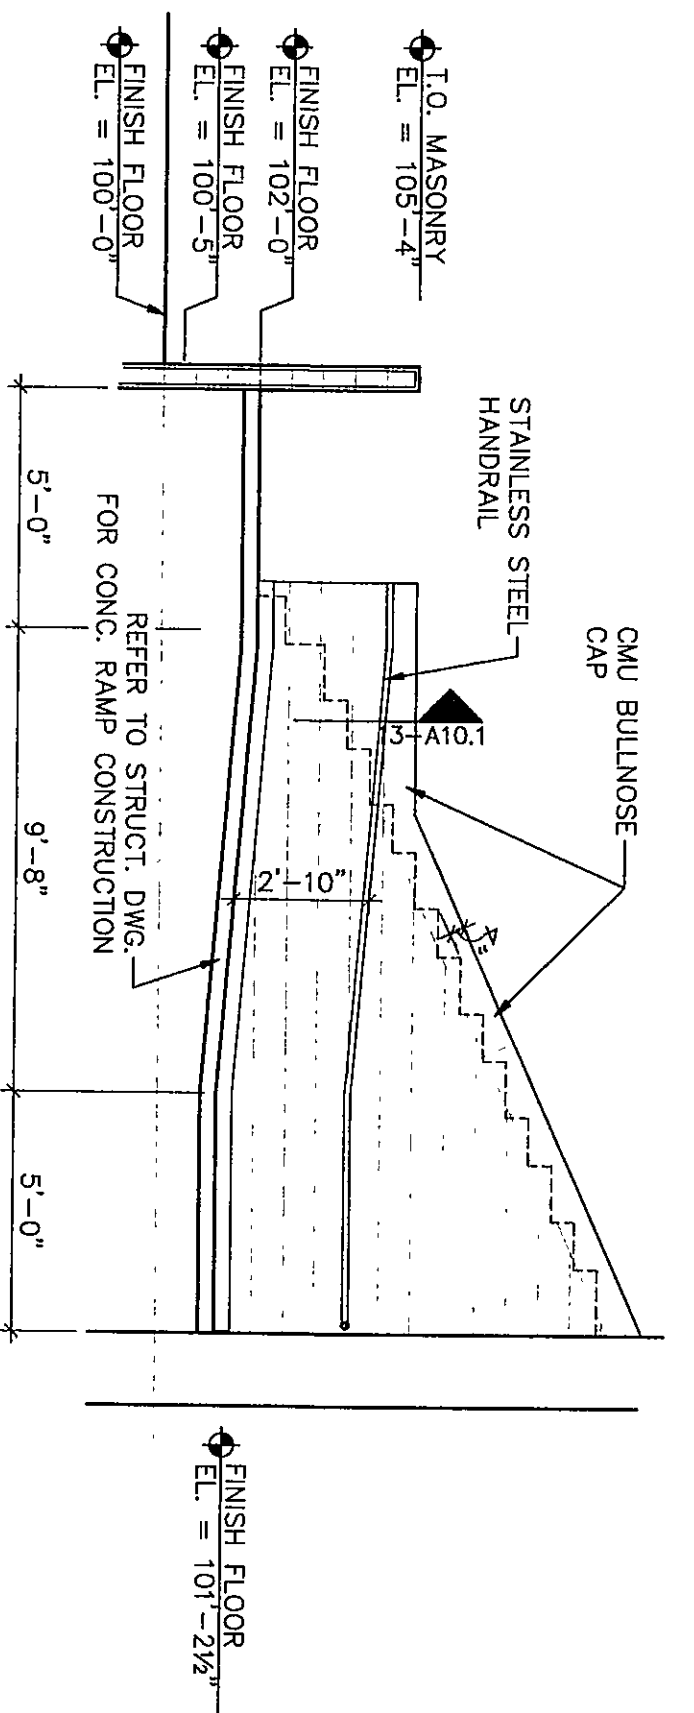


2A
RAMP SECTION - UNIT "Q"
1/4" = 1'-0"

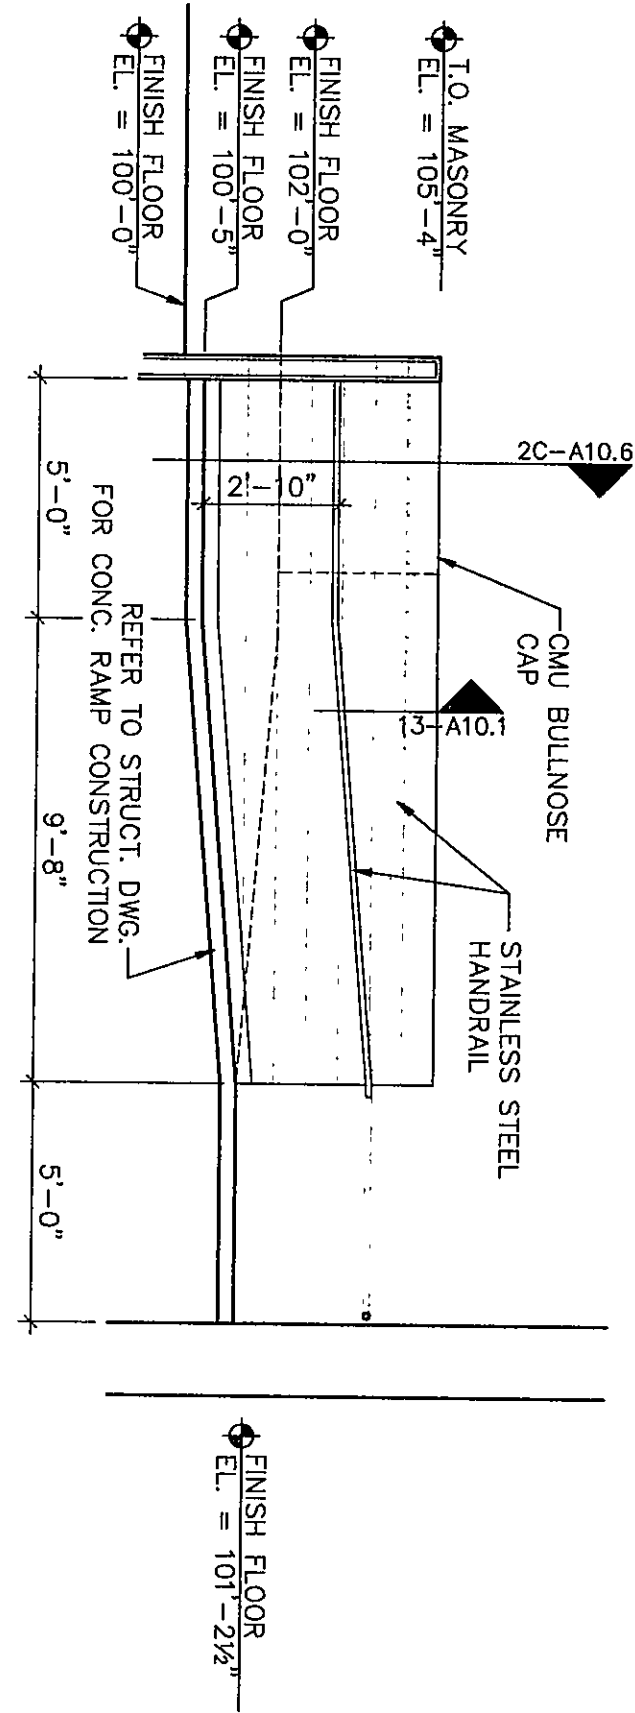


2B
RAMP SECTION - UNIT "Q"
1/4" = 1'-0"

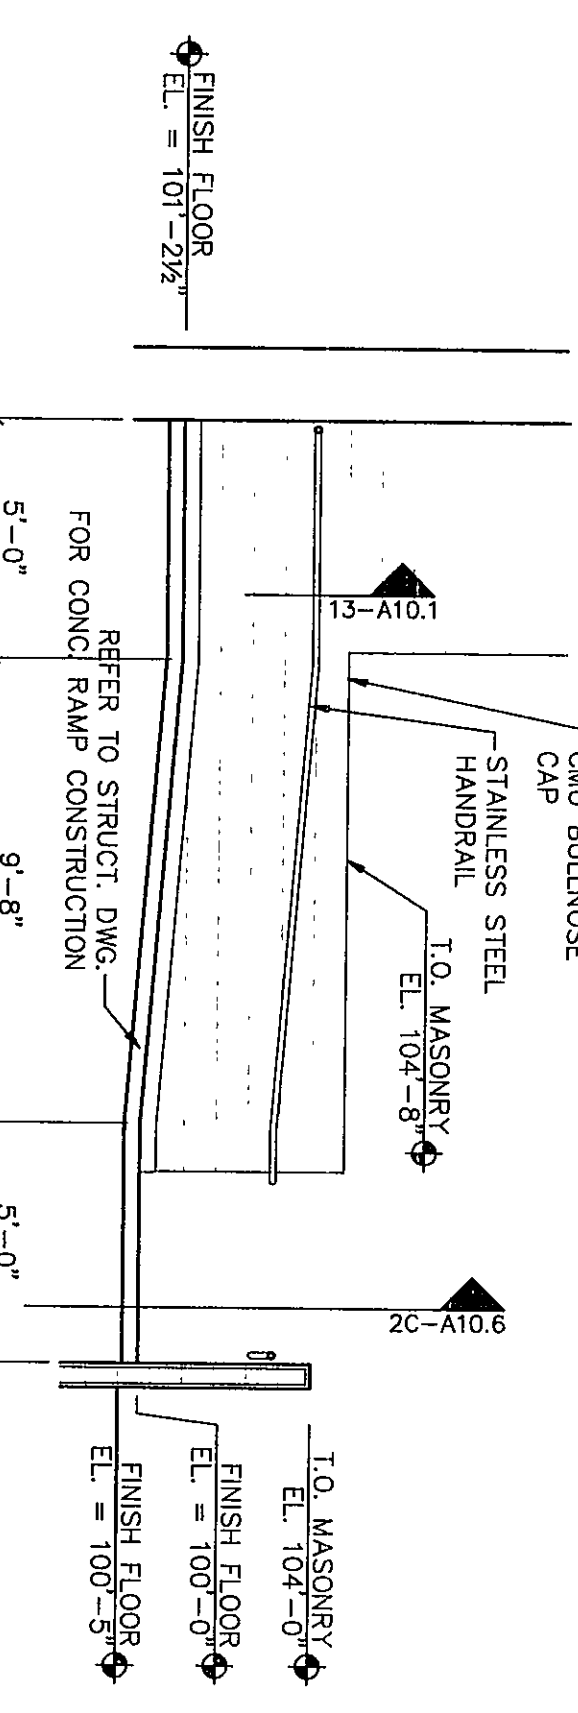


2C
RAMP SECTION - UNIT "Q"
1/4" = 1'-0"

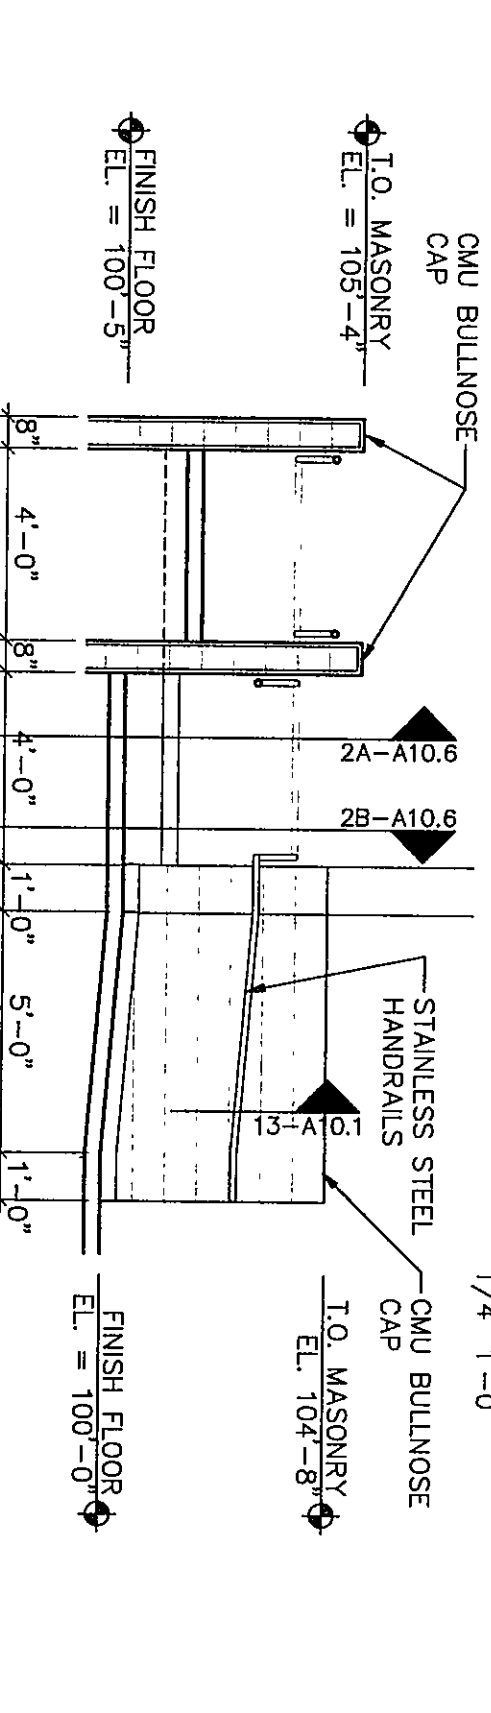


2D
RAMP SECTION - UNIT "Q"
1/4" = 1'-0"

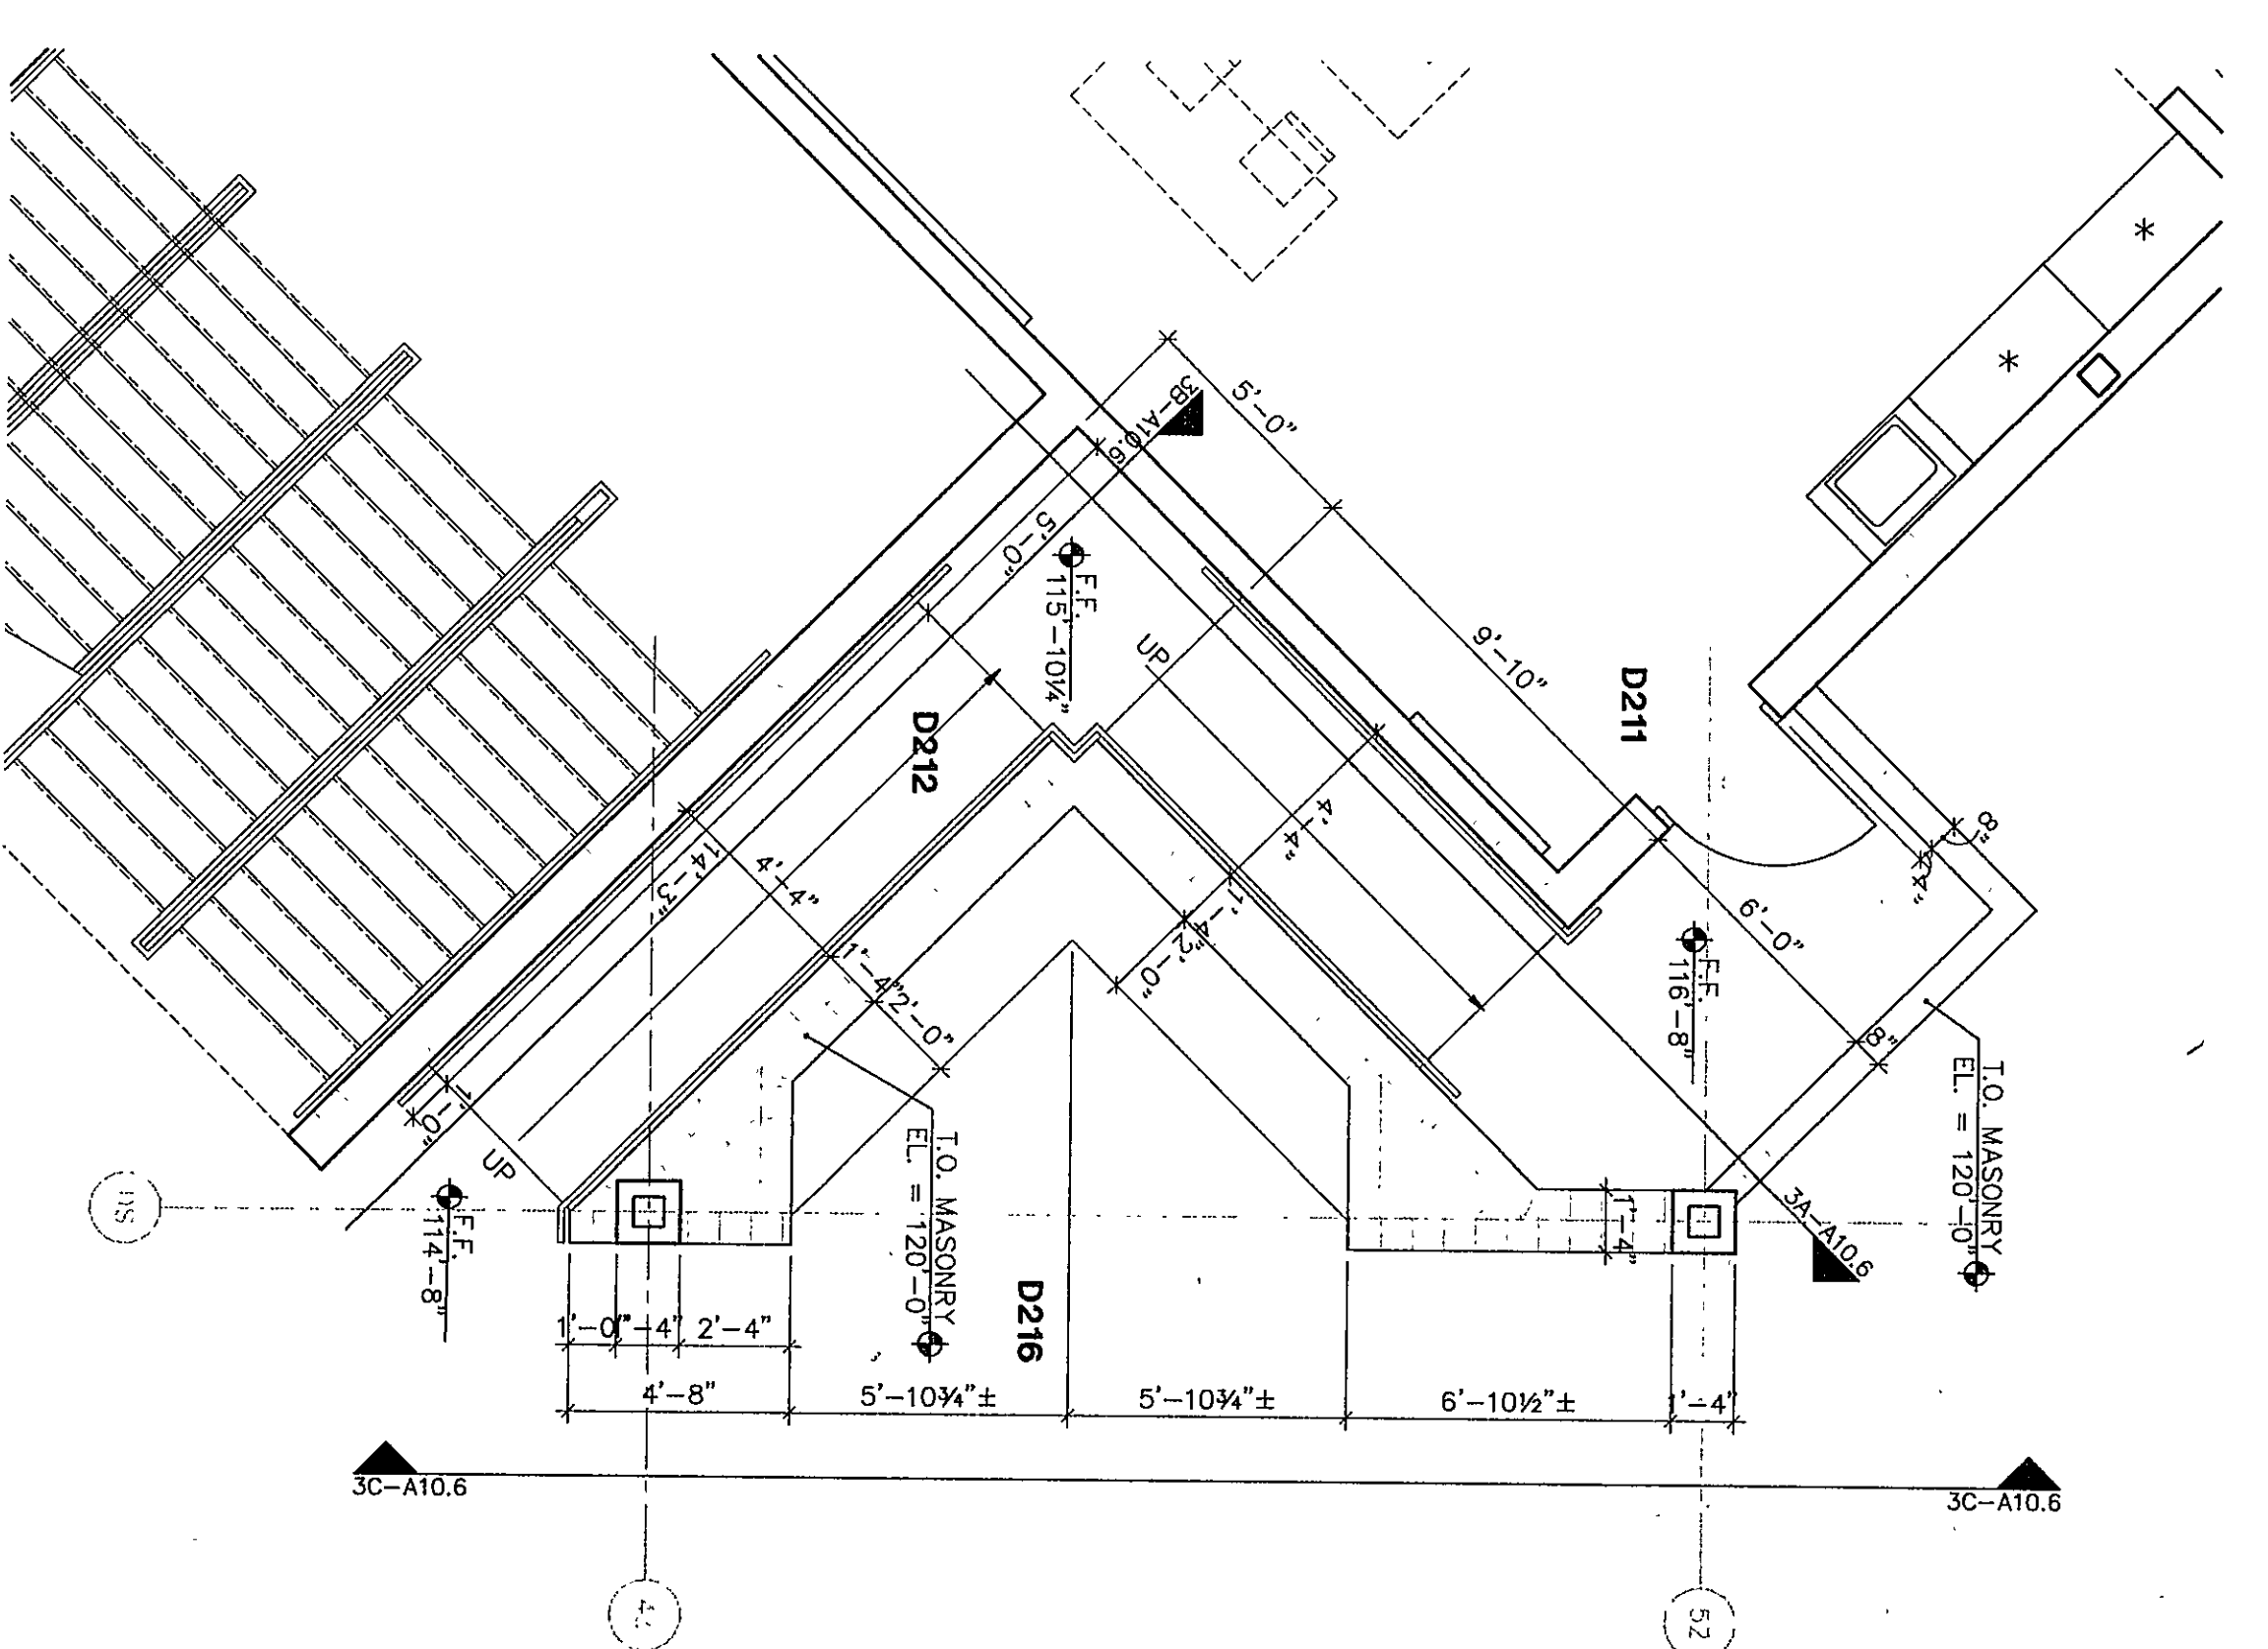


3
RAMP PLAN - UNIT "D2"
1/4" = 1'-0"

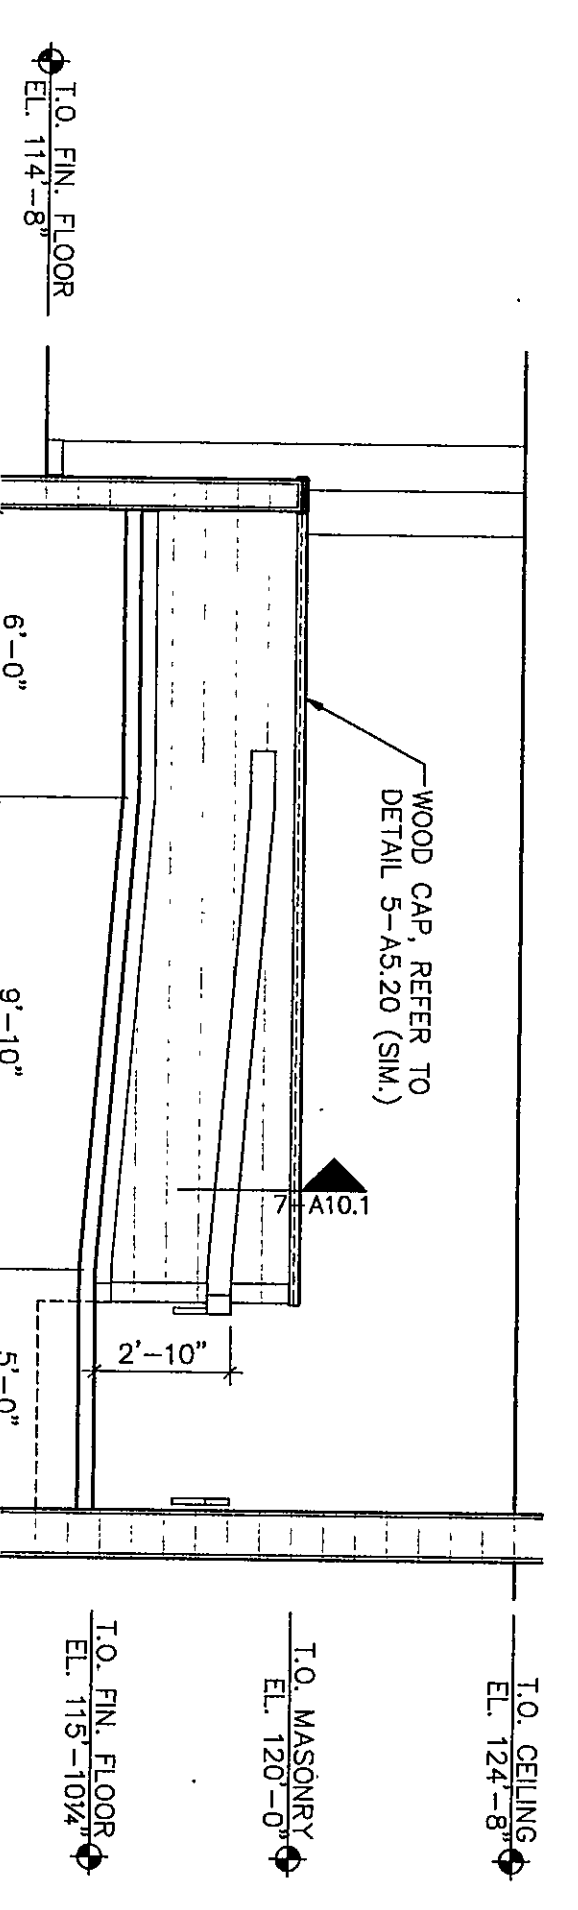


3A
RAMP SECTION - UNIT "D2"
1/4" = 1'-0"

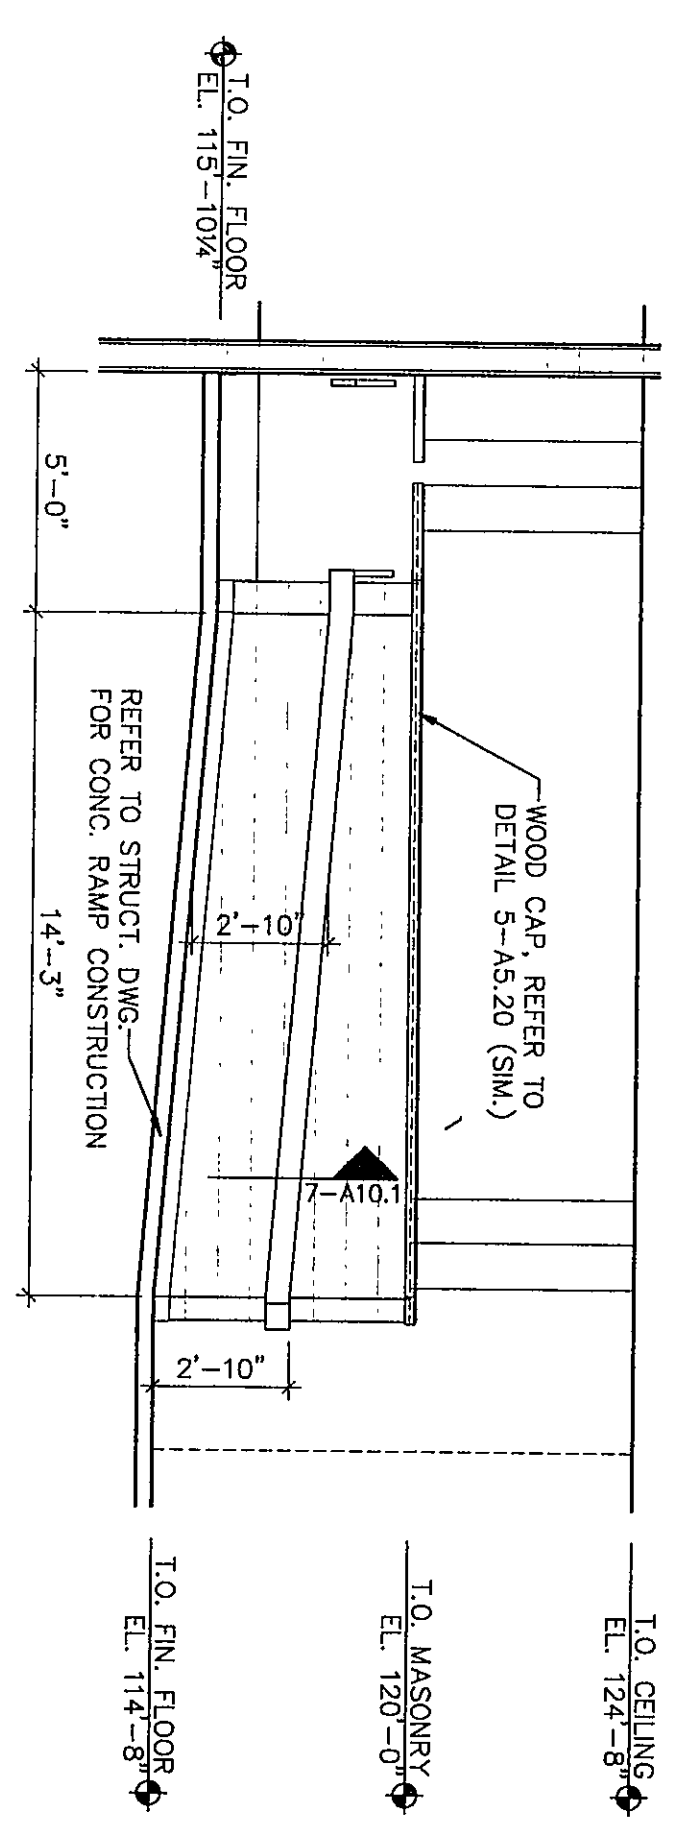

3B
RAMP SECTION - UNIT "D2"
1/4" = 1'-0"

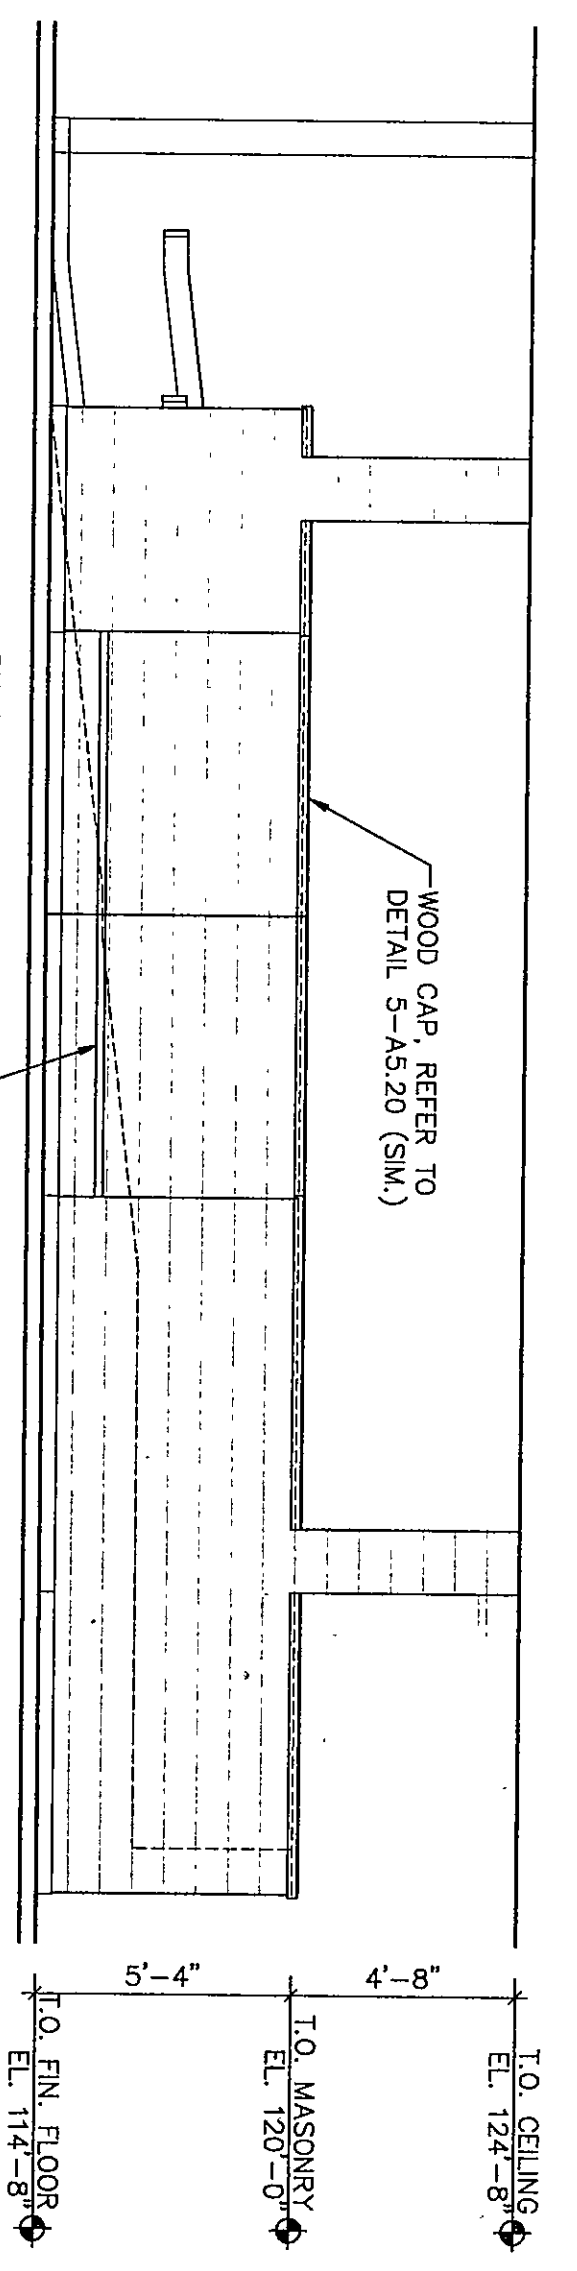

3C
RAMP WALL ELEVATION - UNIT "D2"
1/4" = 1'-0"

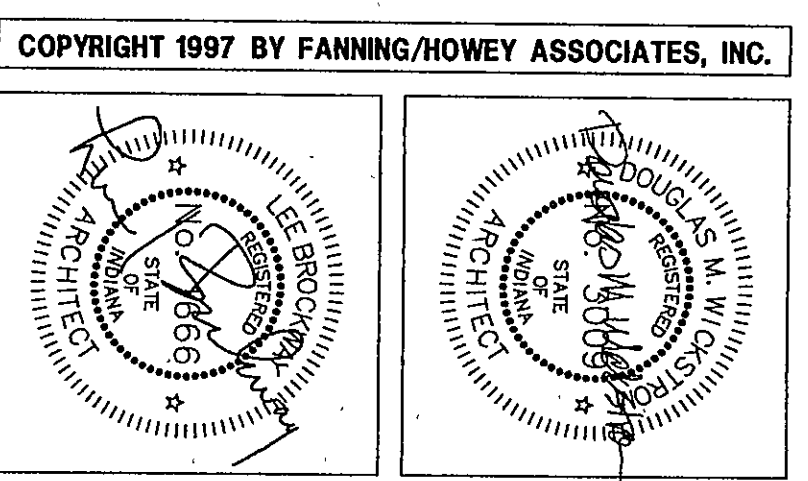

THE NEW
CHESTERTON HIGH SCHOOL
FOR THE
DUNELAND SCHOOL CORPORATION
CHESTERTON, INDIANA

STAIR DETAIL
 DRAWN BY: TCB, HAS
 CHECKED BY: JHJ
A10.6

COMM. NO.: 95067.00
 DATE: APRIL 21, 1997
 REVISIONS NO. DATE

Fanning/Howey Associates, Inc.
Architects Engineers Consultants

CHESTERTON HIGH SCHOOL
95067.00