


ROOM NO.	ROOM NAME	AREA S.F.	CEILING HEIGHT
J101	PRECISION STORAGE	556	9'-4"
J102	WORKROOM	430	9'-4"
J103	PRACTICE ROOM	63	9'-4"
J104	INSTRUMENT II	2089	9'-4"
J105	OFFICE	643	10'-0"
J106	OFFICE	213	9'-4"
J107	OFFICE	160	9'-4"
J108	BOYS TOILET	160	9'-4"
J109	BOYS TOILET	160	9'-4"
NOTE:
REFER TO DRAWING A1-18 FOR
FLOOR PLAN AND KEY NOTES.

FLOOR PLAN UNIT J1

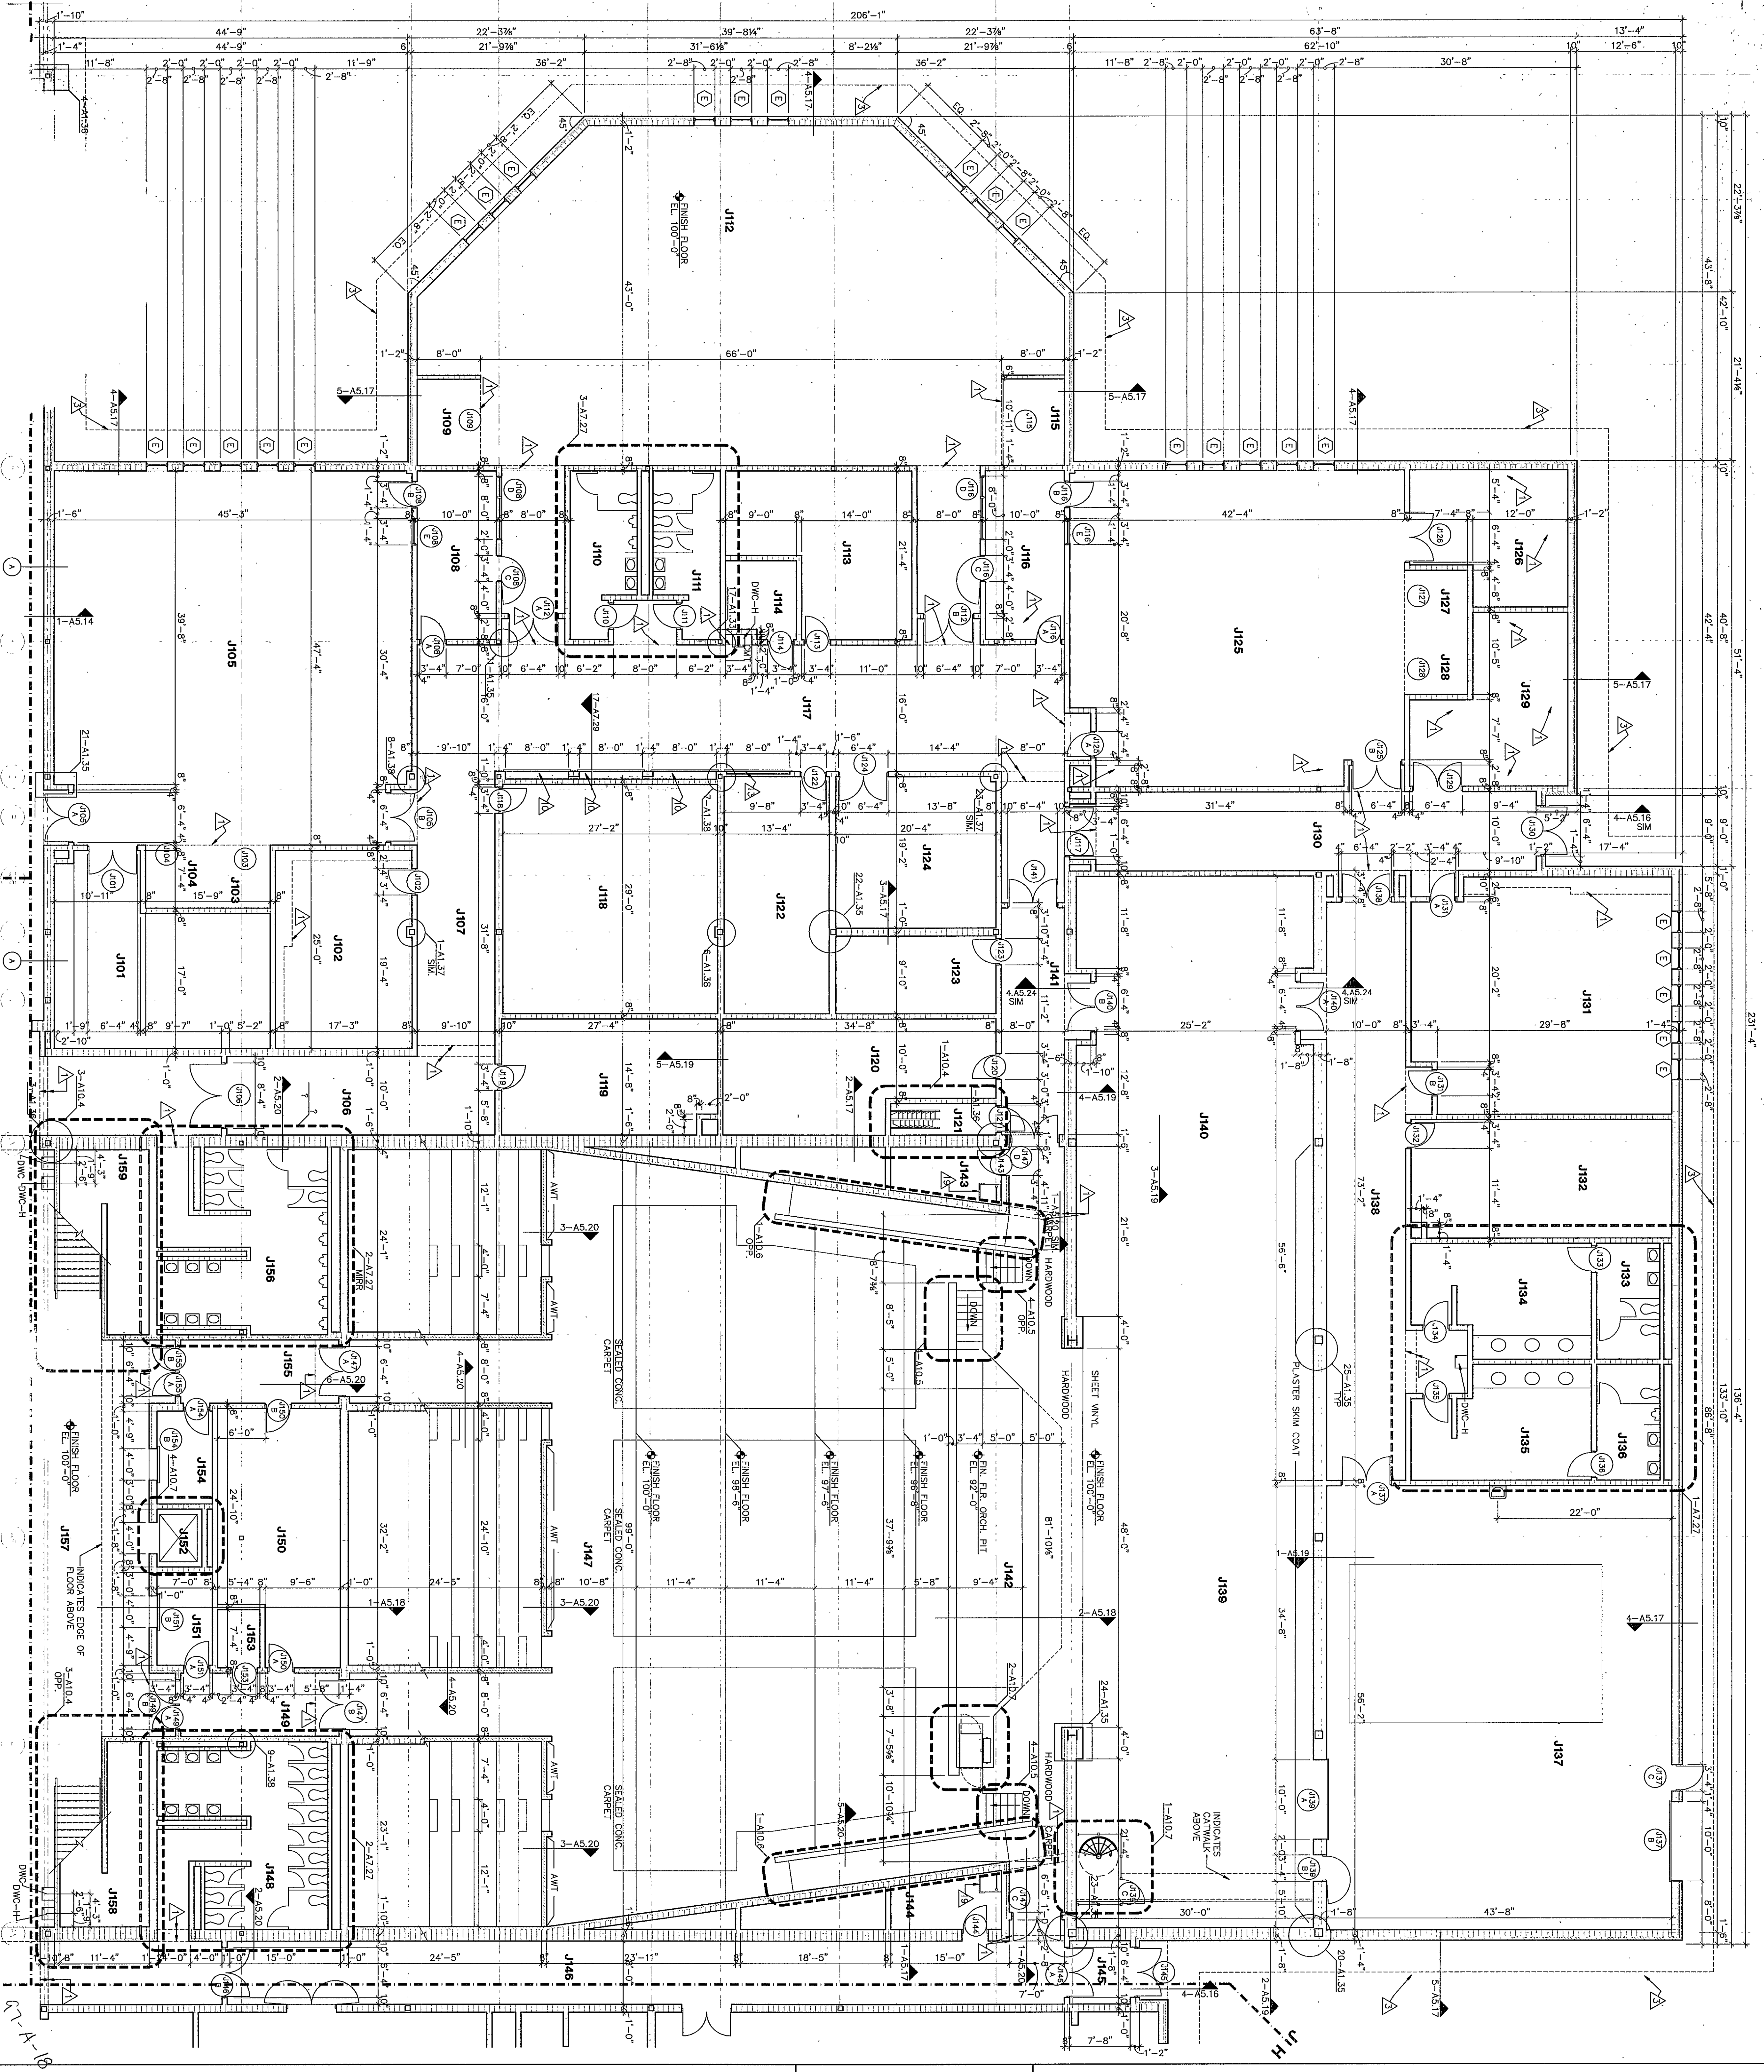

FLOOR PLAN UNIT J1

DRAWN BY: LEC/JCD COMM. NO.: 95067.00
 CHECKED BY: JHJ DATE: APRIL 21, 1997

A1.16

REVISIONS NO. DATE

Fanning/Howey Associates, Inc.
 Architects Engineers Consultants

THE NEW
CHESTERTON HIGH SCHOOL
 FOR THE
 DUNELAND SCHOOL CORPORATION
 CHESTERTON, INDIANA

Copyright 1997 by Fanning/Howey Associates, Inc.