SEE DRAWING FP-3 FOR GENERAL FIRE PROTECTION NOTES

SEE DRAWINGS FP-23 THRU FP-25 FOR BUILDING SECTIONS

SEE DRAWING FP-26 FOR FIRE PUMP LAYOUT

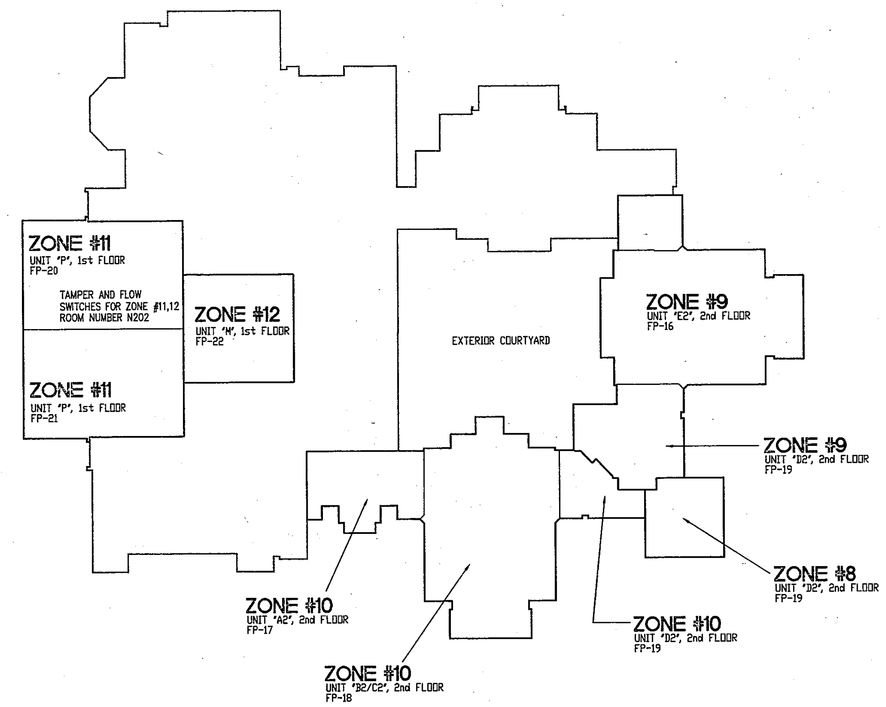

2nd FLOOR PLAN LAYOUT

SCALE 1"=100'-0"

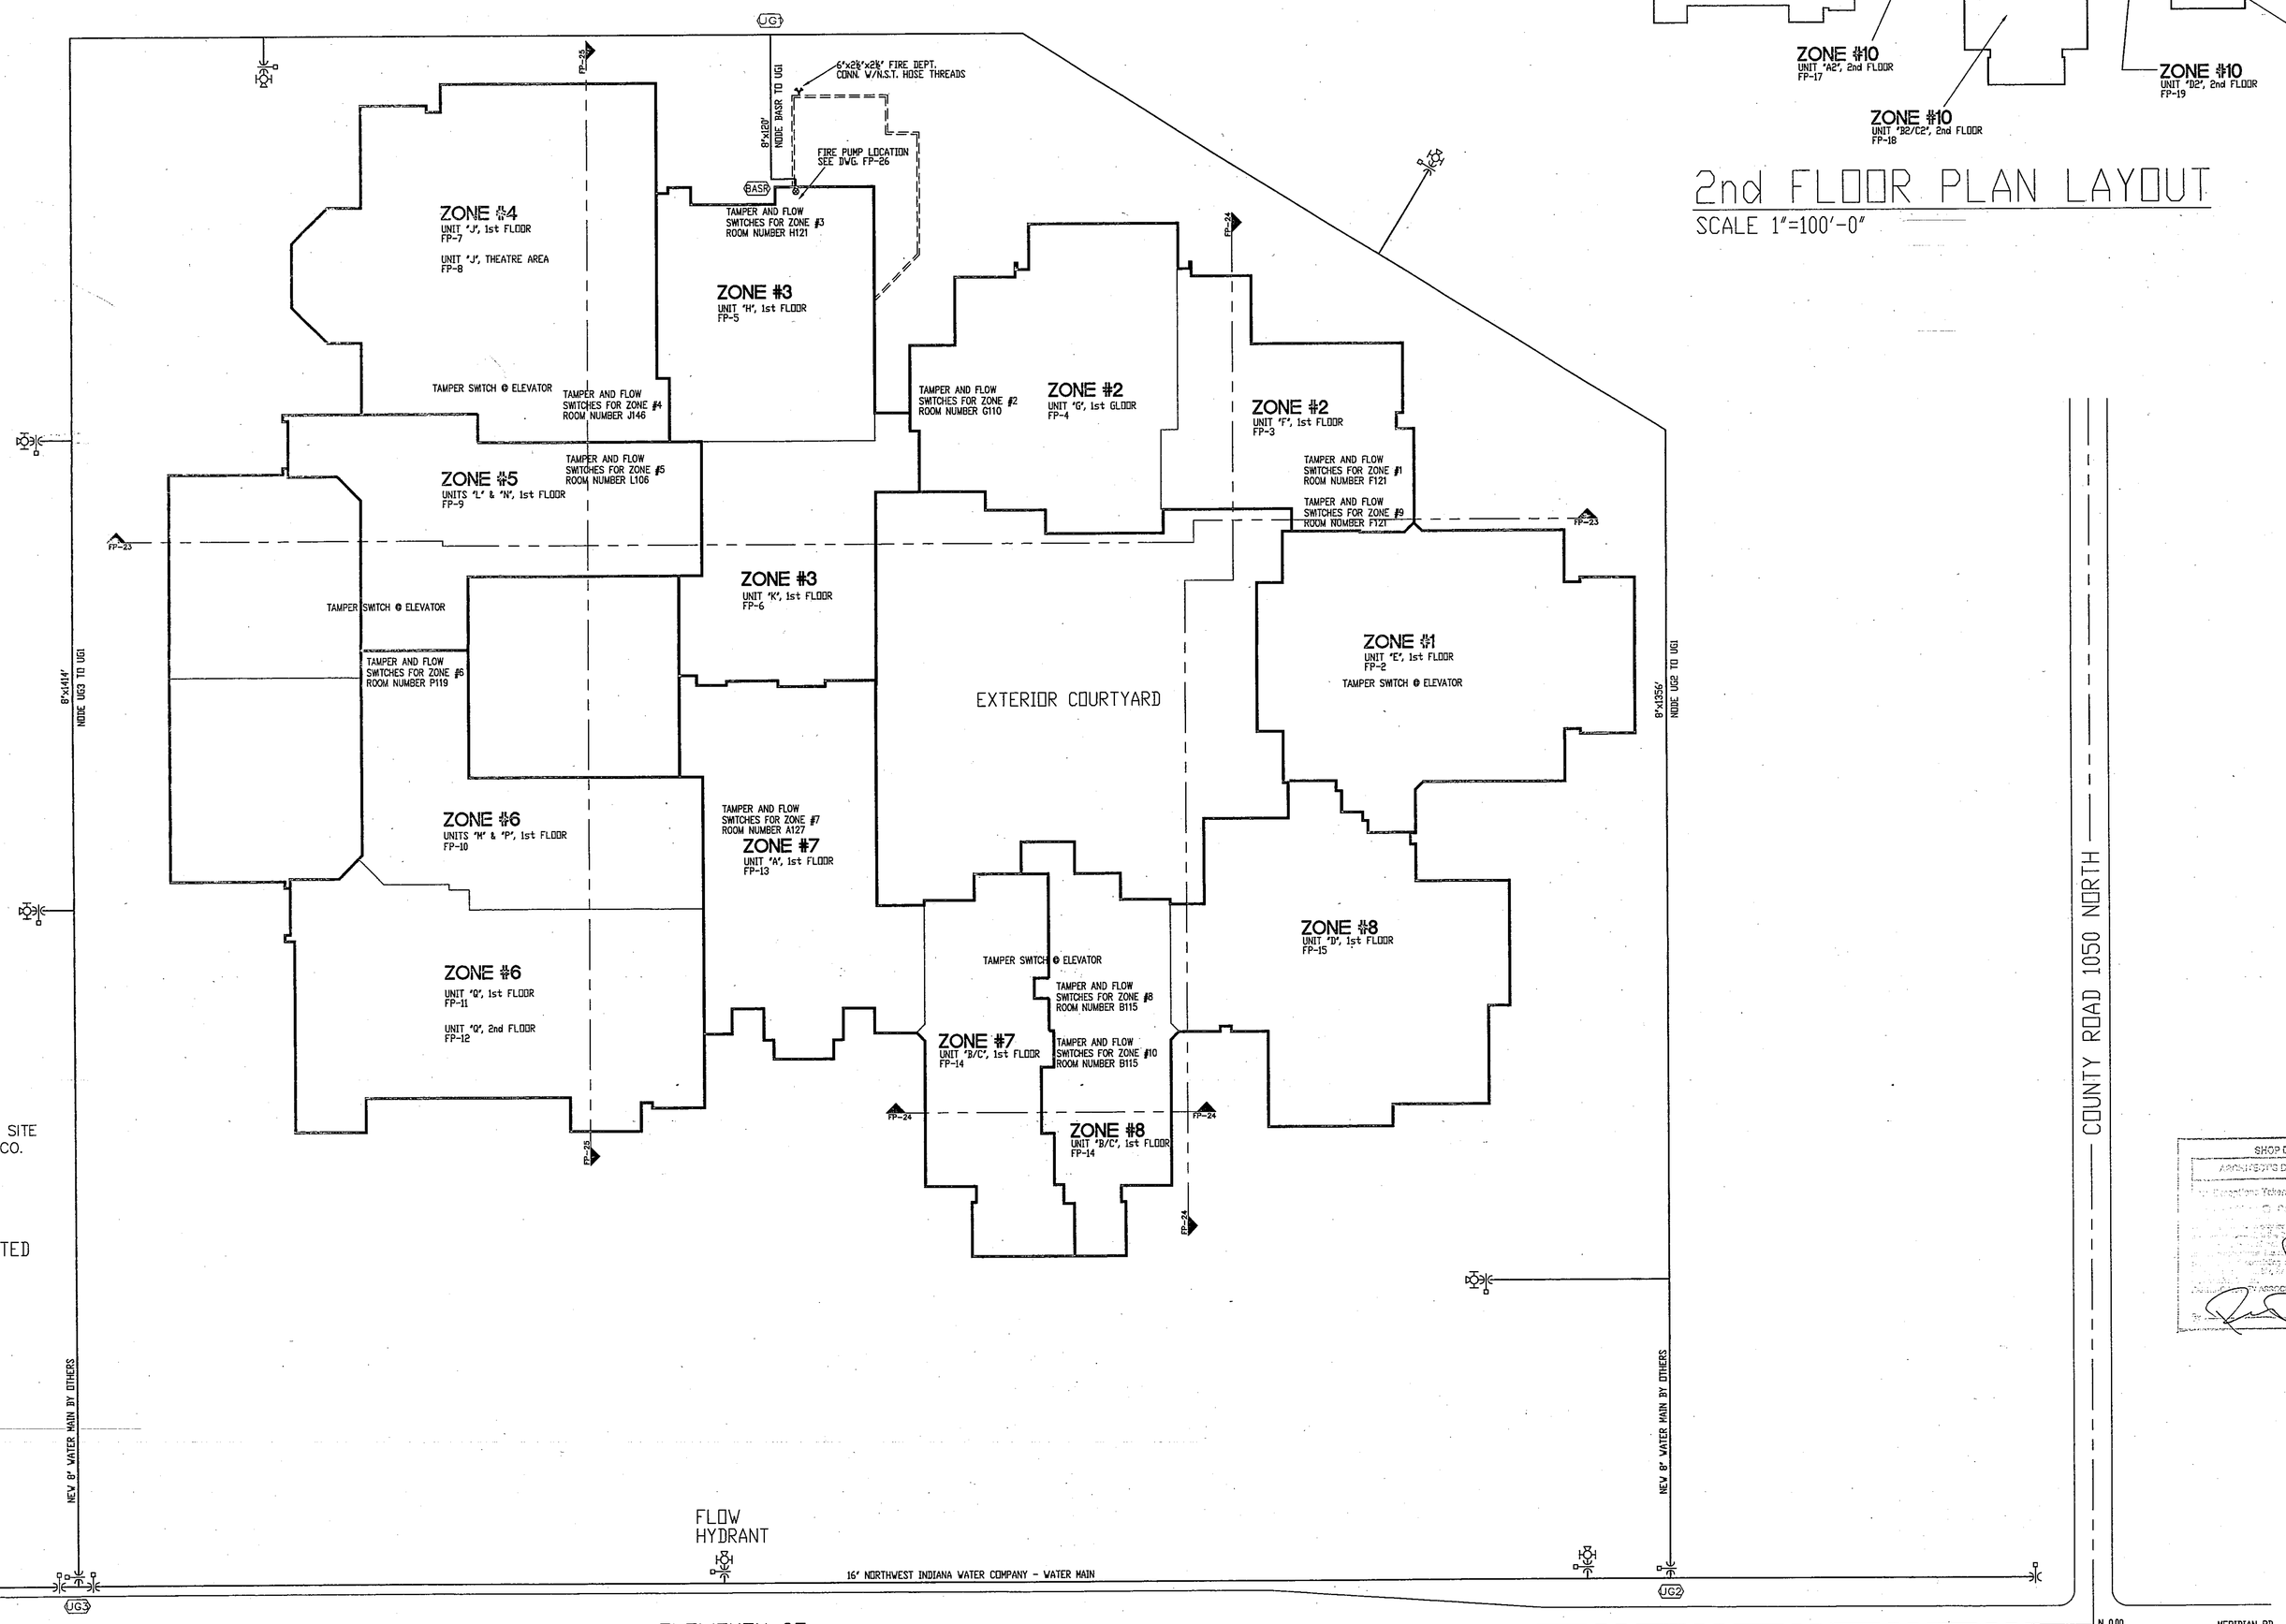

WATER FLOW INFO

DATE & TIME: ESTIMATED
WHERE: 16" CITY WATER MAIN ADAJACENT TO SITE
BY: EST. BY NORTHWEST INDIANA WATER CO.
STATIC: 53 PSI
RESIDUAL: 24 PSI
FLOWING: 2200 GPM

THE FLOW TEST DATA WAS PROVIDED ON CONTRACT DRAWING FP.1, AND WAS ESTIMATED BY NORTHWEST INDIANA WATER CO.

1st FLOOR PLAN LAYOUT

SCALE 1"=50'-0"

SHOP DRAWING/SUBMITTAL REVIEW STATUS

ARCHITECT'S DETERMINATION	RESPONSE REQUIRED
Approved as Noted ☐ Rejected ☐	Confirm ☐
☐ Resubmit Attached ☐	Resubmit ☐

REVIEWED

ARCHITECT/ENGINEER

Date 3/13/02

THIS SHEET FOR REFERENCE ONLY
WORK REPRESENTED ON THIS DRAWING IS BY OTHERS, AND IS SHOWN FOR INFORMATION PURPOSES ONLY.

ALL UNDERGROUND FIRE PROTECTION WORK IS BY OTHERS. THIS DRAWING IS FOR HYDRAULIC AND INSIDE REFERENCE ONLY.

S&S
FIRE PROTECTION DIVISION
SHAMBAUGH & SON, INC.
CONTRACTORS - ENGINEERS
7614 OPPORTUNITY DRIVE, FORT WAYNE INDIANA 46825
PHONE (219) 407-7777 FAX 407-7788

YEARS OF EXCELLENCE 70

PROJECT NAME:
Chesterton High School
2125 South Eleventh St.
Chesterton, IN 46304

NO.	DATE	REVISION	BY
6	-	-	-
5	-	-	-
4	-	-	-
3	-	-	-
2	-	-	-
1	051800	RECORD DRAWING	AZ

FIRE PROTECTION:
FIRE PROTECTION SITE PLAN
--

DRAWN BY: Alan Zimmerman
CHECKED BY:
SCALE: 1"=50'-0"
DATE: 10-1-97
SPKRS. THIS SHEET:
TOTAL SPKRS. THIS JOB:
STATE PROJECT NUMBER: 240902
APPROVAL AGENCIES: ISFM, LOCAL FM, ARCHITECT
JOB NO. 231893
SHEET NO FP-1

CAD DWG 231893-1DWG

97-FP-01