

1 1000 1500 2000 19

6	10/25/98	RECORD	BRAVING	AZ
5	07/26/98	LIST	FIELD MEASURE	AZ
4	06/29/98	RECORD	DWG DUE TO RISK	AZ
3	04/05/98	AD	AND RELOCATION	AZ
2	03/05/98	AD	RELOCATION	AZ
1	01/26/98	SUBMIT	FOR APPROVAL	BY
NO.	DATE	REVISION		

FIRE PROTECTION
 ZONE #1
 UNIT N2
 FIRE PROTECTION

CHECKED BY
 M. A. Gordon

SCALE
 1/8"=1'-0"

DATE
 10-1-97


SHEET NO. 1 OF 1
 TOTAL SHEETS 100

PROJECT NUMBER
 240902

APPROVALS: ARCHITECT
 S.W. LOCAL P.W. ARCHITECT

DRAWING NO. 231893

SHEET NO. FP-20

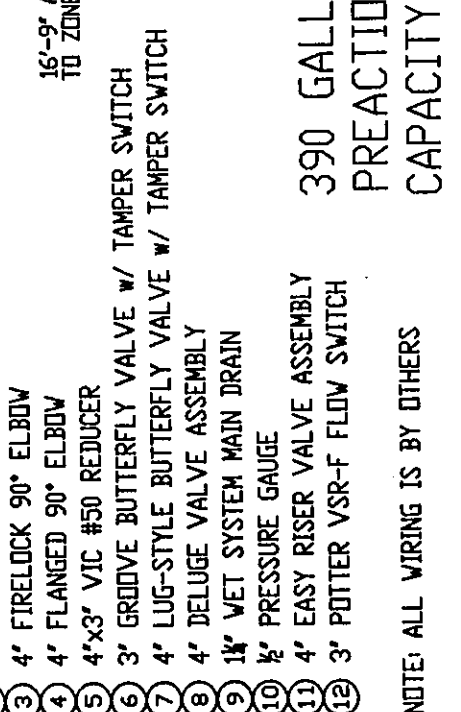

ROOM NO.	ROOM NAME	AREA S.F.	CEILING HEIGHT
N121	FIELDHOUSE	15052	---
N113	STAIR	74	10'-8"
N201	STAIR	579	10'-8"
N202	MECHANICAL ROOM	2866	---
N203	ELEVATOR EQUIPMENT	37	---
N205	BALCONY COURT	4681	---

