




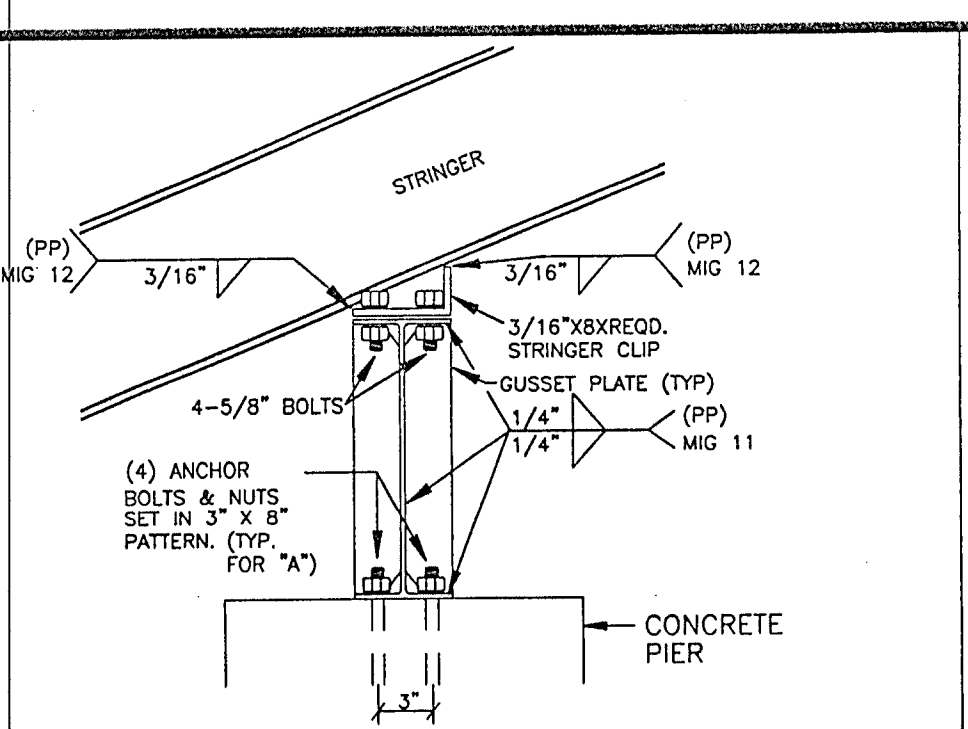


1 ROW "A" BEAM DETAIL
6/6 SCALE: NONE

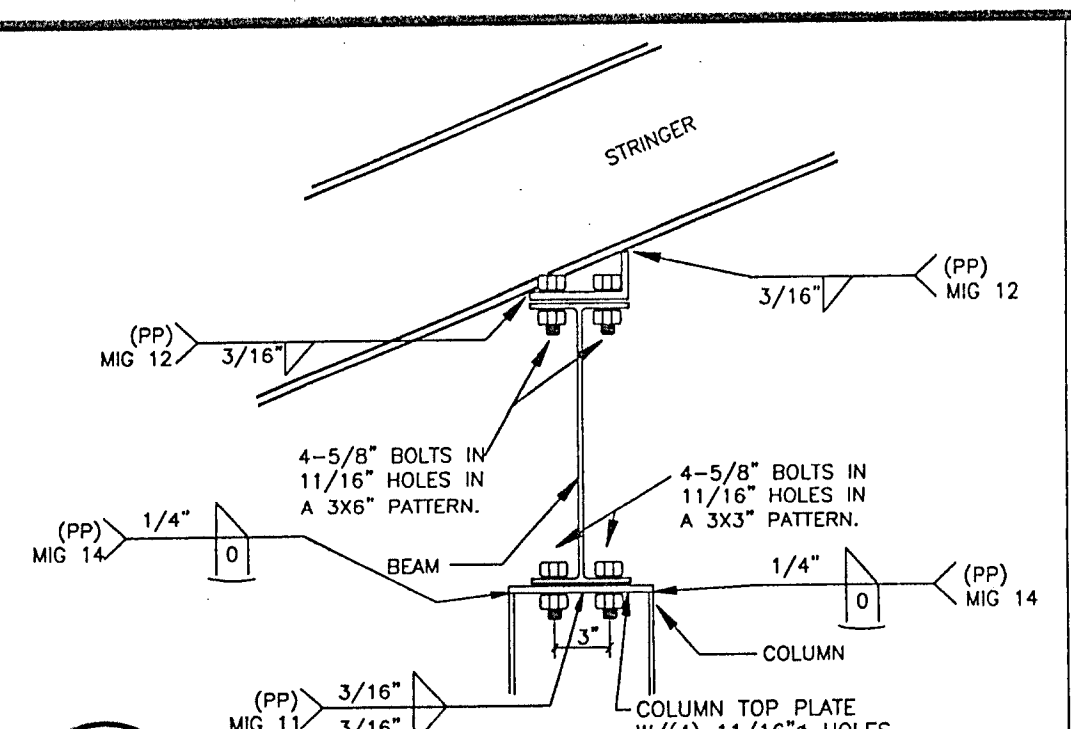


2 TYPICAL BEAM TO COLUMN DETAIL
6/6 SCALE: NONE

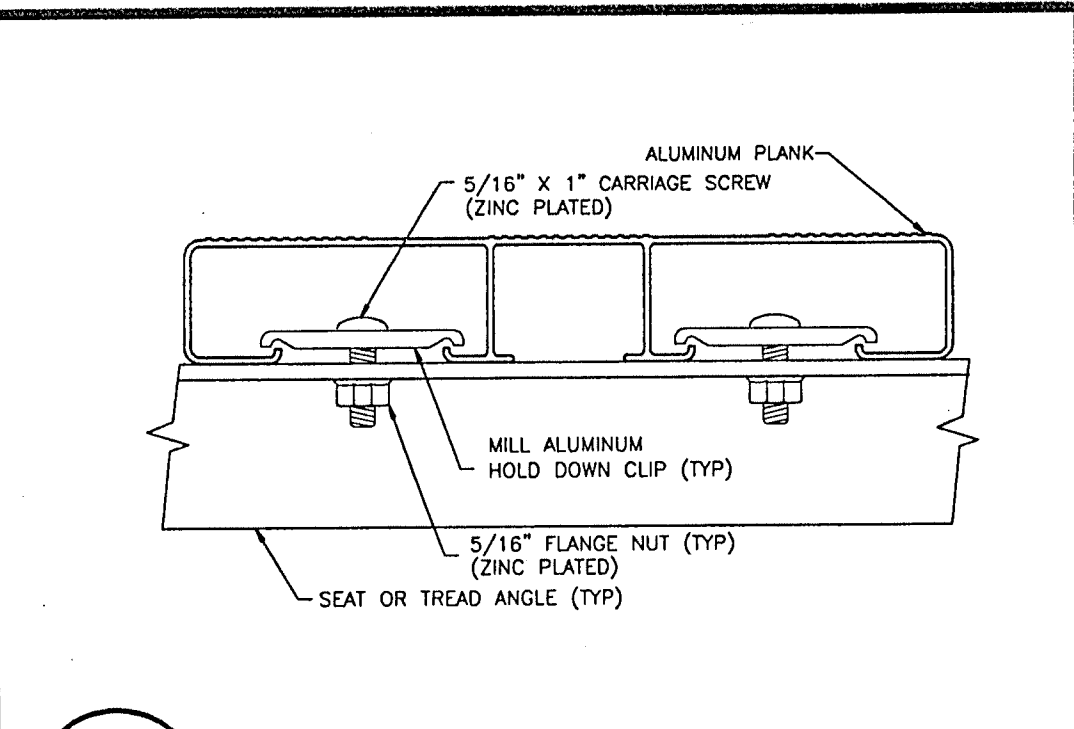


3 PLANK INSTALLATION DETAIL
6/6 SCALE: NONE

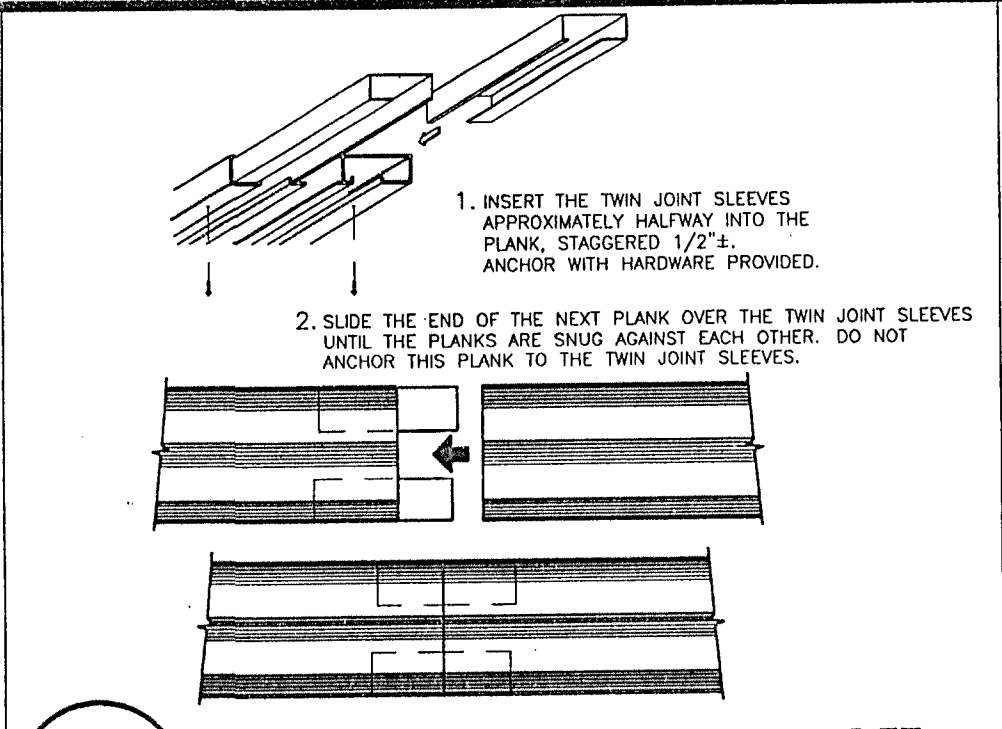


4 JOINT SLEEVE INSTALLATION DETAIL
6/6 SCALE: NONE

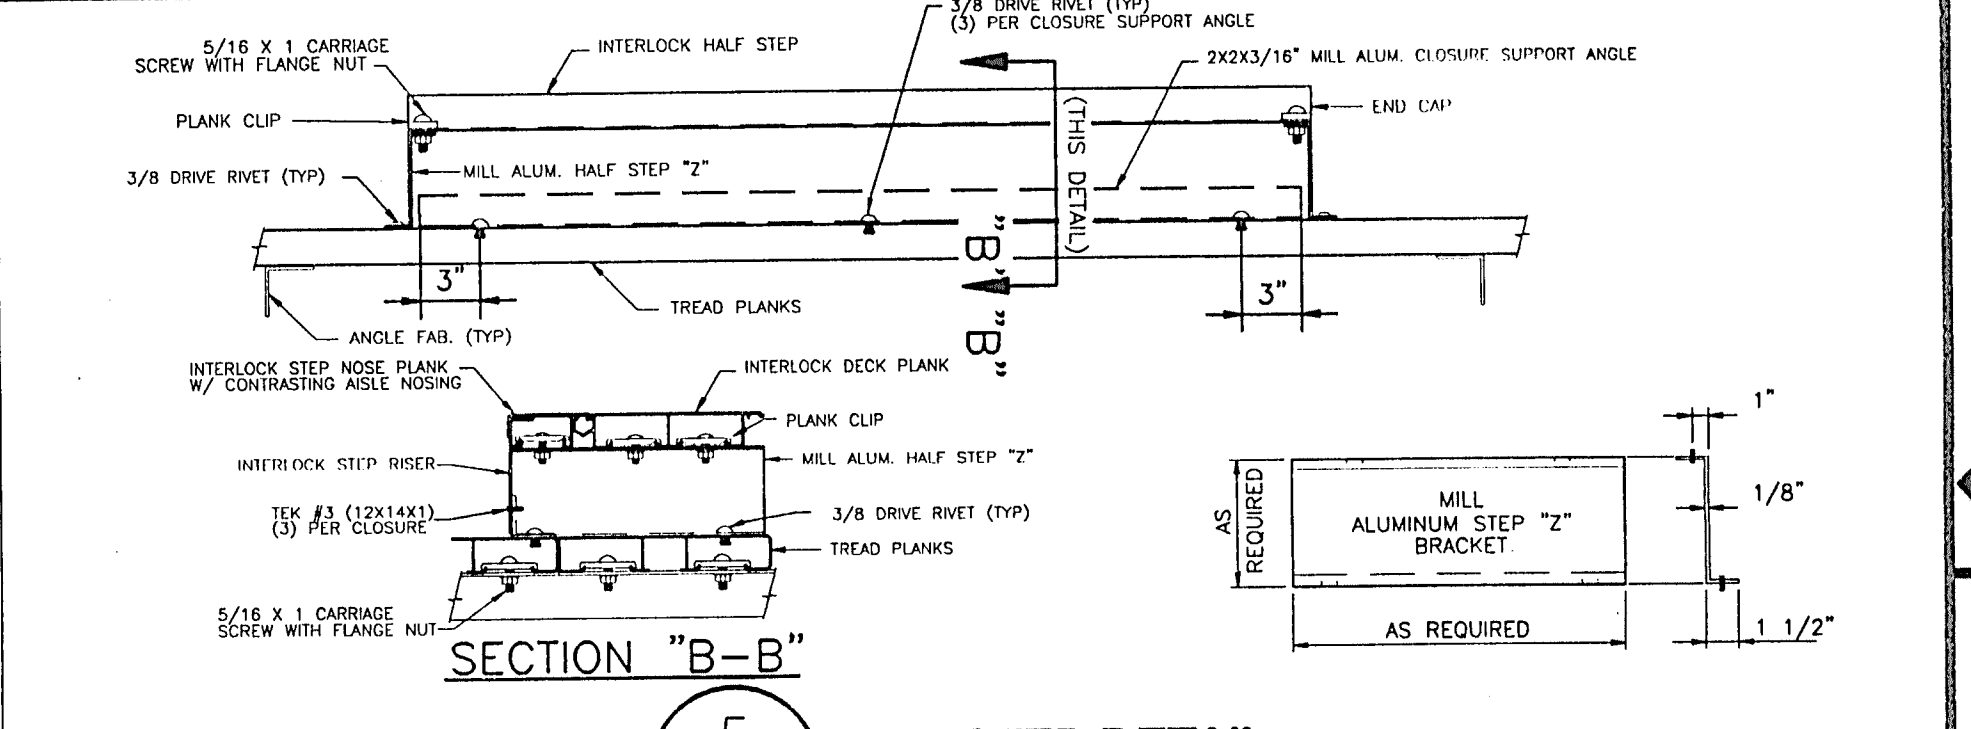


5 HALF STEP DETAIL
6/6 SCALE: NONE

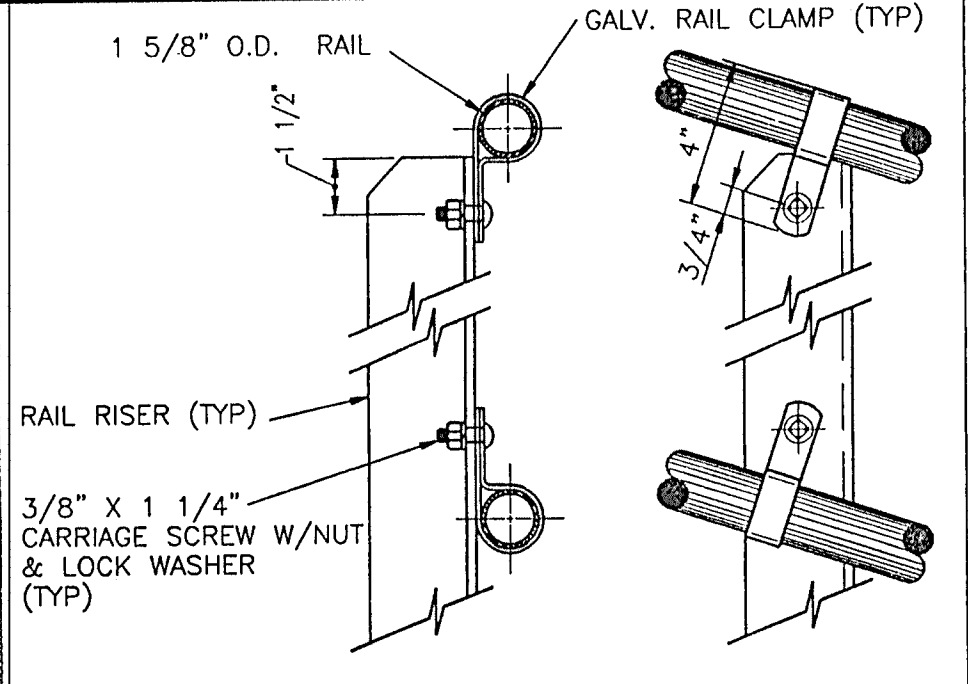


6 RAIL RISER ATTACHMENT DETAIL
6/6 SCALE: NONE

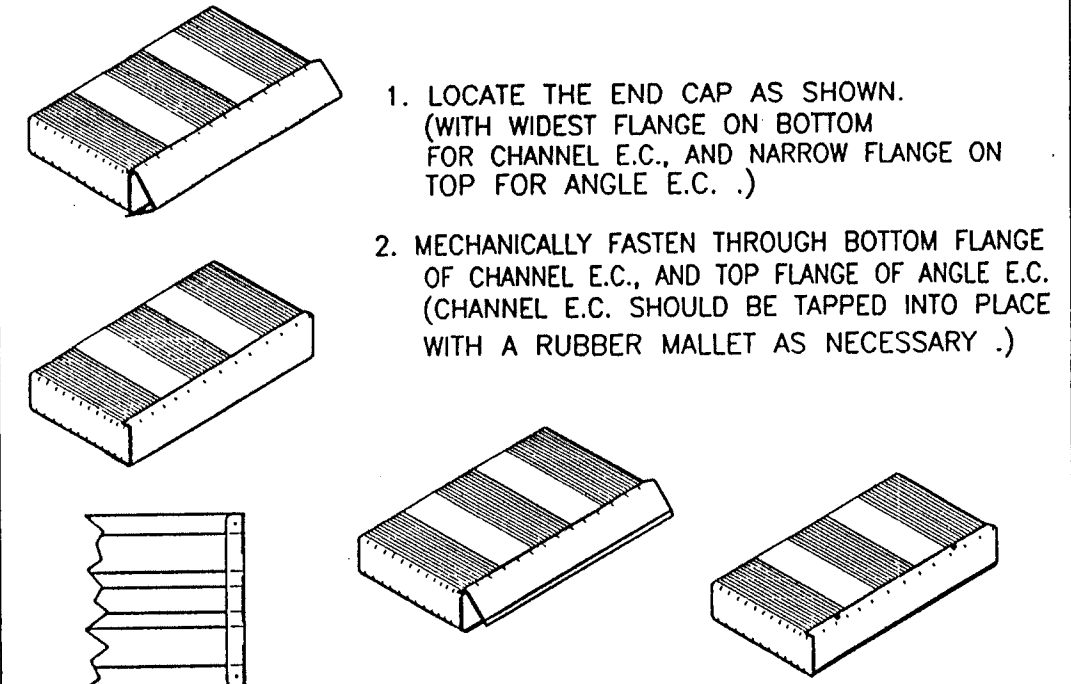


7 END CAP INSTALLATION DETAIL
6/6 SCALE: NONE

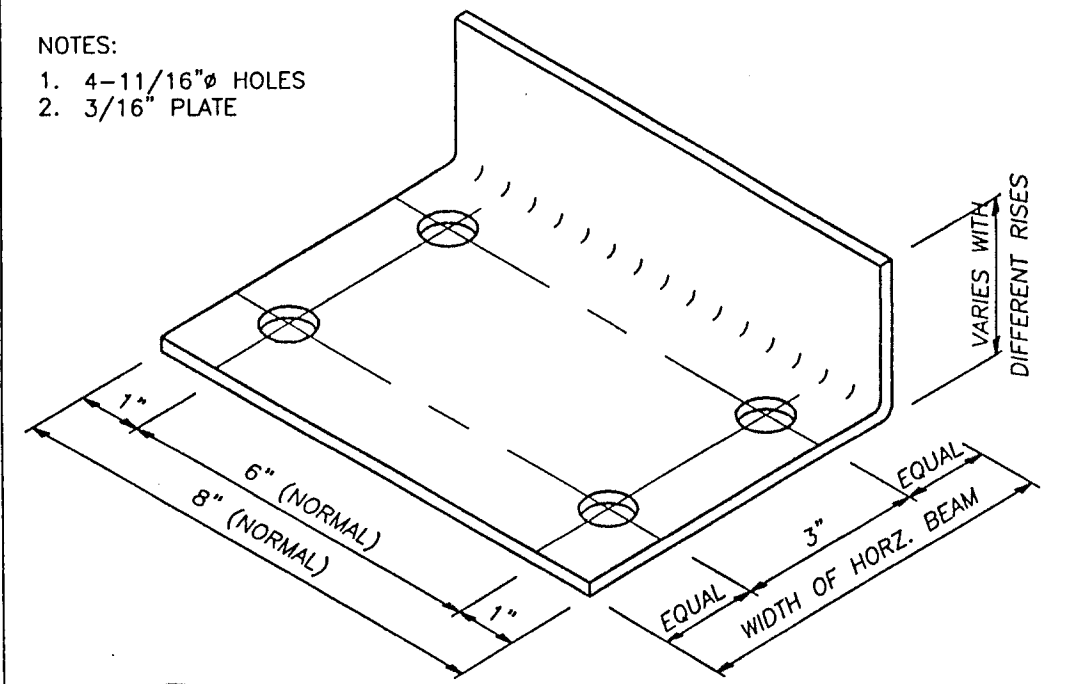


8 STRINGER CLIP DETAIL
6/6 SCALE: NONE

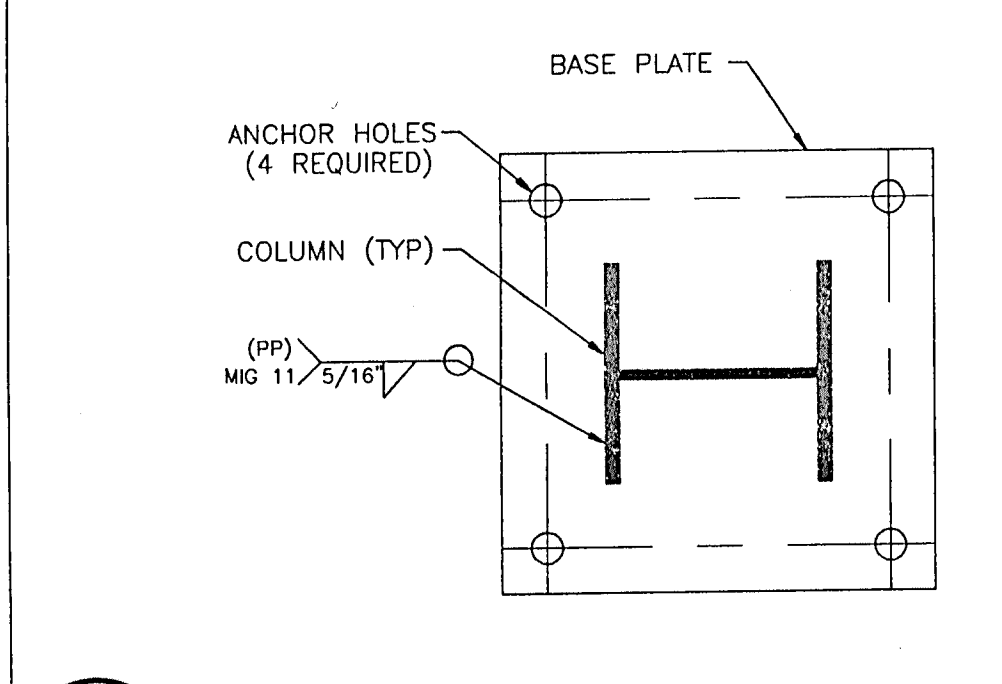


9 BASE PLATE ATTACHMENT DETAIL
6/6 SCALE: NONE

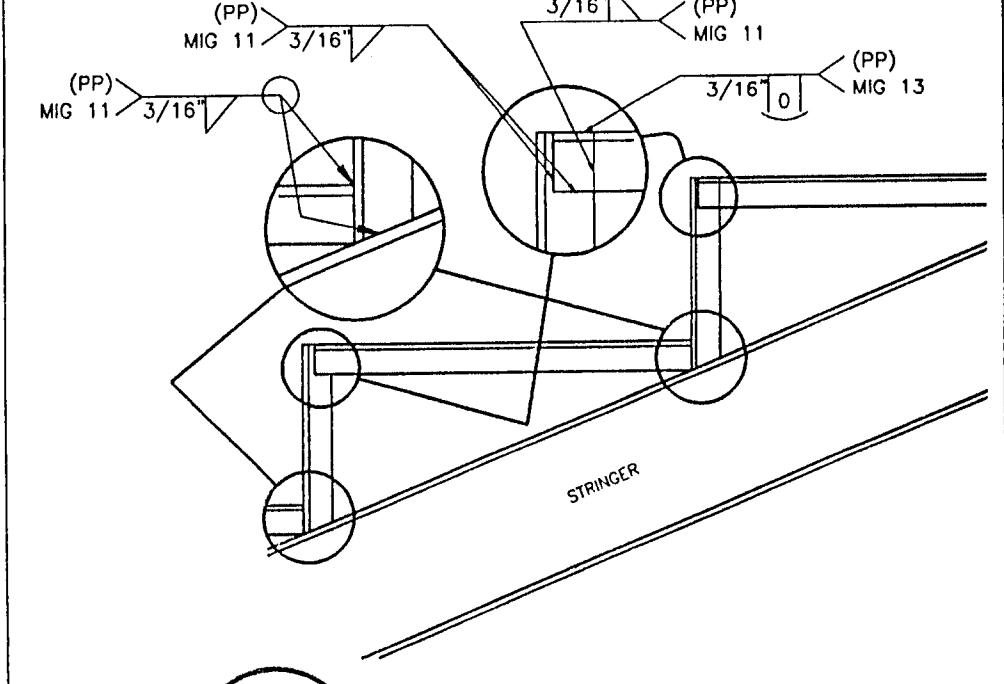


10 ANGLE FAB DETAIL
6/6 SCALE: NONE

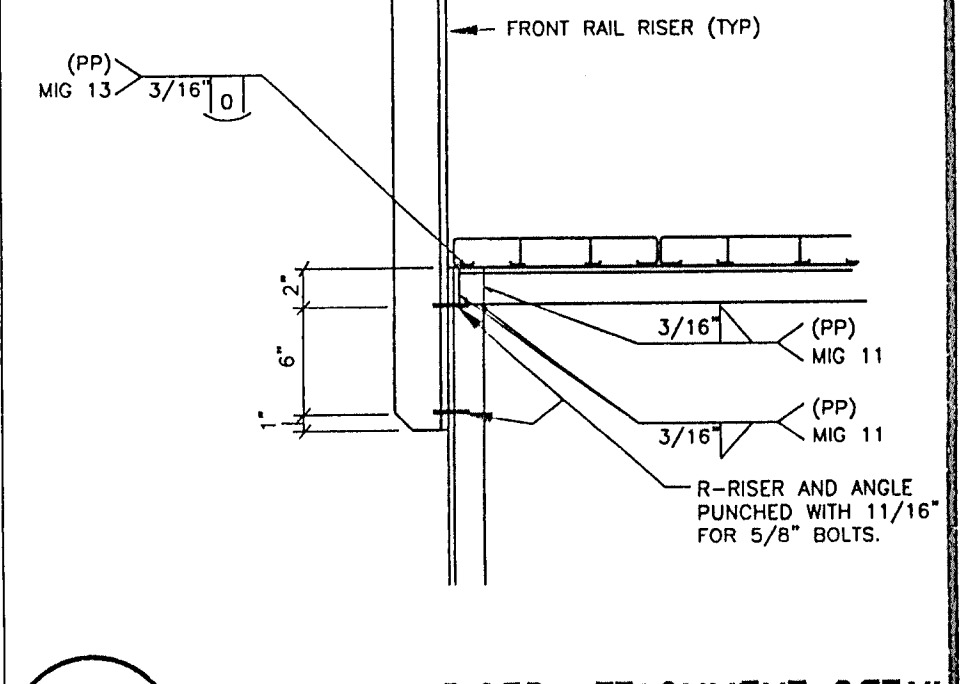


11 FRONT RAIL RISER ATTACHMENT DETAIL
6/6 SCALE: NONE

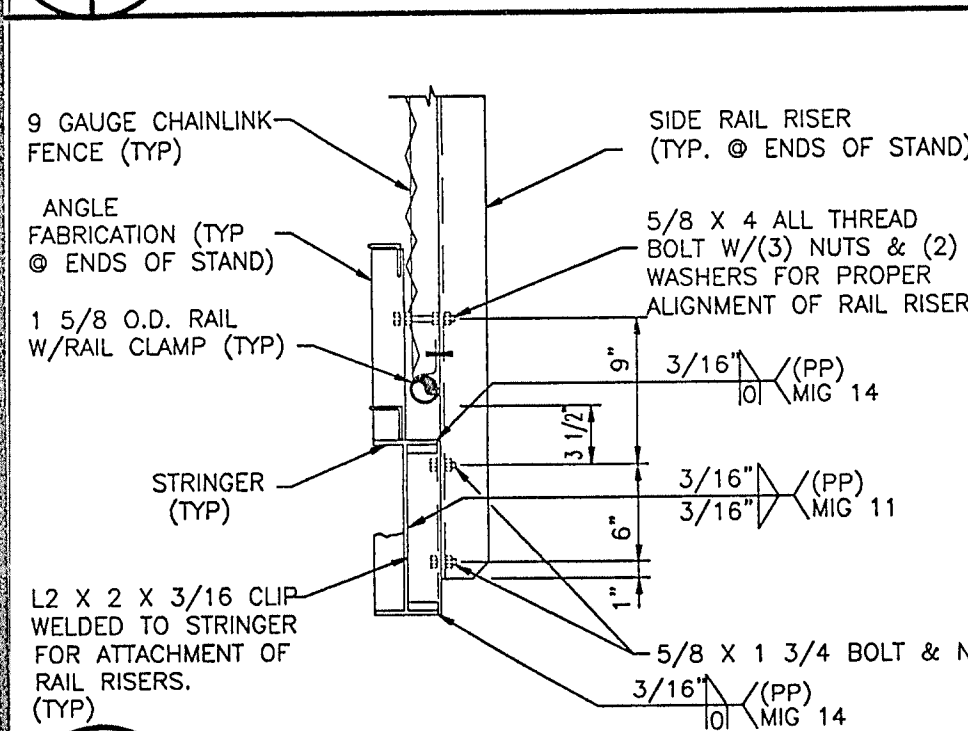


12 SIDE RAIL RISER ATTACHMENT DETAIL
6/6 SCALE: NONE

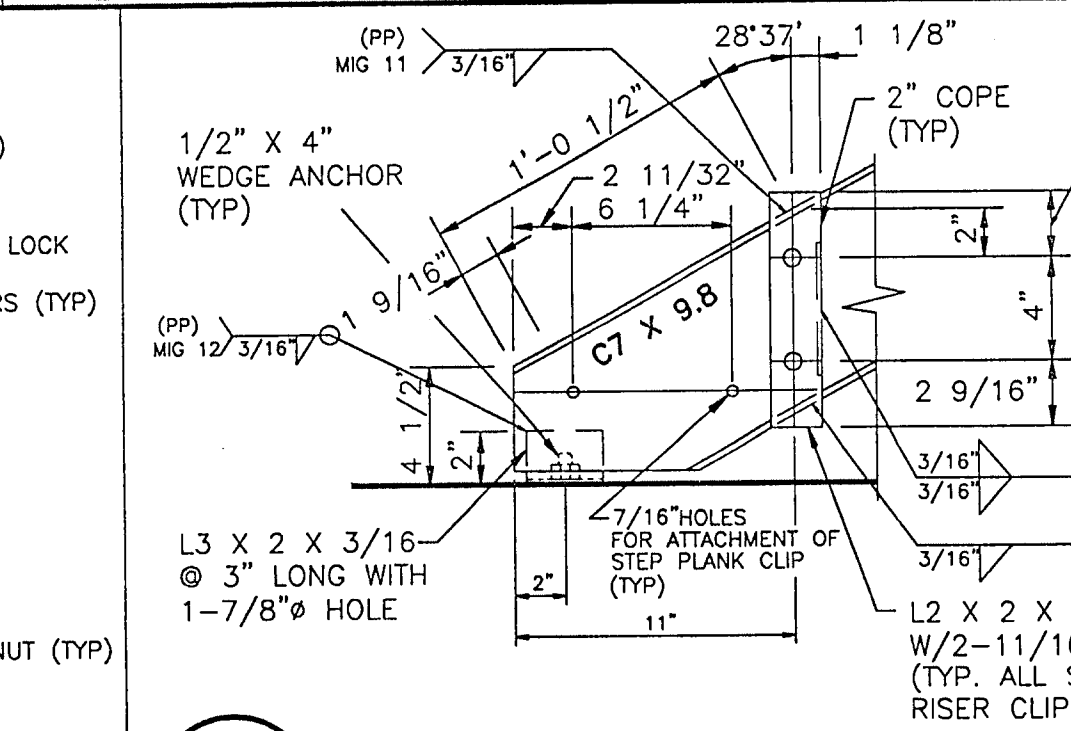


13 LOWER PART/STEP FRAME DETAIL

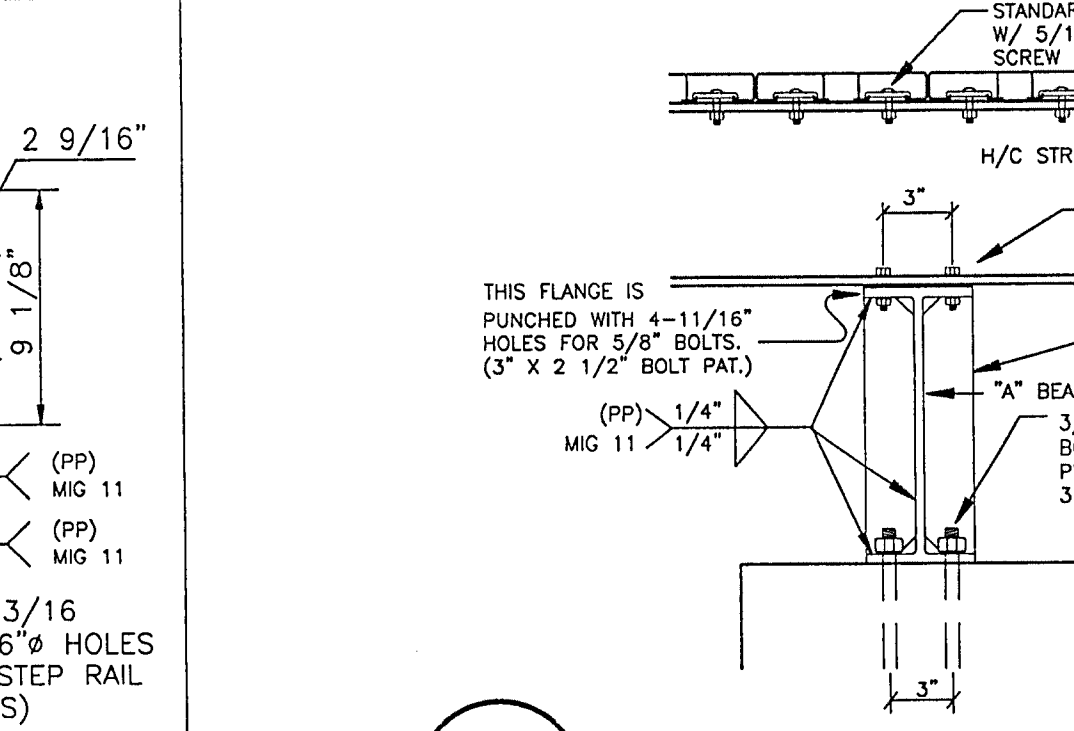


14 ROW "A" DETAIL @ WHEELCHAIR AREA
6/6 SCALE: NONE

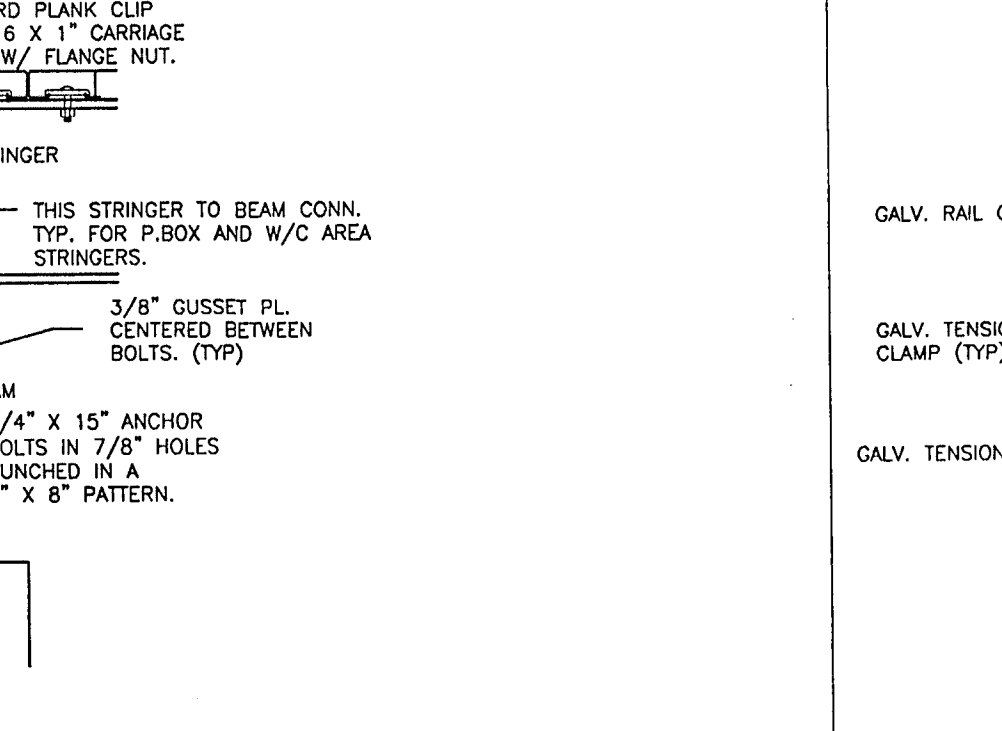


15 FENCE ATTACHMENT DETAIL
6/6 SCALE: NONE

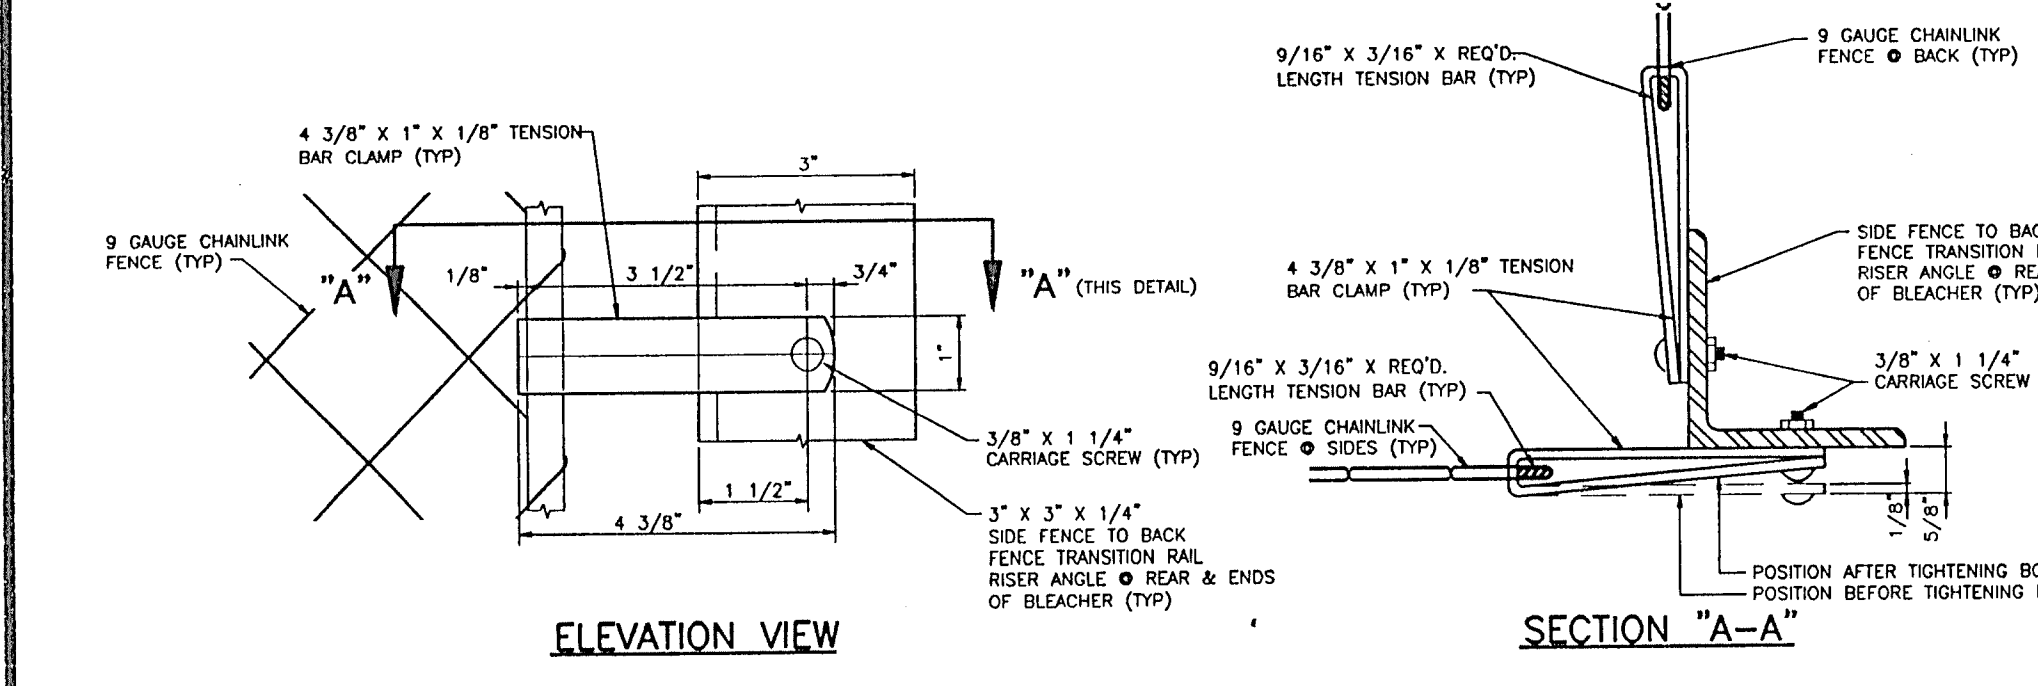

16 TENSION BAR CLAMP DETAIL
6/6 SCALE: NONE

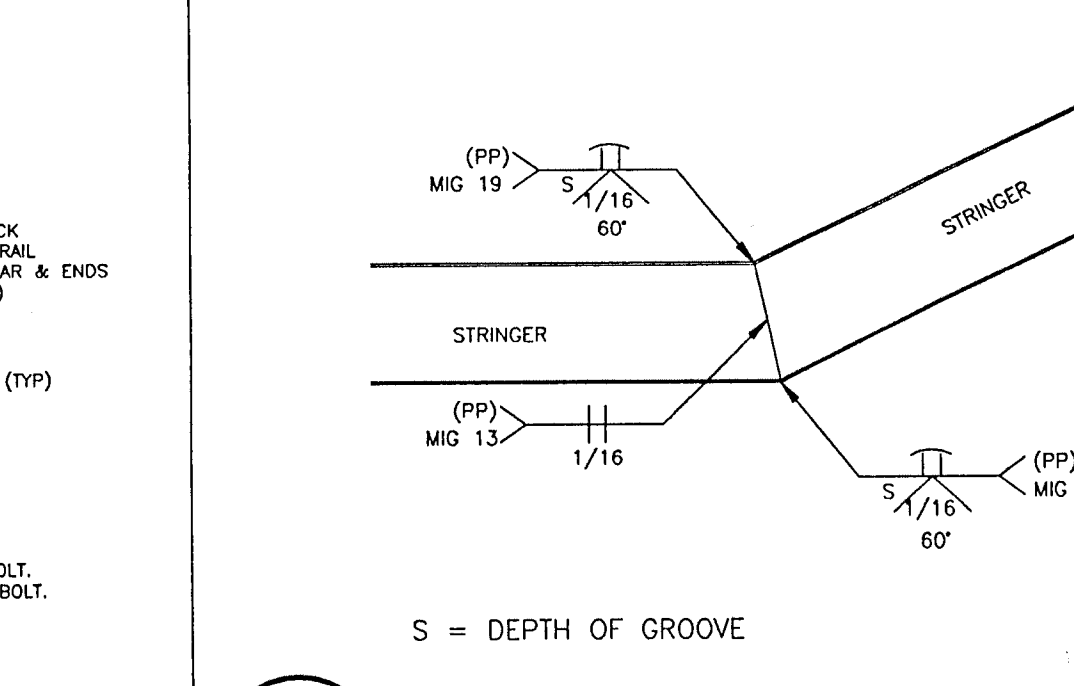

17 STRINGER SNOOTER JOINT CONNECTION
6/6 SCALE: NONE

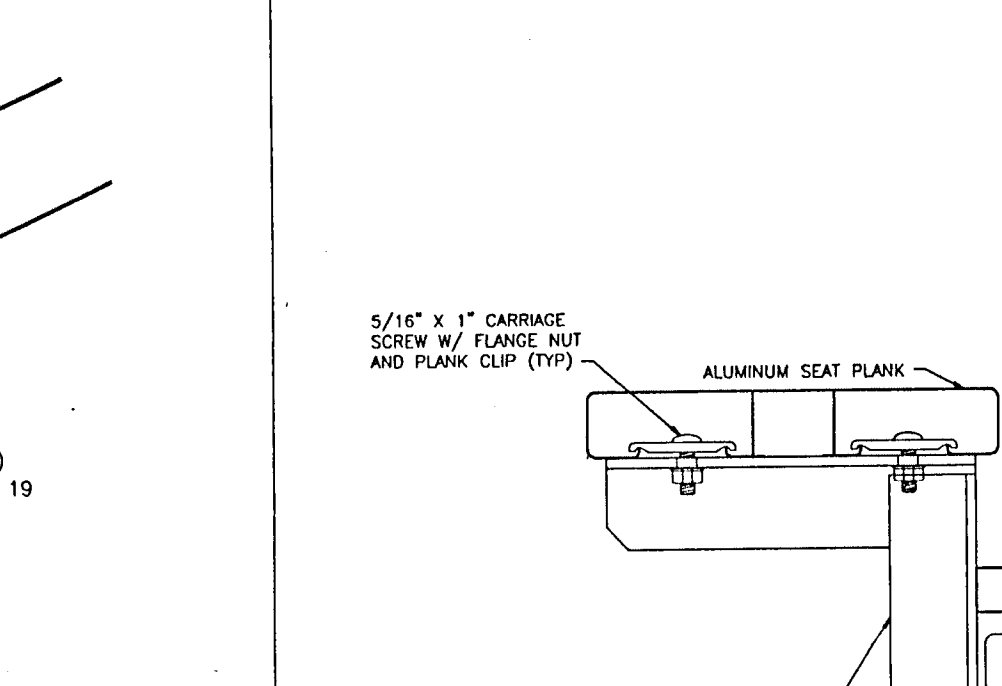

18 SEAT "Z" BRACKET DETAIL
6/6 SCALE: NONE



18 SEAT "Z" BRACKET DETAIL
6/6 SCALE: NONE

CHECKED AND FORWARDED TO A/E
☐ REVISE AND RESUBMIT
☐ INSUFFICIENT INFORMATION
Checking is only for conformance and compliance with the information given in the Contract Documents. Contractor is responsible for dimensions to be confirmed and completed at the job site for information that pertains solely to the fabrication processes or to techniques of construction and for coordination of the work of all trades.
BY: MEB
DATE: 9/11/97
CONSTRUCTION CONTROL
FORT WAYNE, INDIANA

DETAIL NUMBER
110
SHEET SHOWN
1
THE SADLER GROUP
STRUCTURAL ENGINEERS
(817) 332-1074 • 500 MAIN STREET SUITE 707 • FORT WORTH, TX. 76102
Southern BLEACHER COMPANY
Established 1946
P.O. BOX ONE • GRAHAM, TEXAS 76450 • 817/548-0793
DUNELAND SCHOOLS CORP.
GRANDSTAND
CHESTERSON, INDIANA
BY: NOTED DATE: 8/26/97 REV. SDC
JOB NUMBER: 97165
SHEET: 4 OF: 6