
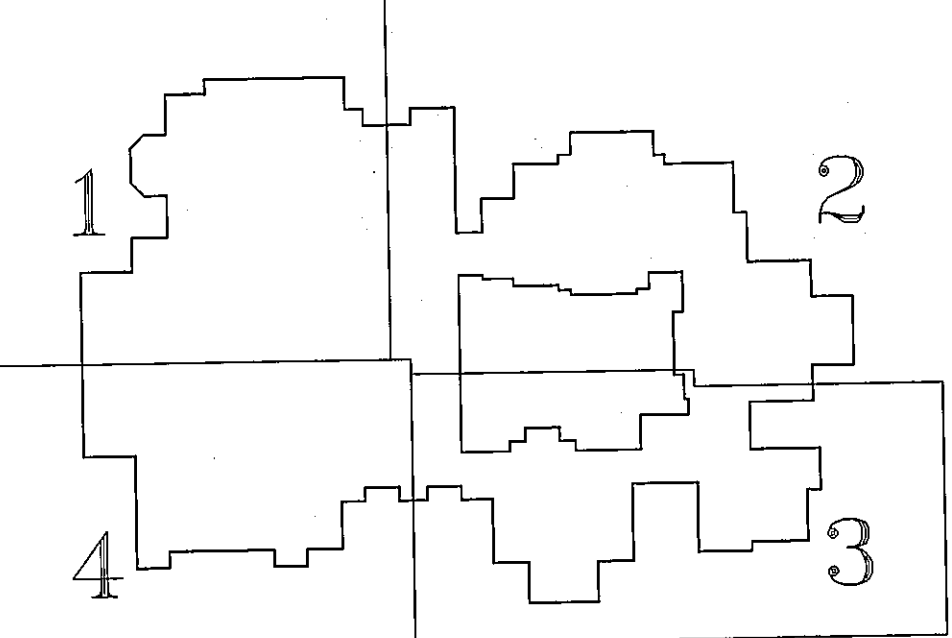


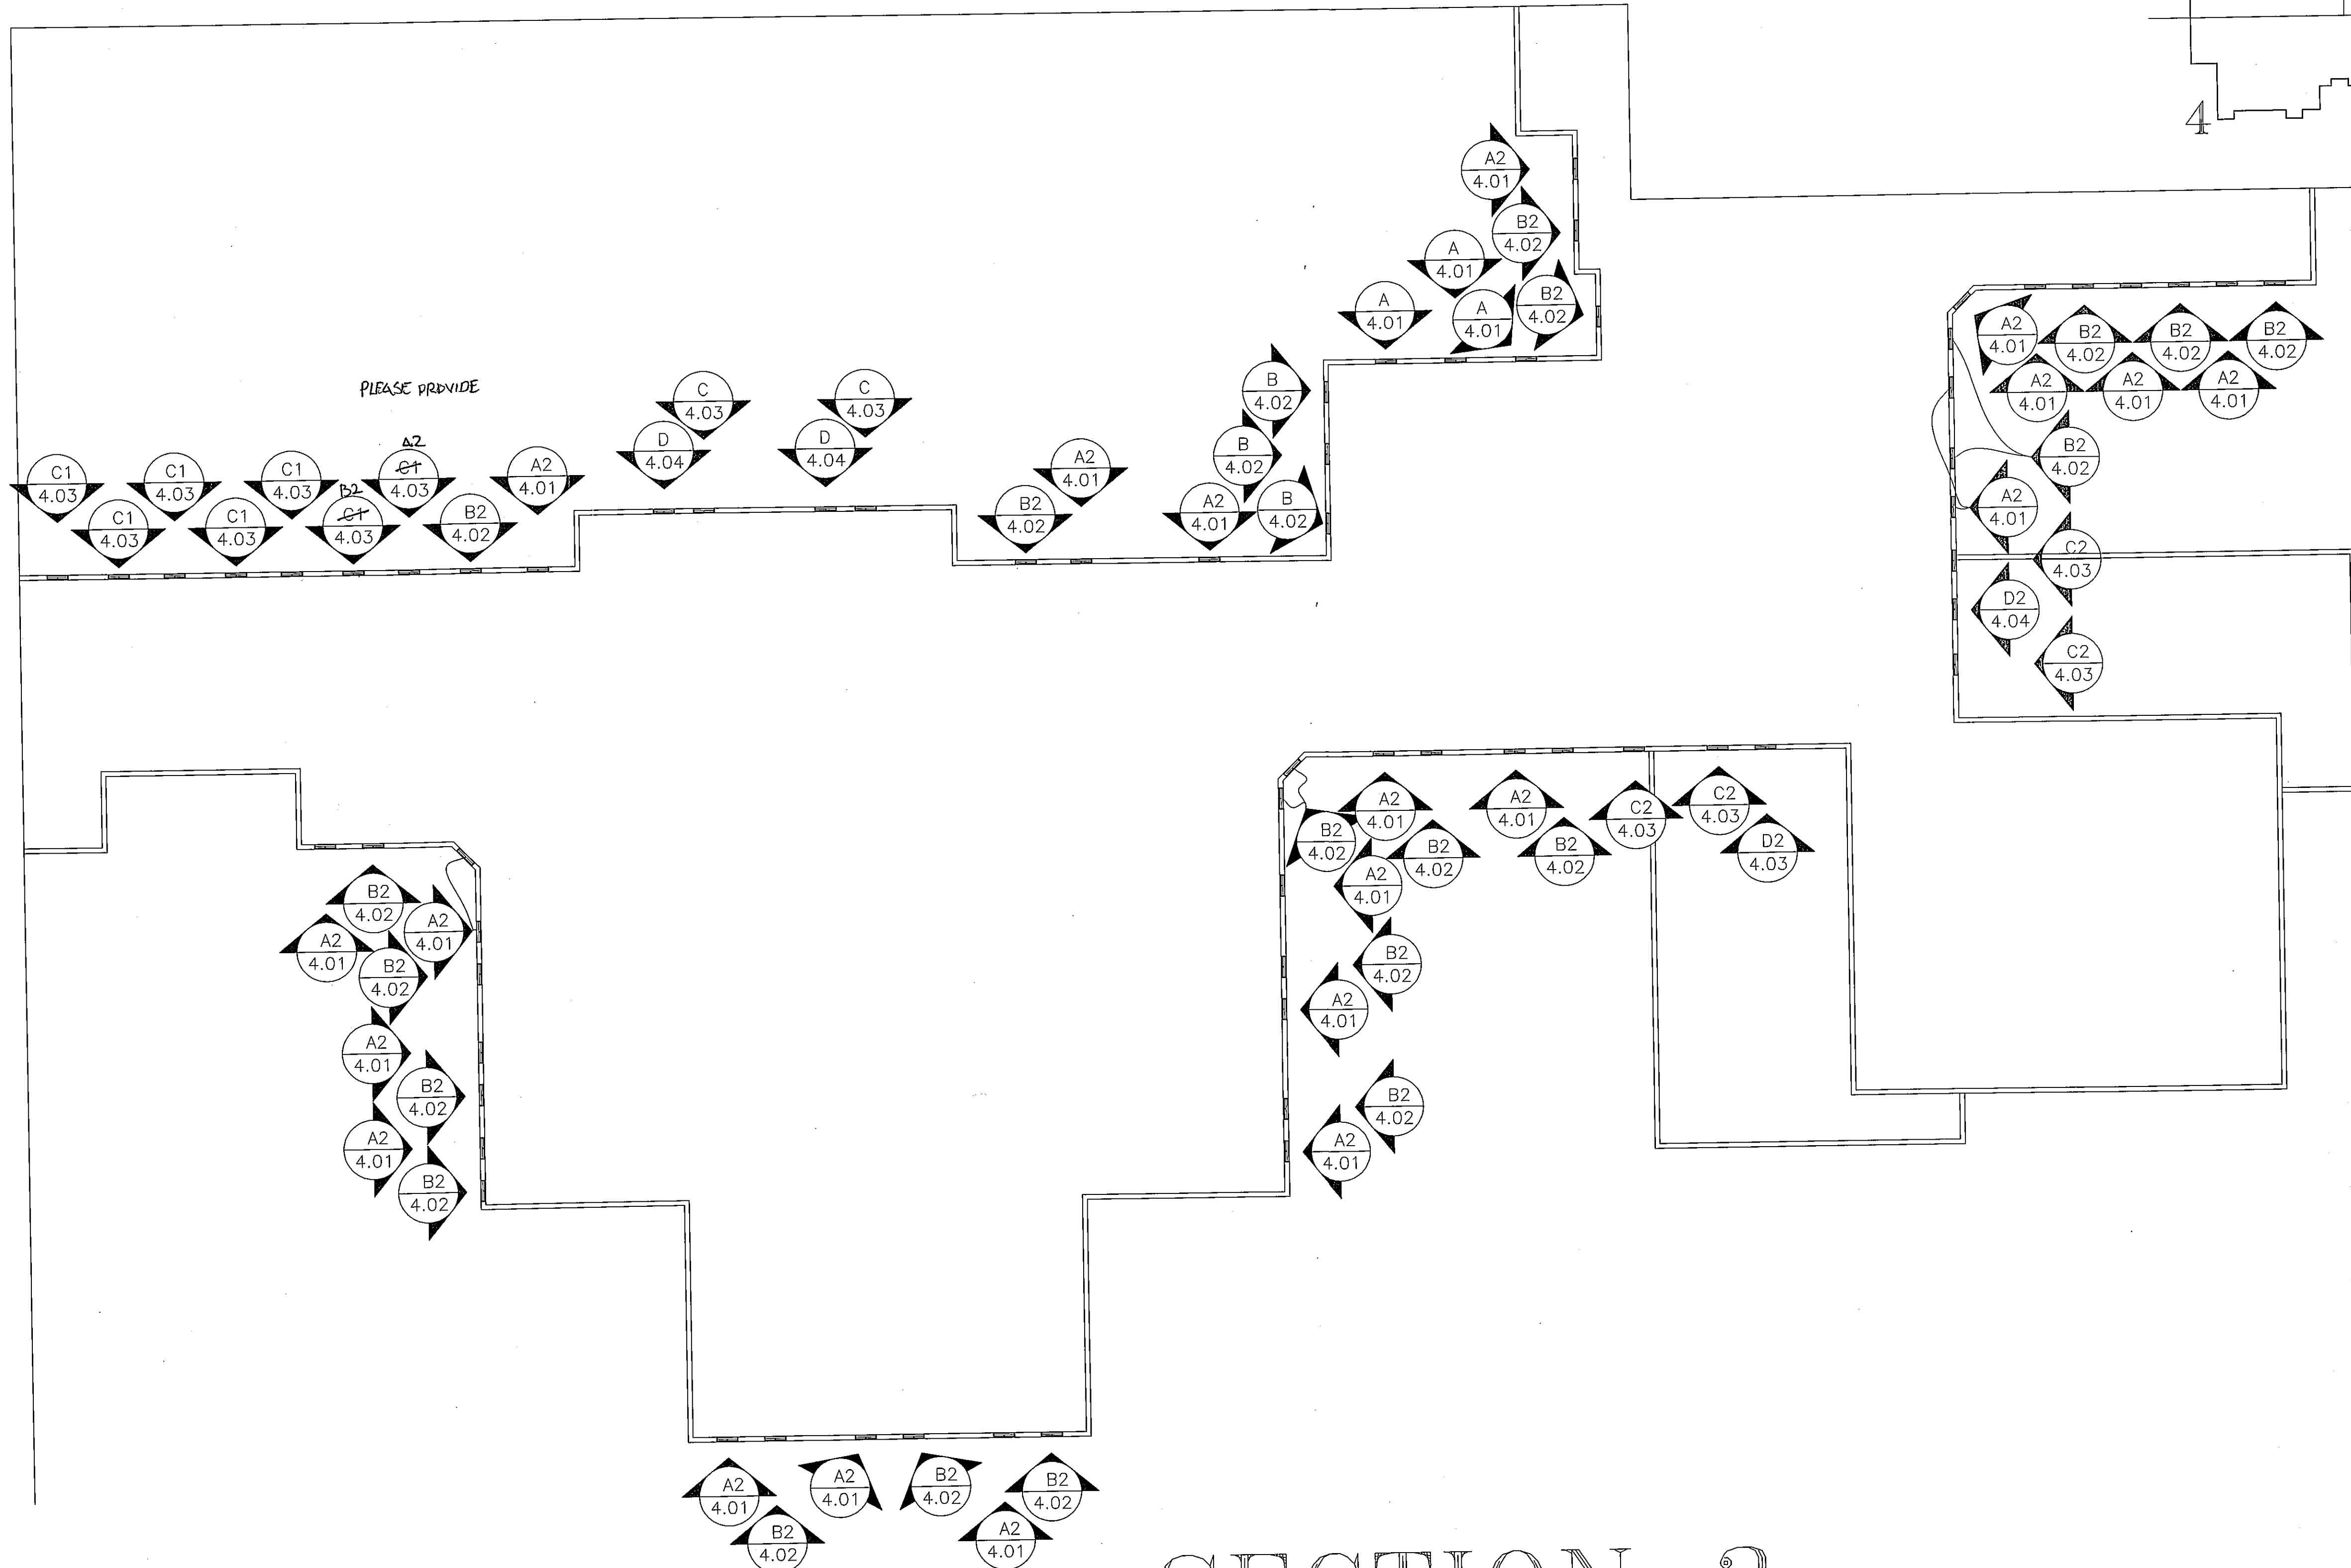

SECTION 3 2ND FLOOR

6P this page

PROJECT: CHESTERTON HIGH SCHOOL
LOCATION: CHESTERTON, INDIANA

ARCHITECT: EFCO CORPORATION

DRAWN BY: GES
CHECKED BY: CC
JOB NO.: 7-8
SHEET NO.: