
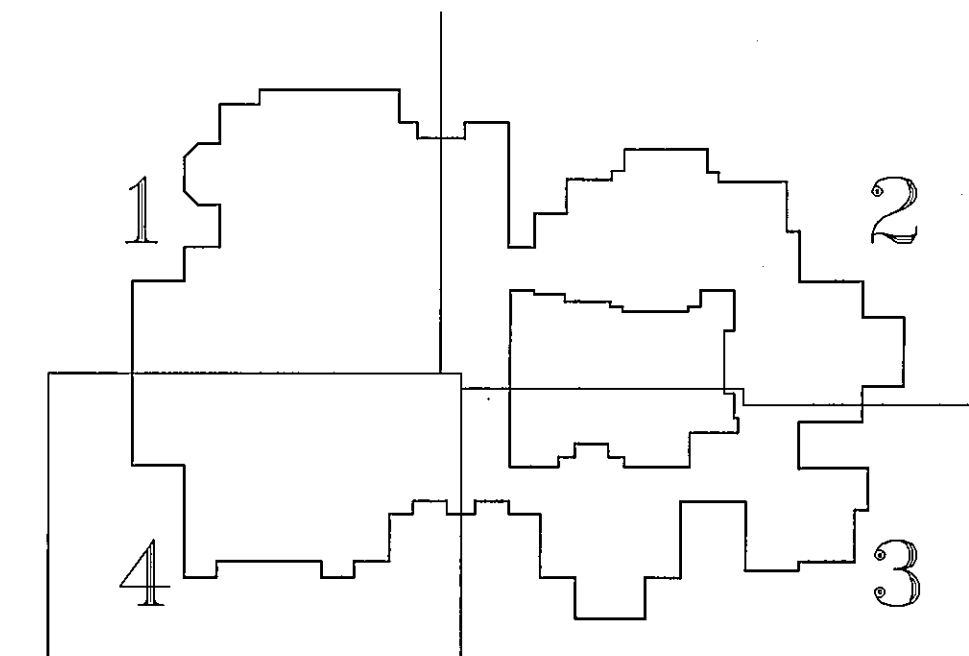


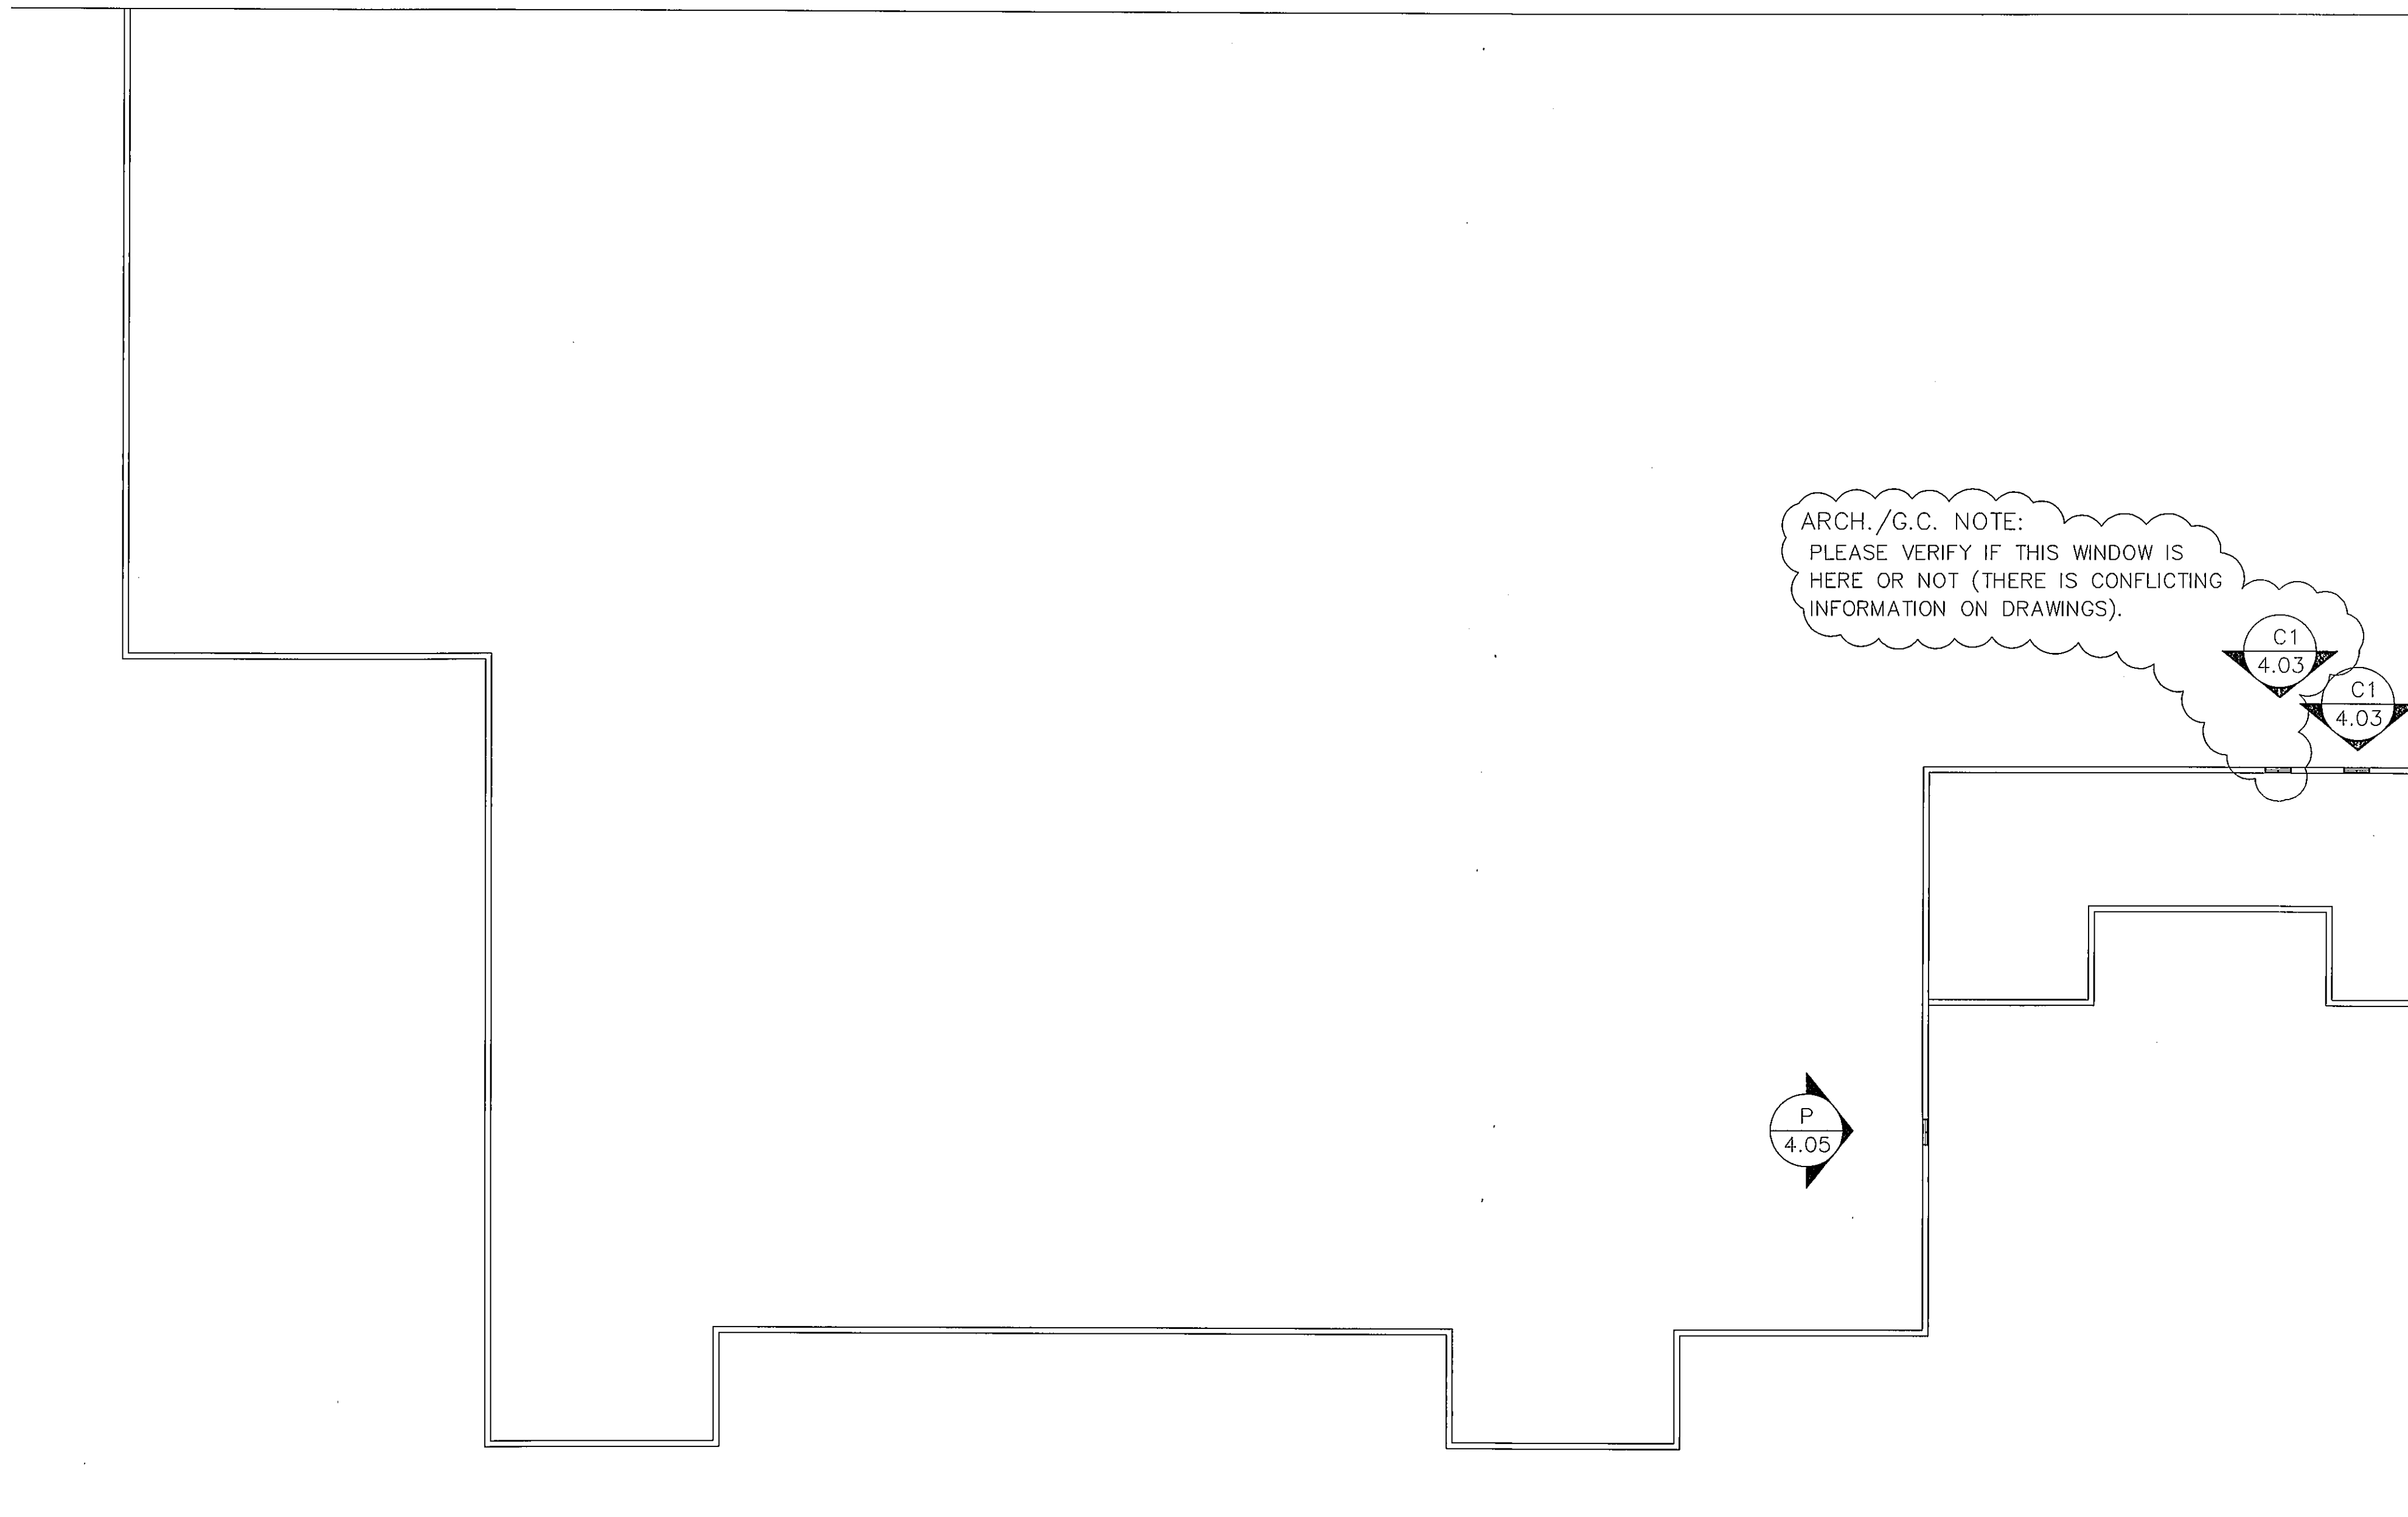

SECTION 4 2ND FLOOR

PROJECT:	CHESTERTON HIGH SCHOOL
LOCATION:	CHESTERTON, INDIANA
ARCHITECT:	FANNING/HOWEY ASSOCIATES, INC.
EFCO CORPORATION P.O. BOX 609	
DRAWN BY:	GES
CHECKED BY:	CC
JOB NO.:	7-82
SHEET NO.:	3