
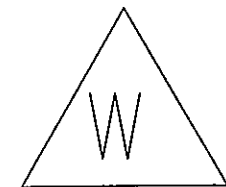




ARCH./G.C. NOTE:
PLEASE VERIFY IF THESE WINDOWS ON
THIS SHEET ARE TO BE P.O. OR P.I.

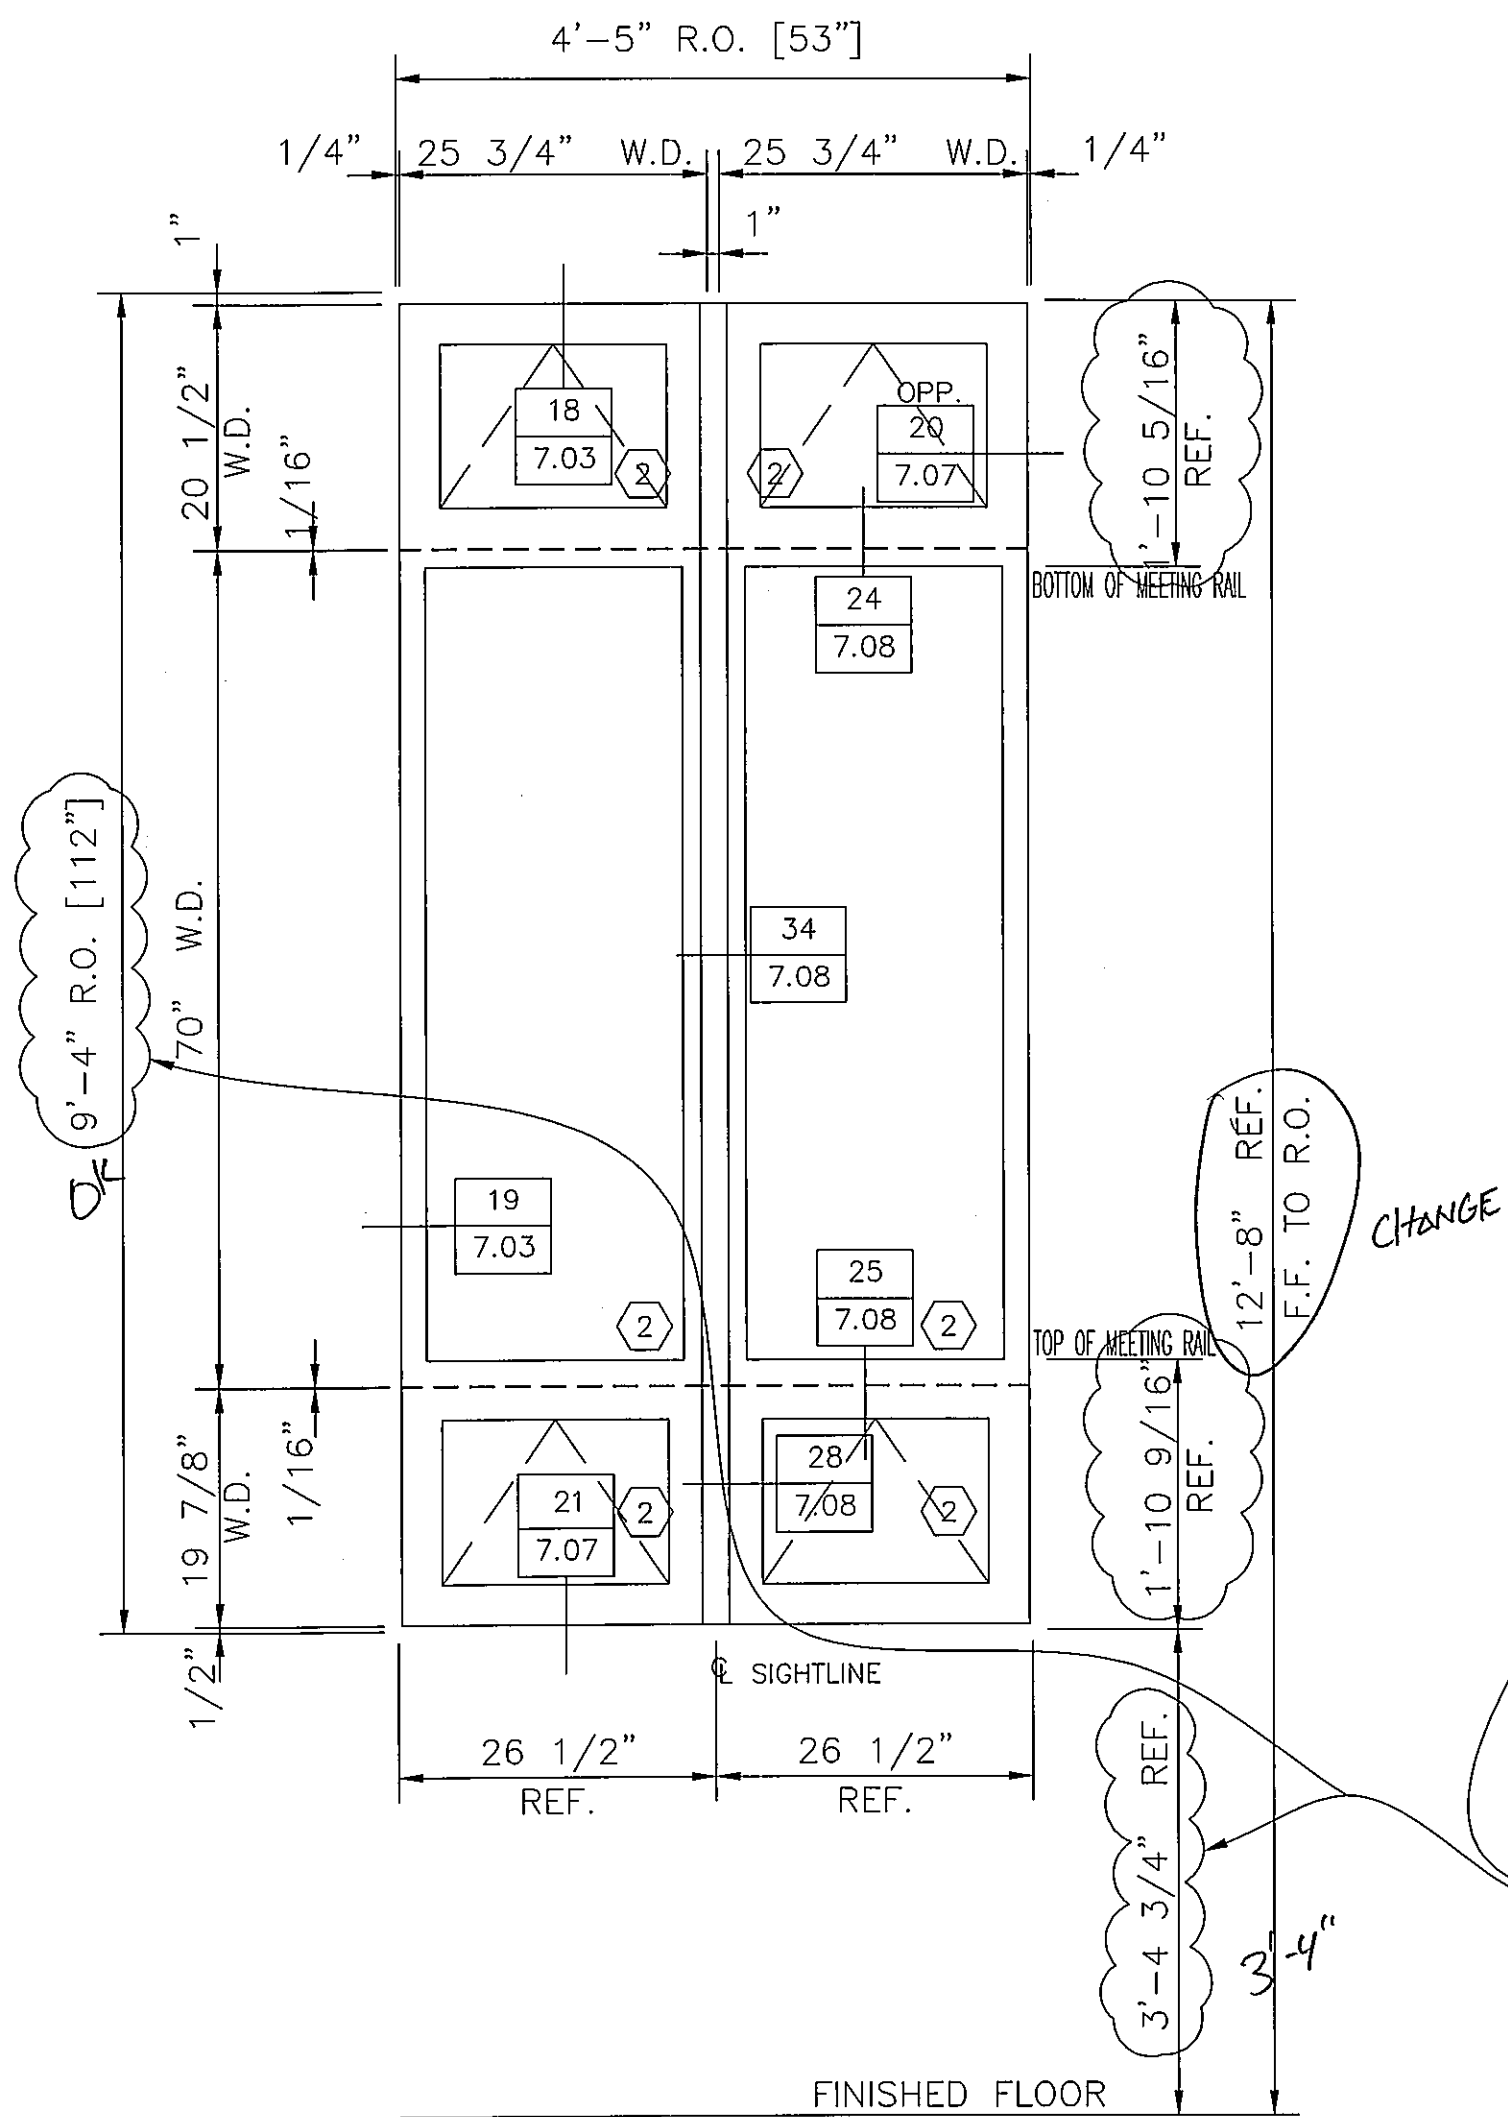

(4) REQUIRED THUS
SERIES 810-I WINDOW
ARCH. REF. G/A6.1

ARCH./G.C. NOTE:
REF. DIMENSIONS HAVE BEEN ALTERED
AT PROJECTED WINDOWS IN ORDER FOR
THE WINDOW TO USE SPECIFIED HARDWARE

ARCH./G.C. NOTE:
USING THE NEW 12'-8" REF. DIM. (FROM
THE TOP OF R.O. TO FINISHED FLOOR),
EITHER THE 3'-4" REF. DIM. (FROM BOTTOM
OF R.O. TO FINISHED FLOOR) OR THE R.O.
MUST CHANGE. PLEASE VERIFY WHICH DIM.
IS TO BE ALTERED.

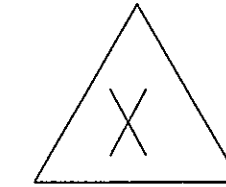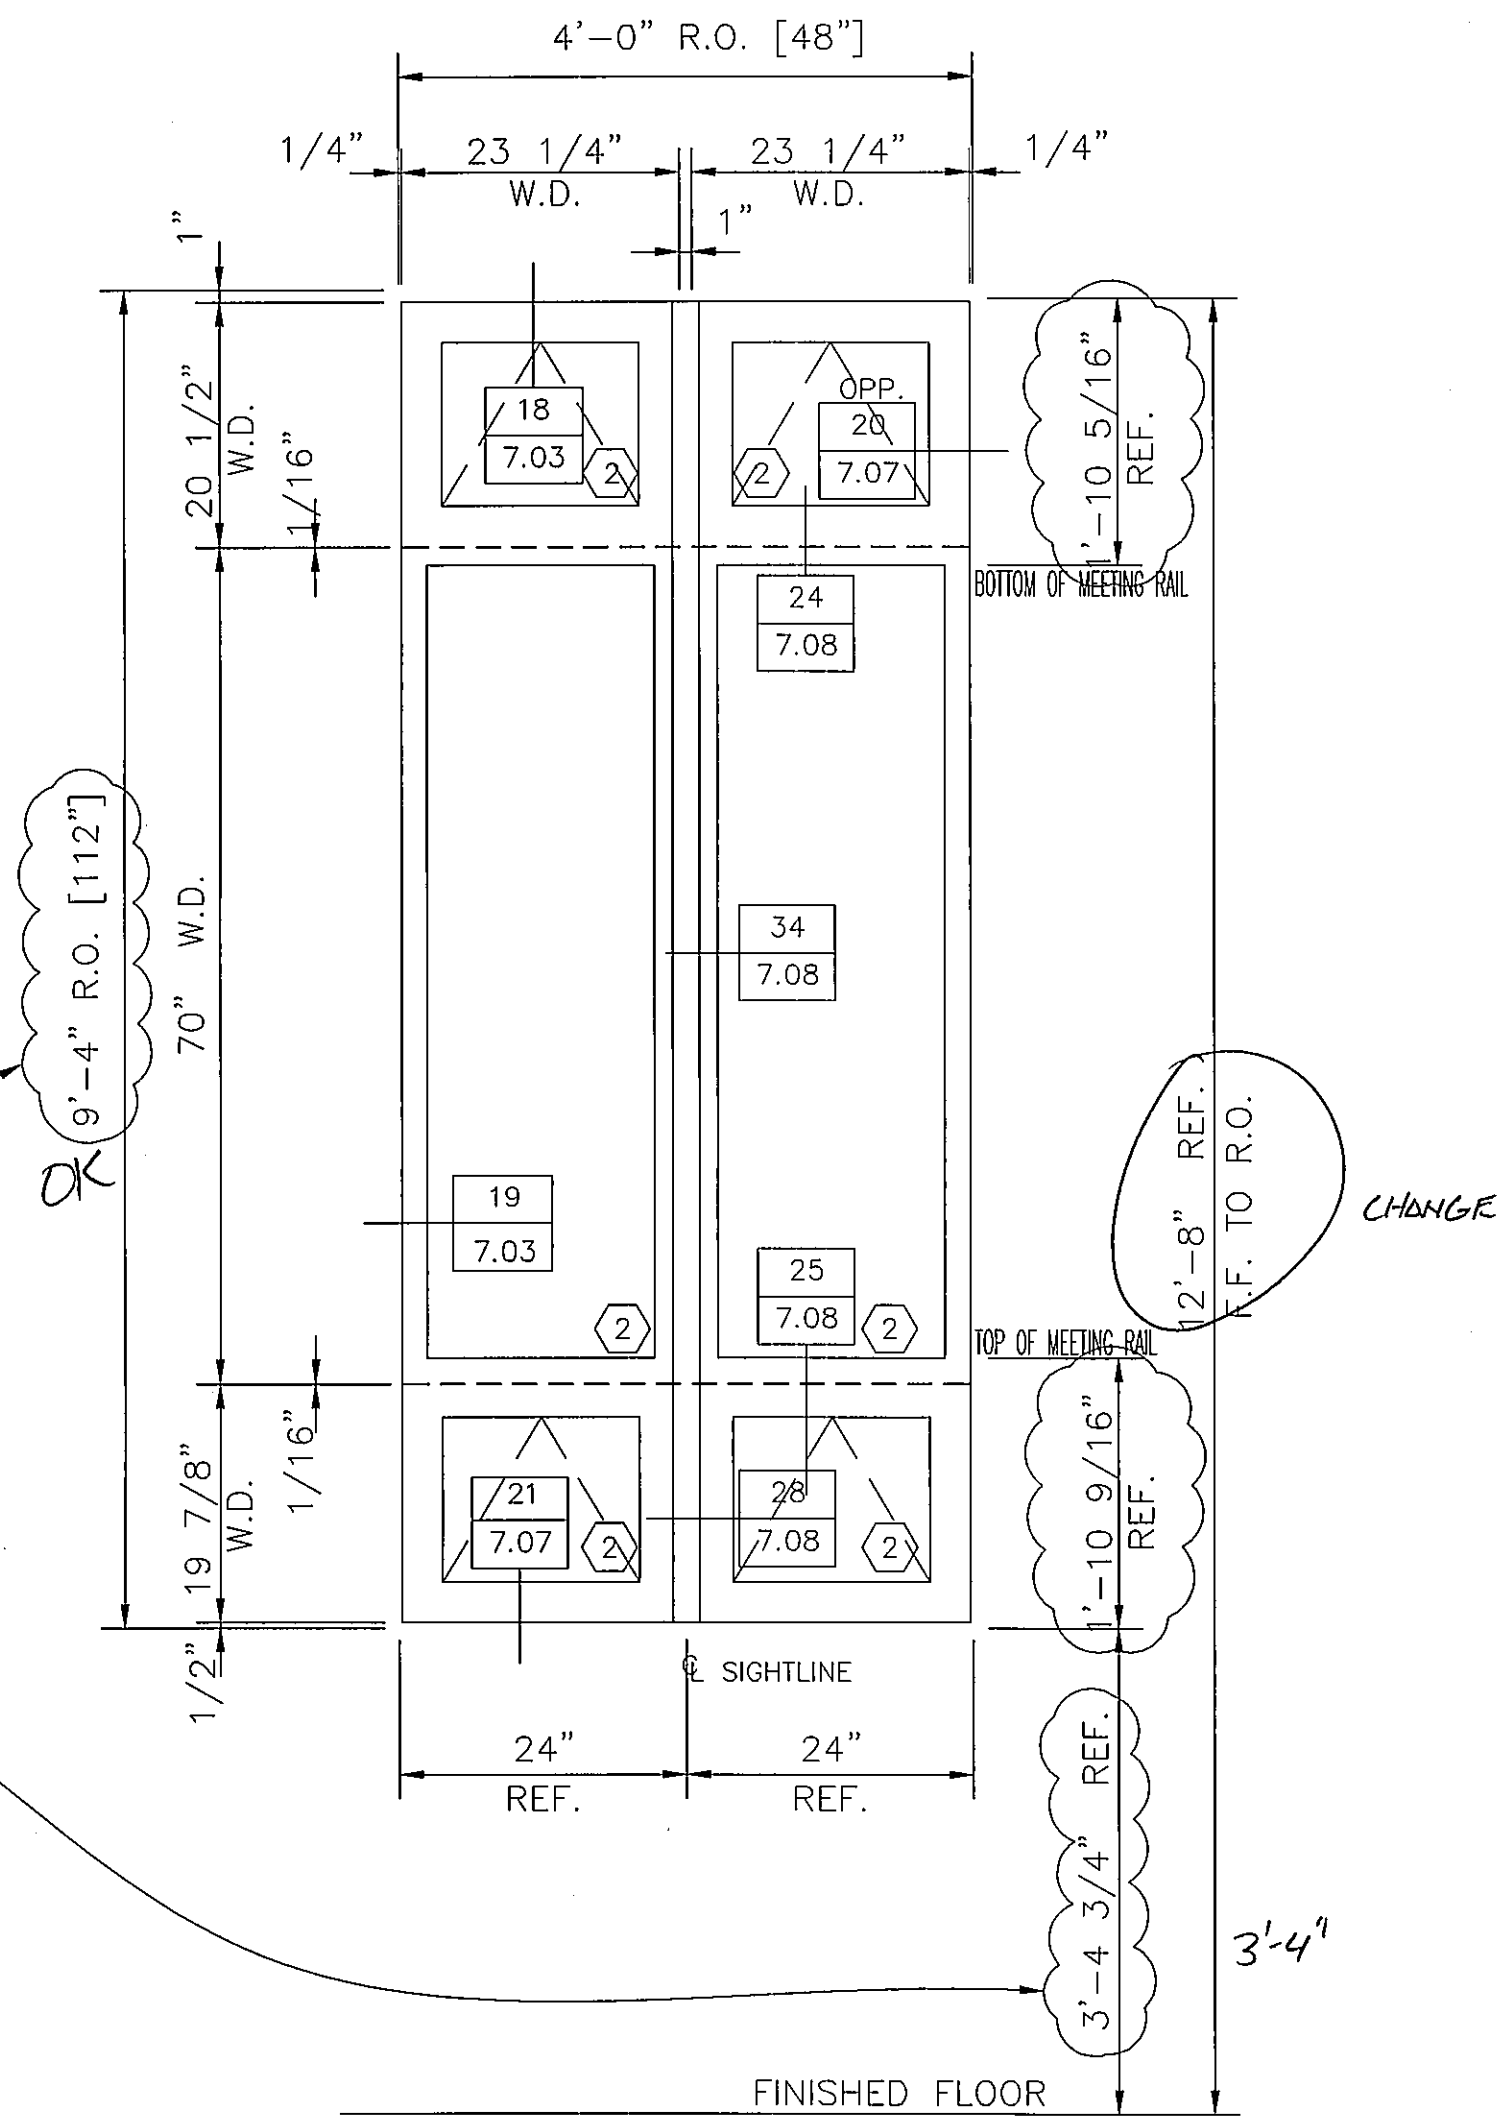

(6) REQUIRED THUS
SERIES 810-I WINDOW
ARCH. REF. G/A6.1