

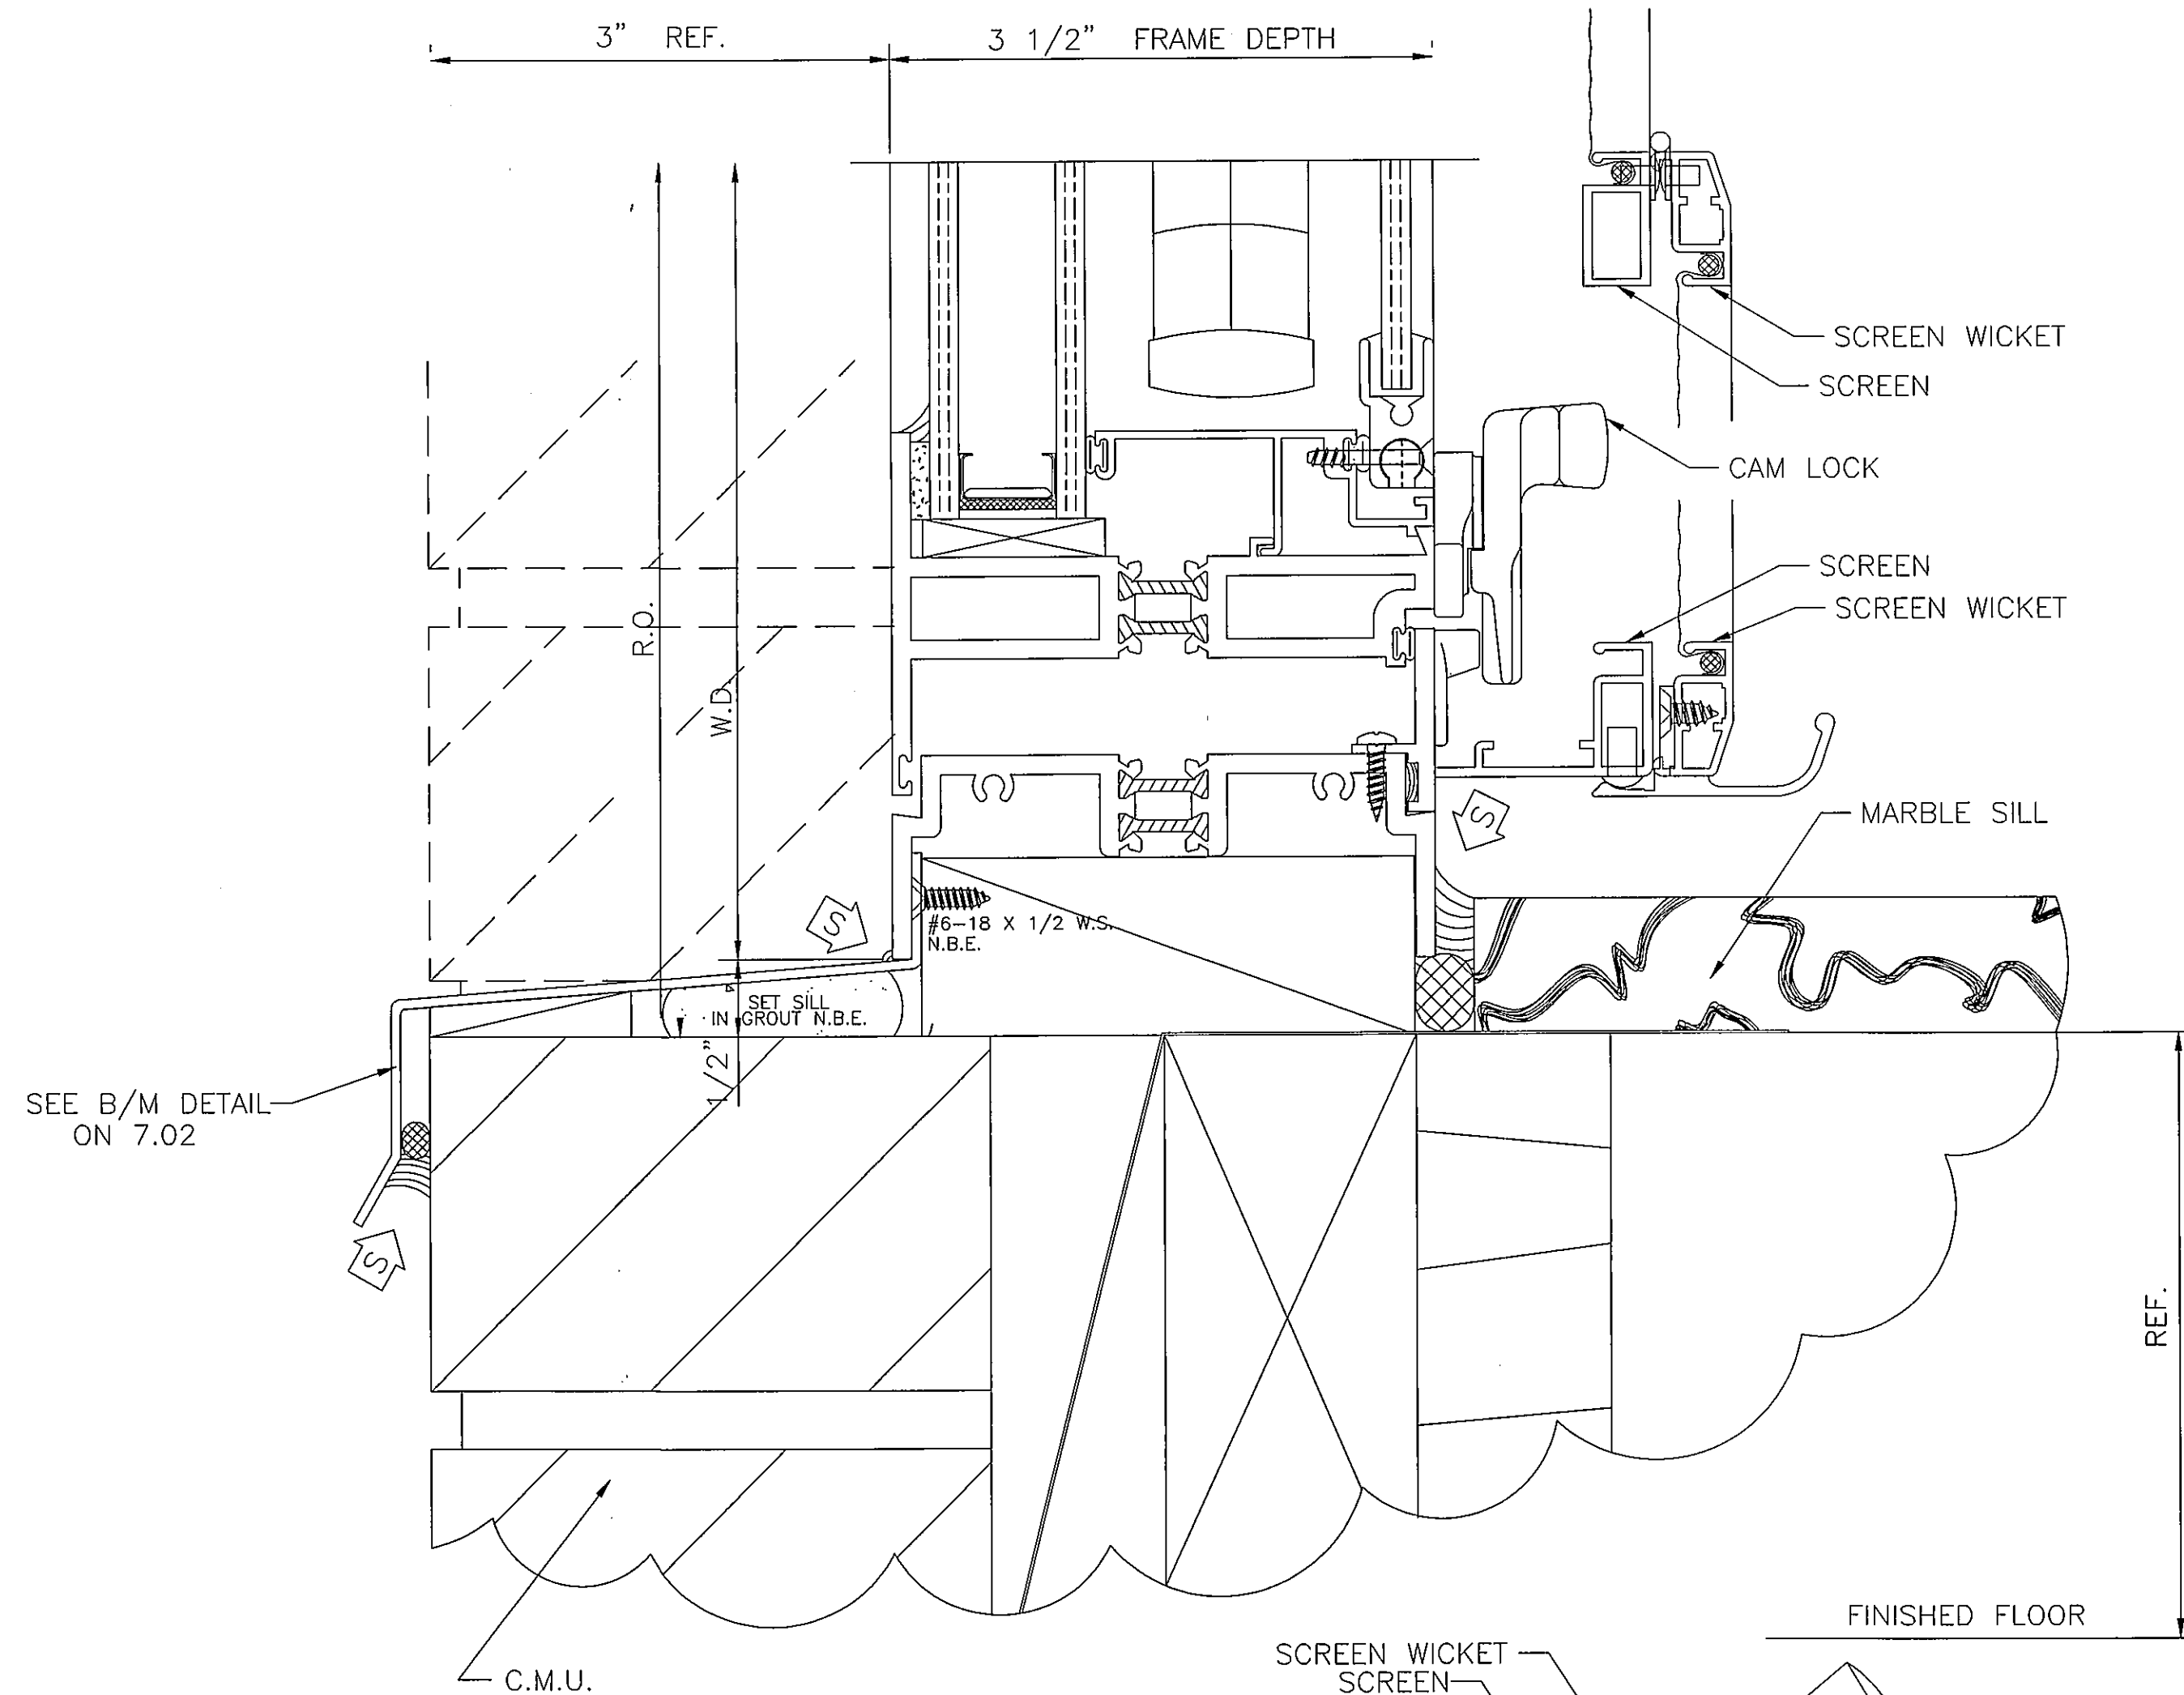


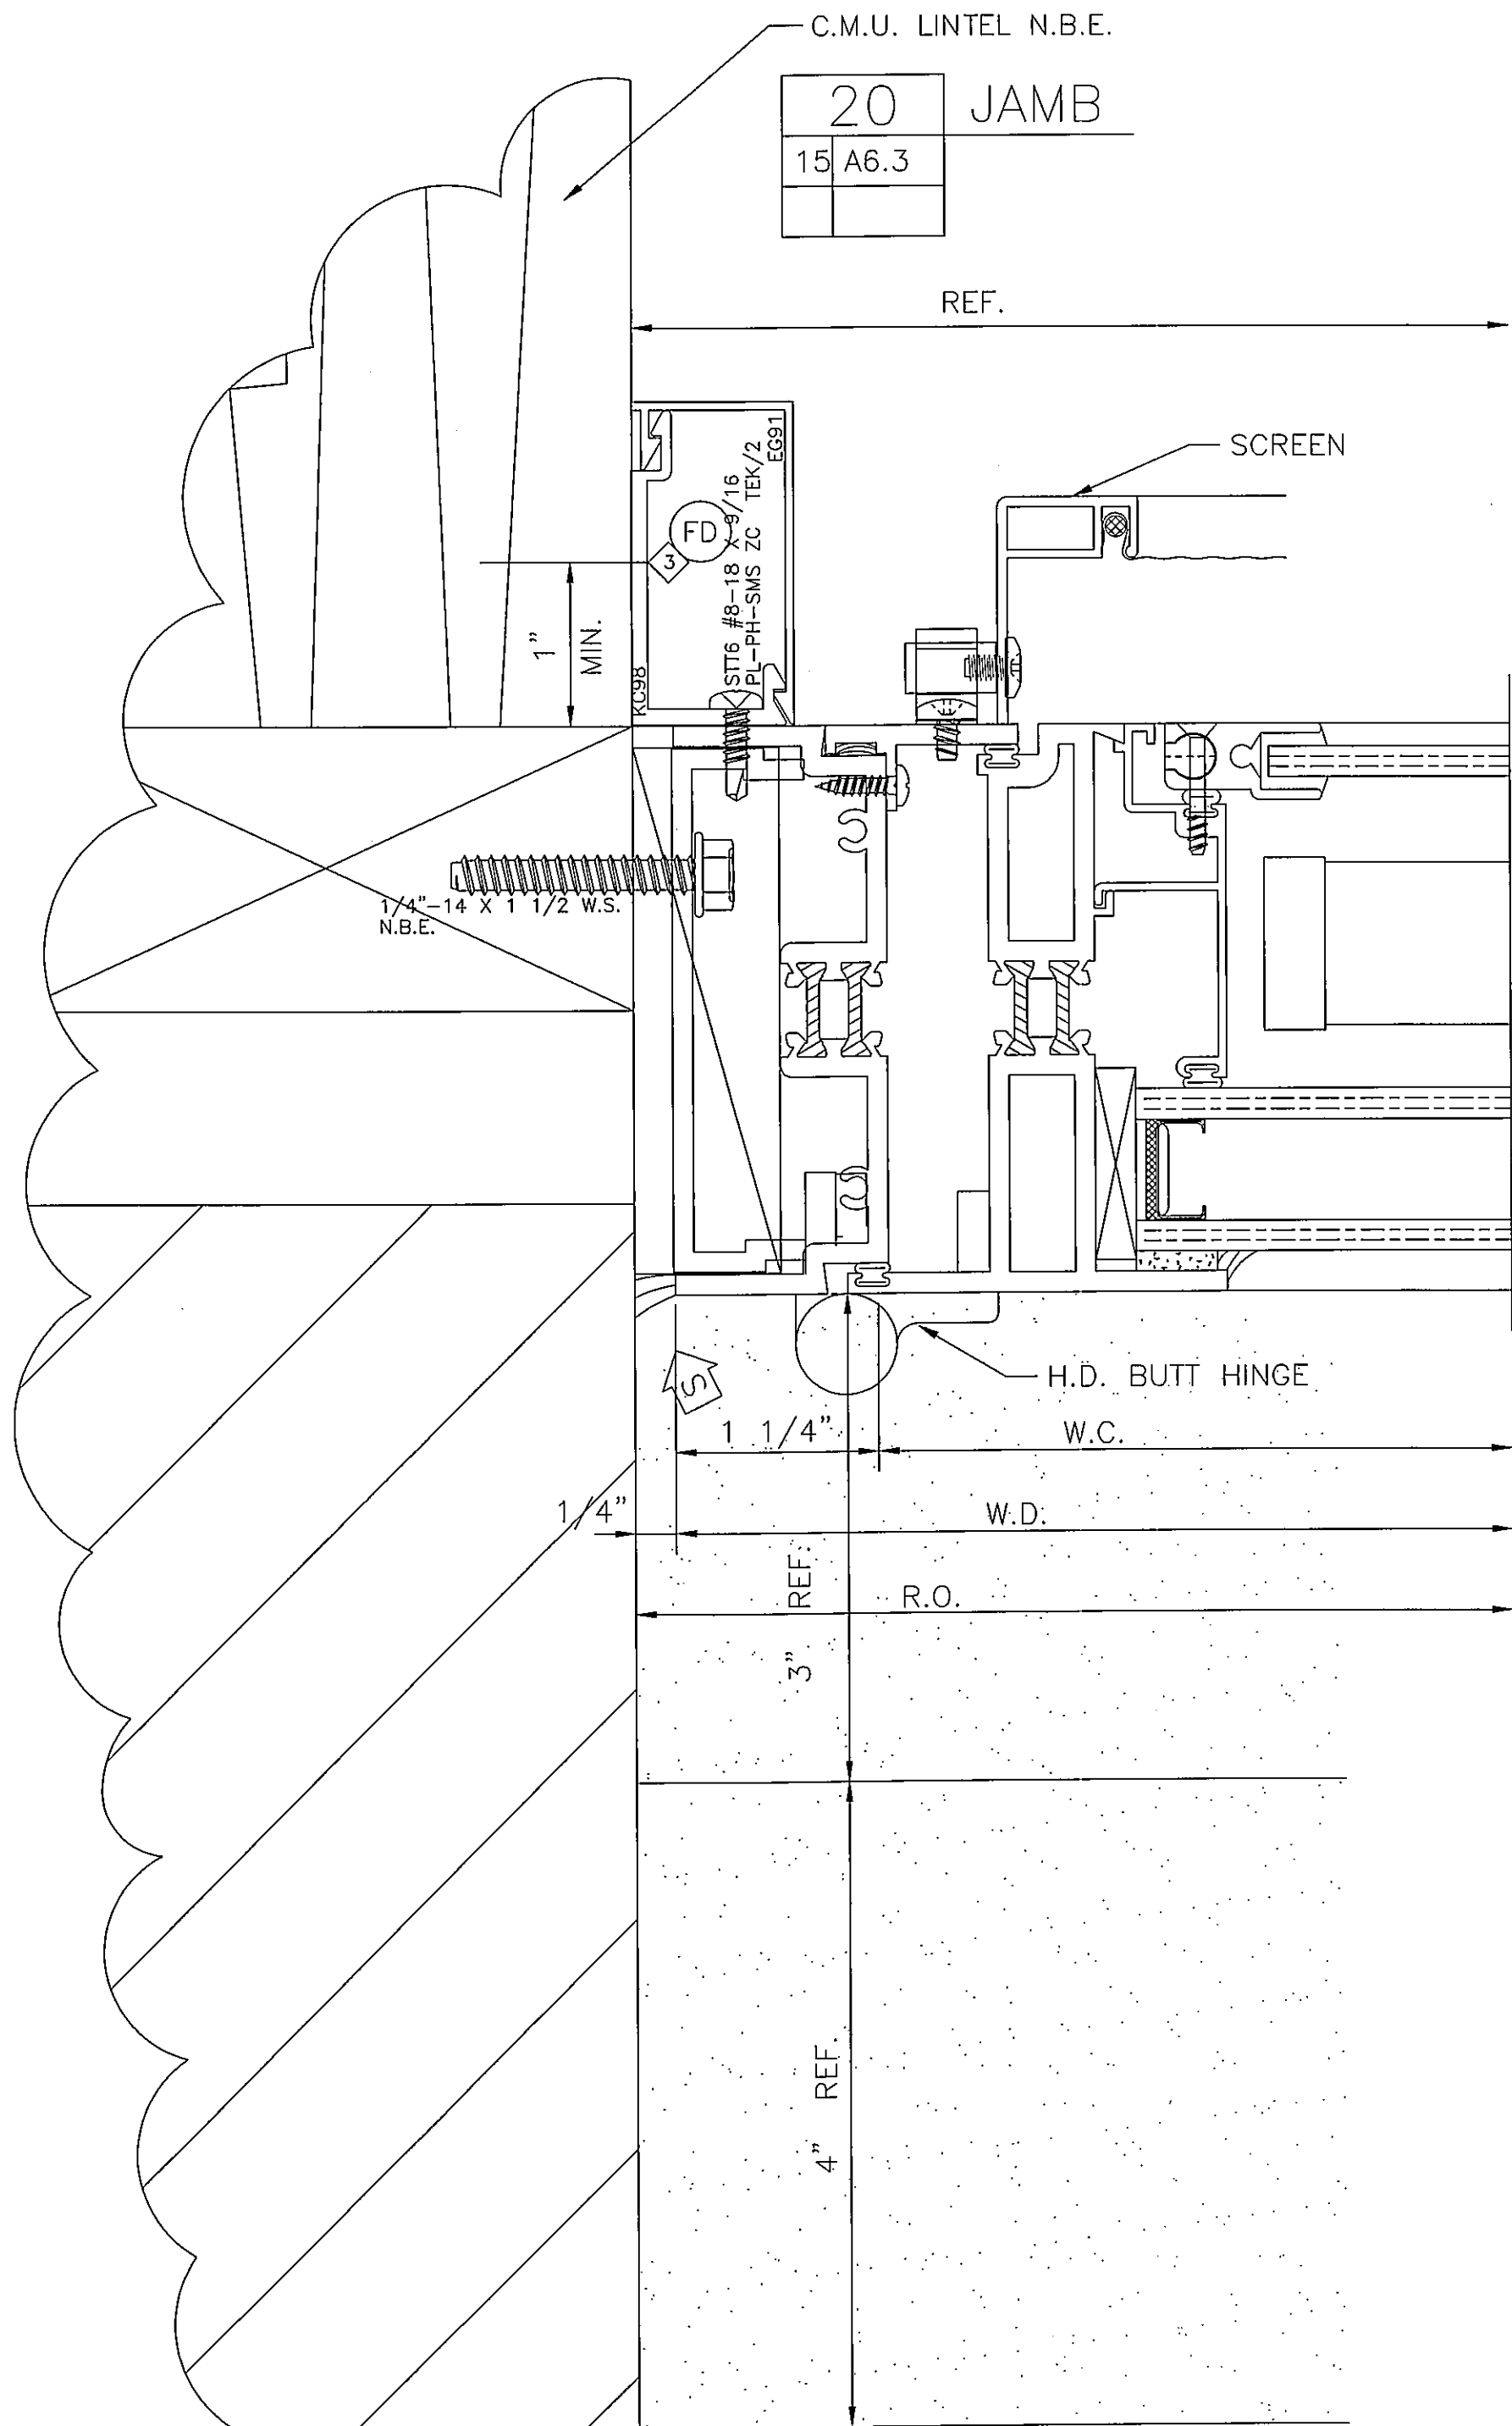

21	SILL
12	A6.2

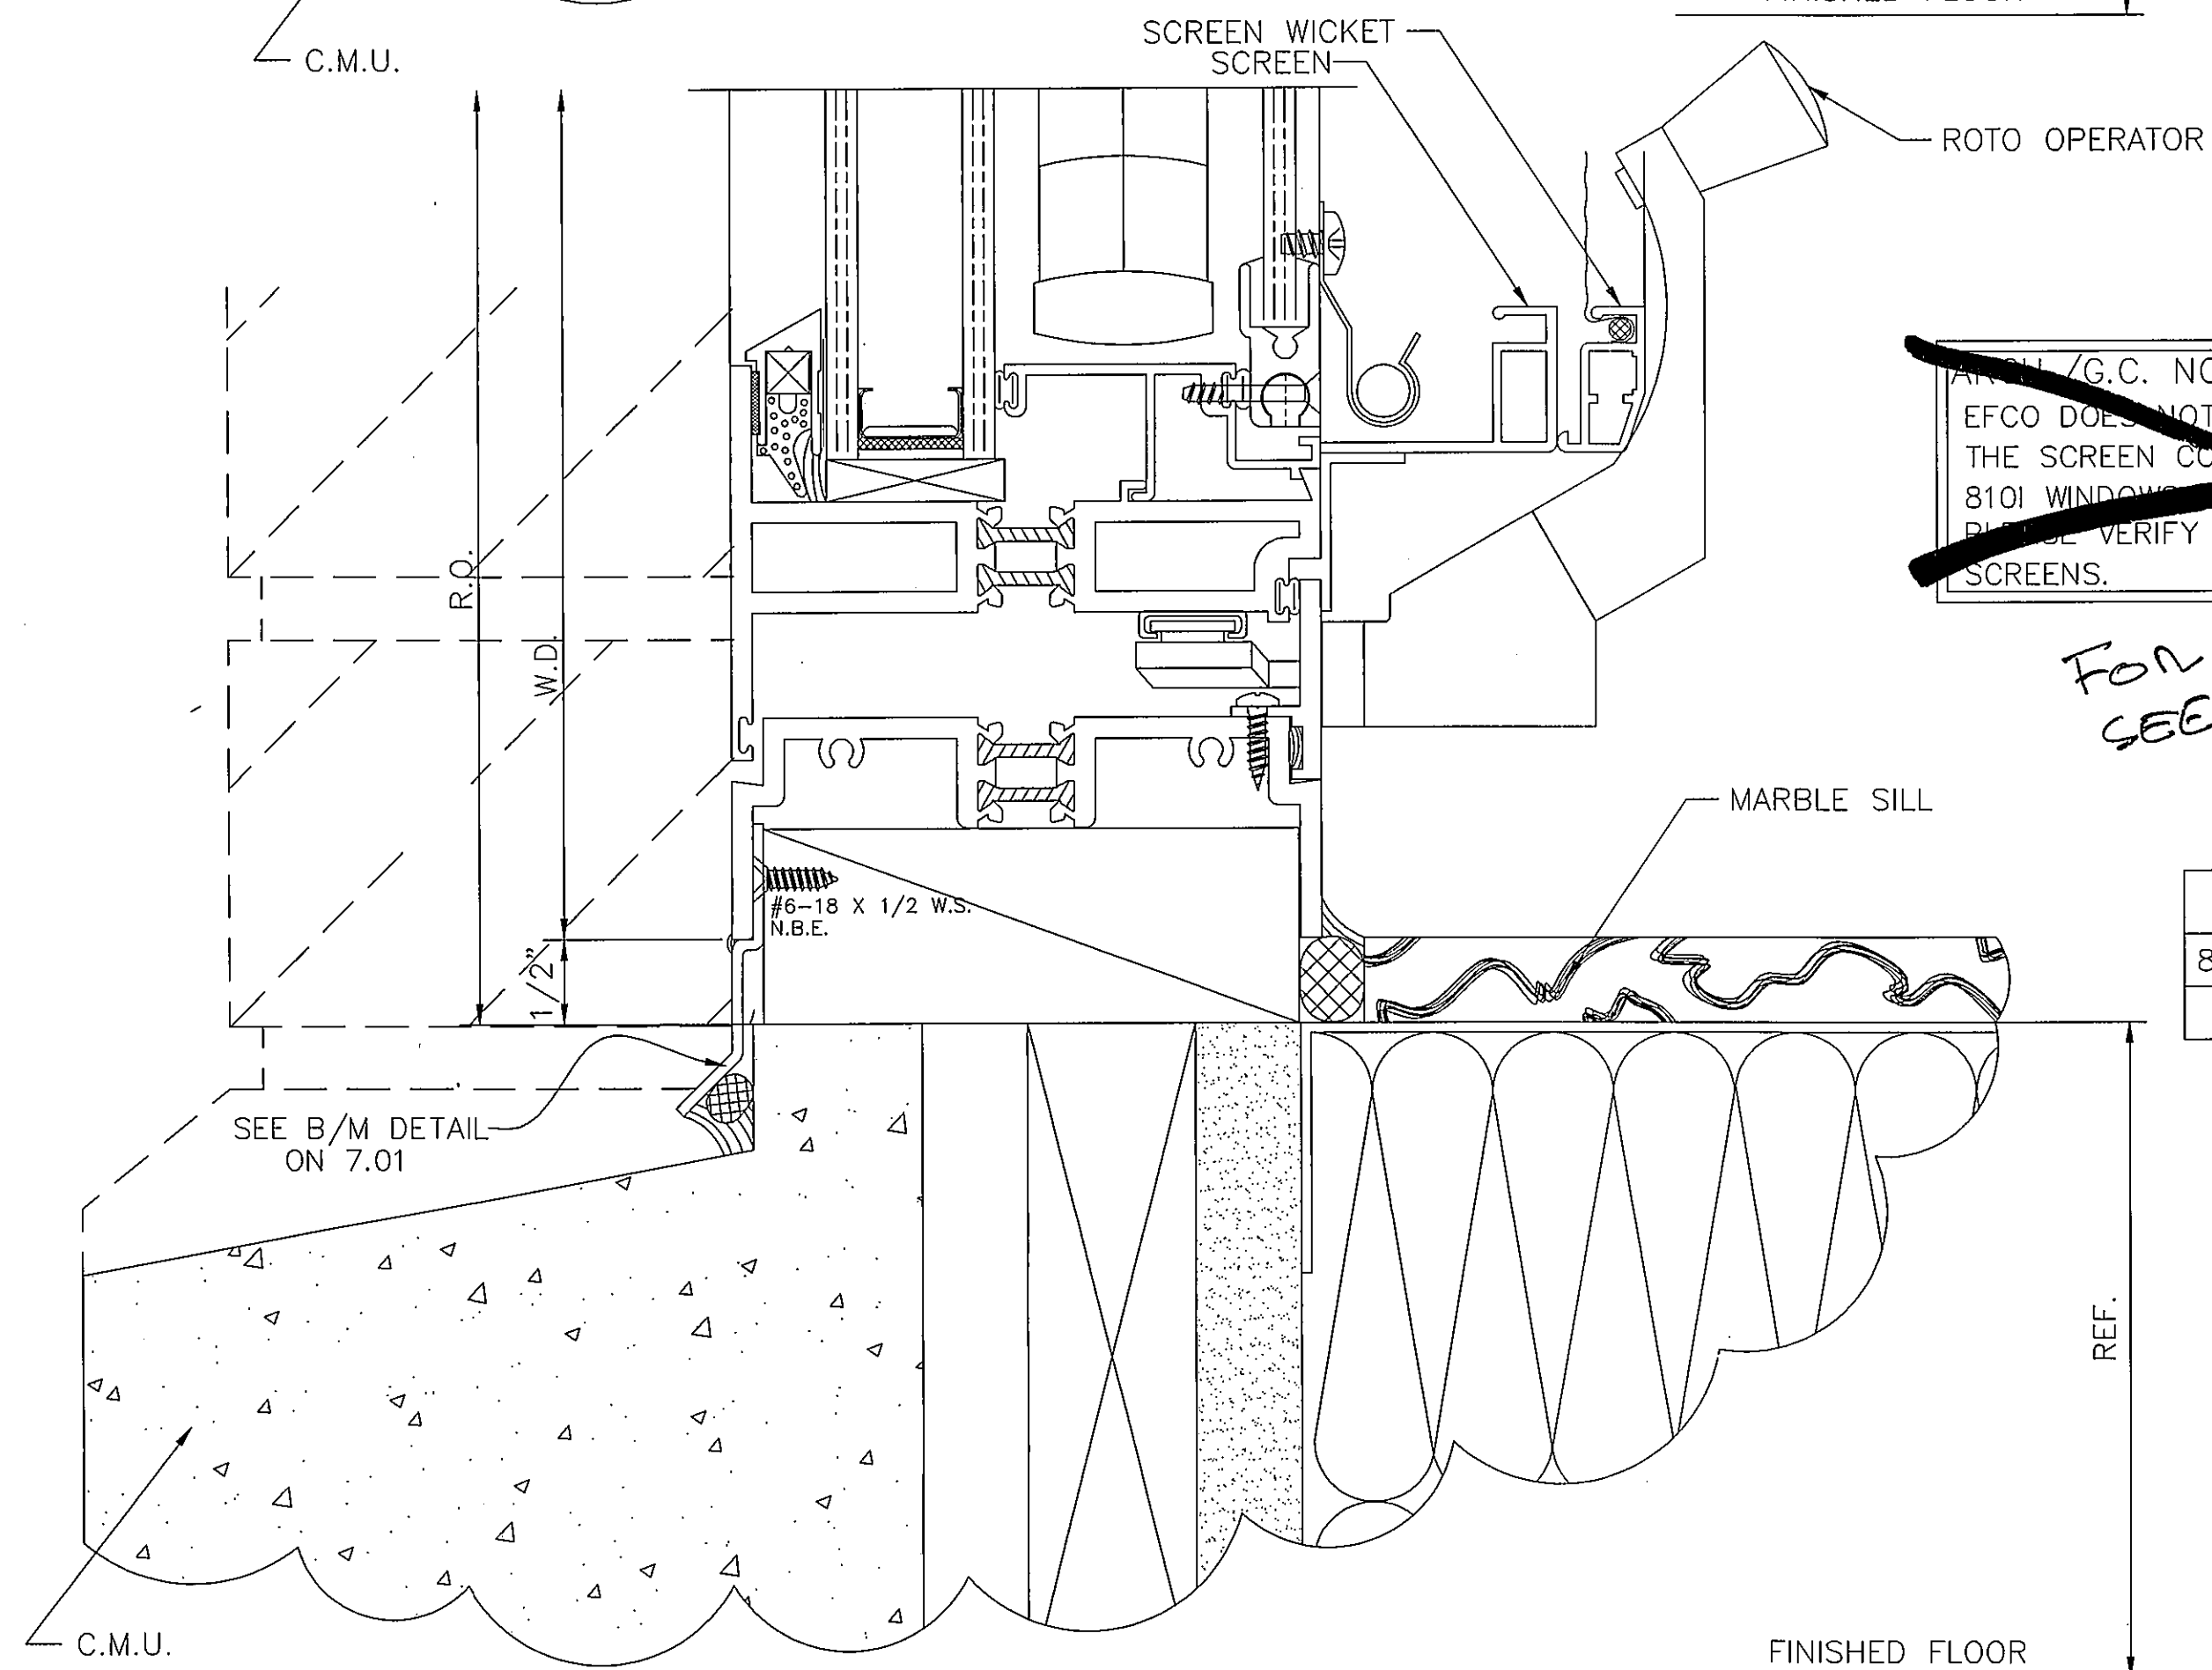

~~EFCO DOES NOT HAVE AN ALTERNATIVE TO~~
~~THE SCREEN CONFIGURATION SHOWN ON THE~~
~~8101 WINDOW DETAIL AND ROTO'S.~~
~~PLEASE VERIFY THE USE OF THE CURRENT~~
~~SCREENS.~~

FOR SCREEN DETAIL
 SEE 10/704

14	SILL
8	A6.2