


SEE DWG. NO. 72703E01 FOR CONTINUATION


SEE DWG. NO. 72703E07 FOR CONTINUATION

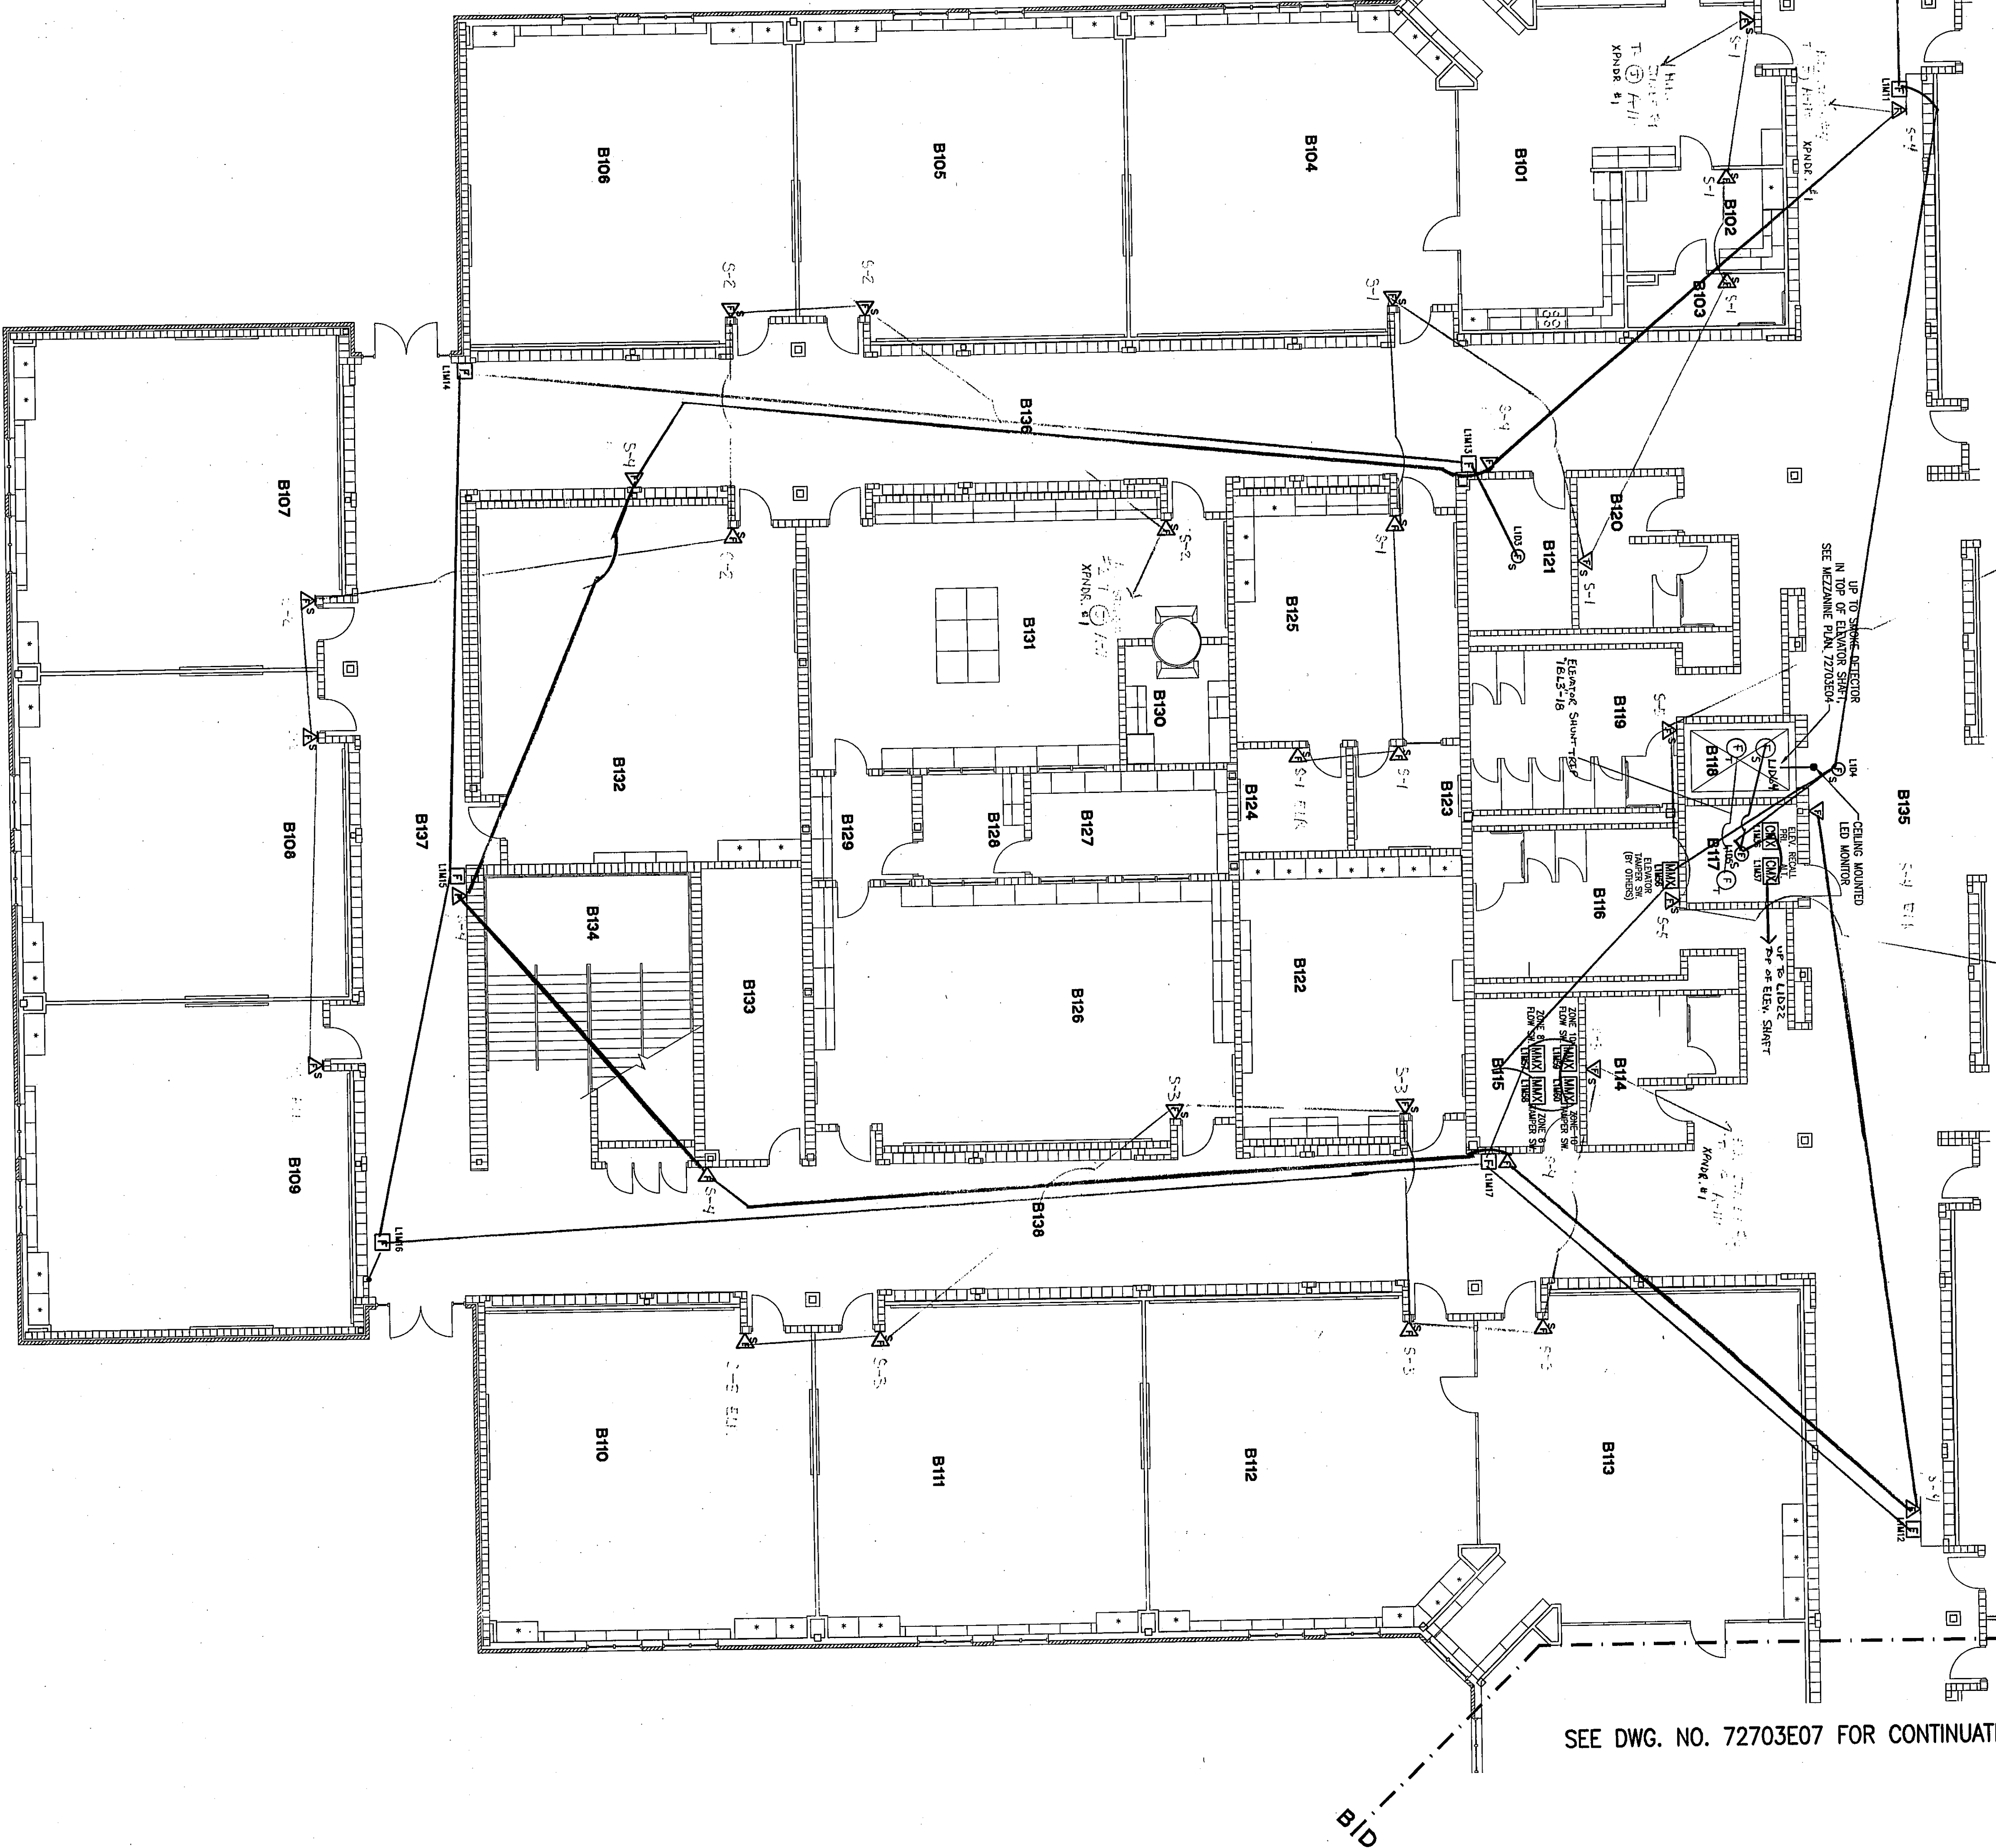

LEGEND

- SYM DESCRIPTION
- [FP] FIRE ALARM PANEL
 - [AH] FIRE ANNUNCIATOR
 - [M] MANUAL PULL STATION
 - [K] ALARM HORN/STROBE
 - [K] ALARM HORN/STROBE, WEATHERPROOF
 - [K] ALARM STROBE
 - [K] ALARM SPEAKER
 - [G] SMOKE DETECTOR
 - [G] HEAT DETECTOR
 - [E] DUCT MOUNTED SMOKE DETECTOR
 - [E] DUCT MOUNTED SMOKE DETECTOR WITH INTEGRAL RELAY
 - [M] MONITORING LED
 - [CM] CONTROL MODULE
 - [LM] MONITOR MODULE
 - [J] Junction Box

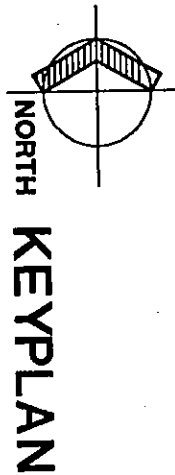

NORTH KEYPLAN

REFERENCE DRAWINGS			
DWG. NO.	DESCRIPTION	DATE	BY
72703E01	FIRE ALARM WIRING RISER DIAGRAM	7/16/98	J. J. GAWRYSIAK
72703E03	FIRE ALARM WIRING DETAILS & NOTES	7/16/98	J. J. GAWRYSIAK
FIRE SYSTEMS			
SCALE: 1/8" = 1'-0"			
DRAWN BY: J. J. GAWRYSIAK			
CHECKED BY: K. A. LUNSTEDT			
DATE: 7/16/98			
DRAWING NO.: 72703E03			
SHEET NO.: 1 OF 1			