

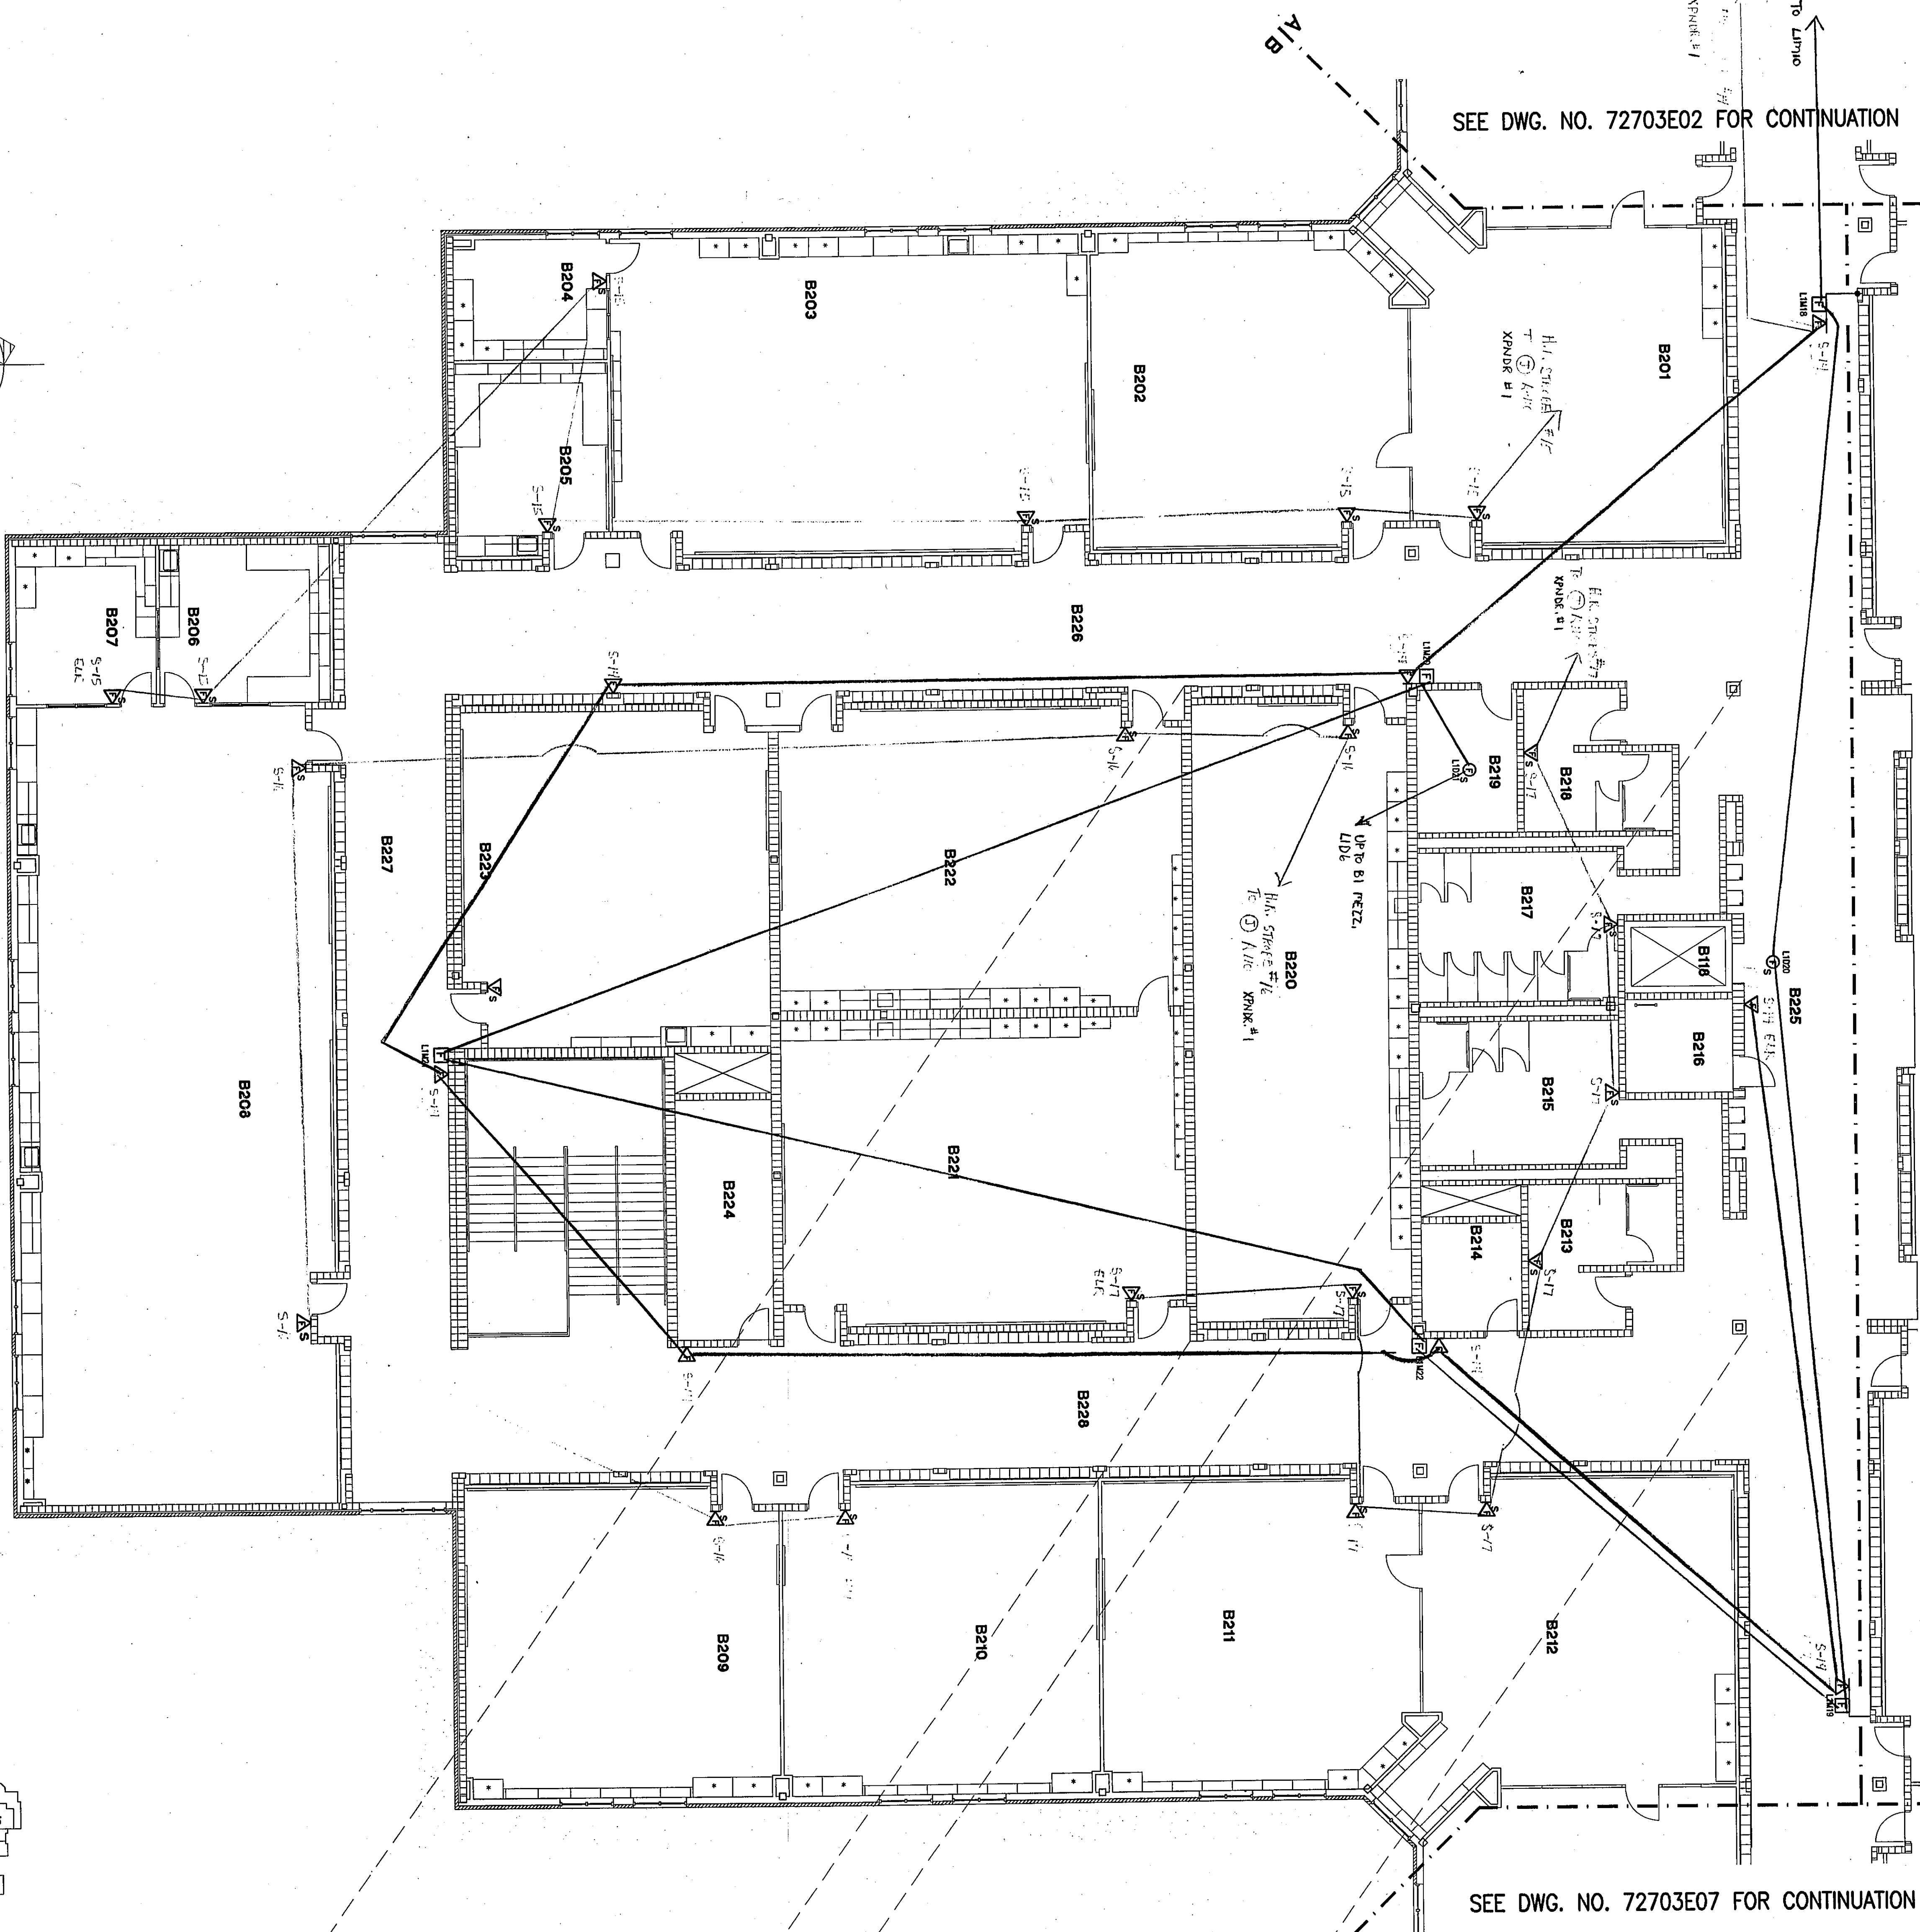


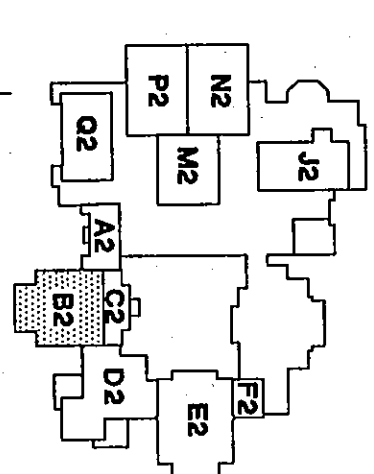

AUXILIARY PLAN UNIT B2

SCALE 1/8" = 1'-0"

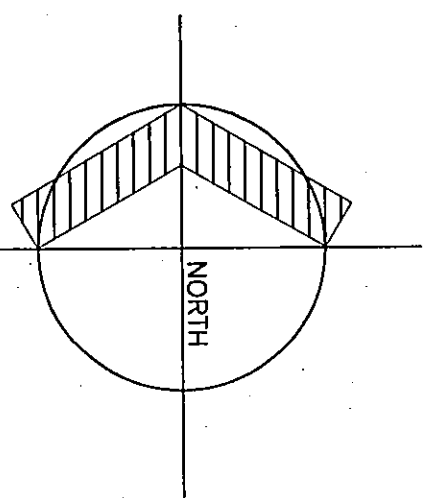


KEY PLAN

0 1 2 4 8 16
1/8" = 1'-0"

ROOM LEGEND B2


- LEGEND**
- SYN DESCRIPTION
 - EXP FIRE ALARM PANEL
 - EXP FIRE ANNUNCIATOR
 - MAN FIRE ALARM STATION
 - MANUAL PULL STATION
 - ALARM HORN/STROBE, WEATHERPROOF
 - ALARM STROBE
 - ALARM SPEAKER
 - SMOKE DETECTOR
 - HEAT DETECTOR
 - DUCT MOUNTED SMOKE DETECTOR
 - DUCT MOUNTED SMOKE DETECTOR WITH INTEGRAL RELAY
 - MONITORING LED
 - CONTROL MODULE
 - MONITOR MODULE

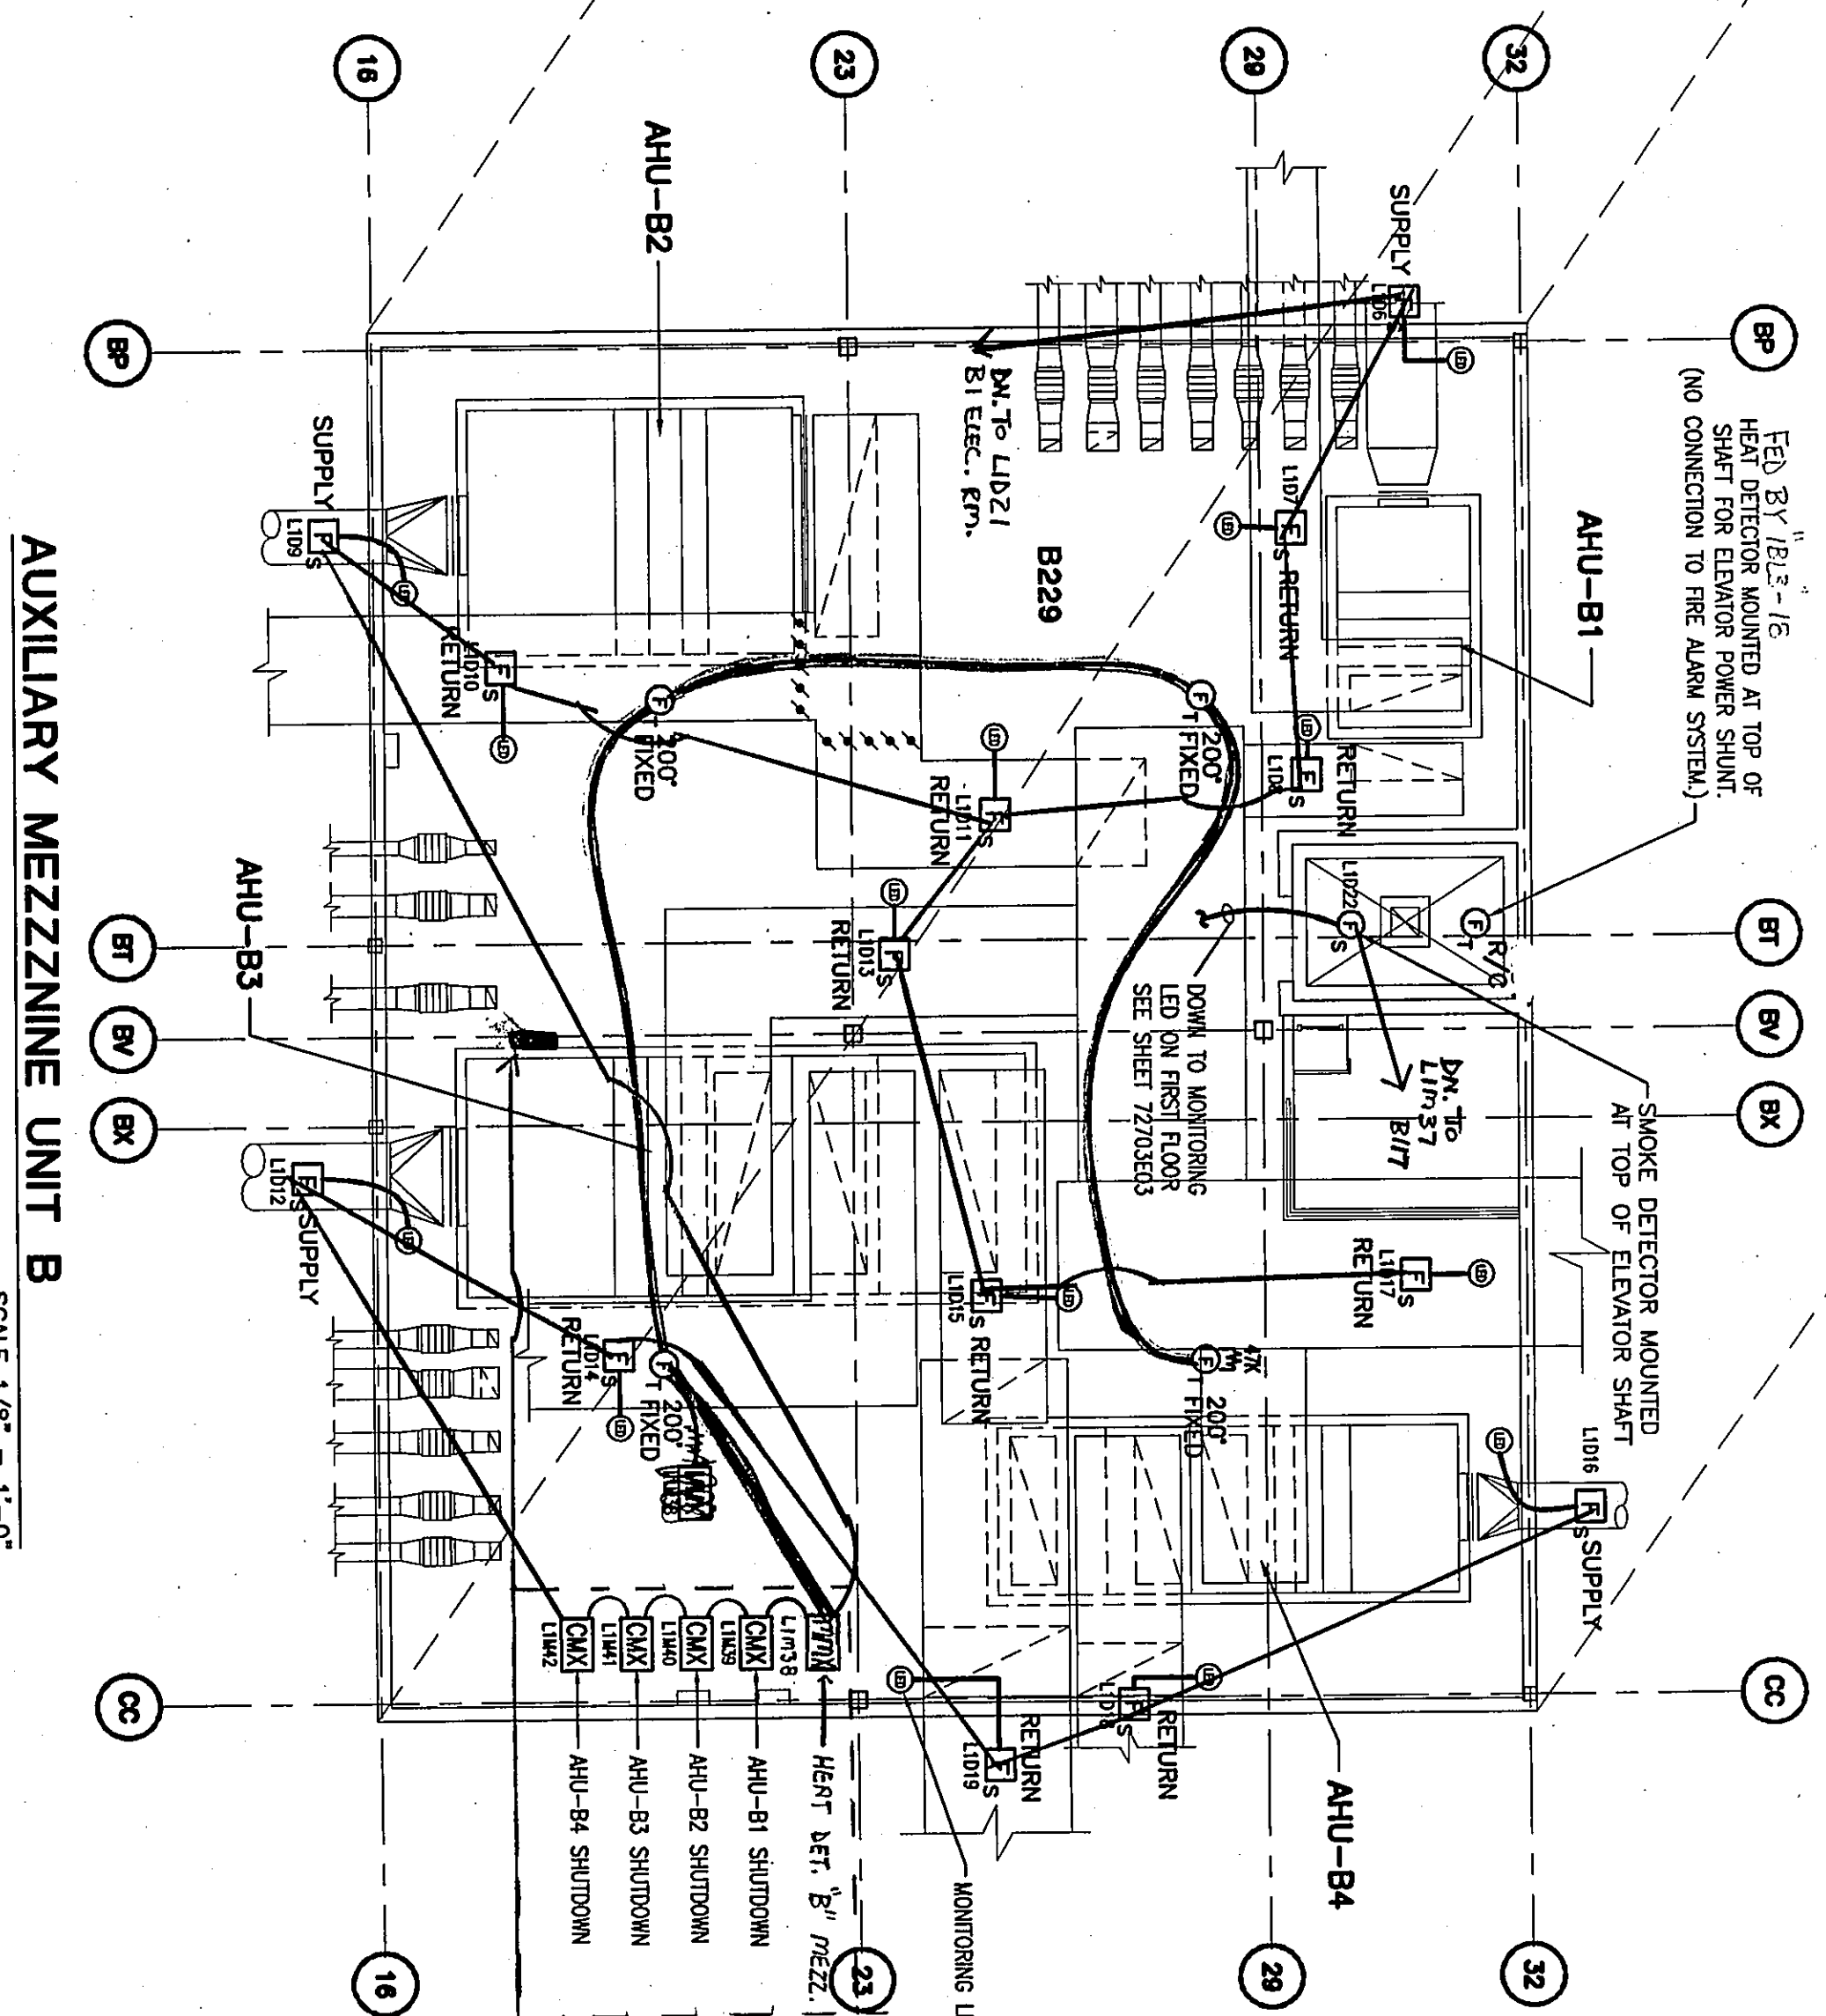

AUXILIARY MEZZANINE UNIT B

SCALE 1/8" = 1'-0"

NO.	DATE	BY	REVISIONS
0	11/17/98	WJL	ISSUED FOR CONSTRUCTION
1	6/13/98	WJL	REVISED PER RFI COMMENTS
2	7/16/98	WJL	ISSUED FOR REVIEW

DWG. NO.	DESCRIPTION	DATE	BY	REVISIONS
72703E02	FIRE ALARM WIRING FIRST FLOOR	7/16/98	WJL	ISSUED FOR REVIEW
72703E03	FIRE ALARM WIRING DETAILS & NOTES	7/16/98	WJL	ISSUED FOR REVIEW

DWG. NO.	DESCRIPTION	DATE	BY	REVISIONS
72703E04	FIRE ALARM & DETECTION SYSTEM UNIT B2	7/16/98	WJL	ISSUED FOR REVIEW

72703E04

CHESTERION HIGH SCHOOL

2125 S. 11TH STREET

CHESTERION, INDIANA

FIRE ALARM & DETECTION SYSTEM

UNIT B2

DETAILED LAYOUT

REV. 1 OF 1

SHEET NO.