

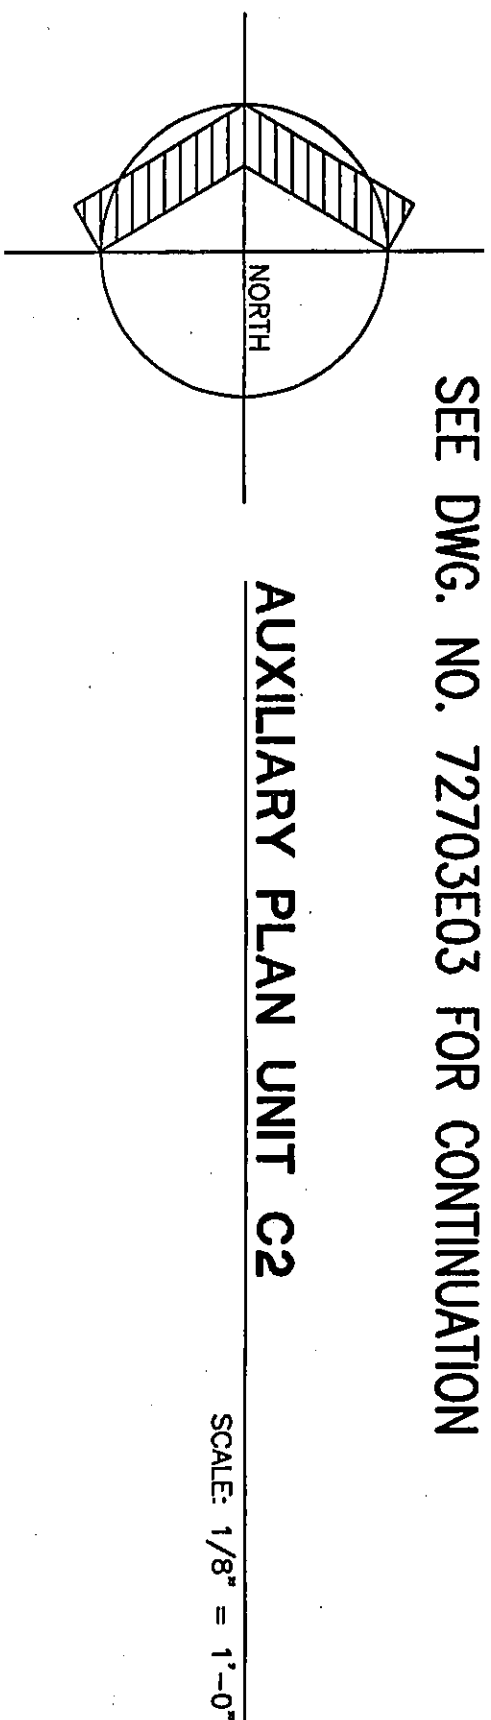
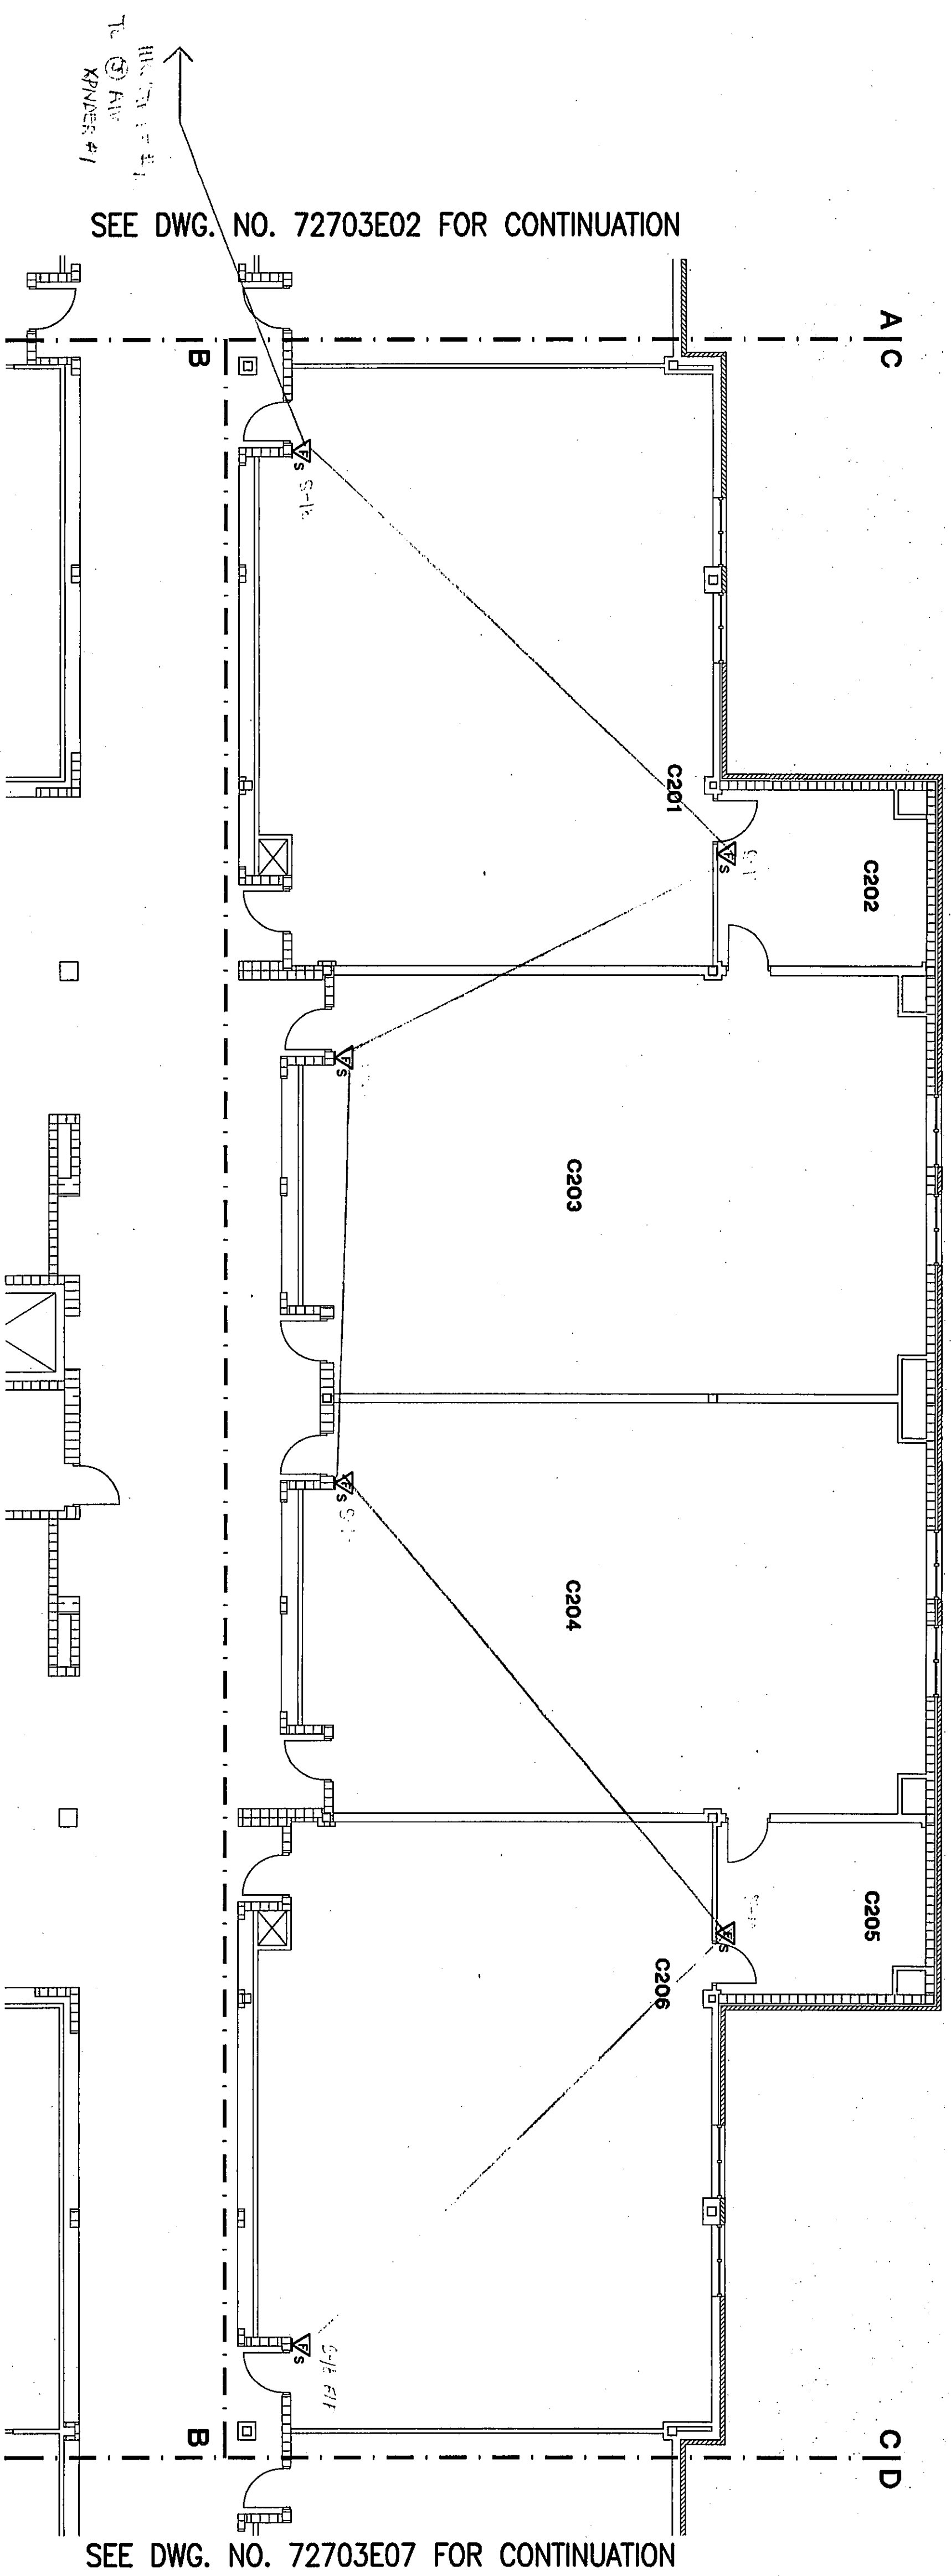


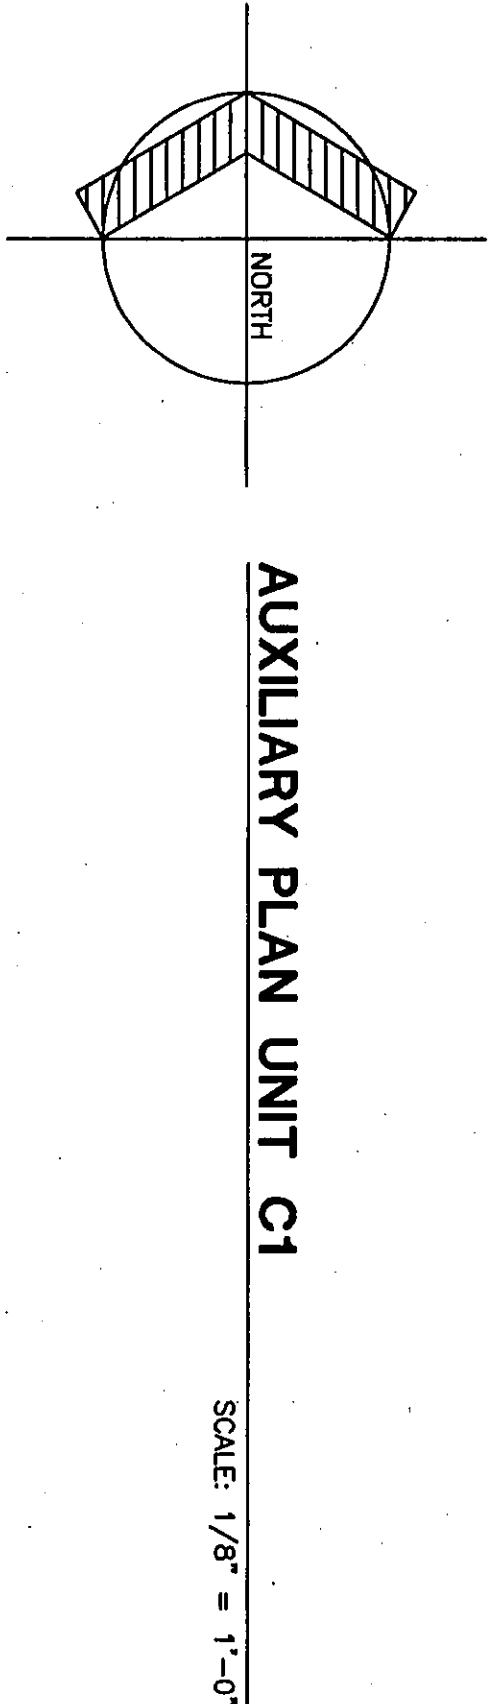

SEE DWG. NO. 72703E03 FOR CONTINUATION

AUXILIARY PLAN UNIT C2

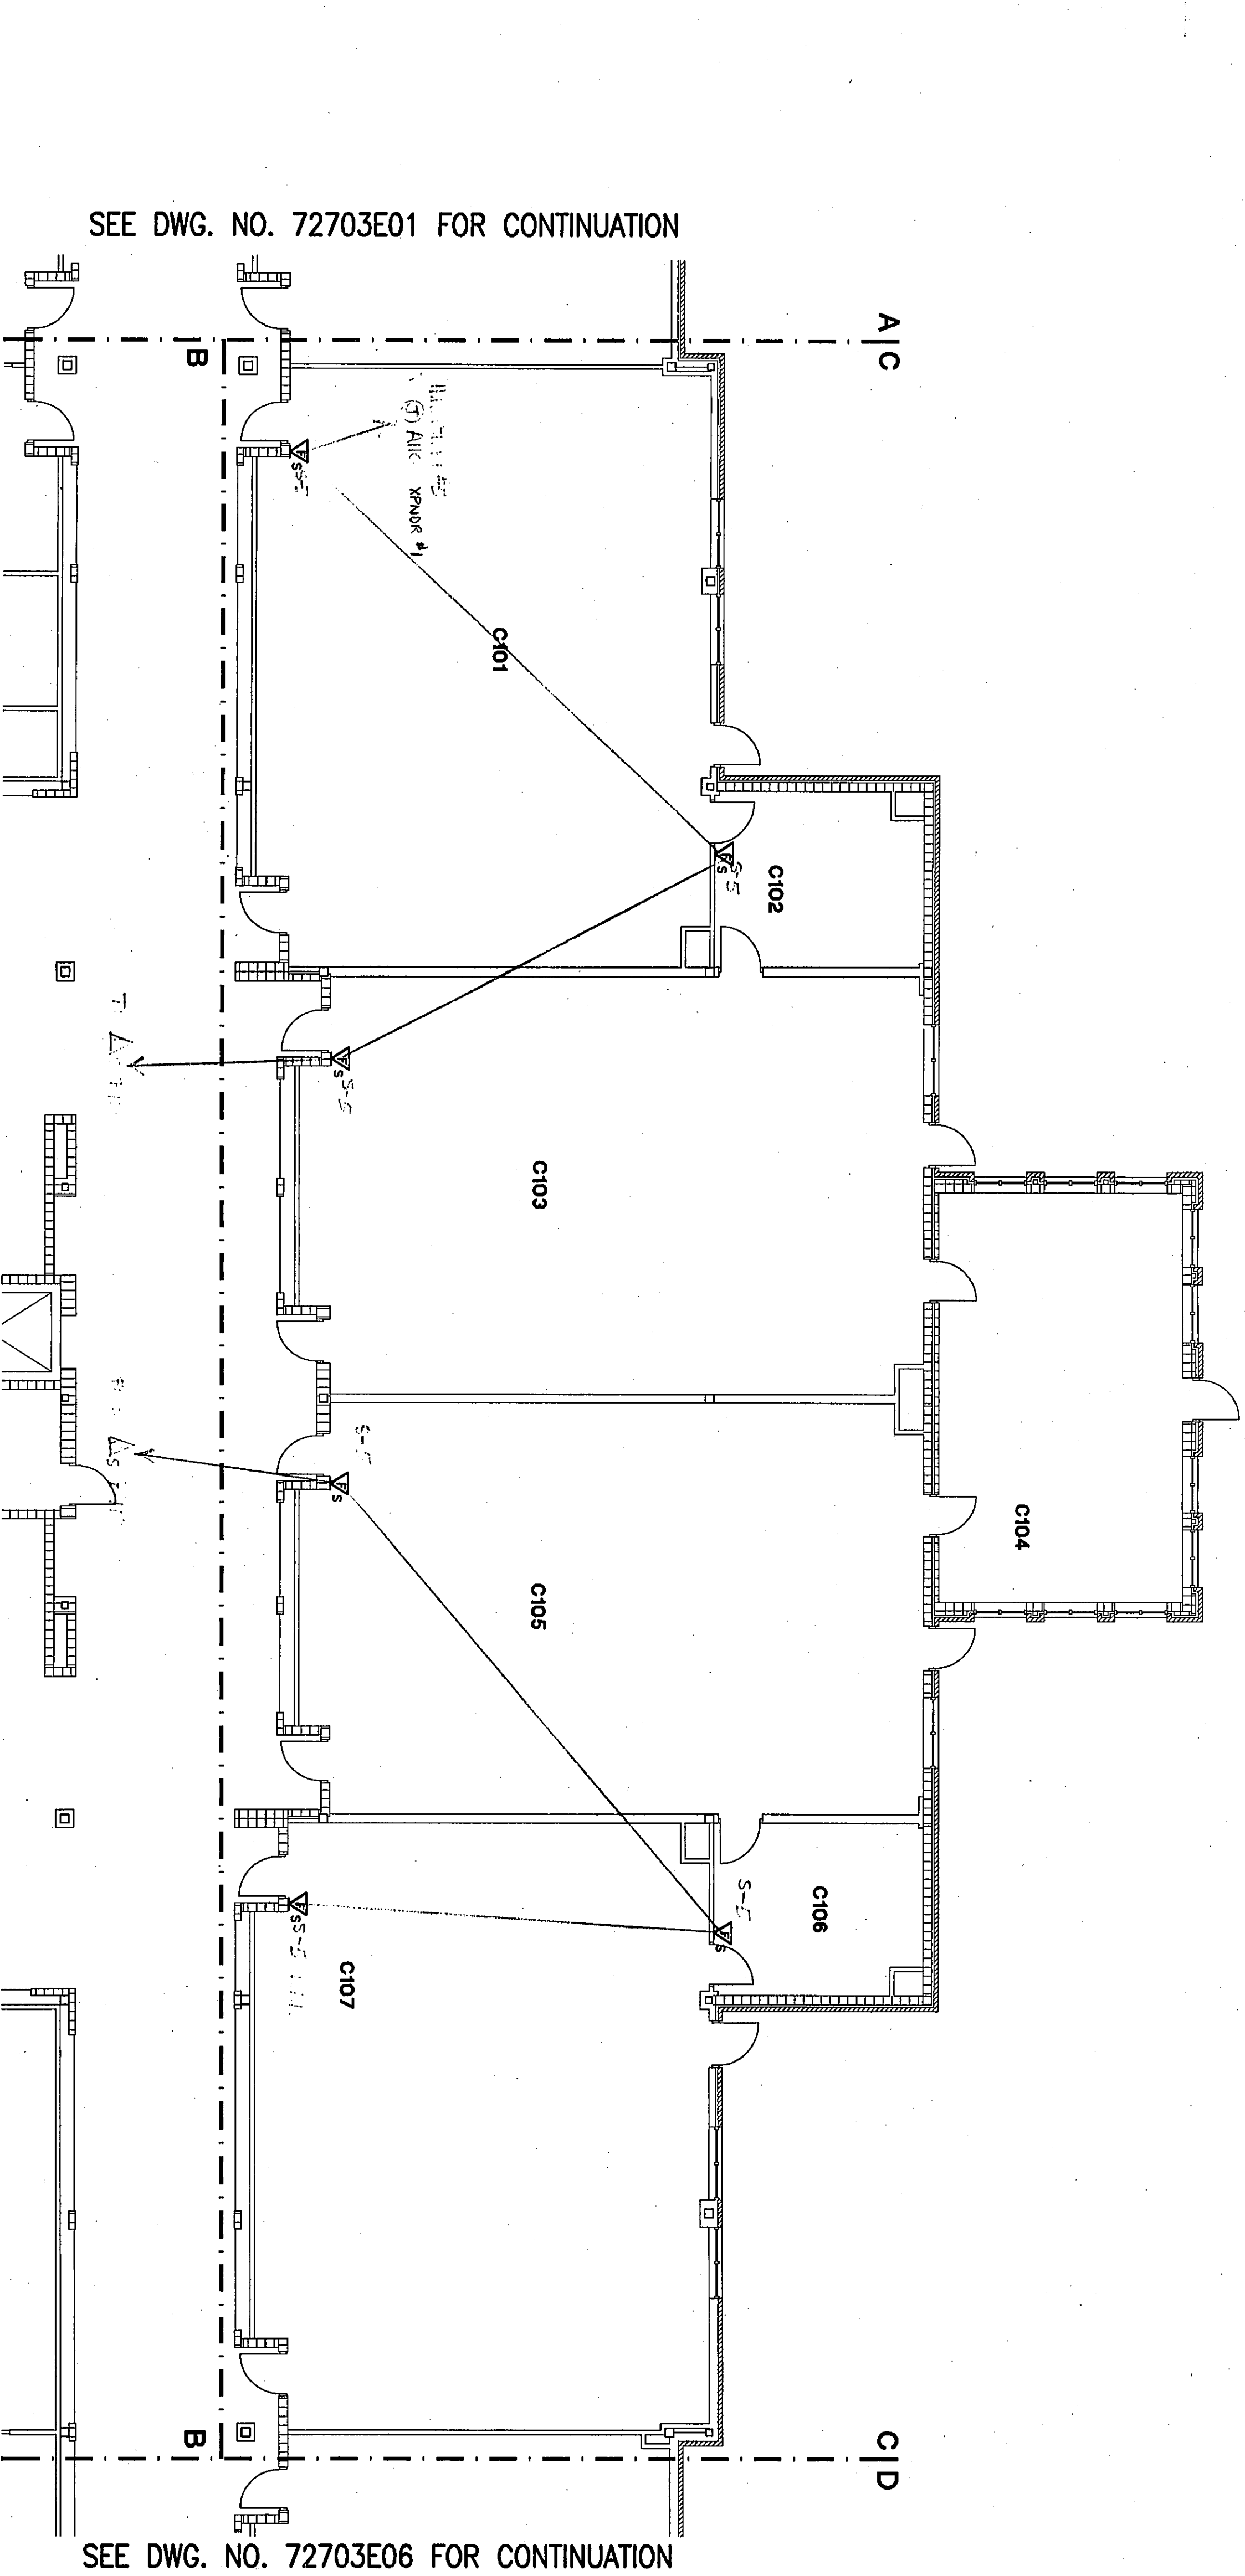



AUXILIARY PLAN UNIT C1

ROOM LEGEND C2		
ROOM NO.	ROOM NAME	AREA S.F.
C201	SCIENCE LAB	1505
C203	SCIENCE LAB	1435
C204	SCIENCE LAB	1435
C206	SCIENCE LAB	1505

- LEGEND**
- SWL DESCRIPTION
- [F2] FIRE ALARM PANEL
 - [F1] FIRE ANNUNCIATOR
 - [F3] MANUAL PULL STATION
 - [F4] ALARM HORN/STROBE
 - [F5] ALARM HORN/STROBE, WEATHERPROOF
 - [F6] ALARM SPEAKER
 - [F7] SMOKE DETECTOR
 - [F8] HEAT DETECTOR
 - [F9] DUCT MOUNTED SMOKE DETECTOR
 - [F10] DUCT MOUNTED SMOKE DETECTOR WITH INTEGRAL RELAY
 - [F11] MONITORING LED
 - [F12] CONTROL MODULE
 - [F13] MONITOR MODULE

ROOM LEGEND C1		
ROOM NO.	ROOM NAME	AREA S.F.
C101	SCIENCE LAB	1509
C102	PREP. ROOM	205
C103	SCIENCE LAB	1441
C104	GREENHOUSE	580
C105	SCIENCE LAB	1441
C106	SCIENCE LAB	1509
C107	SCIENCE LAB	1509

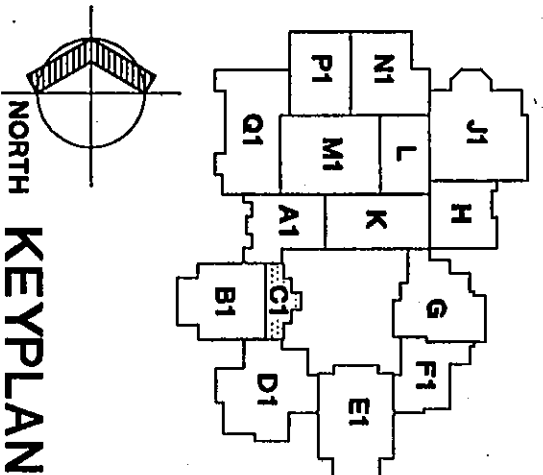

KEYPLAN

REFERENCE DRAWINGS		
DWG. NO.	DESCRIPTION	
72703E05	FIRE ALARM WIRING DETAILS & NOTES	
PROJECT INFORMATION		
PROJECT NO. 72703		1055 W. JOLIET RD. • P.O. BOX 70
DESIGNED BY J. L. CAMPBELL		WALPARK, INDIANA 46385
CHECKED BY K. A. LUNDSTEDT		(210)-402-0071
DATE 7/16/95		
DRAWING NO. 72703E05		
SHEET NO. 1 OF 1		