


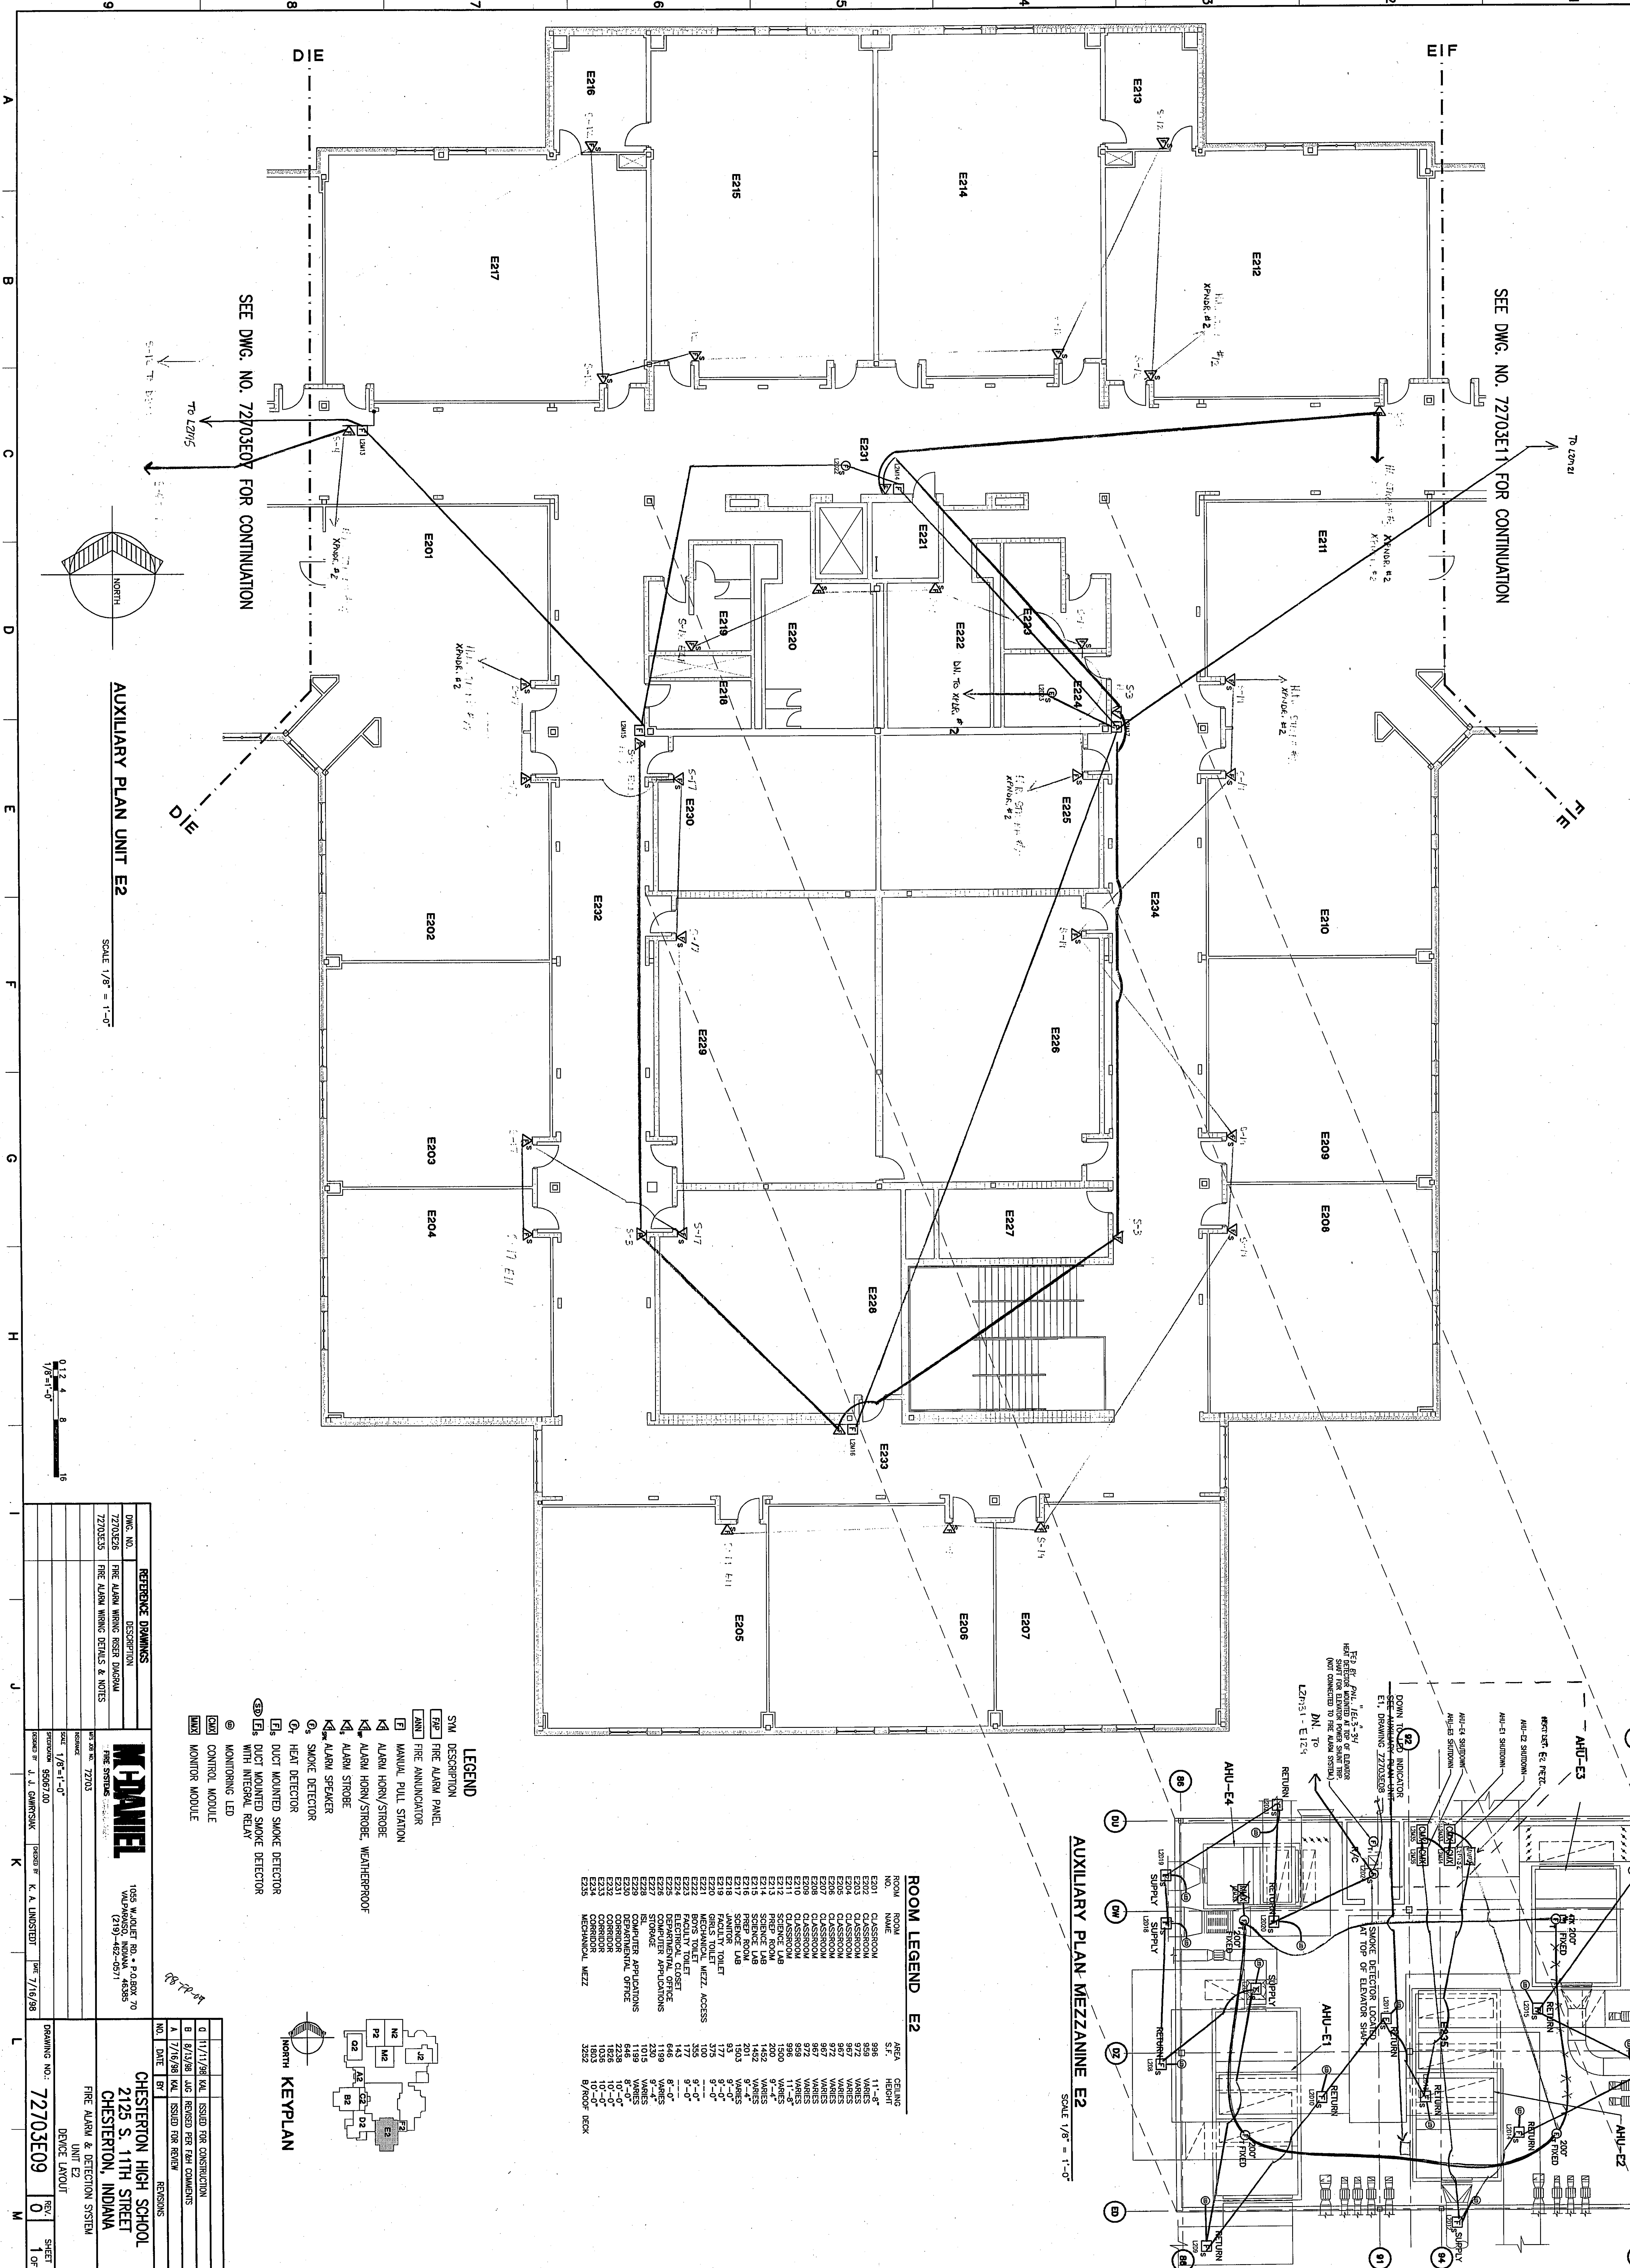

REFERENCE DRAWINGS		REVISIONS	
DWG. NO.	DESCRIPTION	NO.	DATE

--	--

DRAWING NO.: 72703E09	REV. 0	SHEET NO. 1 OF 1
-----------------------	--------	------------------

--	---