
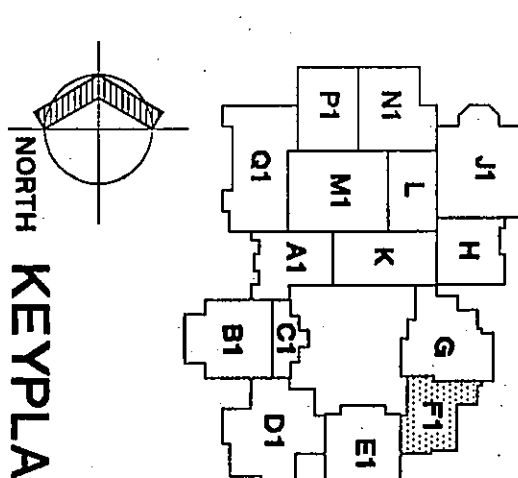


ROOM LEGEND F1			
ROOM NO.	ROOM NAME	AREA SQ. FT.	CEILING HGT.
F101	CLASSROOM	923	9'-4"
F102	RECORDING	33	9'-4"
F103	RECORDING	33	9'-4"
F104	RECORDING	33	9'-4"
F105	VESTIBULE	80	9'-4"
F106	CHILD DEVELOPMENT	534	9'-4"
F107	CHILD DEVELOPMENT	534	9'-4"
SEE DWG. NO. 72703E12 FOR CONTINUATION

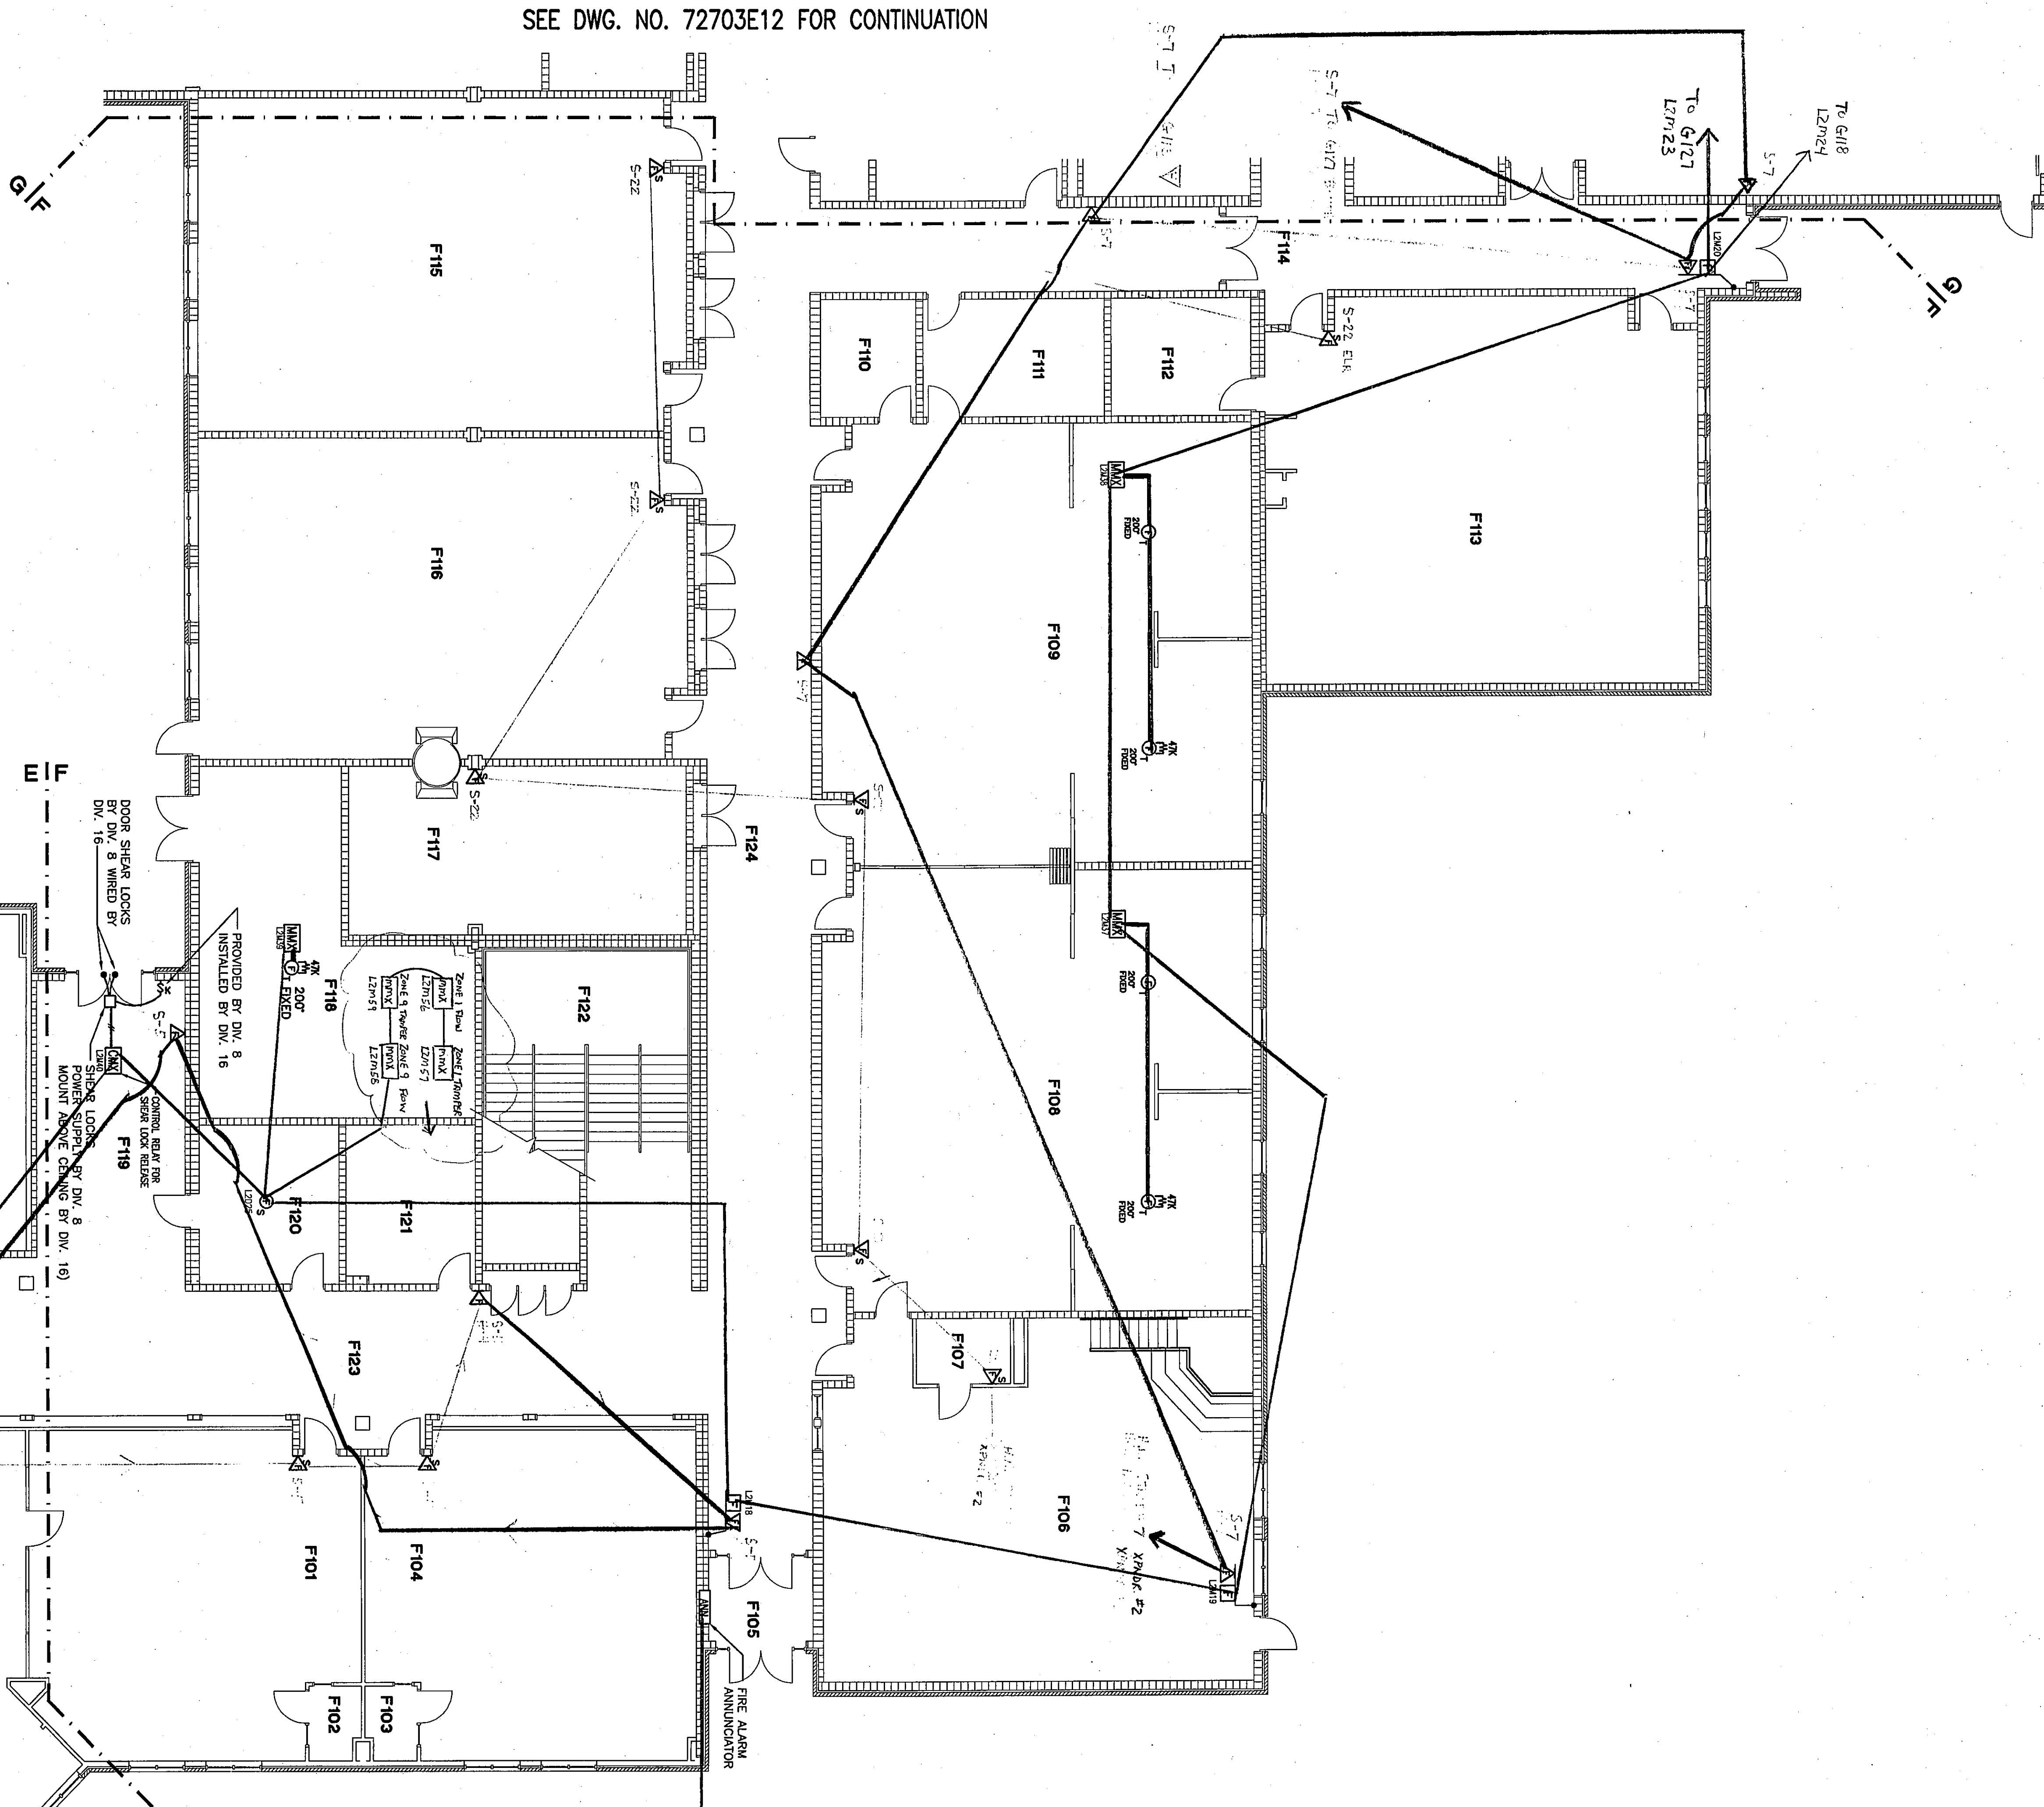

AUXILIARY PLAN UNIT F1

SEE DWG. NO. 72703E08 FOR CONTINUATION

SCALE 1/8" = 1'-0"

0 12 24 23