

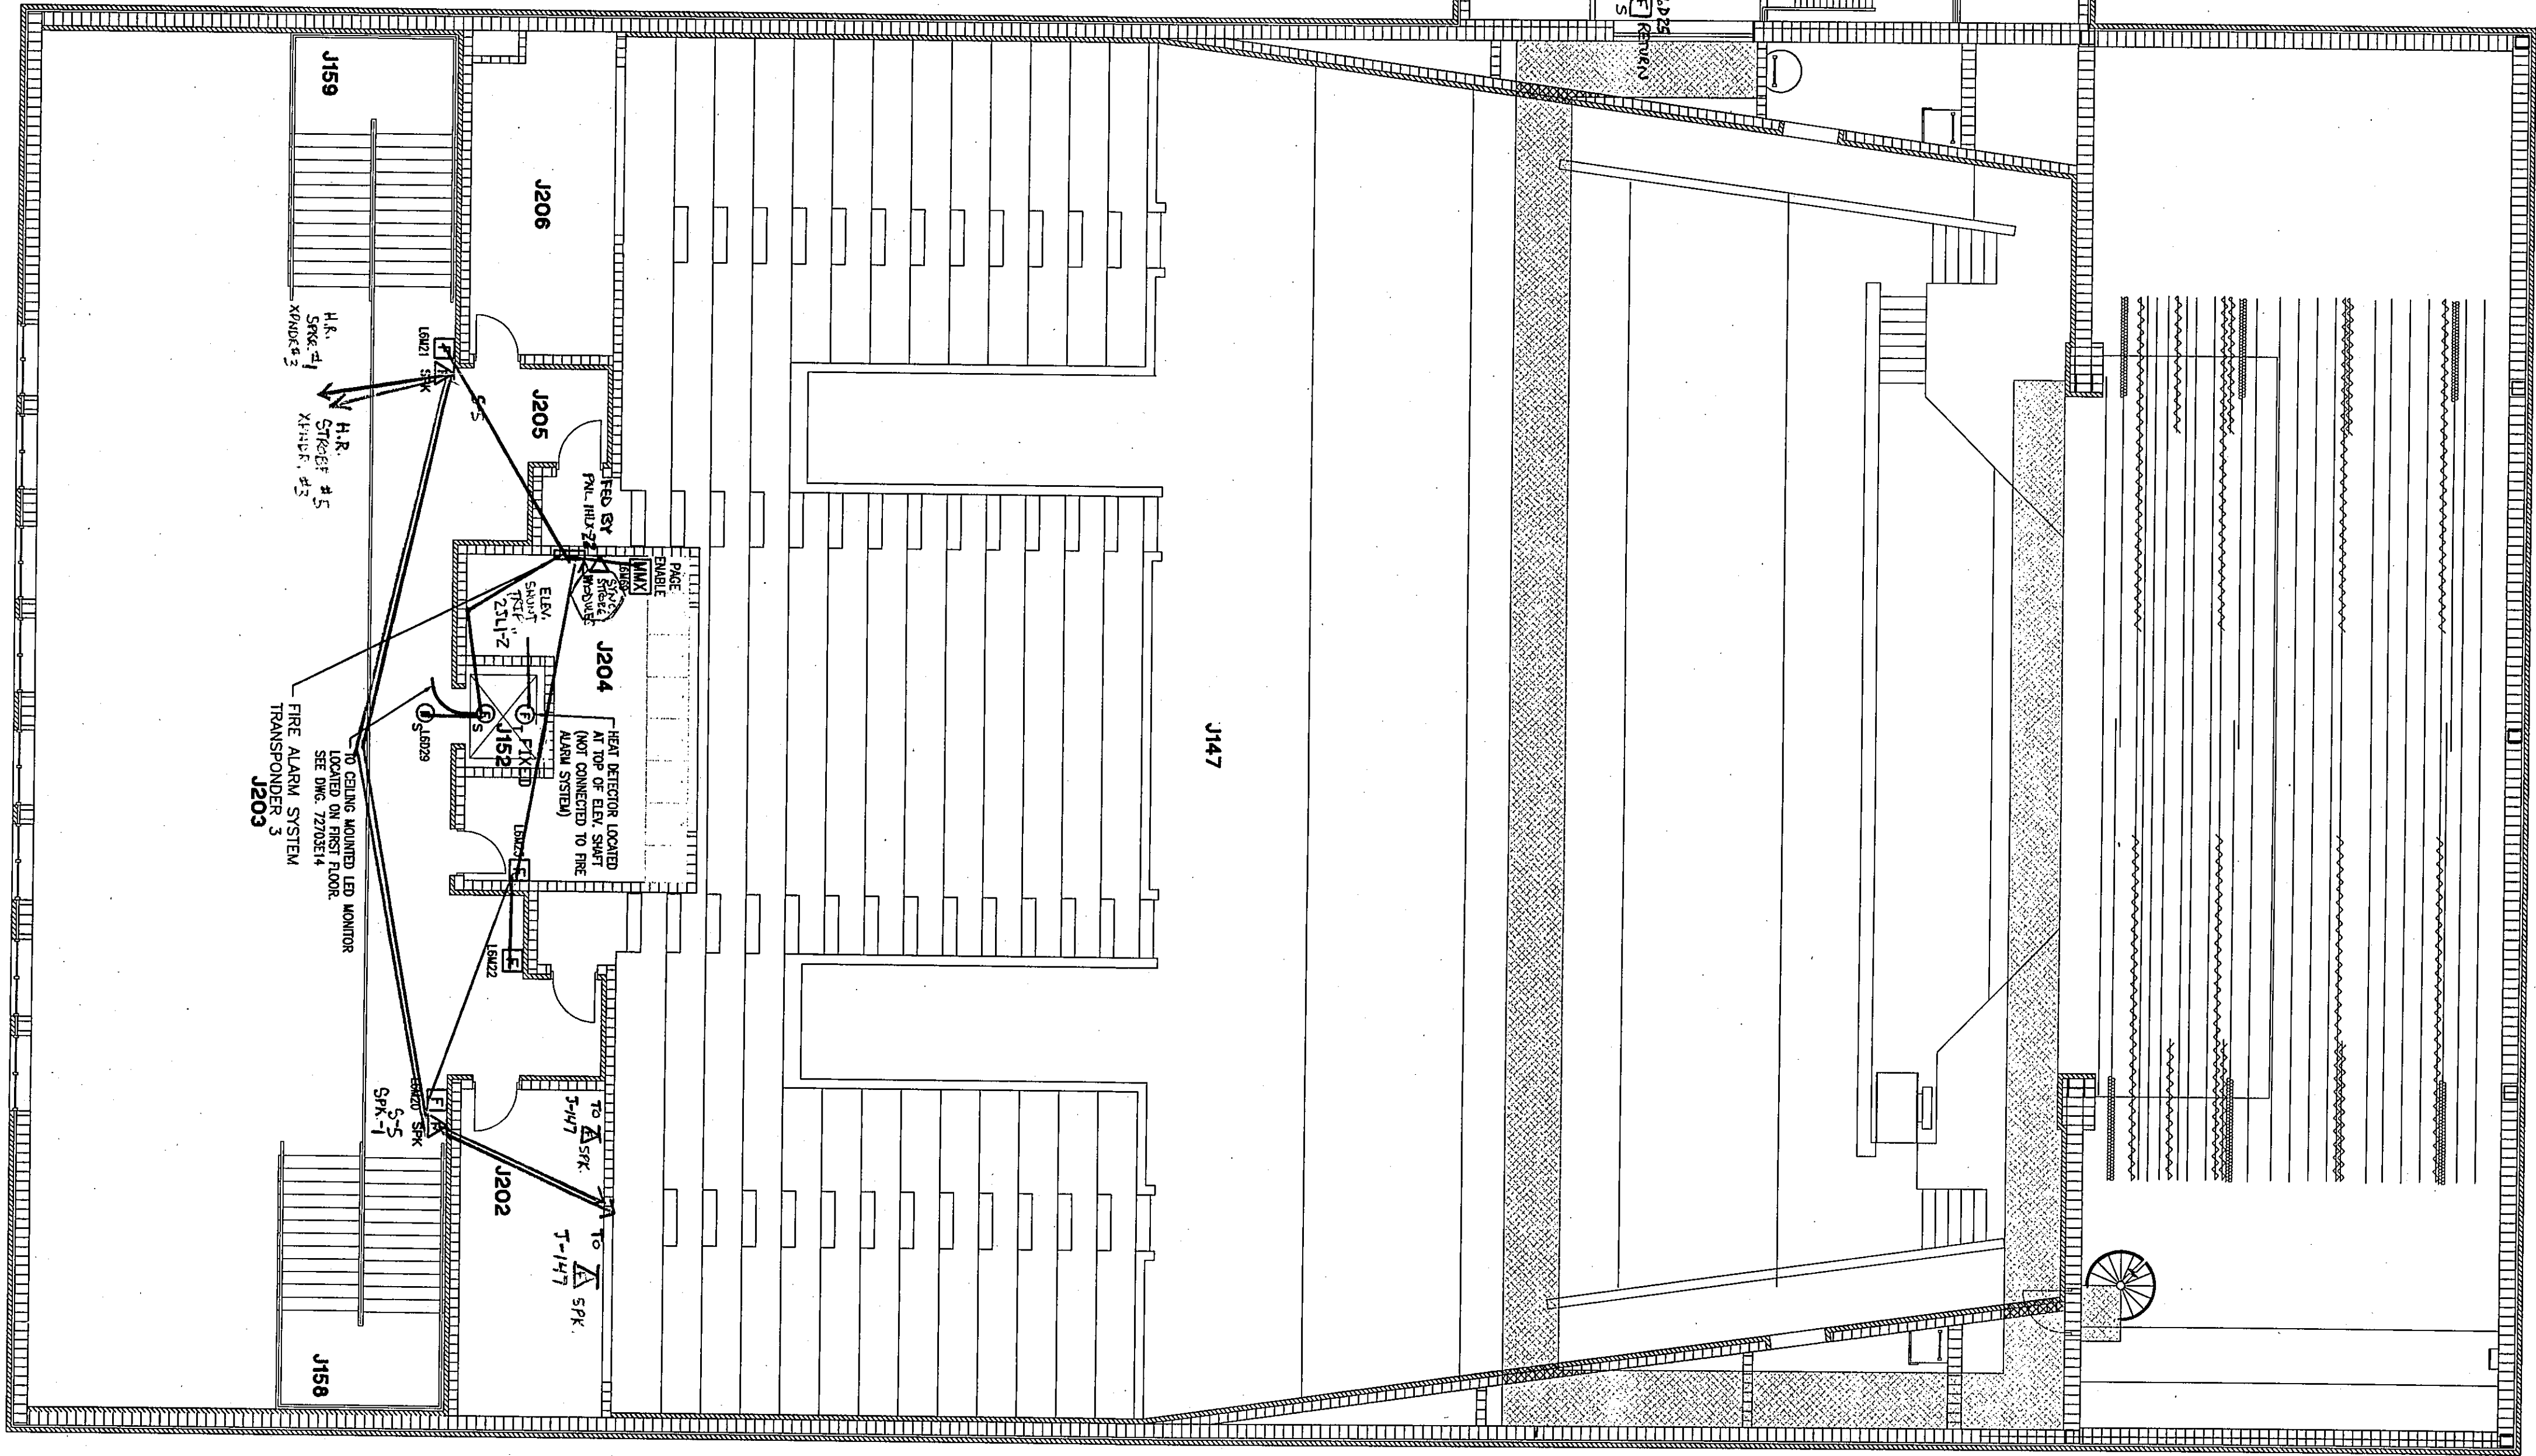


ROOM LEGEND J2		
ROOM NO.	ROOM NAME	AREA

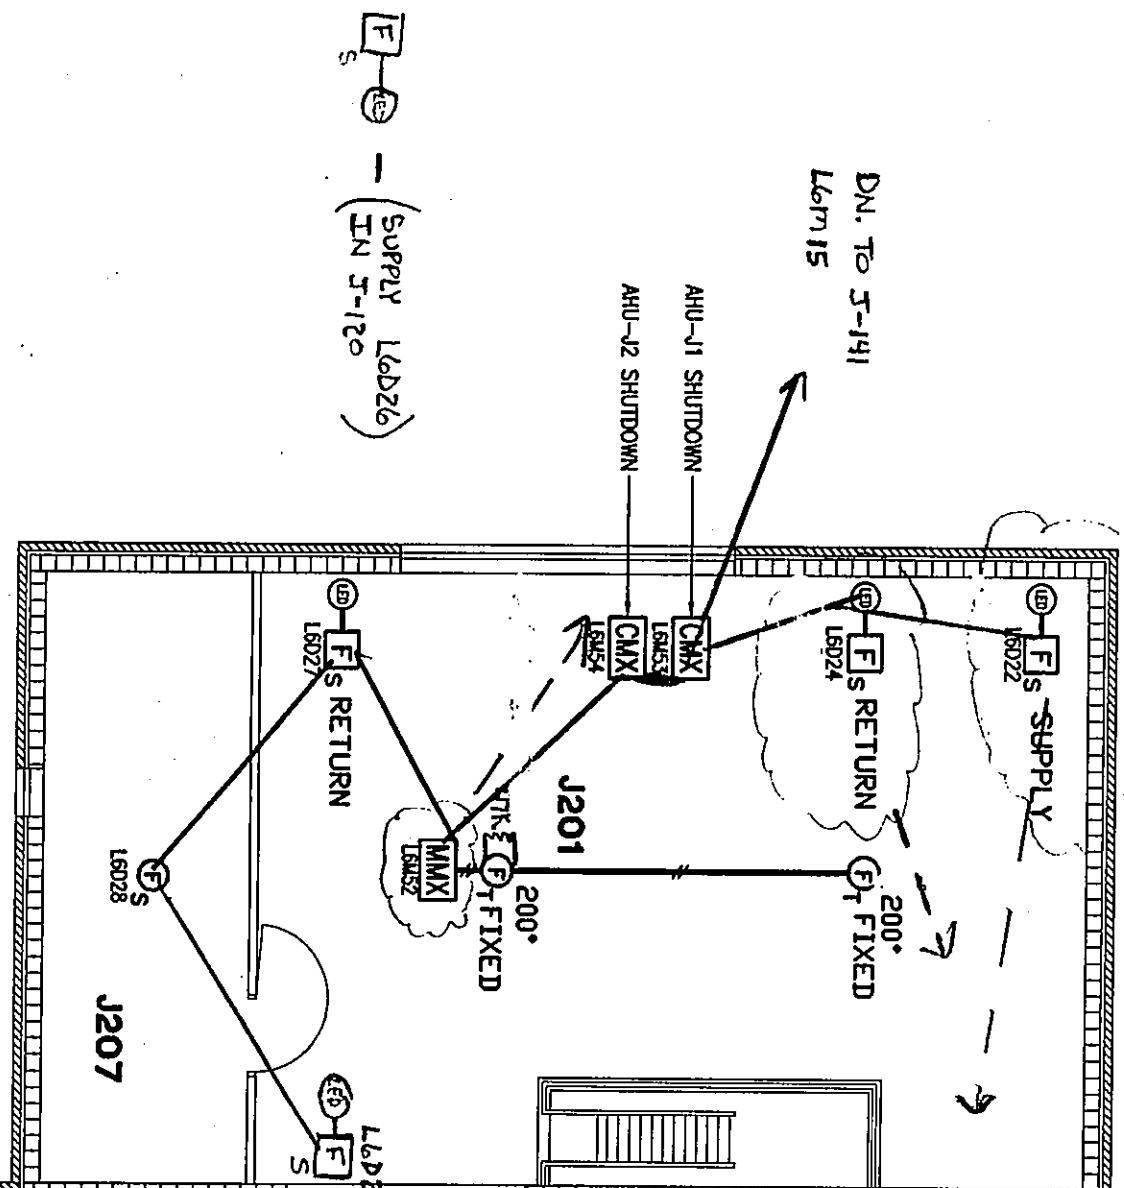


AUXILIARY PLAN - UNIT J2

SCALE 1/8" = 1'-0"

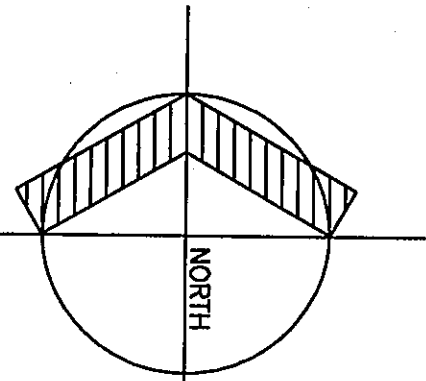

- LEGEND**
- [EAP] FIRE ALARM PANEL
 - [ANN] FIRE ANNUNCIATOR
 - [MAN] MANUAL PULL STATION
 - [K] ALARM HORN/STROBE
 - [K] ALARM HORN/STROBE, WEATHER-ROOF
 - [K] ALARM STROBE
 - [K] ALARM SPEAKER
 - [H] HEAT DETECTOR
 - [E] DUCT MOUNTED SMOKE DETECTOR
 - [E] DUCT MOUNTED SMOKE DETECTOR WITH INTEGRAL RELAY
 - [E] MONITORING LED
 - [CM] CONTROL MODULE
 - [MM] MONITOR MODULE

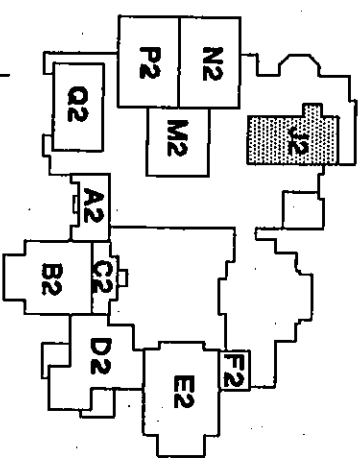

KEY PLAN

REFERENCE DRAWINGS		REVISIONS	
DWG. NO.	DESCRIPTION	NO.	DATE
72703E15	FIRE ALARM WIRING RISER DIAGRAM	A	7/16/98
72703E15	FIRE ALARM WIRING DETAILS & NOTES	B	7/16/98
PROJECT INFORMATION		DRAWING NO.	
1055 W. 10TH ST. • P.O. BOX 70		72703E15	
WALTON, INDIANA 46785		SHEET NO.	
K. A. LUNDSTEDT		1 OF 1	