
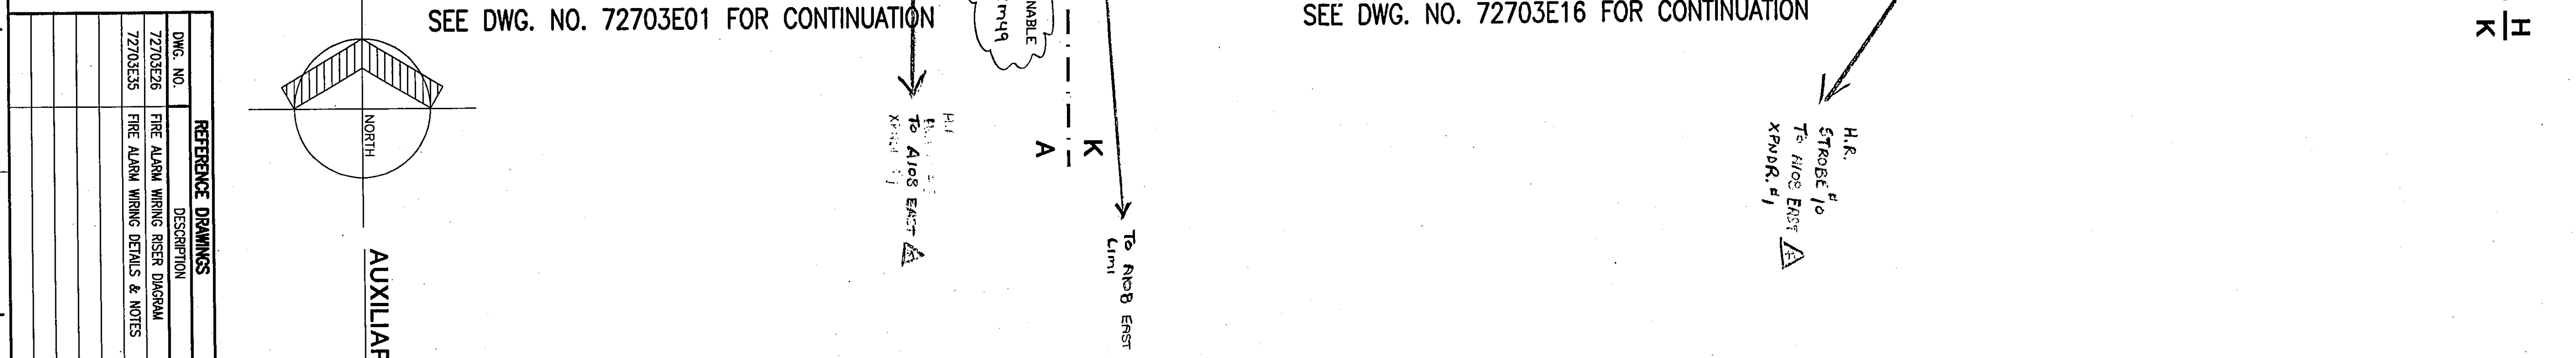


SEE DWG. NO. 72703E20 FOR CONTINUATION

SEE DWG. NO. 72703E22 FOR CONTINUATION

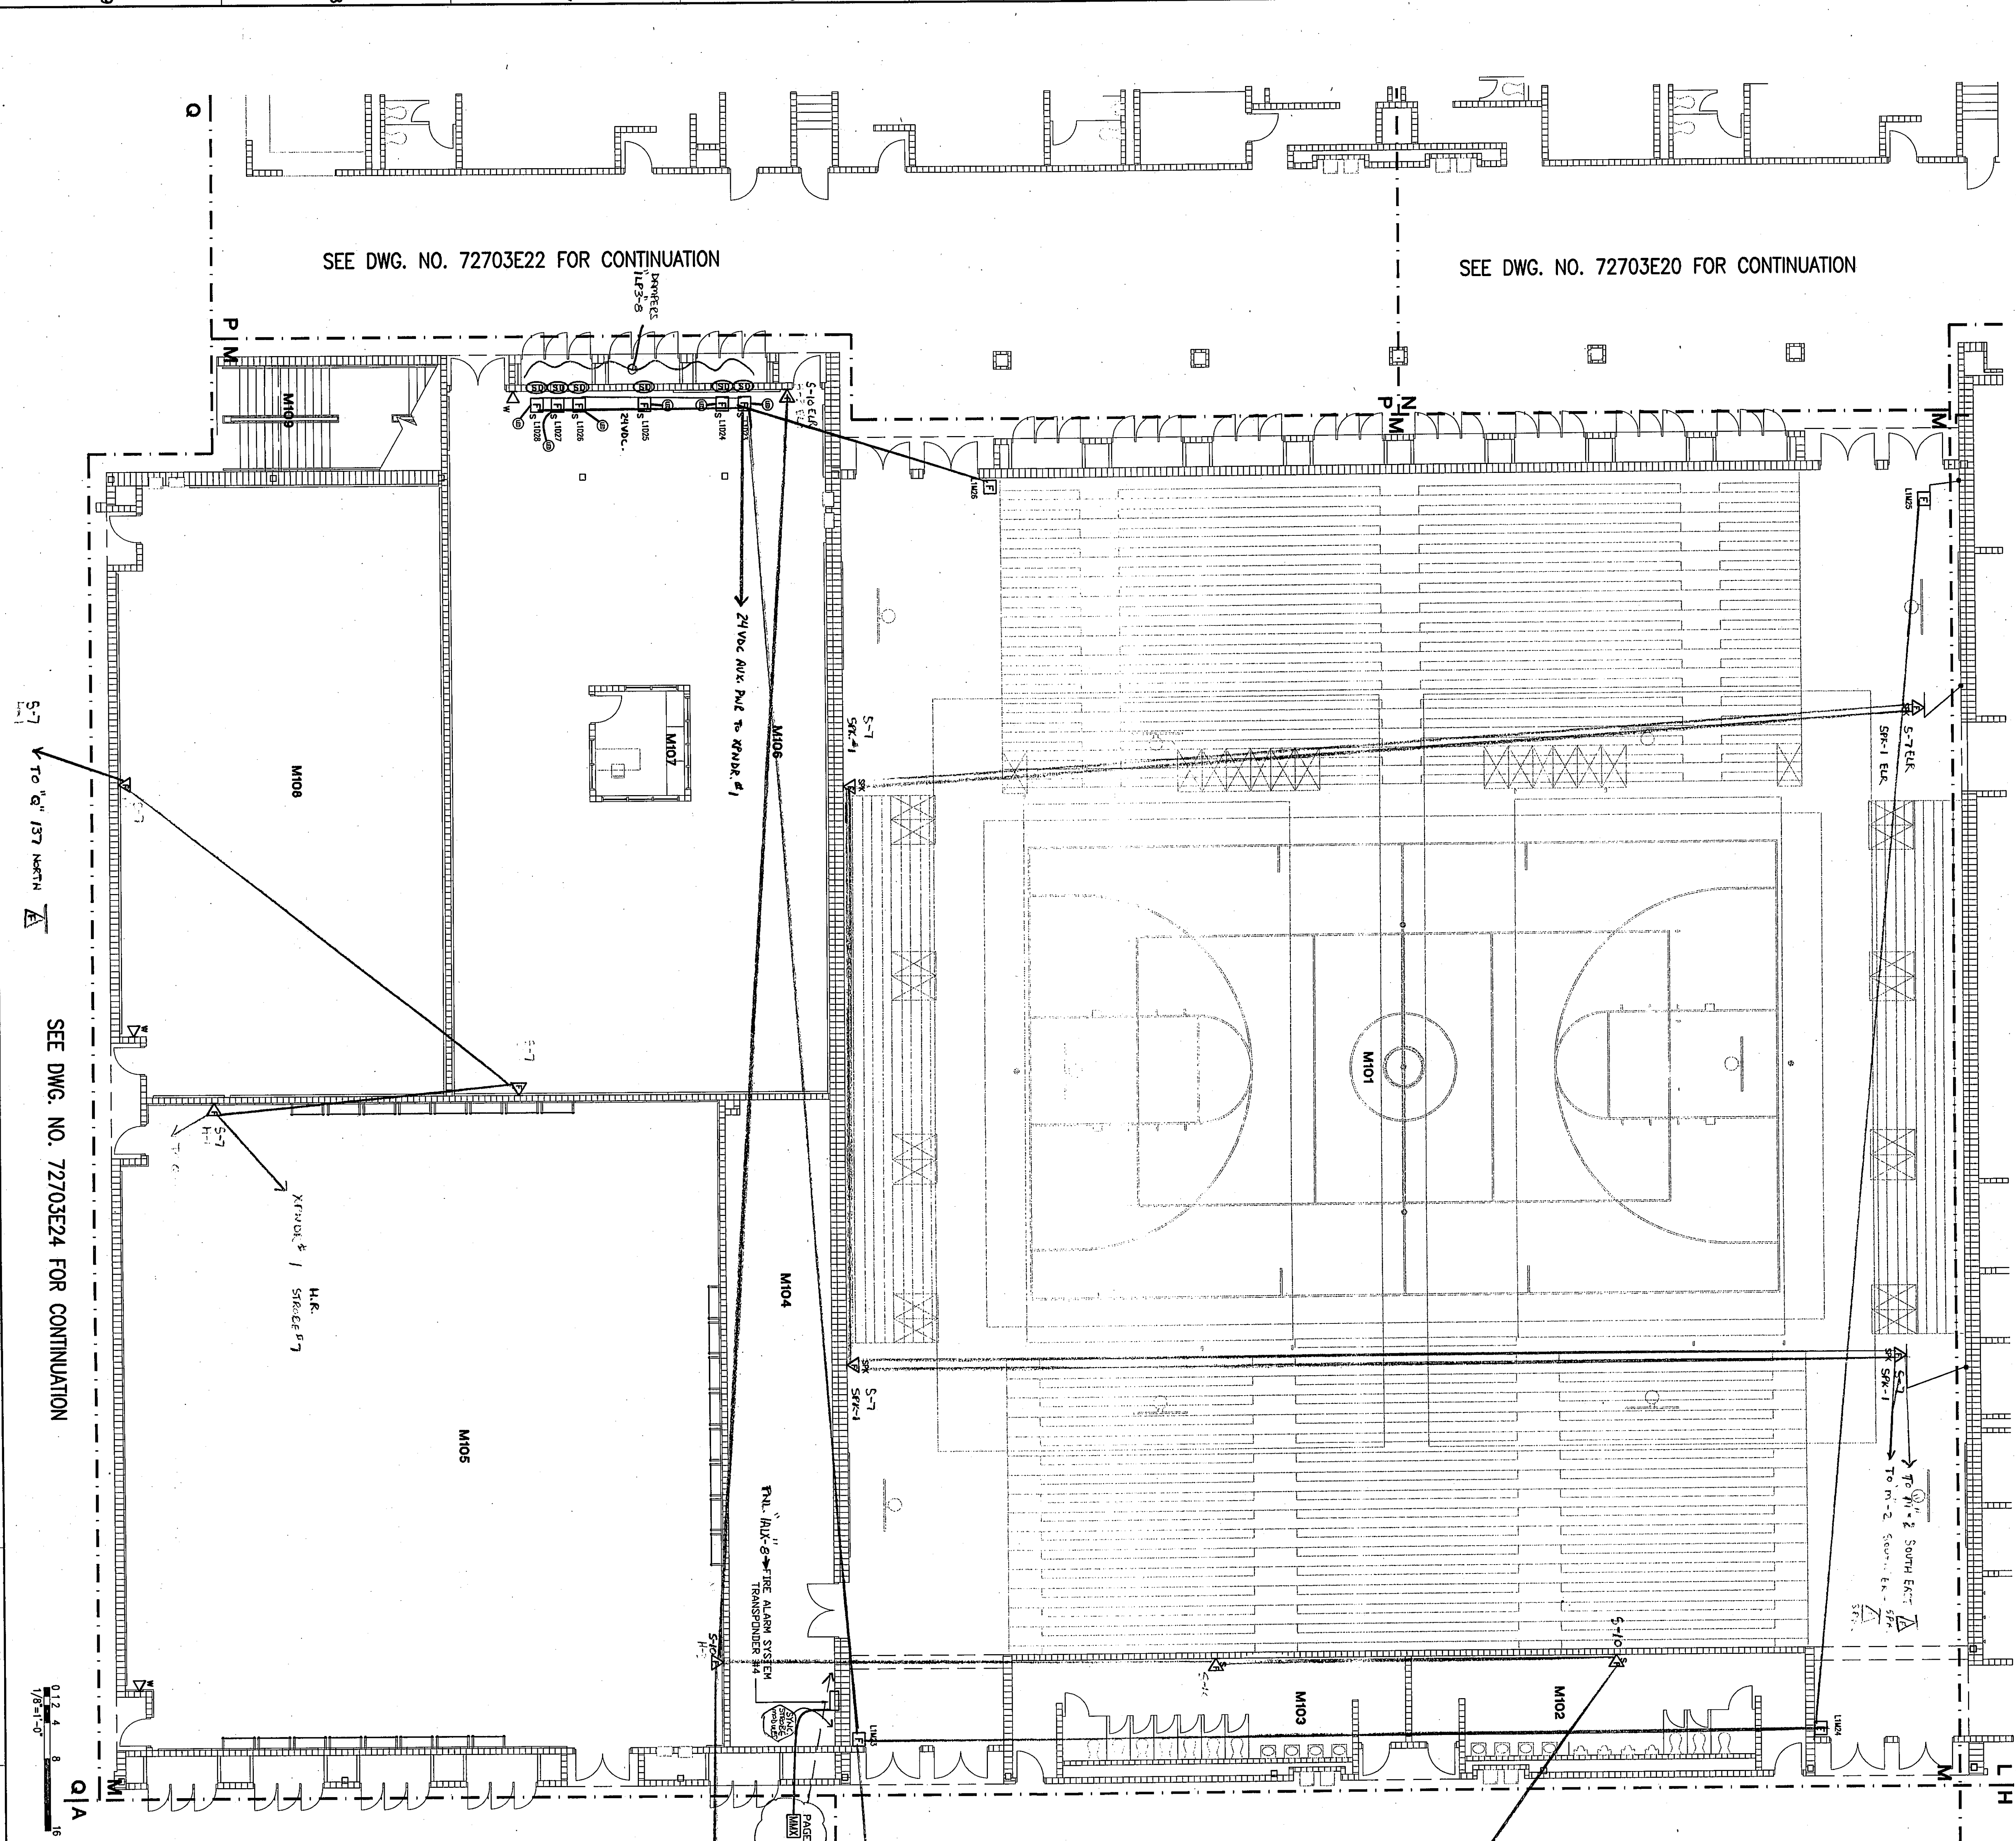


- LEGEND
- SYN. DESCRIPTION
 - FRP FIRE ALARM PANEL
 - ANN FIRE ANNUNCIATOR
 - MANUAL PULL STATION
 - ALARM HORN/STROBE
 - ALARM HORN/STROBE, WEATHERPROOF
 - ALARM STROBE
 - ALARM SPEAKER
 - SMOKE DETECTOR
 - HEAT DETECTOR
 - DUCT MOUNTED SMOKE DETECTOR
 - DUCT MOUNTED SMOKE DETECTOR WITH INTEGRAL RELAY
 - MONITORING LED
 - CONTROL MODULE
 - MONITOR MODULE

REFERENCE DRAWINGS	
DWG. NO.	DESCRIPTION
72703E26	FIRE ALARM WIRING RISER DIAGRAM

DRAWING NO.	
72703E18	0
REV.	
1	1 OF 1
SHEET NO.	
0	1 OF 1