DRAWING NO.: 72703E20

SEE DWG. NO. 72703E14 FOR CONTINUATION

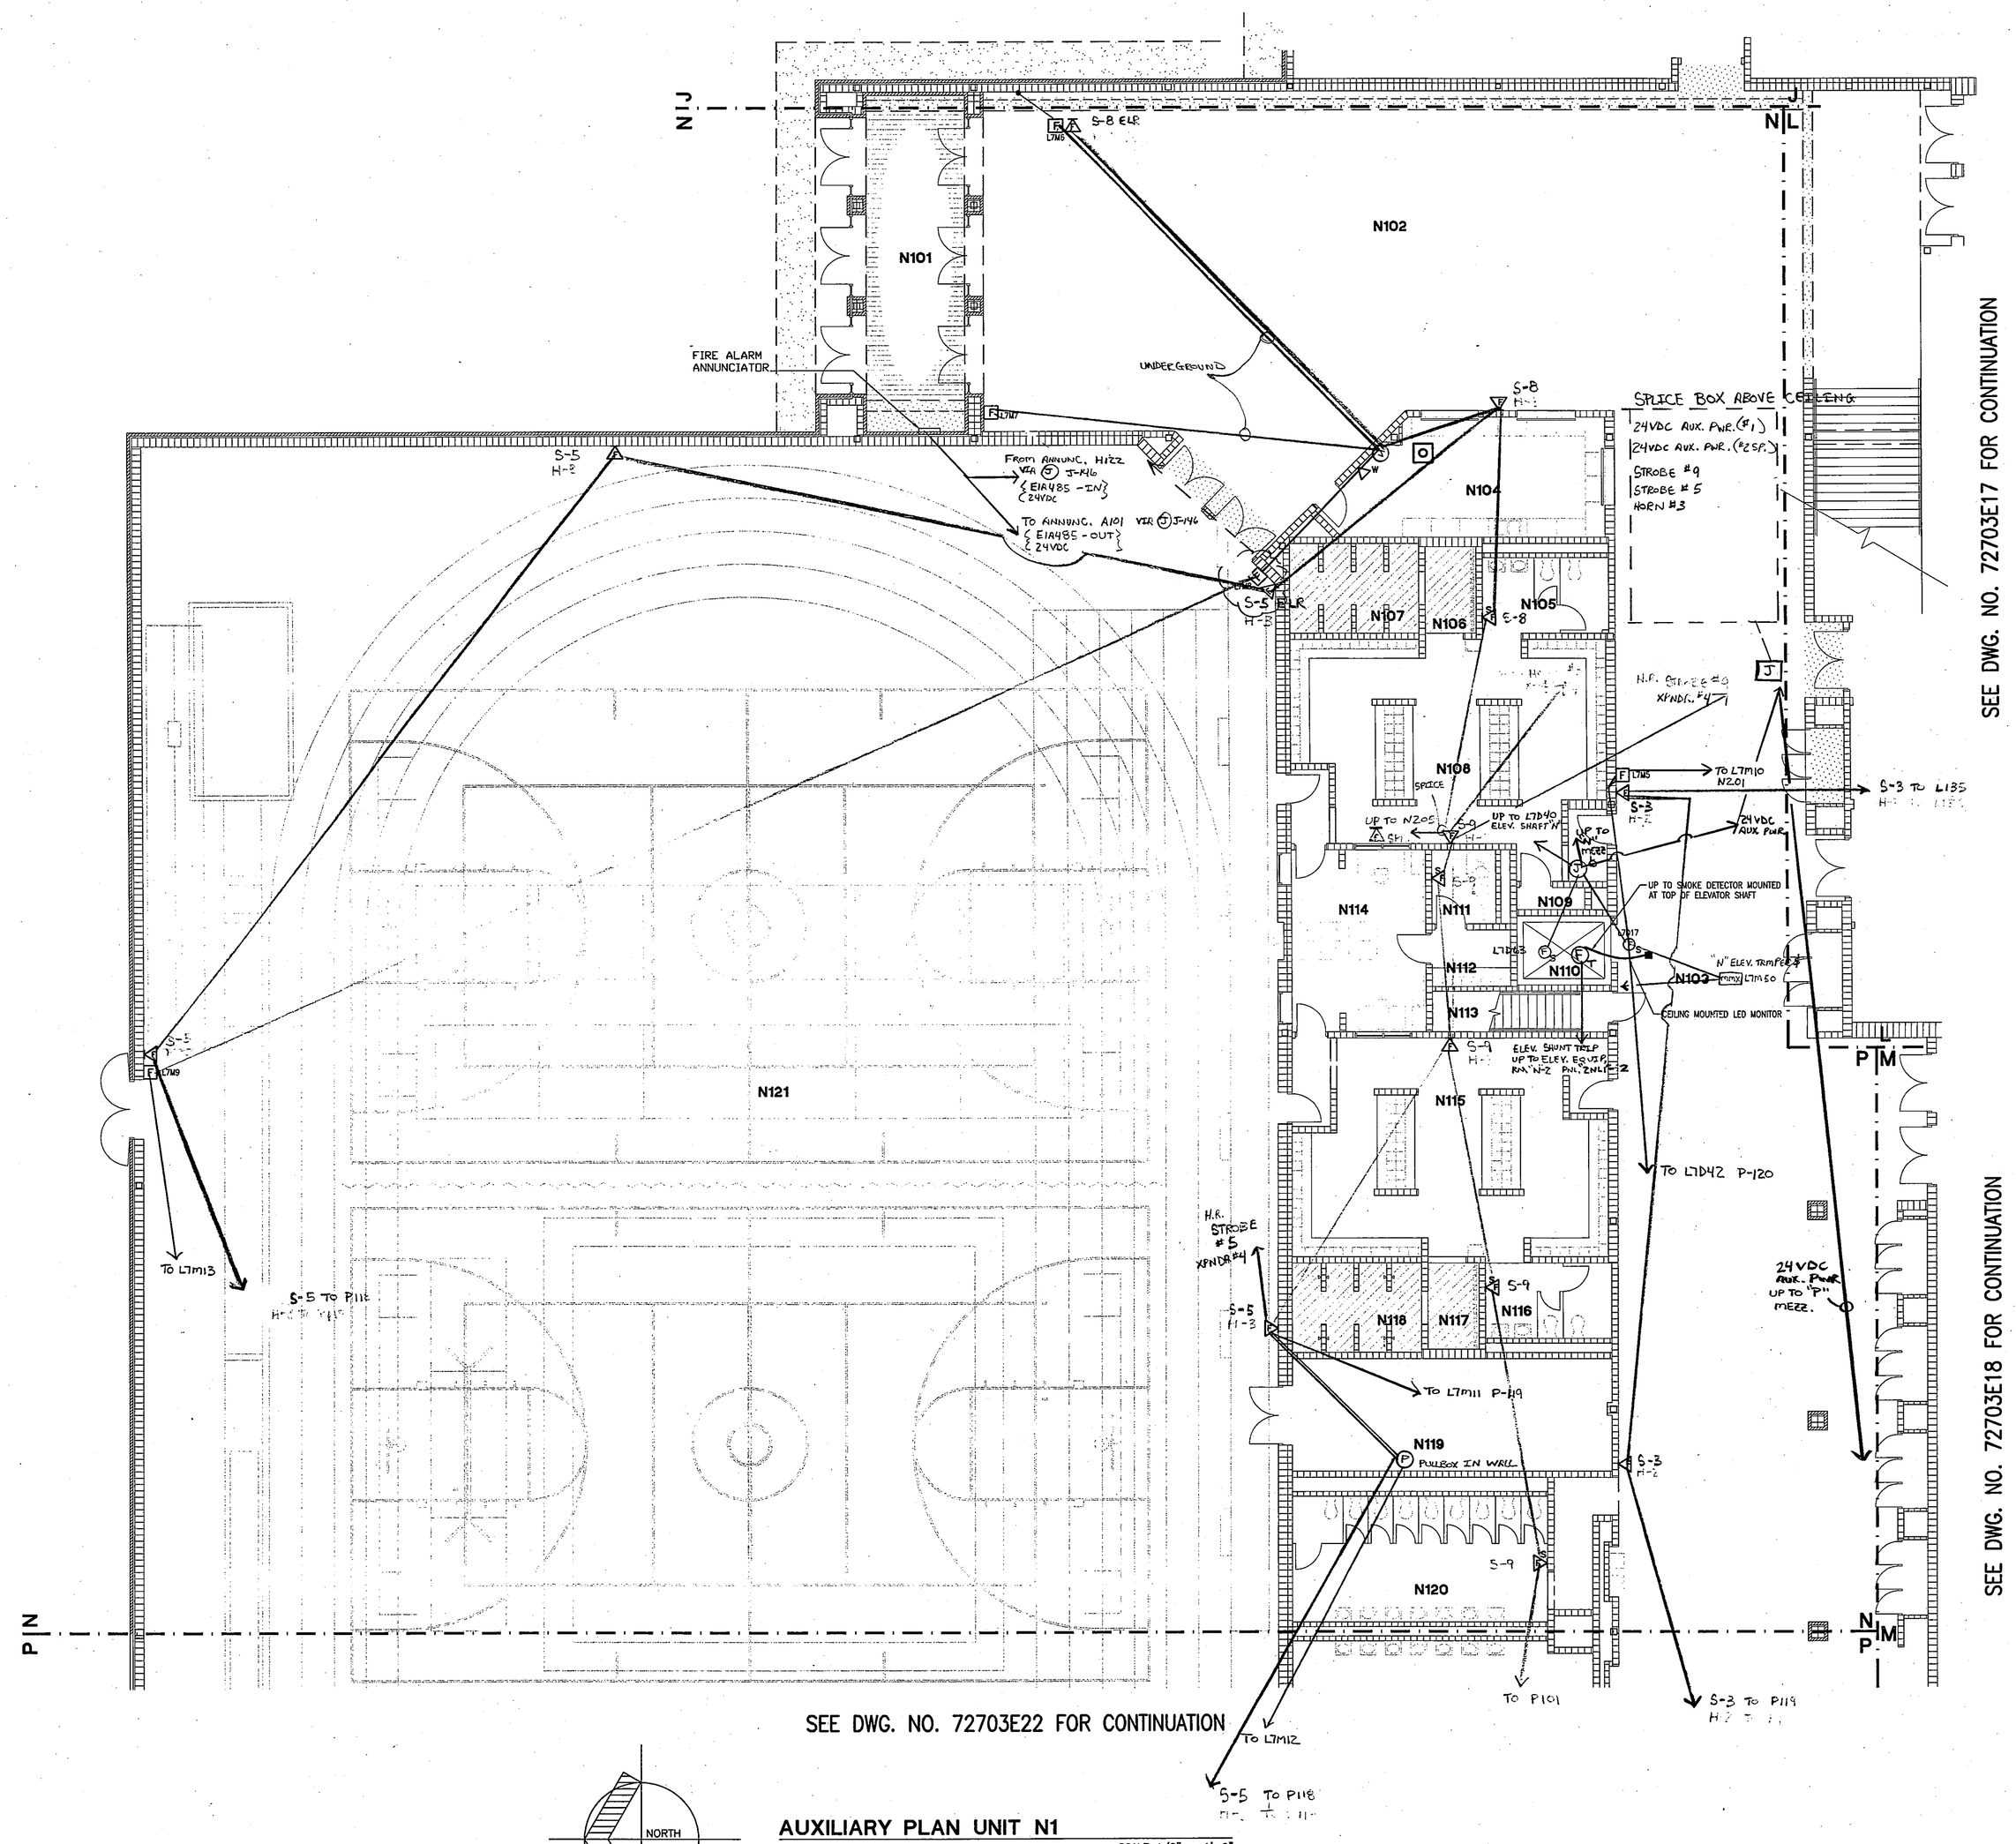

SEE DWG. NO. 72703E17 FOR CONTINUATION

SEE DWG. NO. 72703E18 FOR CONTINUATION

SEE DWG. NO. 72703E22 FOR CONTINUATION

ROOM LEGEND N1

ROOM NO.	ROOM NAME	AREA S.F.	CEILING HEIGHT
N101	VESTIBULE	397	----
N102	CORRIDOR	3654	10'-0"
N103	CORRIDOR	3297	10'-0"
N104	CONCESSION STAND	337	9'-4"
N105	TOILET	104	9'-4"
N106	DRYING ROOM	49	9'-4"
N107	SHOWER	130	9'-4"
N108	GIRLS PE LOCKER	749	9'-4"
N109	STORAGE	19	----
N110	ELEVATOR	71	----
N111	TOILET	52	9'-4"
N112	COACH LOCKER	52	9'-4"
N113	STAIR	74	VARIES
N114	OFFICE	272	9'-4"
N115	GIRLS PE LOCKER	763	9'-4"
N116	TOILET	104	9'-4"
N117	DRYING ROOM	49	9'-4"
N118	SHOWER	130	9'-4"
N119	PE STORAGE	397	----
N120	GIRLS TOILET	425	9'-4"
N121	FIELDHOUSE	15052	----

LEGEND

SYM	DESCRIPTION
FAP	FIRE ALARM PANEL
ANN	FIRE ANNUNCIATOR
F	MANUAL PULL STATION
	ALARM HORN/STROBE
	ALARM HORN/STROBE, WEATHERPROOF
	ALARM STROBE
	ALARM SPEAKER
F_S	SMOKE DETECTOR
F_T	HEAT DETECTOR
F_S	DUCT MOUNTED SMOKE DETECTOR
SD F_S	DUCT MOUNTED SMOKE DETECTOR WITH INTEGRAL RELAY
	MONITORING LED
CMX	CONTROL MODULE
MMX	MONITOR MODULE

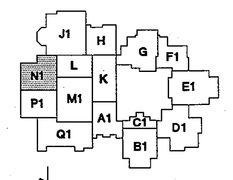

NORTH KEYPLAN

NORTH

AUXILIARY PLAN UNIT N1

SCALE 1/8" = 1'-0"

0 1 2 4 8 16
1/8"=1'-0"

REFERENCE DRAWINGS	
DWG. NO.	DESCRIPTION
72703E26	FIRE ALARM WIRING RISER DIAGRAM
72703E35	FIRE ALARM WIRING DETAILS & NOTES

NO.	DATE	BY	REVISIONS
0	11/11/98	KAL	ISSUED FOR CONSTRUCTION
B	8/13/98	JJG	REVISED PER F&H COMMENTS
A	7/16/98	KAL	ISSUED FOR REVIEW

98-RP-20

McDANIEL FIRE SYSTEMS
1055 W.JOLIET RD. • P.O.BOX 70
VALPARAISO, INDIANA 46385
(219)-462-0571

MFS JOB NO. 72703
INSURANCE
SCALE 1/8"=1'-0"
SPECIFICATION 95067.00
DESIGNED BY J. J. GAWRYSIAK CHECKED BY K. A. LINDSTEDT DATE 7/16/98

CHESTERTON HIGH SCHOOL
2125 S. 11TH STREET
CHESTERTON, INDIANA

FIRE ALARM & DETECTION SYSTEM
UNIT N1
DEVICE LAYOUT

DRAWING NO.: 72703E20 REV. 0 SHEET NO. 1 OF 1