


ROOM LEGEND N2			
ROOM NO.	ROOM NAME	AREA S.F.	CEILING HEIGHT
N201	MECHANICAL ROOM	579	10'-8"
N202	MECHANICAL ROOM	425	---
N203	ELEVATOR EQUIPMENT	37	---
N205	BULLDOZ COURT	4681	---

PLAN NOTES



1) VERIFY EXACT LOCATION OF PRE-ACTION PANEL AND SPRINKLER VALVE WITH DIVISION 15.

- LEGEND
- SMA DESCRIPTION
 - PRE FIRE ALARM PANEL
 - ANN FIRE ANNUNCIATOR
 - MANUAL PULL STATION
 - ALARM HORN/STROBE
 - ALARM HORN/STROBE WEATHERPROOF
 - ALARM STROBE
 - ALARM SPEAKER
 - SMOKE DETECTOR
 - HEAT DETECTOR
 - DUCT MOUNTED SMOKE DETECTOR
 - DUCT MOUNTED SMOKE DETECTOR WITH INTEGRAL RELAY
 - MONITORING LED
 - CONTROL MODULE
 - MONITOR MODULE

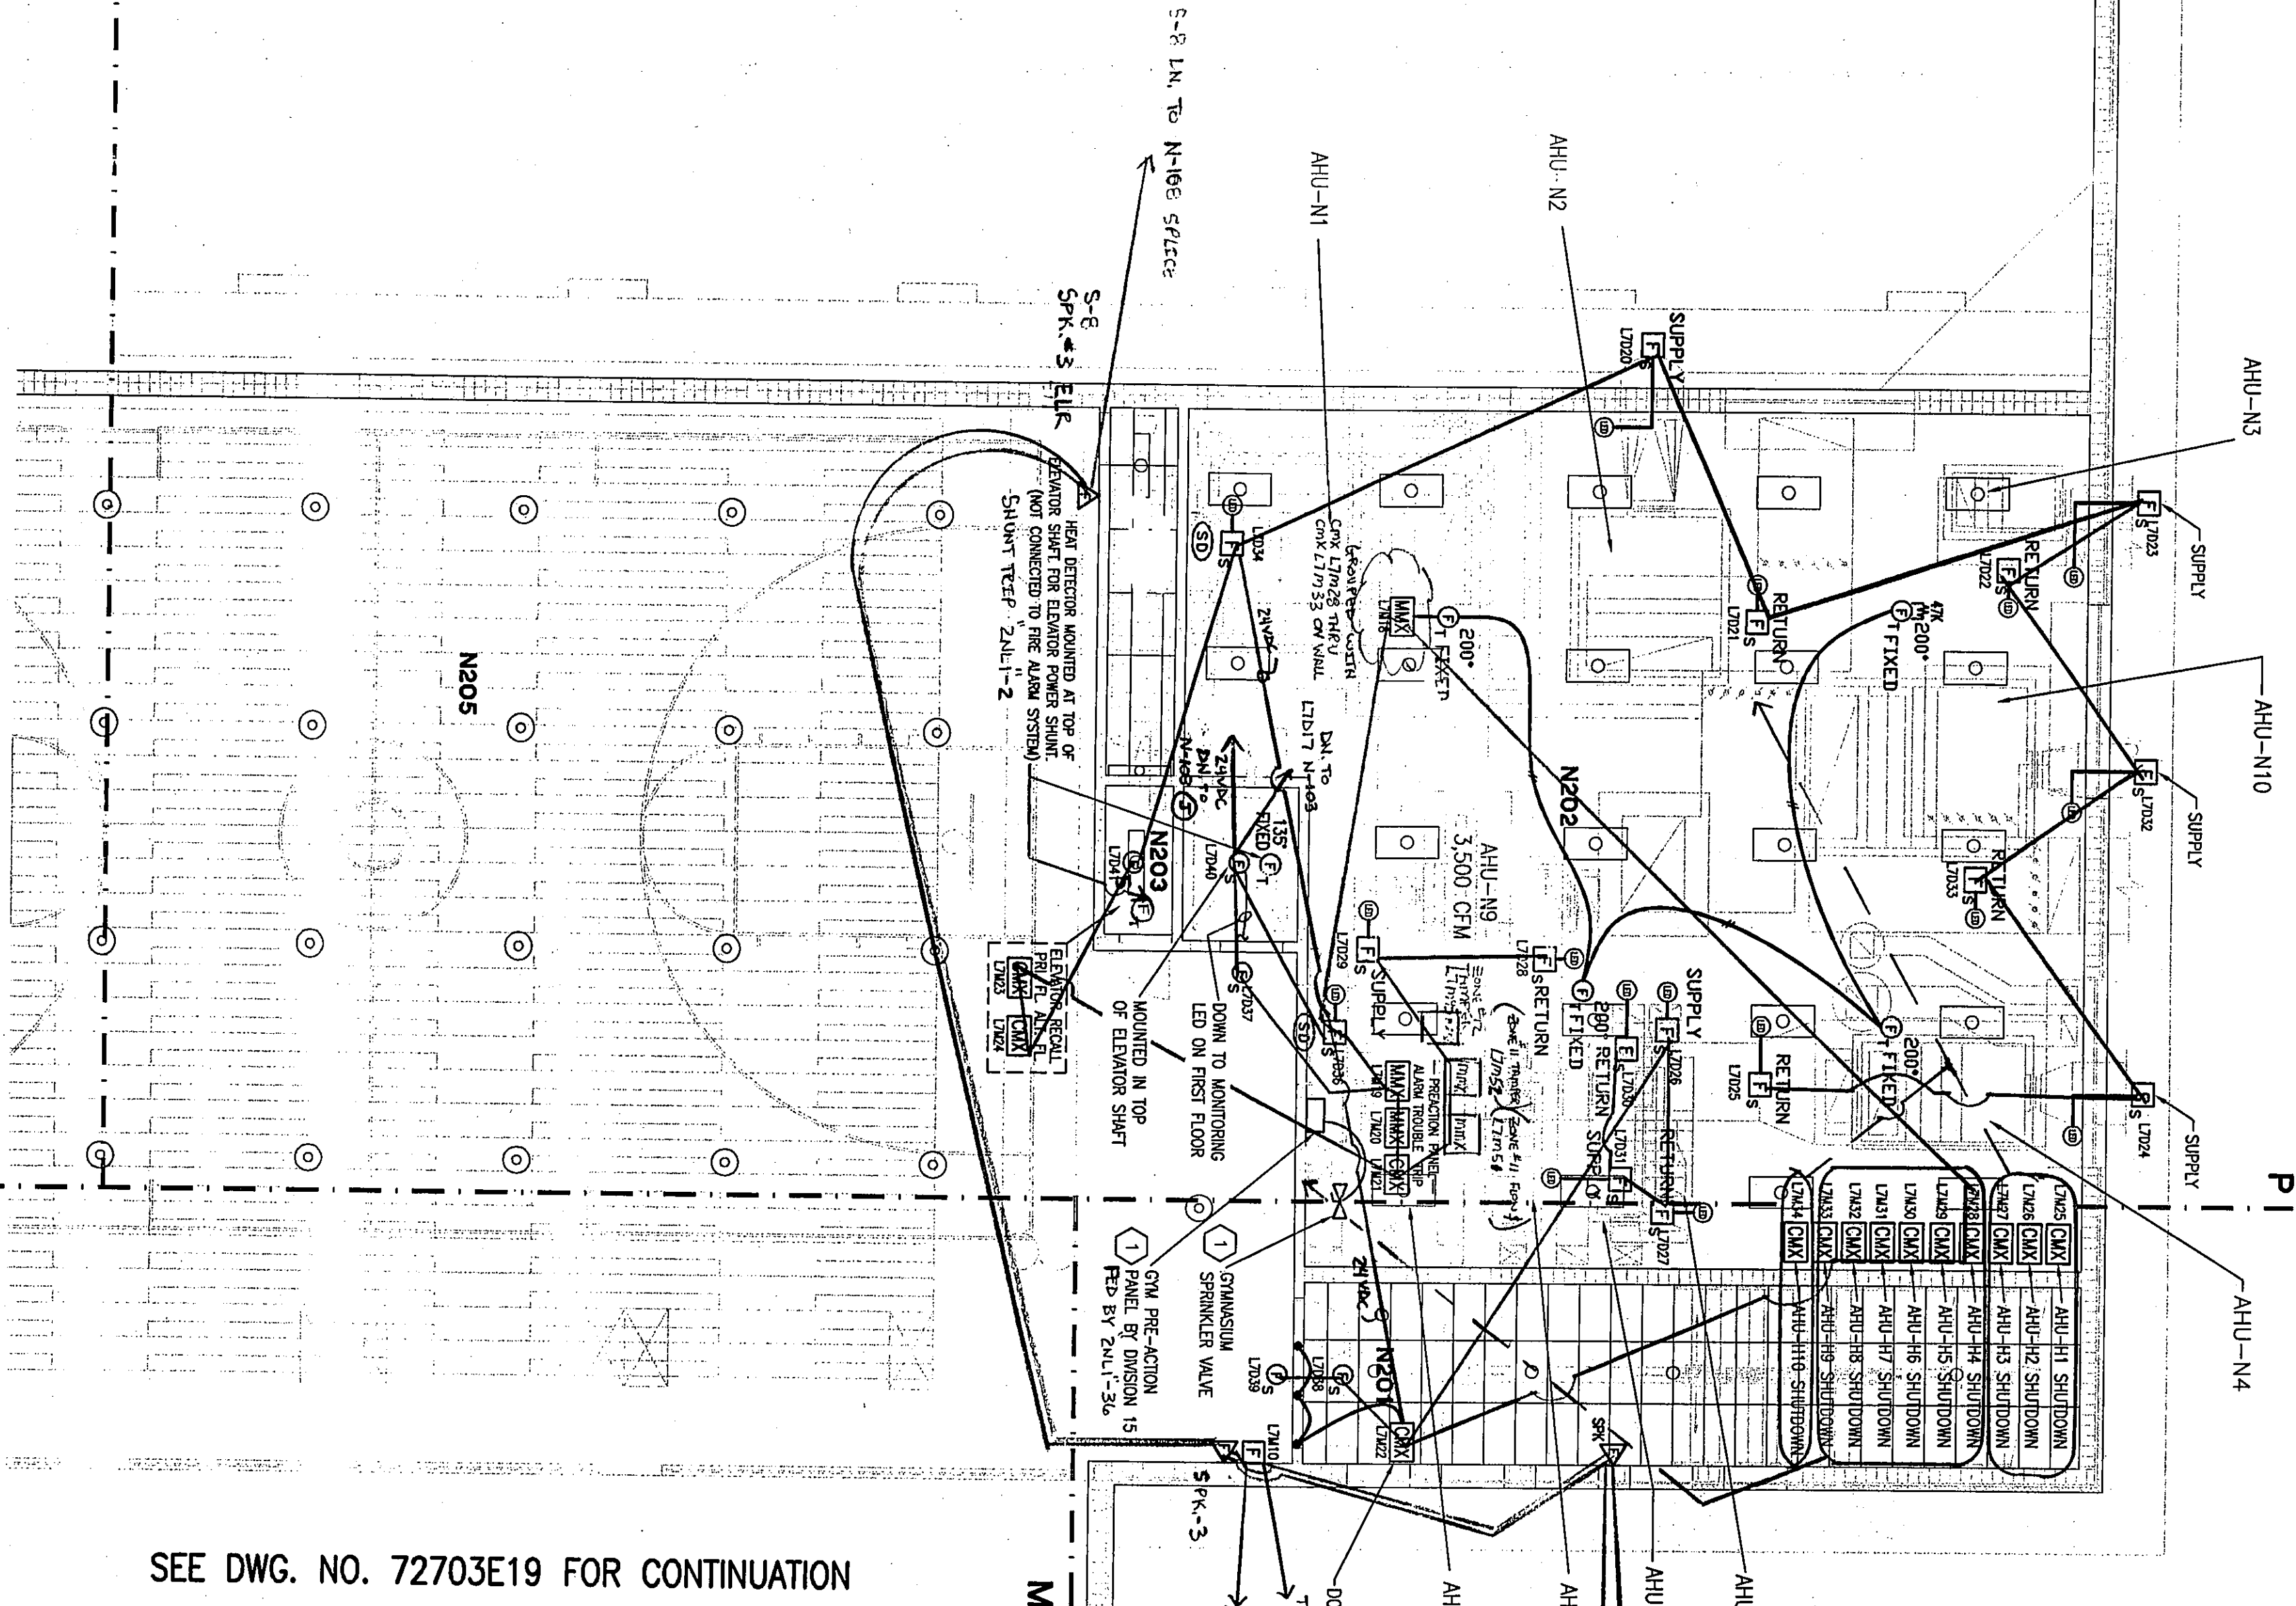

AUXILIARY PLAN UNIT N2

SCALE 1/8" = 1'-0"

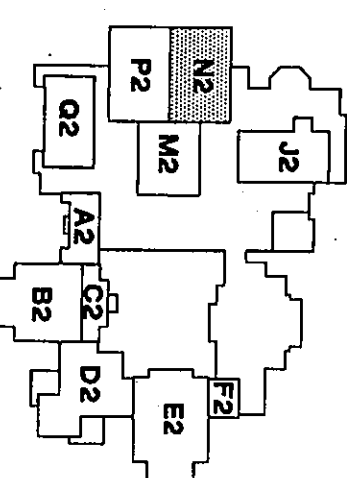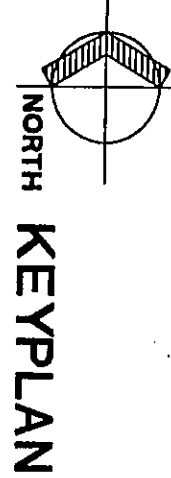

REFERENCE DRAWINGS		REVISIONS	
DWG. NO.	DESCRIPTION	NO.	DATE
72703E20	FIRE ALARM WIRING RISER DIAGRAM	1	11/11/98

CHESTERION HIGH SCHOOL
2125 S. 11TH STREET
CHESTERION, INDIANA
FIRE ALARM & DETECTION SYSTEM
UNIT N2
DEVICE LAYOUT