


SEE DWG. NO. 72703E20 FOR CONTINUATION

ROOM LEGEND P2			
ROOM NO.	ROOM NAME	AREA S.F.	CEILING HEIGHT
P201	STAIR	681	10'-8"
P202	MECHANICAL ROOM	2725	10'-8"
P203	SILICON COURT	4236	9'-4"

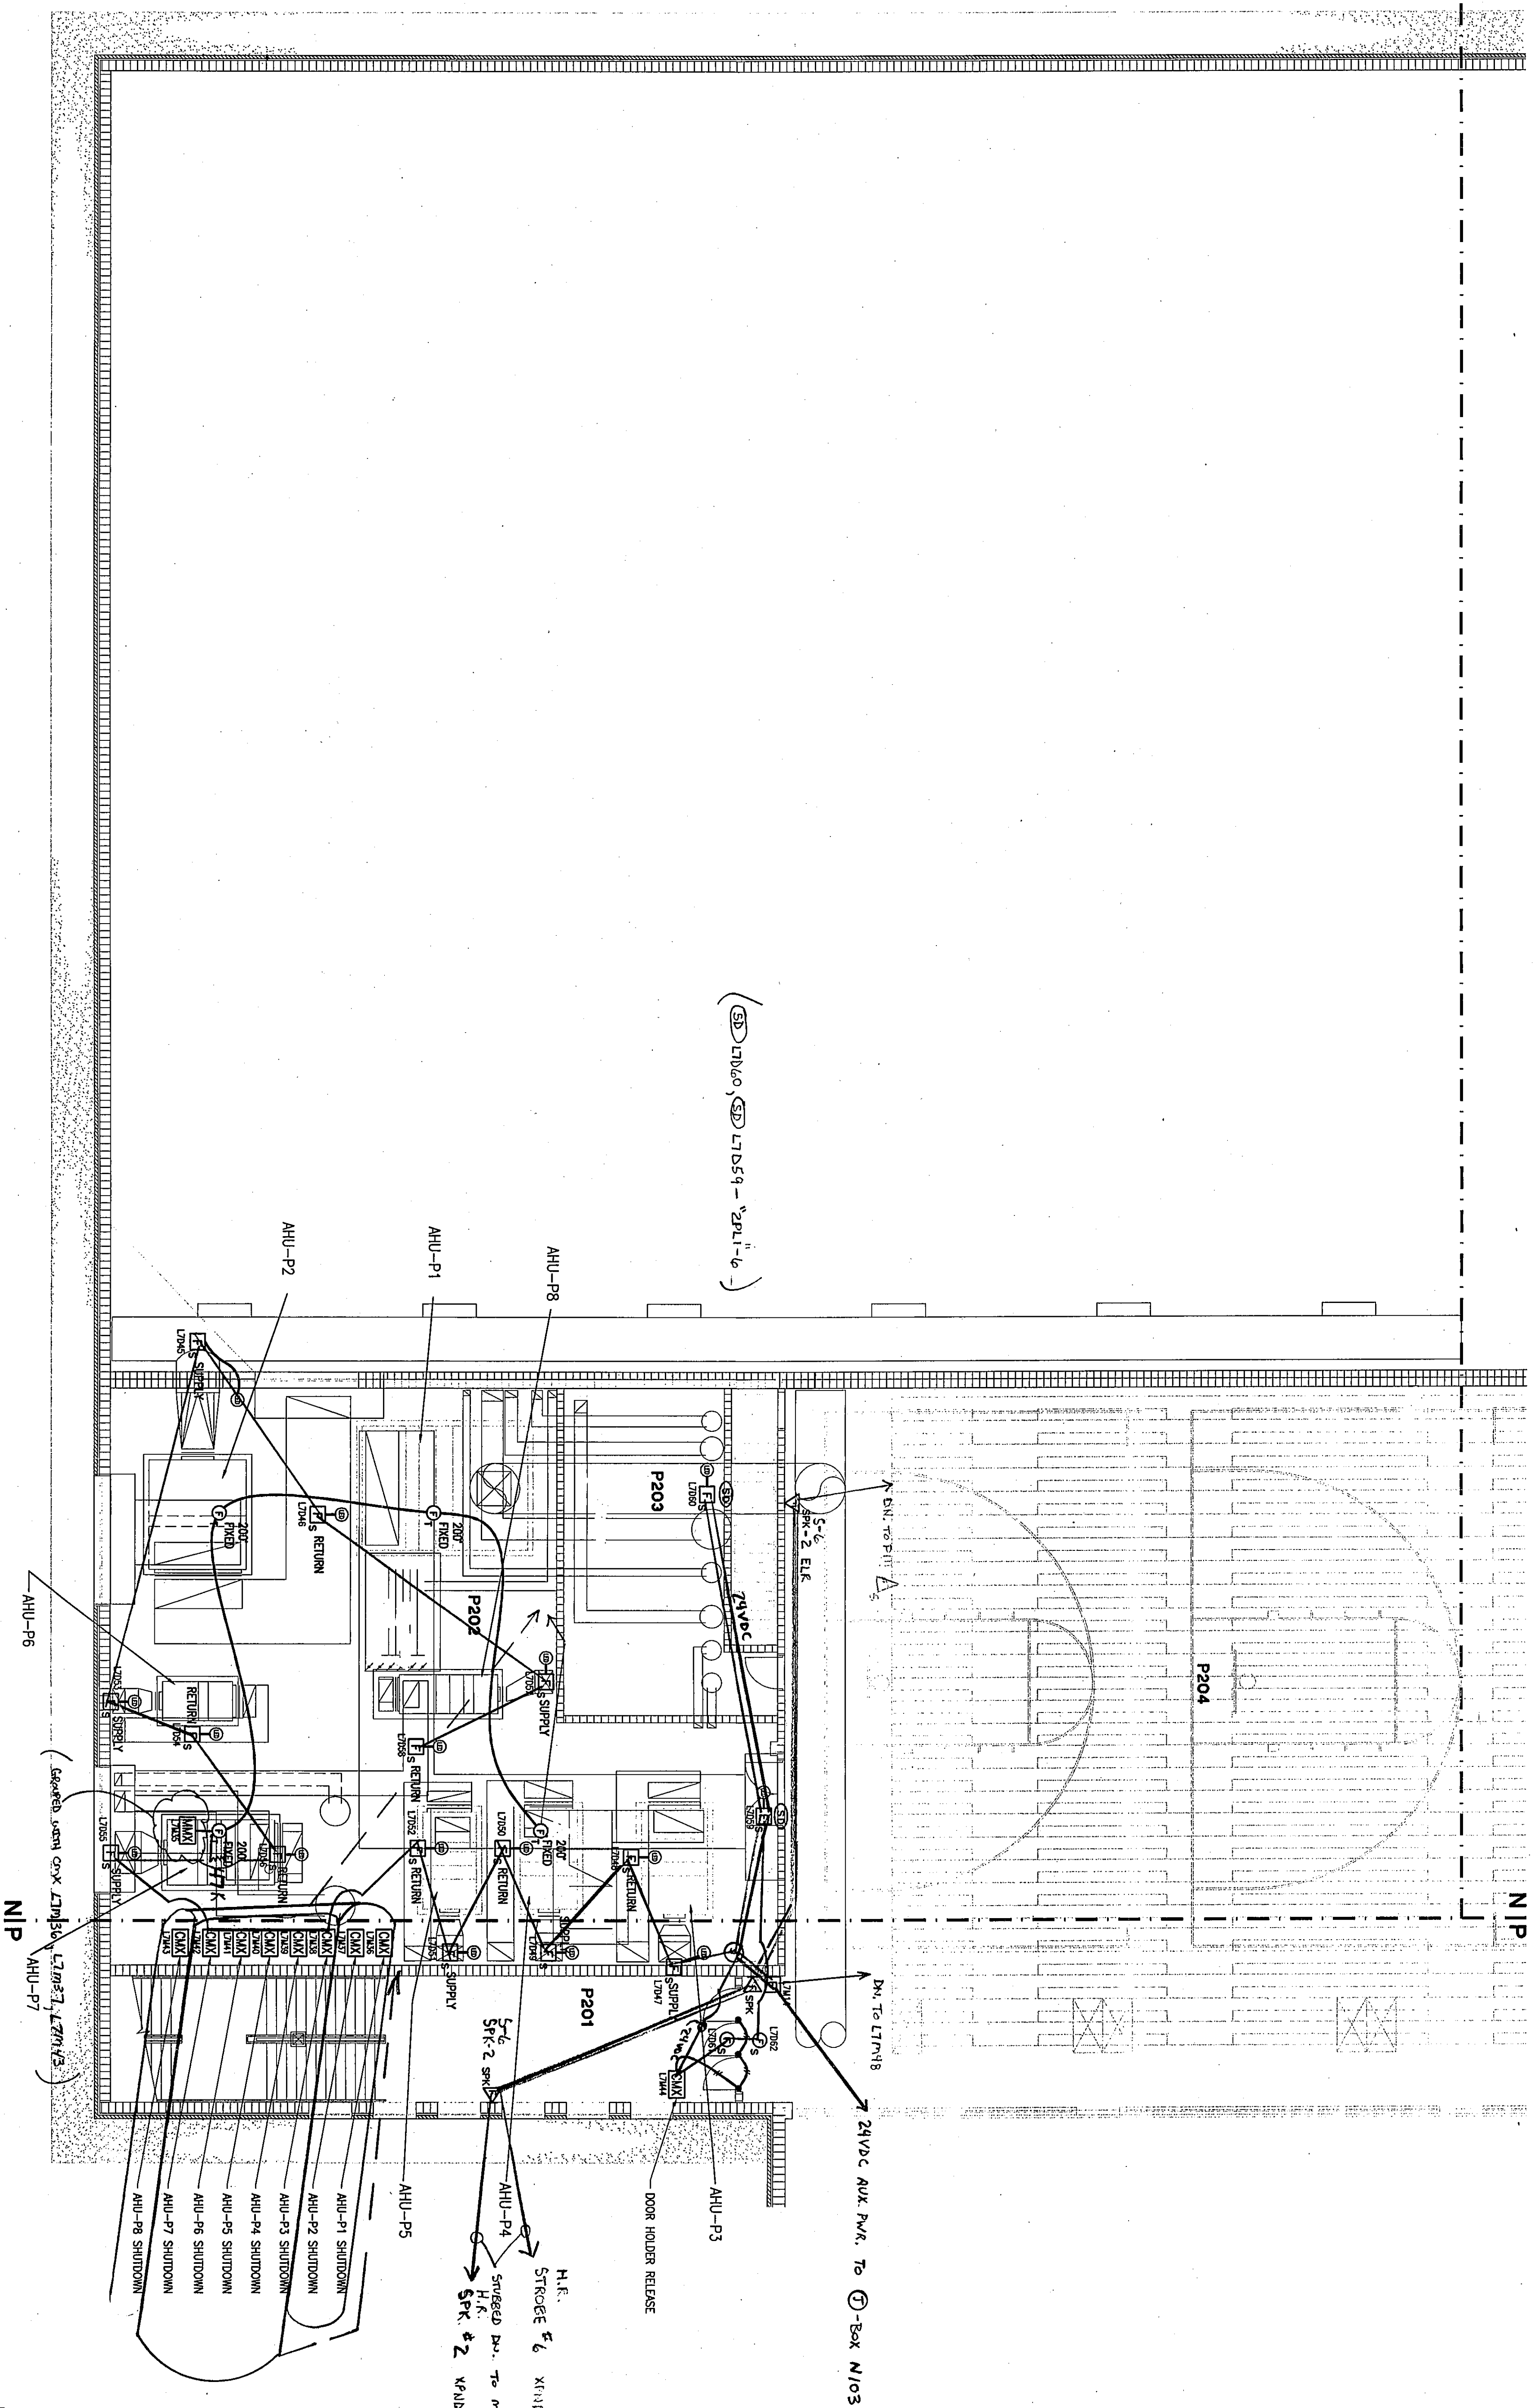


(SEE DWG. NO. 72703E20 FOR CONTINUATION)


AUXILIARY PLAN UNIT P2

SCALE 1/8" = 1'-0"

0 12 4 8 16
1/8" = 1'-0"

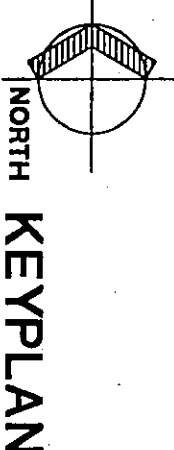

NORTH KEYPLAN

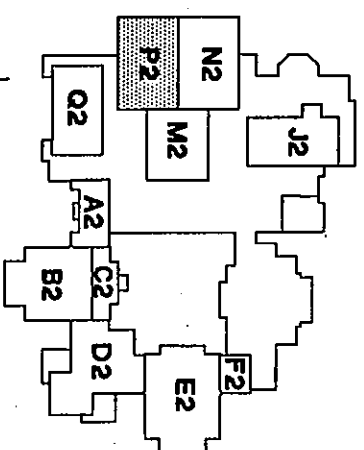

REFERENCE DRAWINGS	
DWG. NO.	DESCRIPTION
72703E20	FIRE ALARM WIRING RISER DIAGRAM
72703E23	FIRE ALARM WIRING DETAILS & NOTES

M. DANIEL	
DESIGNED BY	72703
SCALE	1/8" = 1'-0"
DATE	7/16/98
BY	J. J. GUMINSKI
CHECKED BY	K. A. LUNSTEDT
DATE	7/16/98




LEGEND

- SYM DESCRIPTION
- FAE FIRE ALARM PANEL
- MAN FIRE ANNUNCIATOR
- MAN MANUAL PULL STATION
- ALN ALARM HORN/STROBE
- ALN ALARM HORN/STROBE, WEATHERPROOF
- ALN ALARM STROBE
- ALN ALARM SPEAKER
- SD SMOKE DETECTOR
- HT HEAT DETECTOR
- ES DUCT MOUNTED SMOKE DETECTOR
- ES DUCT MOUNTED SMOKE DETECTOR WITH INTEGRAL RELAY
- MON MONITORING LED
- CON CONTROL MODULE
- MON MONITOR MODULE