



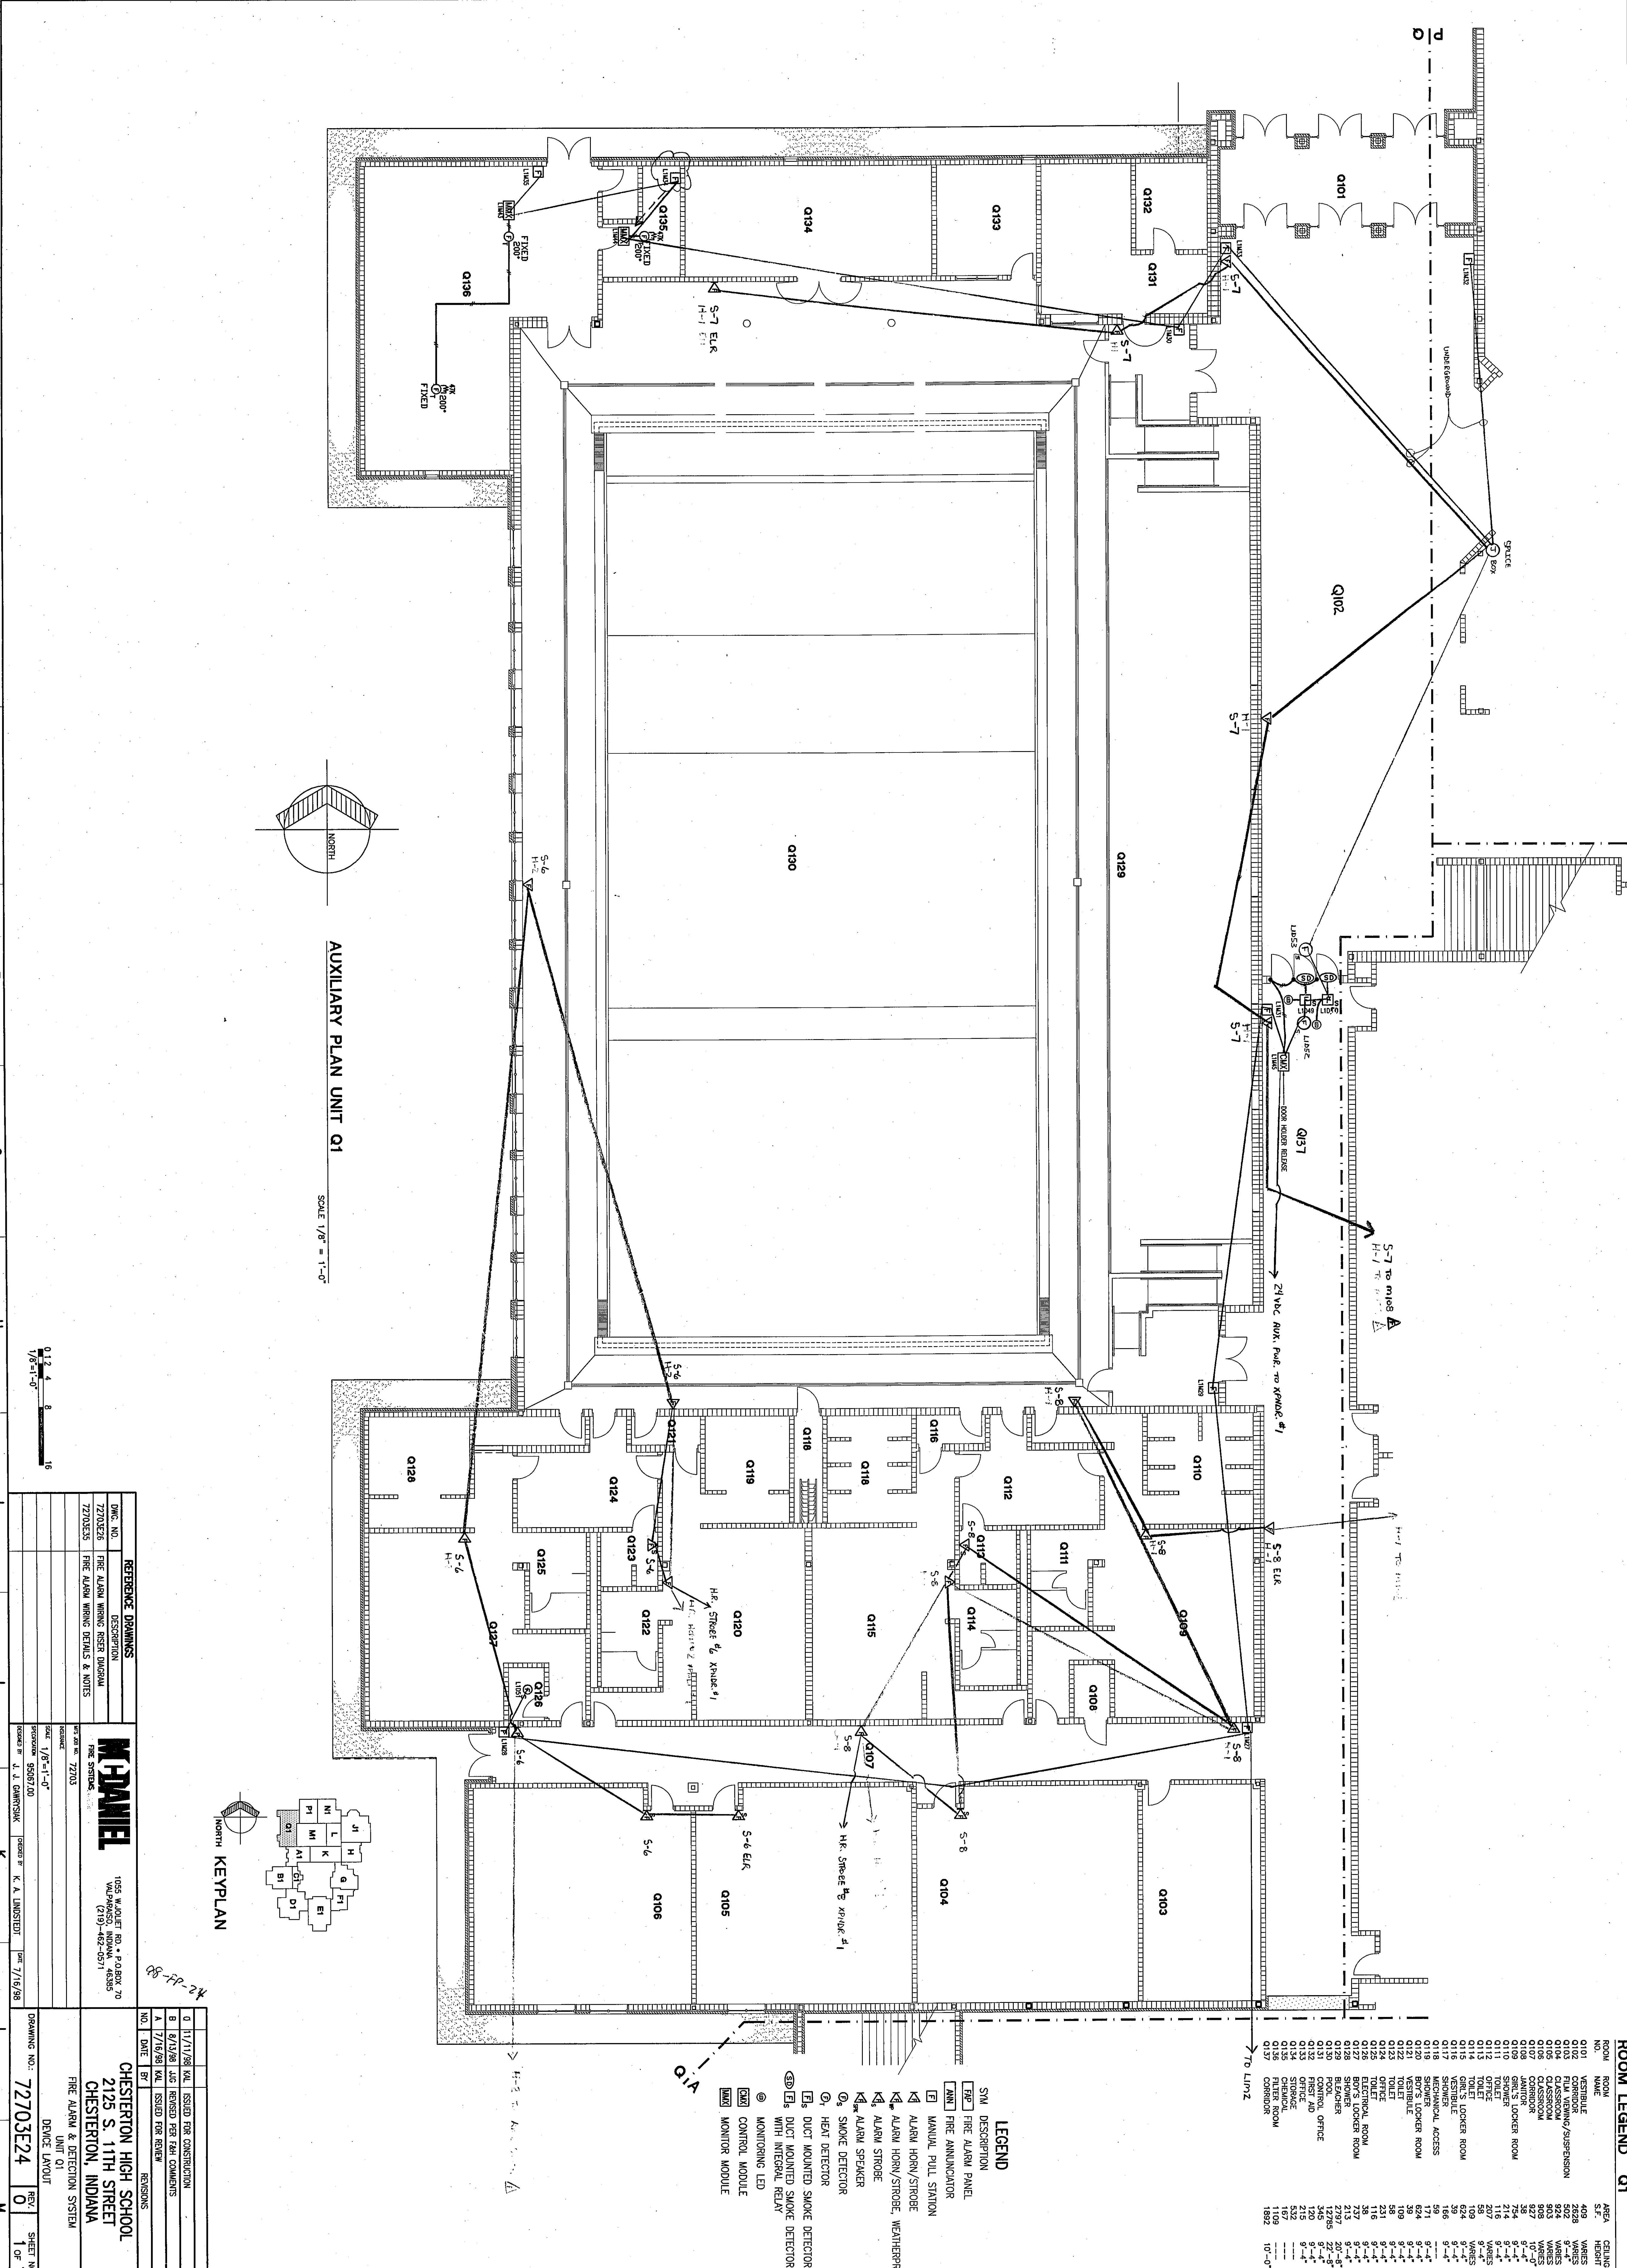

ROOM LEGEND Q1	
ROOM NO.	ROOM NAME
Q101	VESTIBULE
Q102	CORRIDOR
Q103	FILE VIEWING/SUSPENSION
Q104	CLASSROOM
Q105	CLASSROOM
- LEGEND
- S.M. DESCRIPTION
 - [Symbol] FIRE ALARM PANEL
 - [Symbol] FIRE ANNUNCIATOR
 - [Symbol] MANUAL PULL STATION
 - [Symbol] ALARM HORN/STROBE
 - [Symbol] ALARM HORN/STROBE, WEATHERPROOF
 - [Symbol] ALARM STROBE
 - [Symbol] ALARM SPEAKER
 - [Symbol] SMOKE DETECTOR
 - [Symbol] HEAT DETECTOR
 - [Symbol] DUCT MOUNTED SMOKE DETECTOR
 - [Symbol] DUCT MOUNTED SMOKE DETECTOR WITH INTEGRAL RELAY
 - [Symbol] MONITORING LED
 - [Symbol] CONTROL MODULE
 - [Symbol] MONITOR MODULE

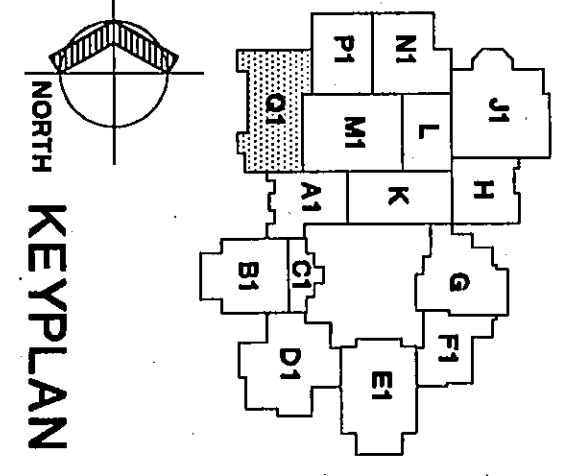

REFERENCE DRAWINGS	
DWG. NO.	DESCRIPTION
72703E25	FIRE ALARM WIRING RISER DIAGRAM
72703E35	FIRE ALARM WIRING DETAILS & NOTES
1053 W. JOLIET RD. • P.O. BOX 70	
VALPARAISO, INDIANA 46183	
(219) 462-0971	
FIRE SYSTEMS	
DESIGNED BY: J. T. GAWRYSIAK	
CHECKED BY: K. A. LUNDSTEDT	
DATE: 7/16/98	
DRAWING NO.: 72703E24	
SHEET NO. 1 OF 1	