

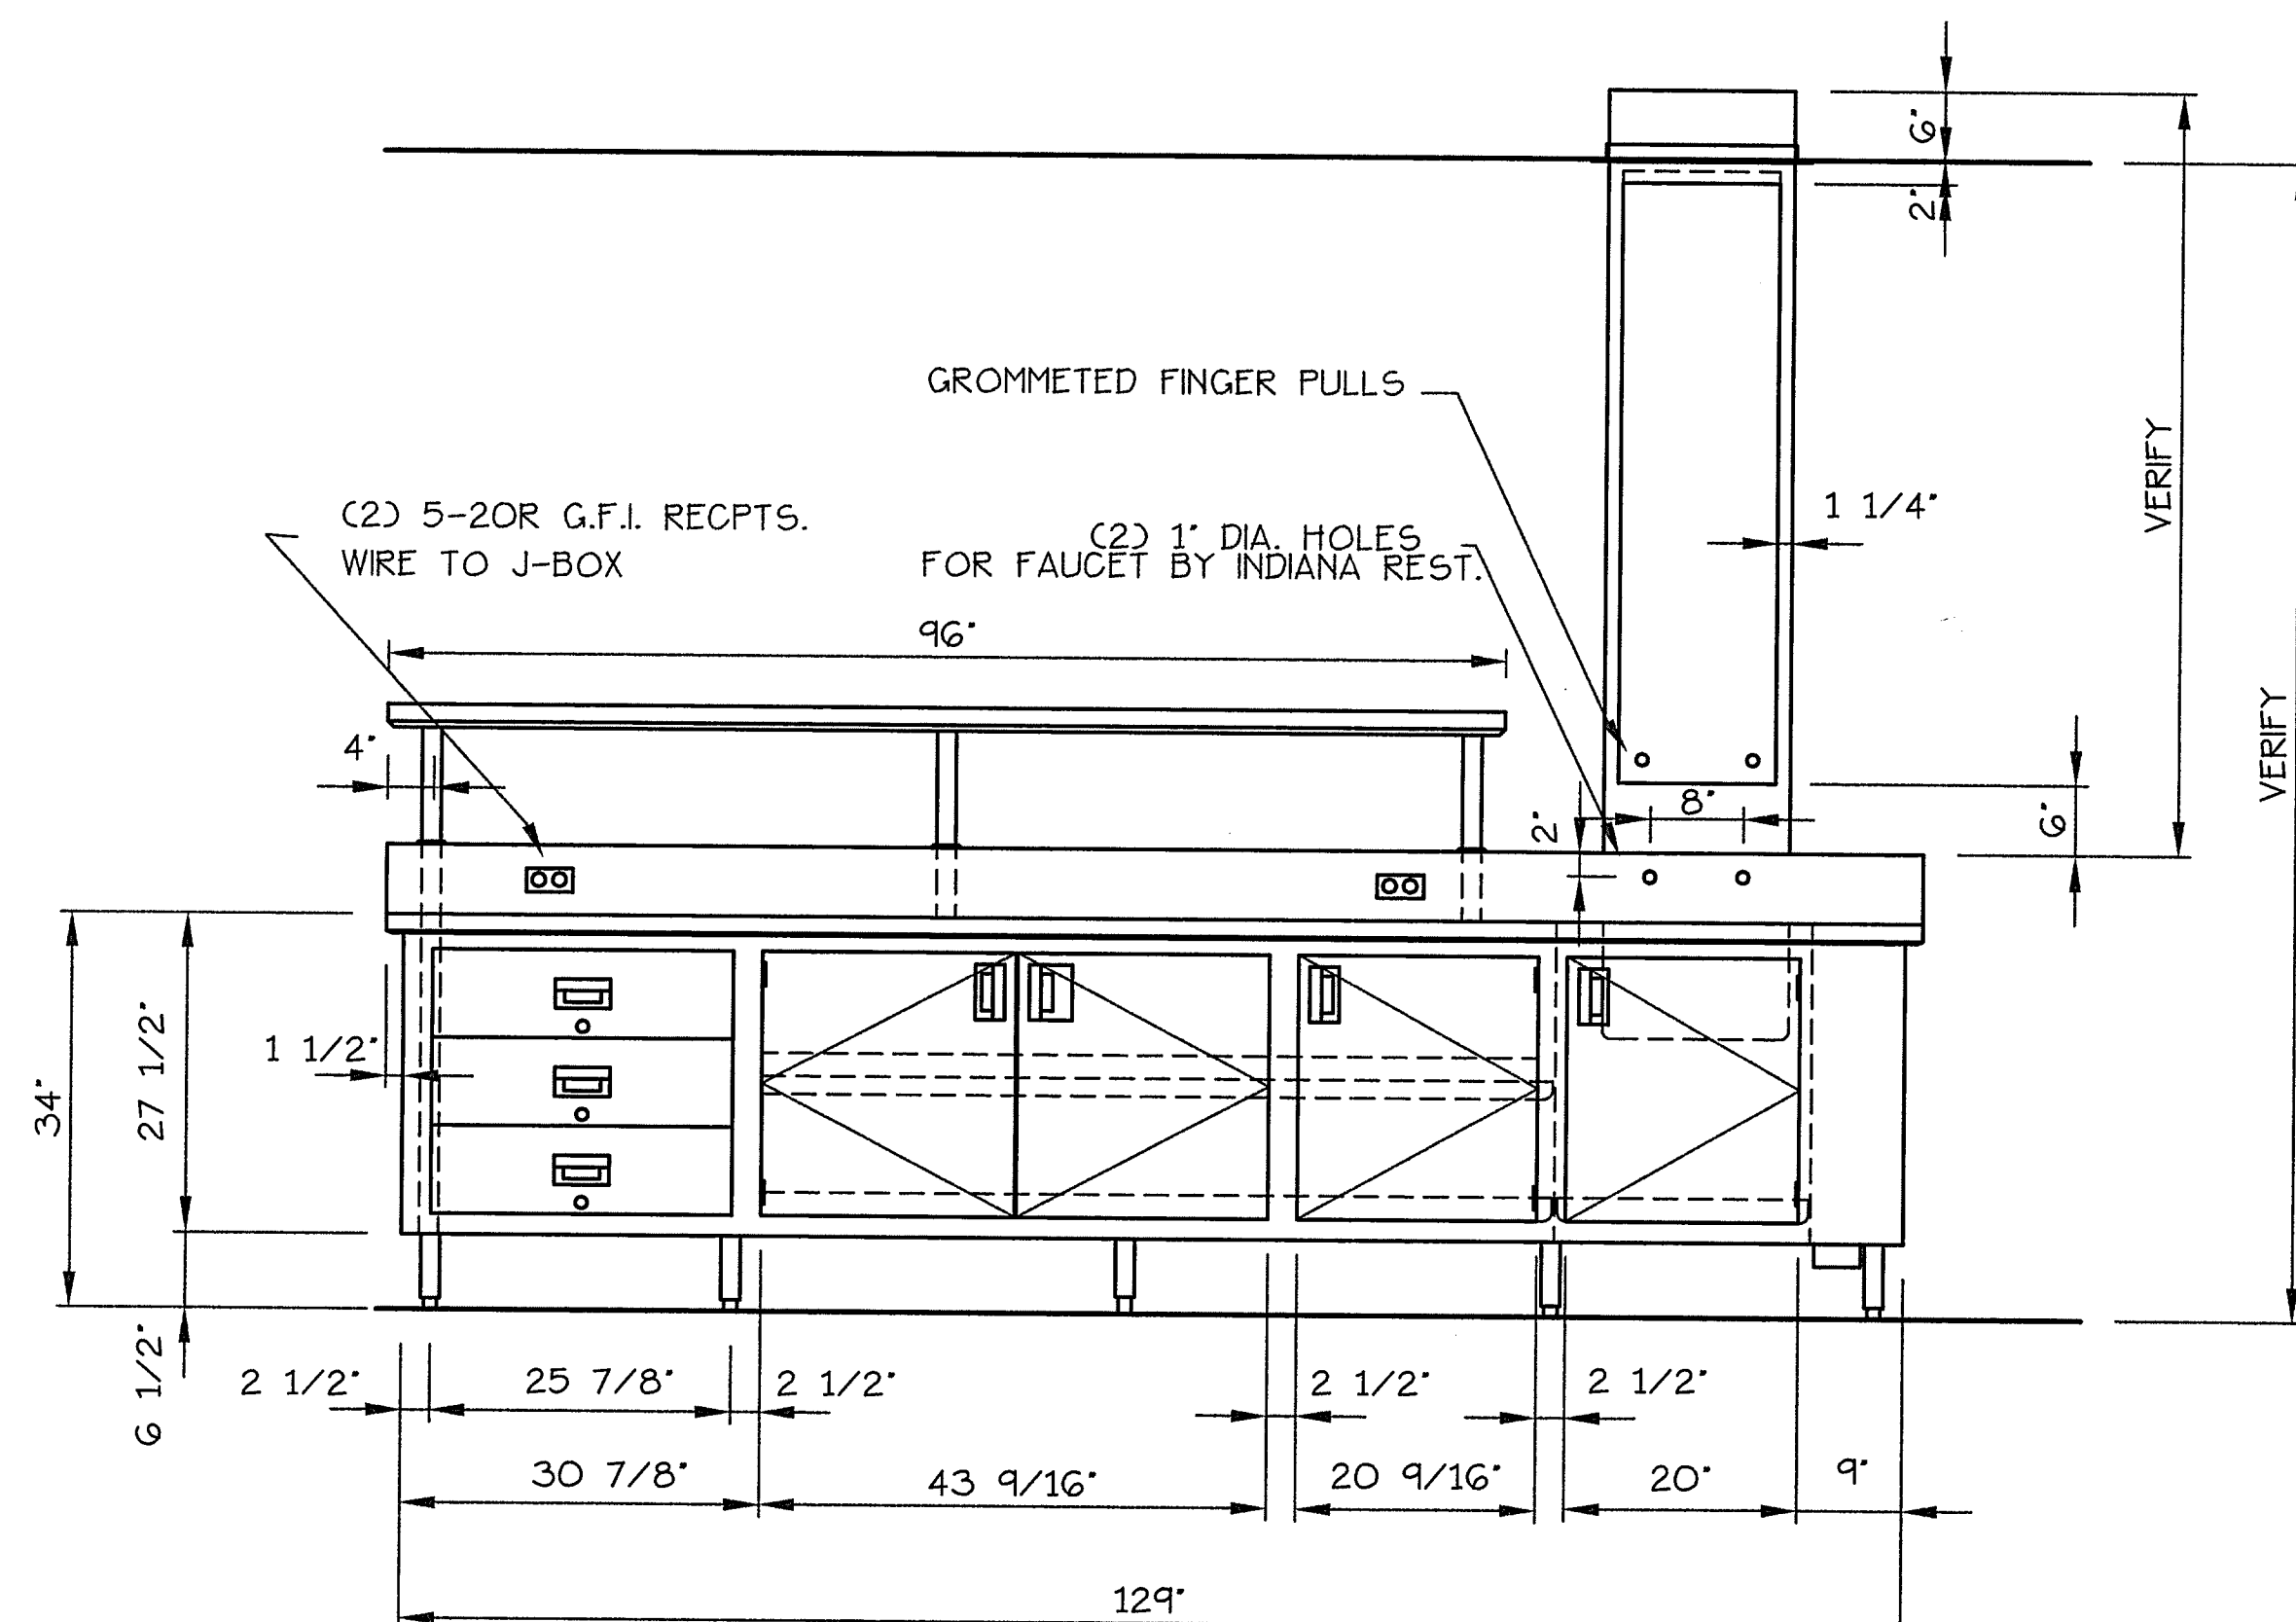
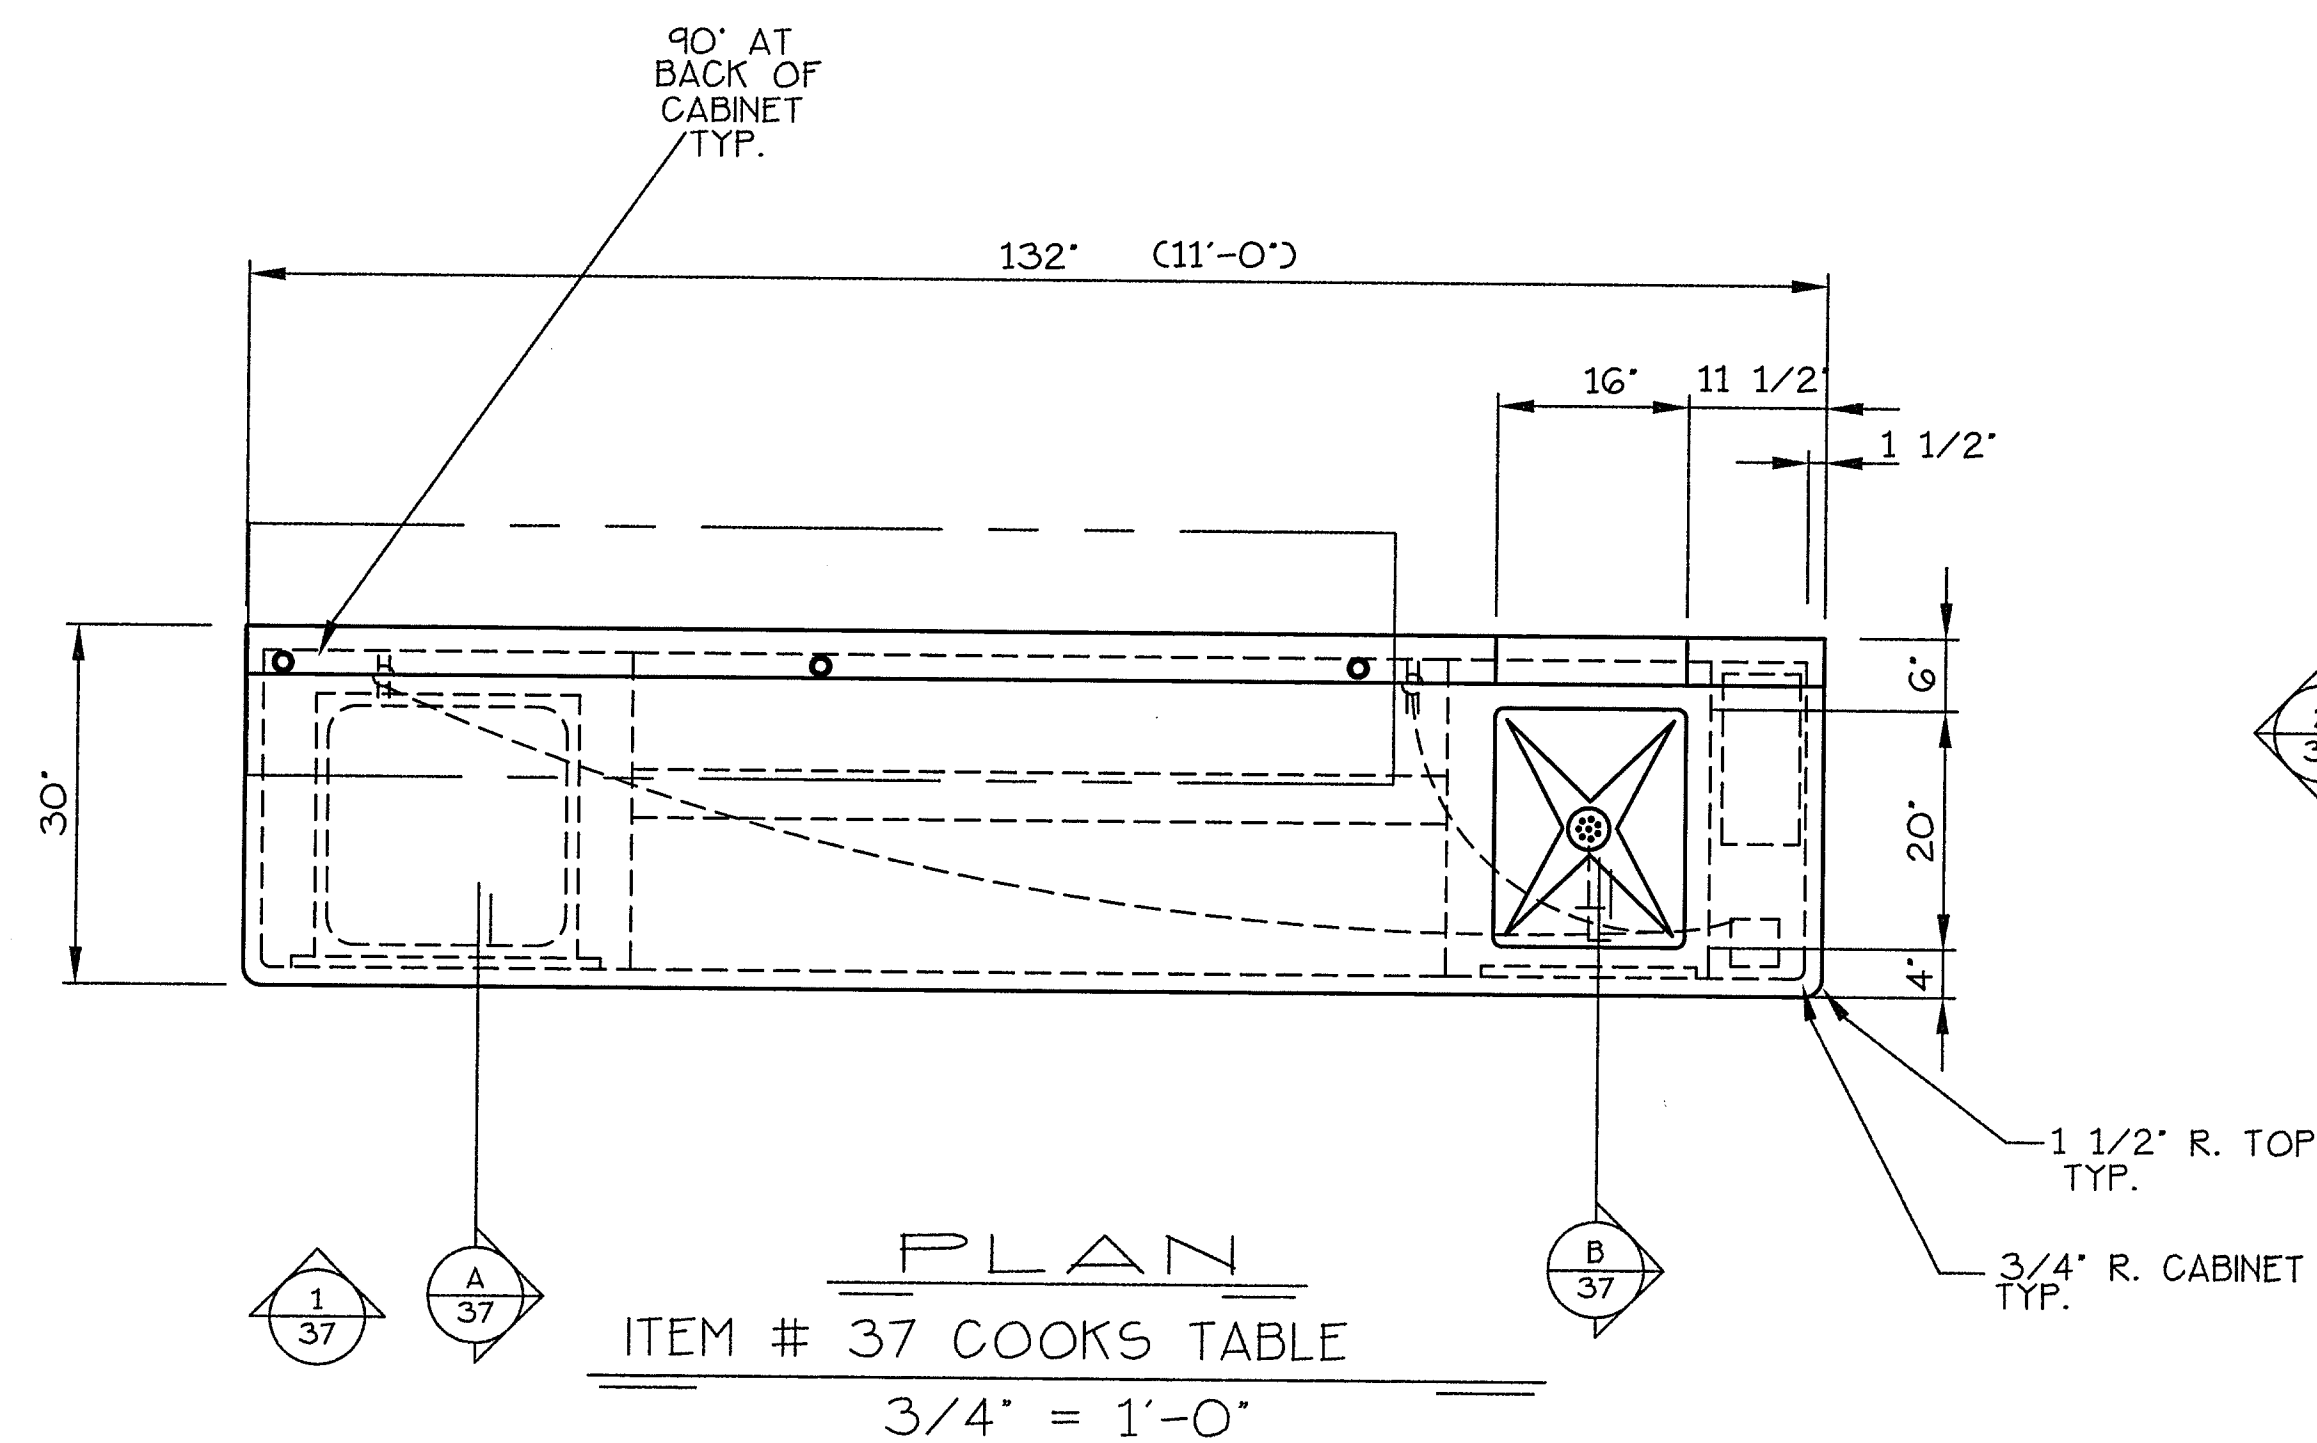


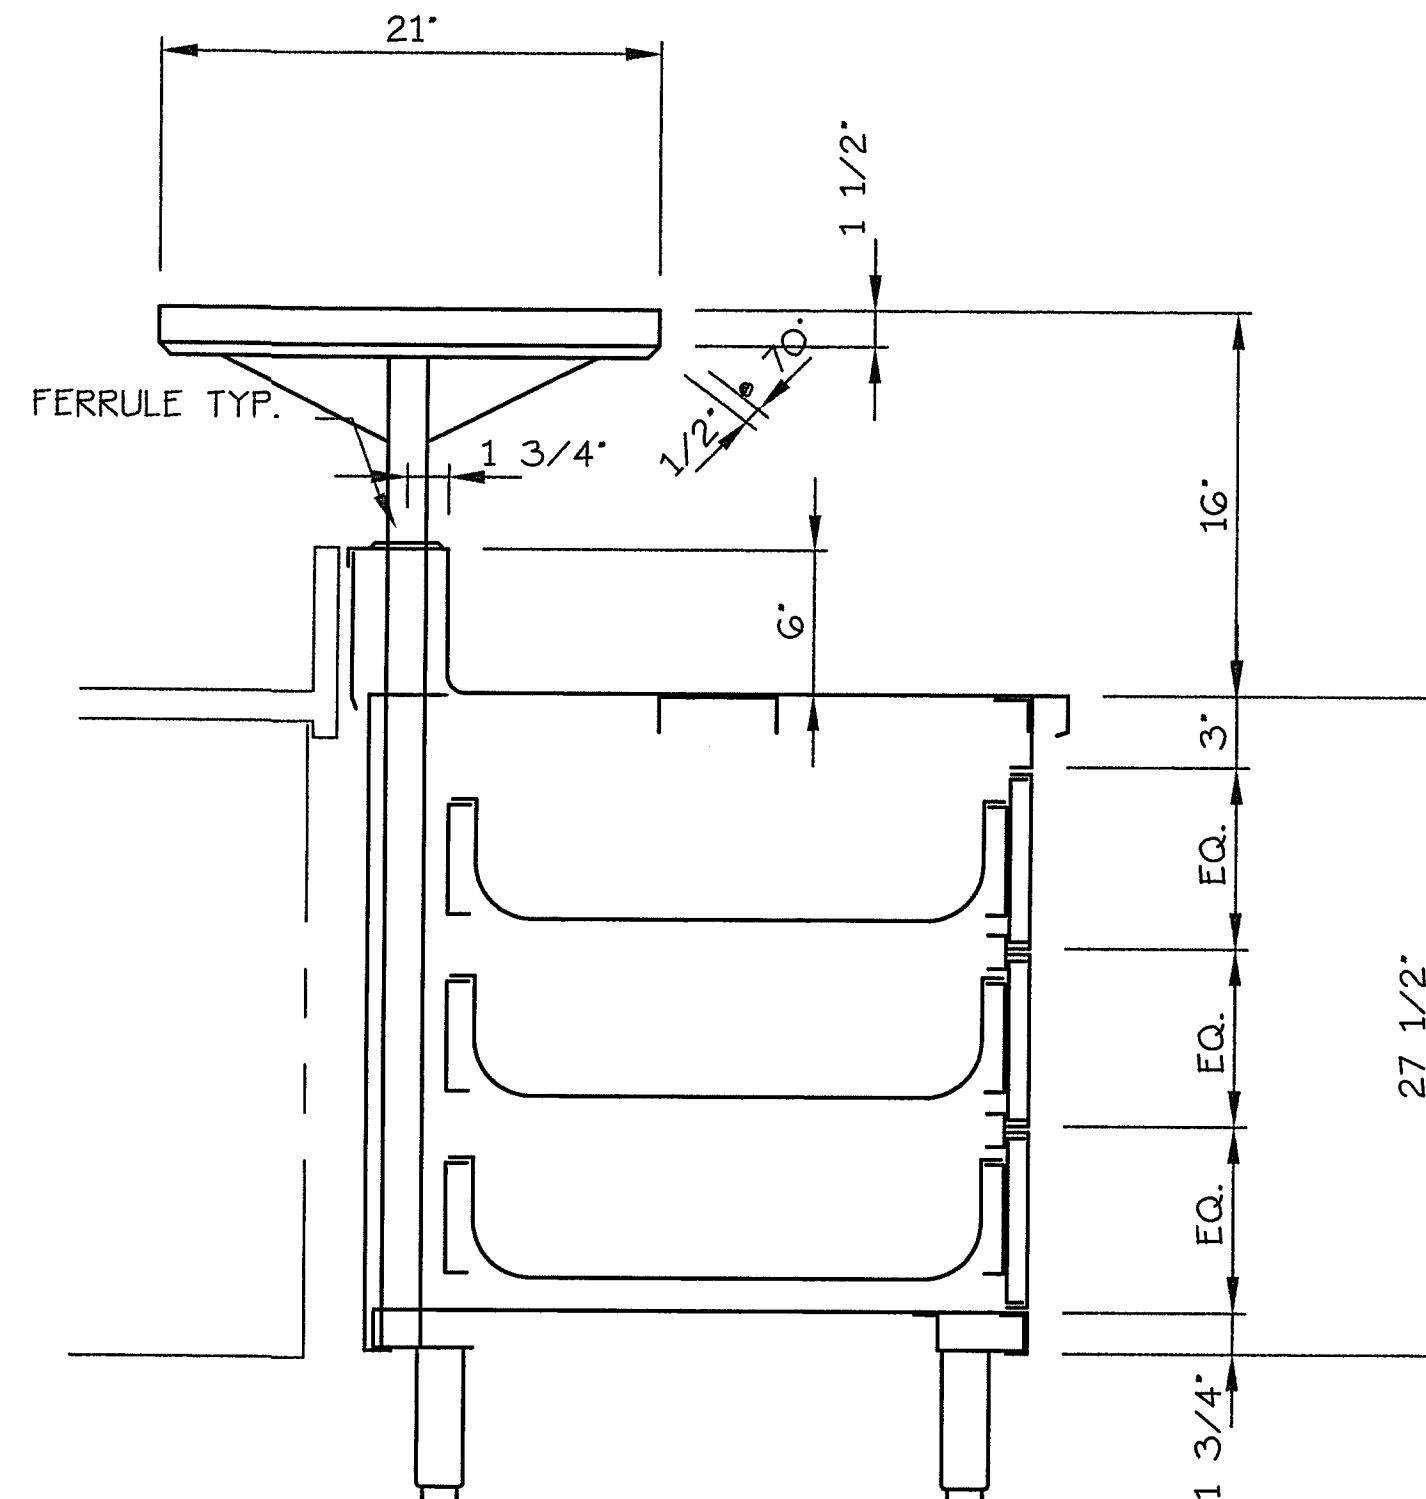

SHIP TO SHOP: BY INDIANA REST. EQUIP.

'AVTEC' QUICK DISCONNECT
D50 MODEL

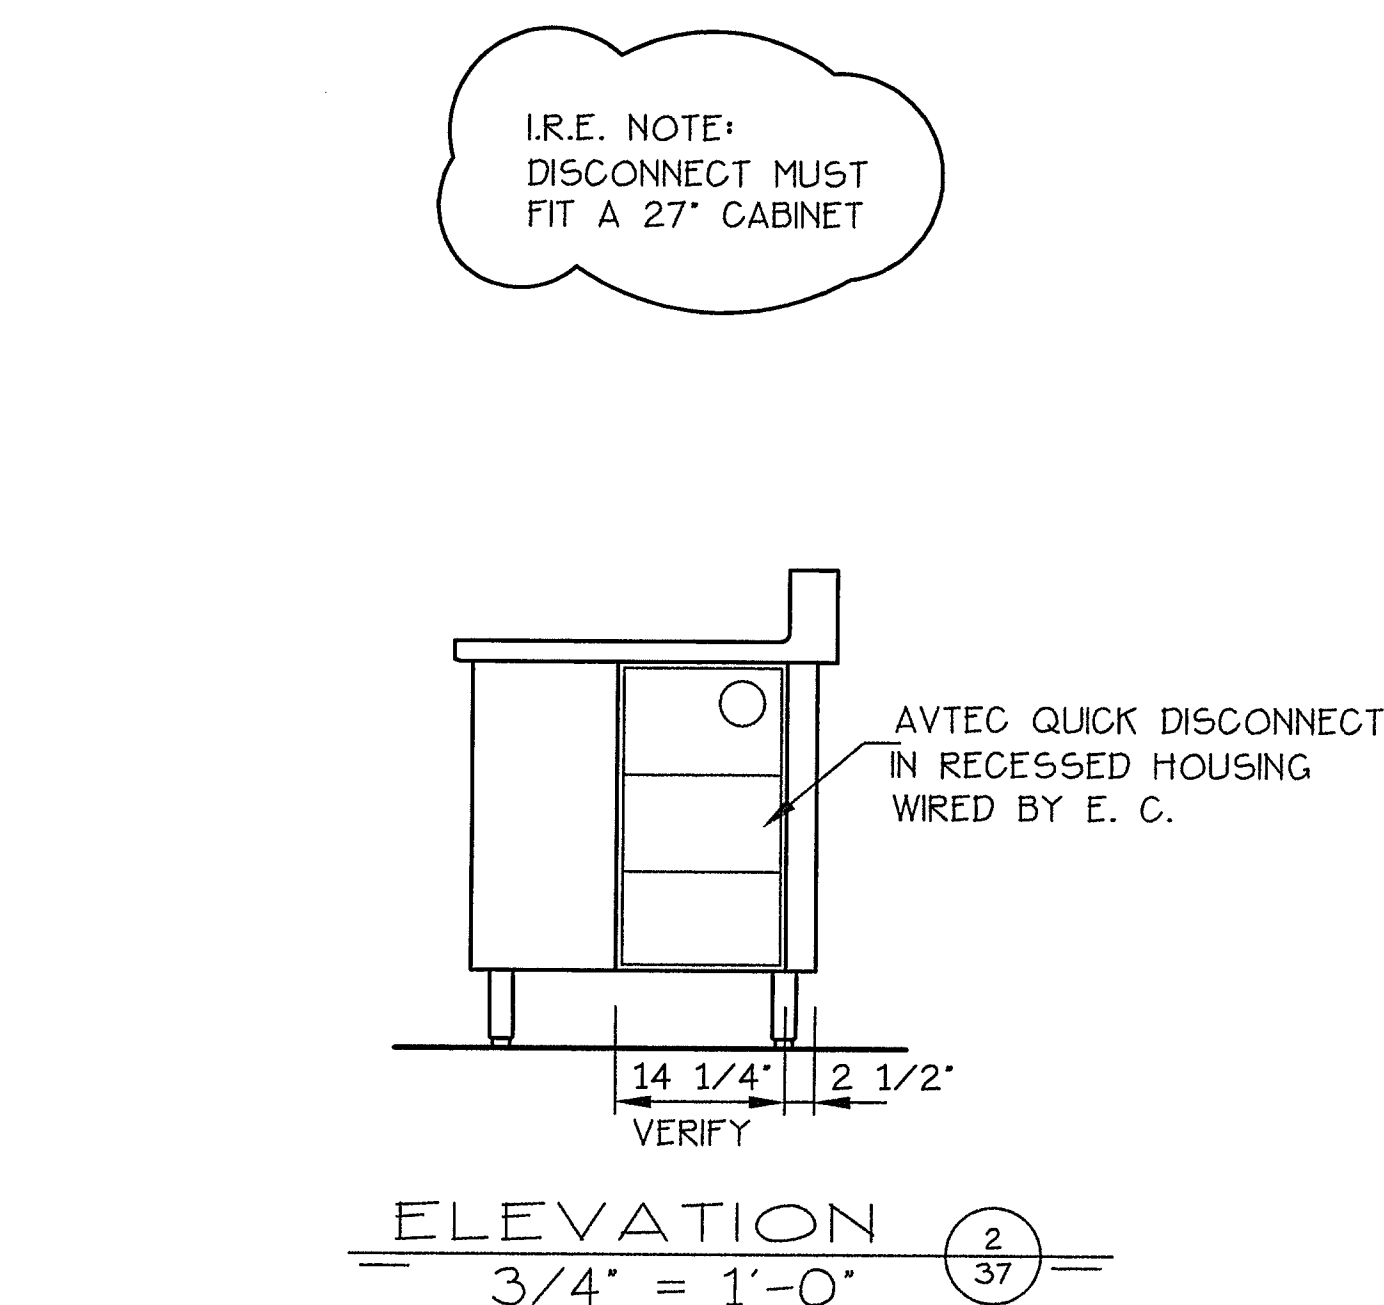

TOP: 14 GA. ST. ST. CONSTRUCTION - REIN. W/12 GA. GALV. CHANNEL-STUD WELD AND CAP W/C.PL. CAP NUTS-SOUND DEADEN + CAULK REIN.

CABINET: 16 GA. ST. ST. CONSTRUCTION WITH GALV. FRAME

SINK: 14 GA. ST. ST. 3/4"R. CONSTRUCTION-COMPONENT HARDWARE D50-7200 ROTARY WASTE W/O OVERFLOW ST. ST. HANDLE SUPPORT (N862)

PIPE CHASE: 16 GA. S/S CONST.- 18 GA.S/S ACCESS PANEL W/ 22 GA. S/S COLLAR (N881)


DOOR: 18 GA. S/S DBL. PAN INSUL. CONST. W/RECESSED PULLS-S/S LIFT OFF HINGES SPRING CATCHES

DRAWER: ST. ST. DBL. PAN INSUL. FACING W/RECESSED PULL-ST. ST. CRADLE FRAME-1452 SERIES DRAWER TRACK-20 x 20 x 5 REMOVABLE 'ROYALITE' PAN-GALV. BOTTOM CLOSURE-NOISE ELIM. CYL. LOCKS (KEYED ALIKE)

LEGS: 1 5/8" DIA. ST. ST. CABINET STYLE W/ADJUSTABLE FEET

UNDERSHELF: 16 GA. ST. ST. CONSTRUCTION

O-SHELF: 16 GA. ST. ST. CONSTRUCTION W/ 14 GA. S/S WING BRACKETS-1 5/8" DIA. S/S UPRIGHTS

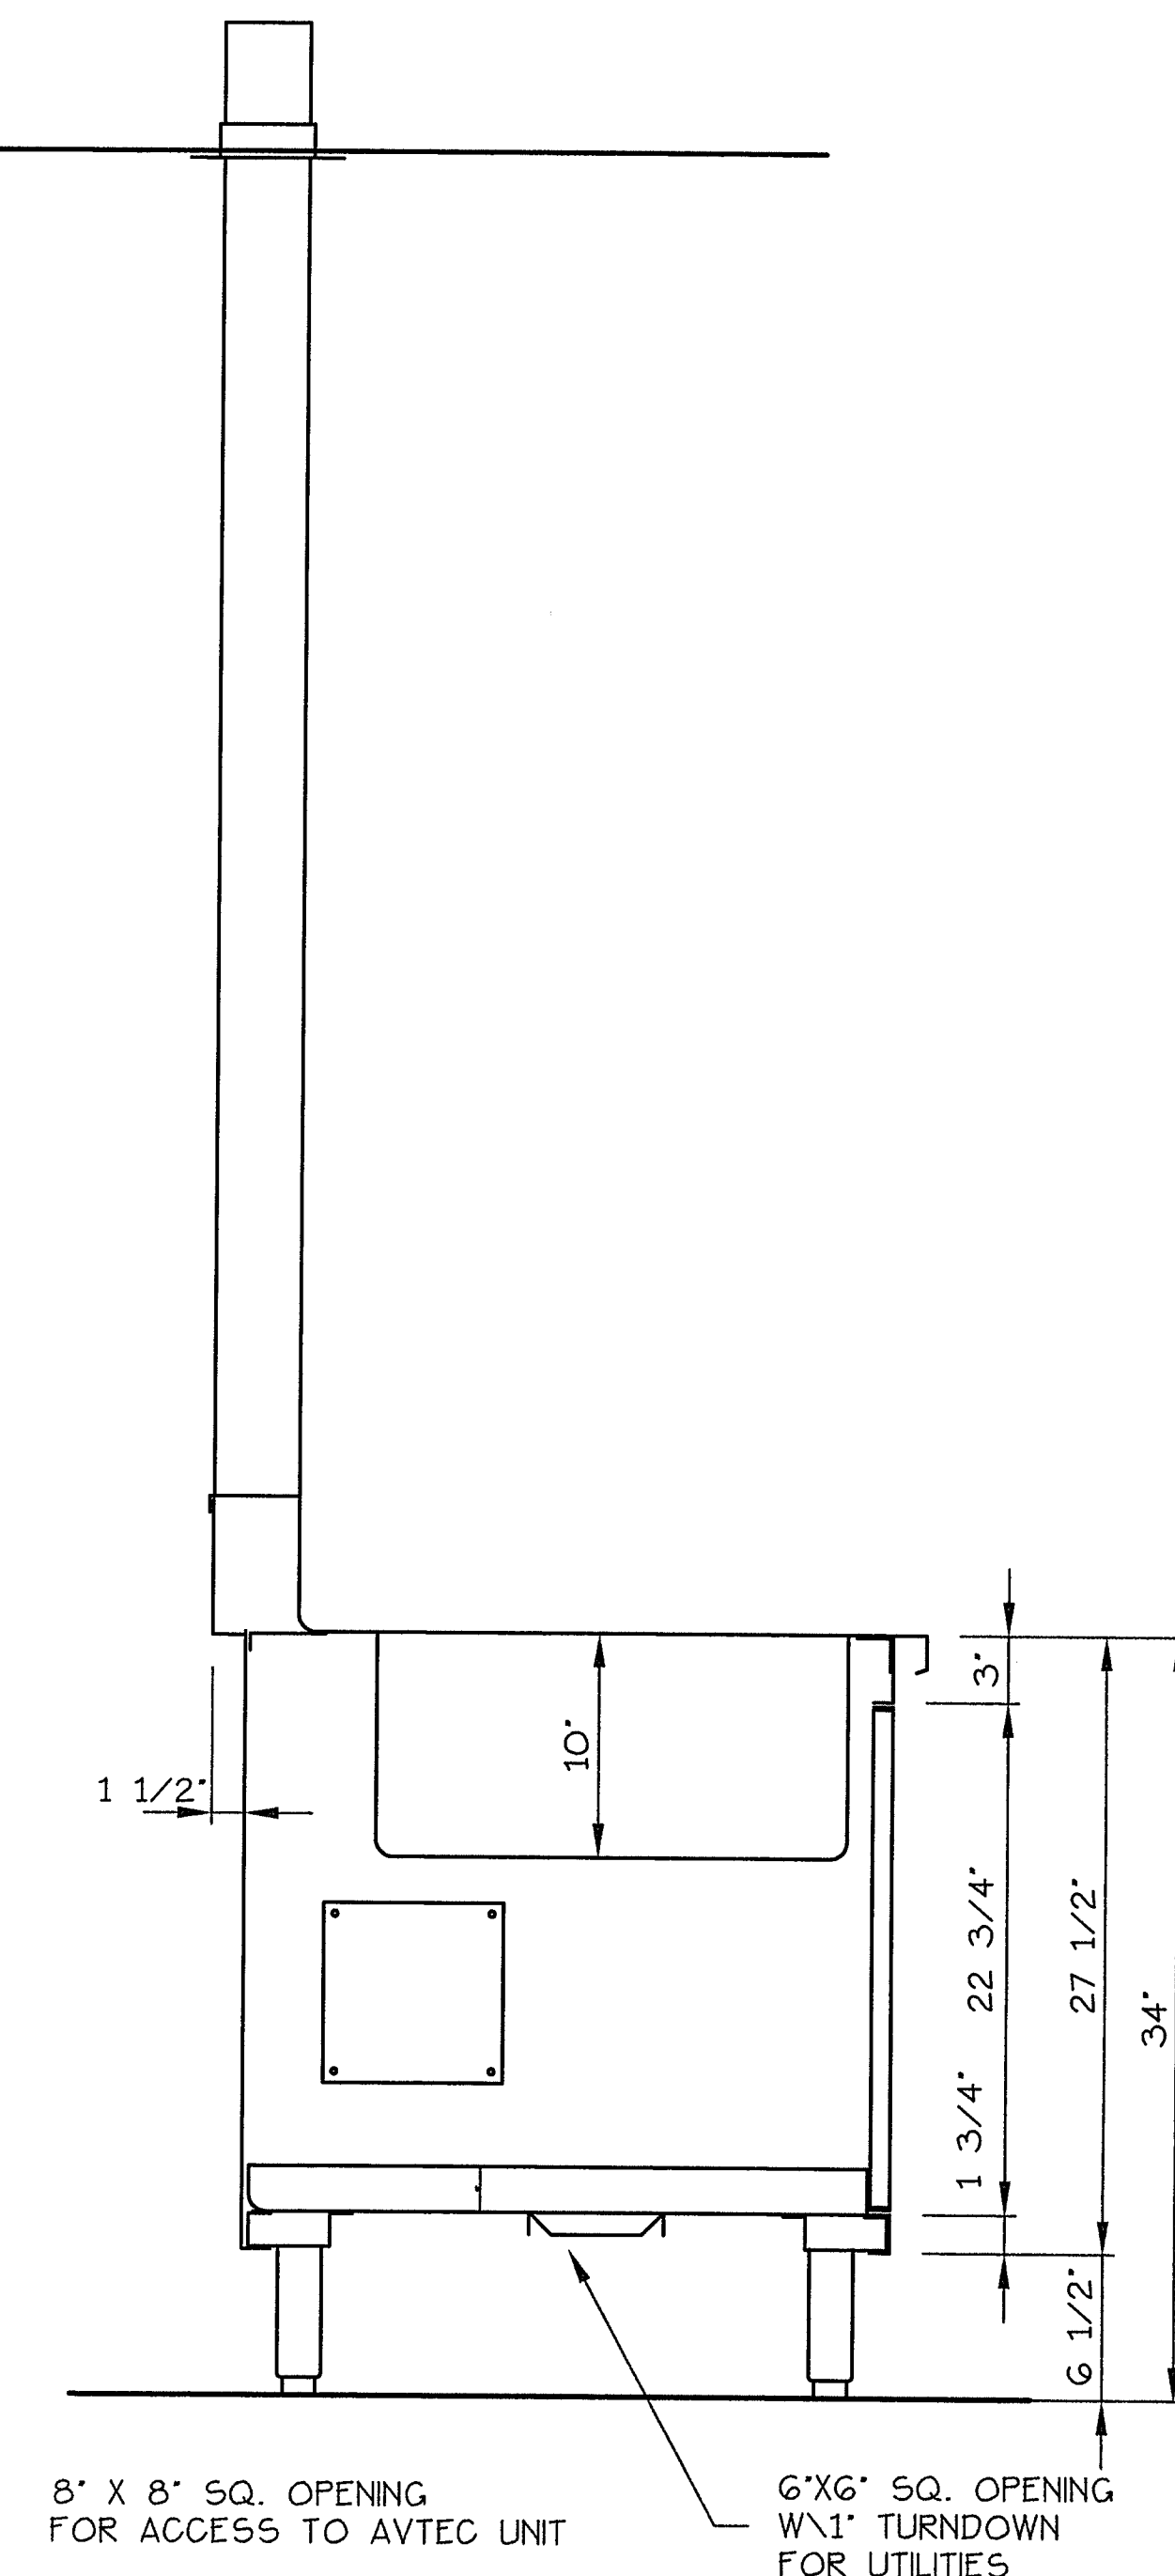

NOTE: ALL ITEMS SUBJECT TO NORMAL SHEET METAL TOLERANCES ±1/8".

THESE PLANS AND THE DESIGNS CONTAINED HEREIN ARE THE PROPERTY OF NORTHERN STAINLESS FABRICATING INC., AND MAY NOT BE REPRODUCED OR USED BY ANYONE, EITHER ALL OR IN PART, WITHOUT FIRST SECURING OUR WRITTEN PERMISSION.

Dealer Responsibility

Dealer to review for final approval, check, and provide all dimensions accordingly for all items before fabrication can proceed.

Signature Approval:

Name

Date

FOODSERVICE CONSULTANT
VORNDRAN & ASSOCIATES

ITEM NO. 37

REF. 5960-06 REF. 5962-07 REF. 5430 - 06	REVISIONS	DRAWN: BAM	CHECKED: MBG	APPROVED:	DATE: 2-12-98
JOB TITLE: NEW CHESTERTON HIGH SCHOOL					
CHESTERTON, INDIANA					
CUSTOMER: INDIANA RESTAURANT EQUIPMENT CO.					
WARSAW, INDIANA					
northern stainless fabricating inc.					
JOB NO. 5969					
SHEET NO. 7 of 14					