


PLAN
ITEM # 42 TRAYSLIDES (2) REQ'D
3/4" = 1'-0"





FIELD DIMENSIONS DETAIL
SCALE: 1/4"=1'-0"


KITCHEN EQUIPMENT CONTRACTOR TO VERIFY +
FILL IN ALL DIMENSIONS PRIOR TO FABRICATION-
OTHERWISE WALLS + DIMENSIONS WILL BE
ASSUMED CORRECT AS SHOWN

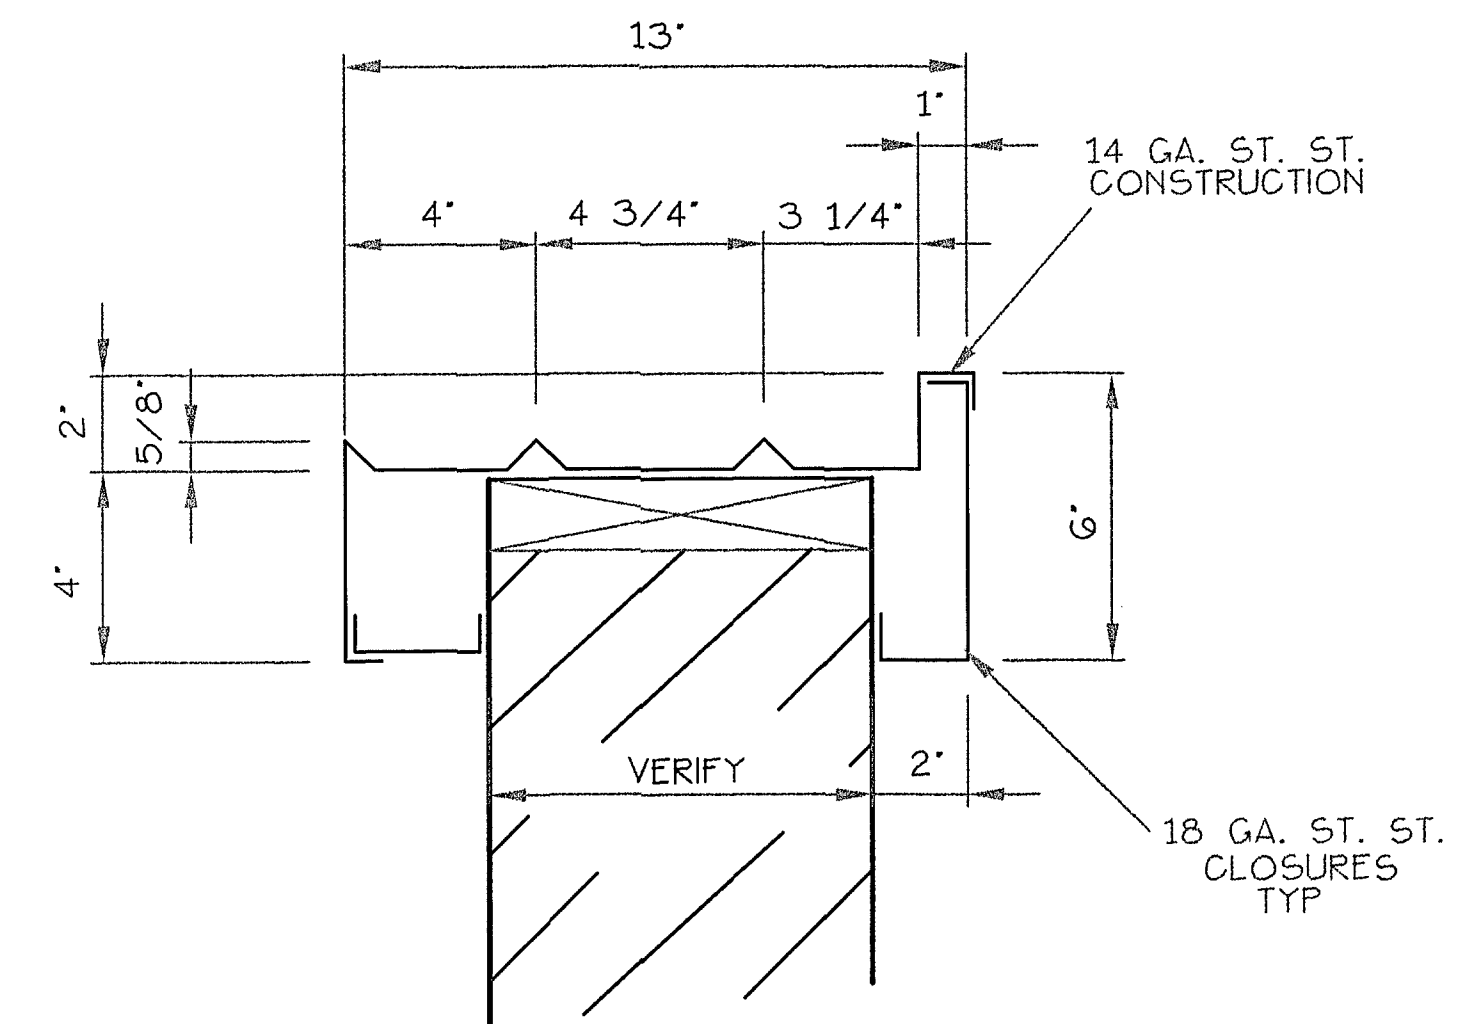

SECTION
1 1/2" = 1'-0" (A 42)

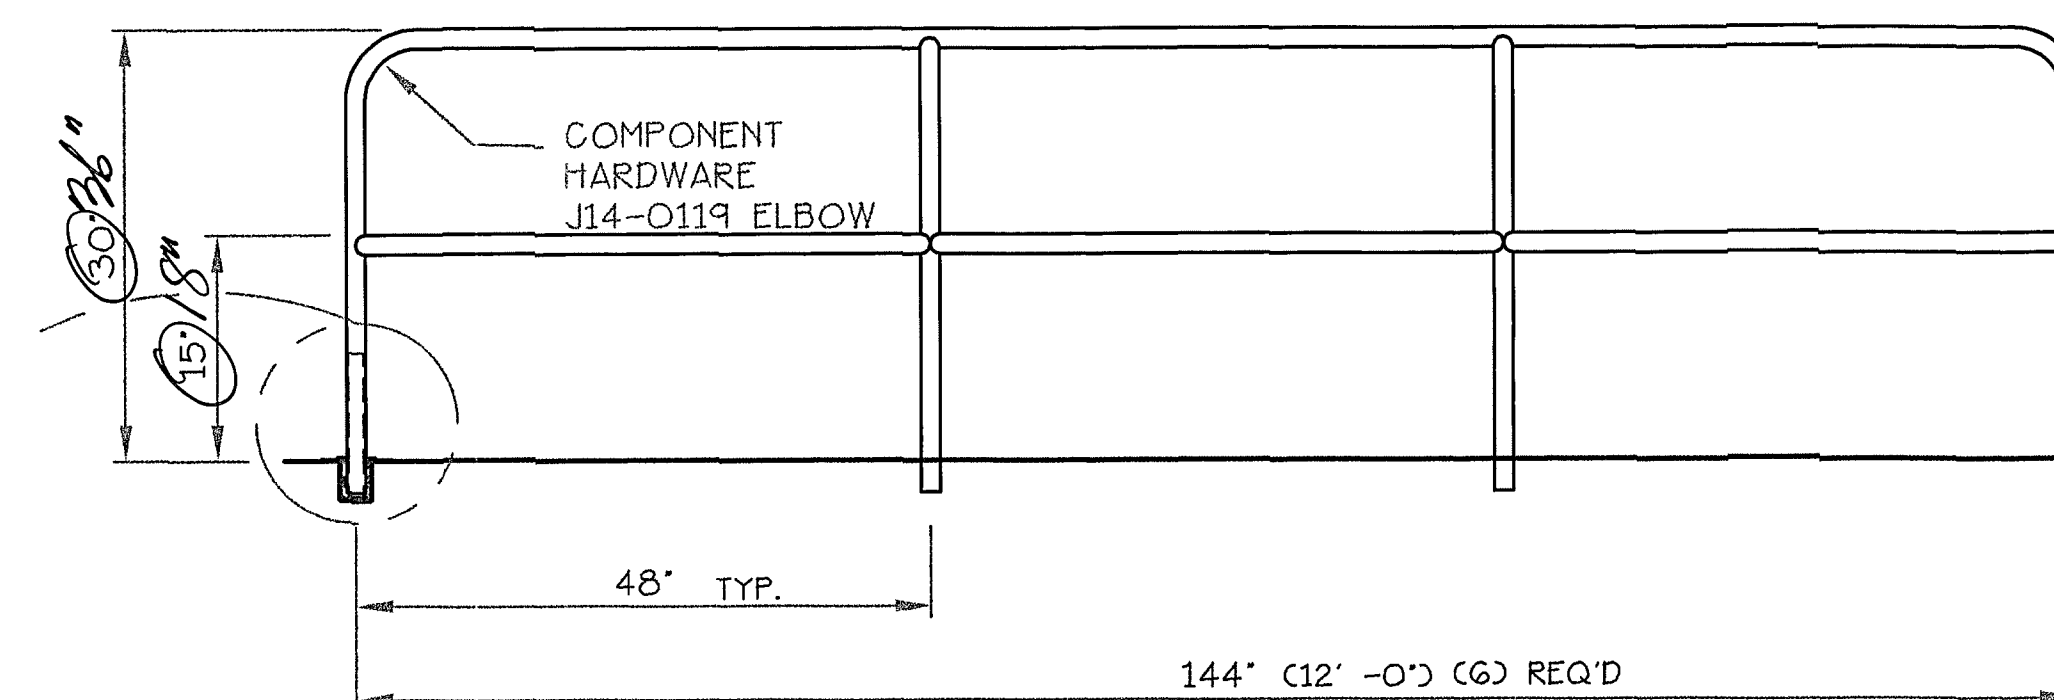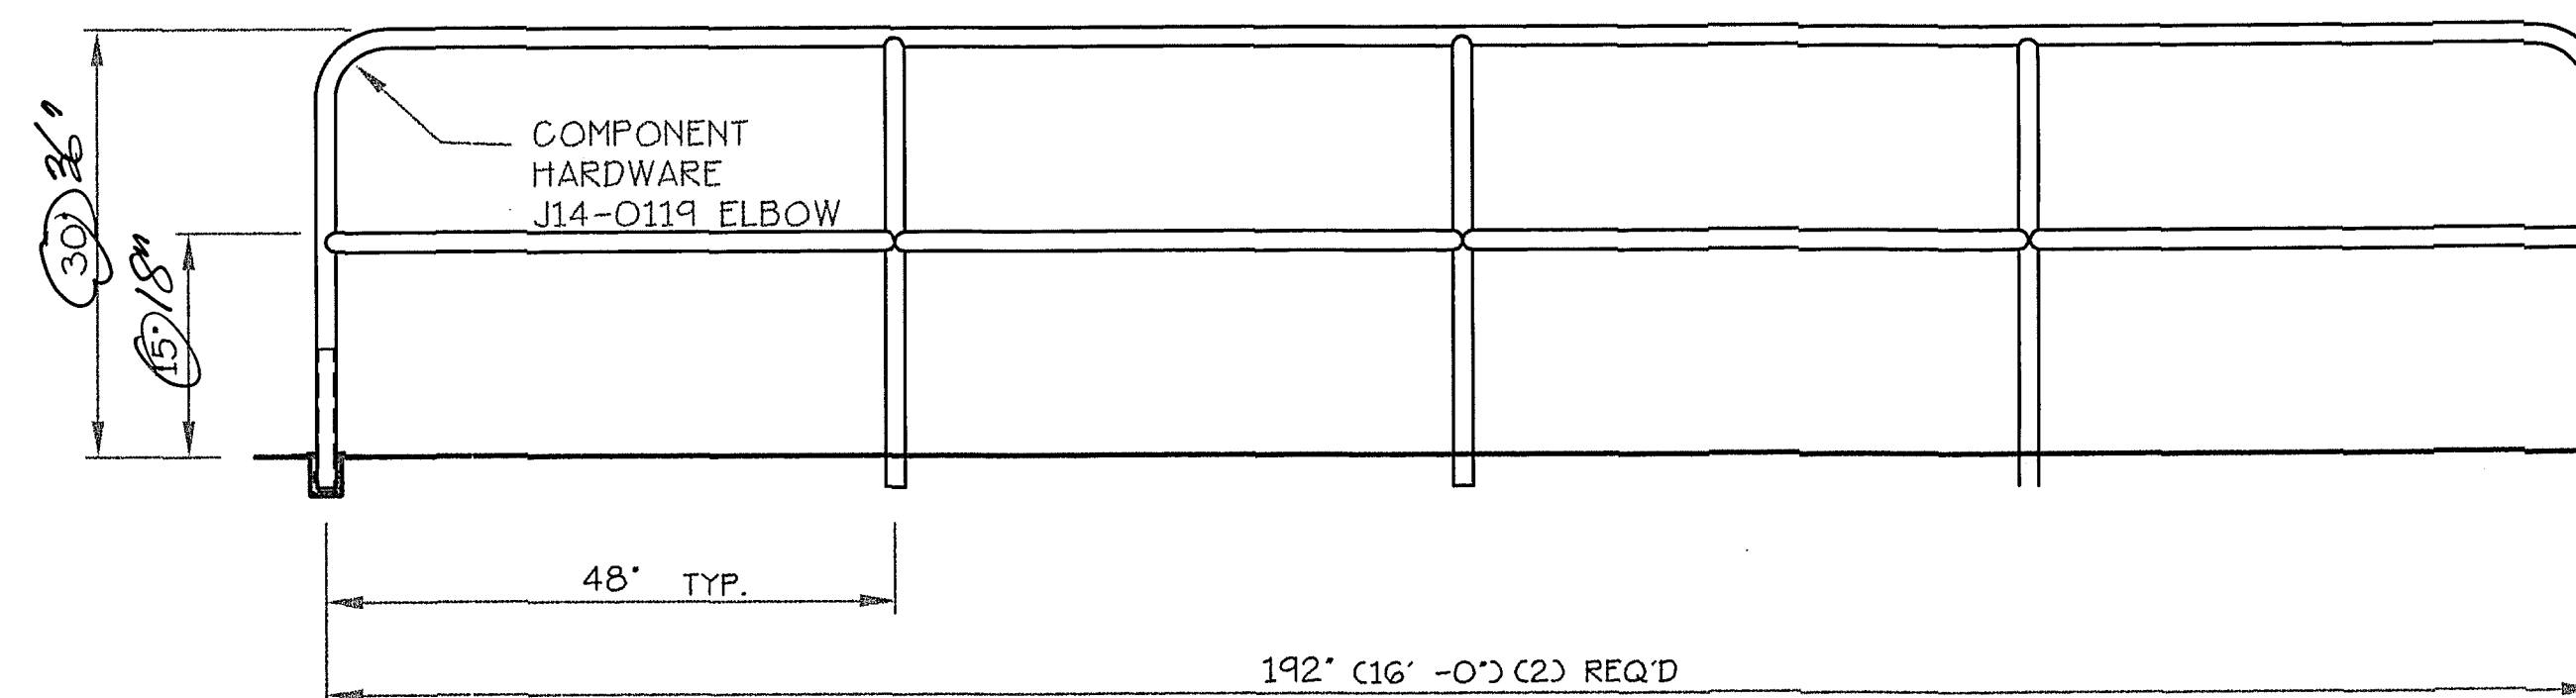


ITEM # 41 TRAFFIC RAILS (8) REQ'D
(2) 16'-0" LONG (6) 12'-0" LONG
3/4" = 1'-0"

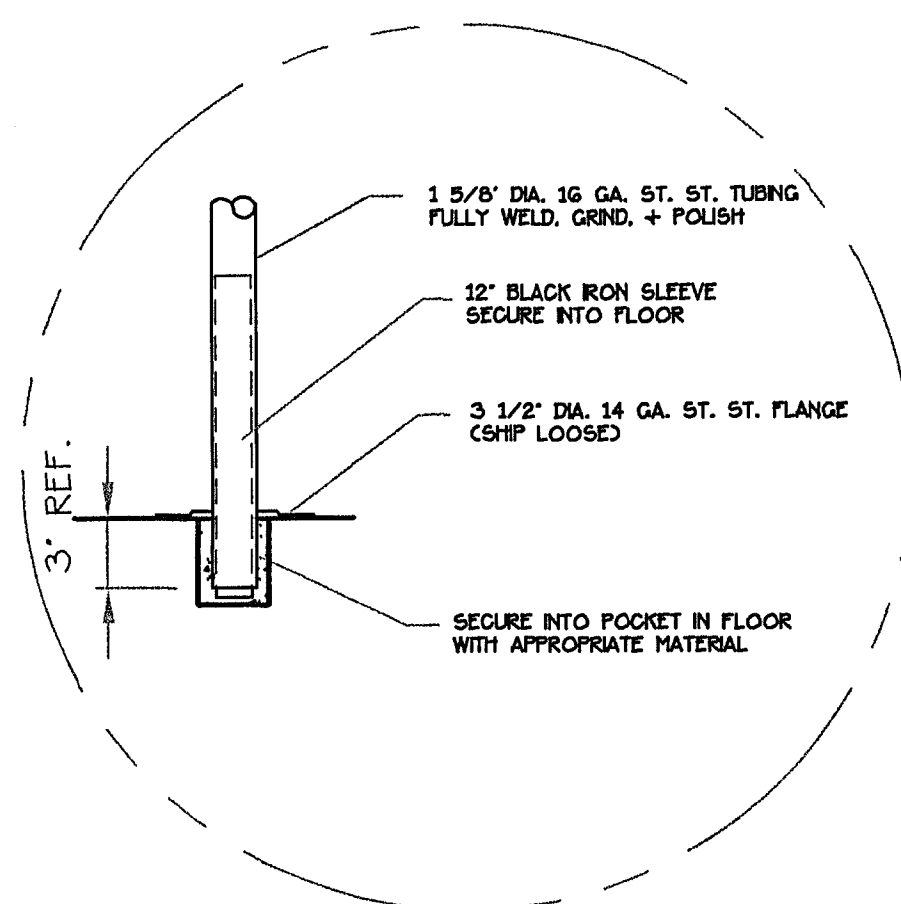

NOTE: ALL ITEMS SUBJECT TO NORMAL SHEET METAL TOLERANCES $\pm 1/8"$.	JOB NO.
THESE PLANS AND THE DESIGNS CONTAINED HEREIN ARE THE PROPERTY OF NORTHERN STAINLESS FABRICATING INC., AND MAY NOT BE REPRODUCED OR USED BY ANYONE, EITHER ALL OR IN PART, WITHOUT FIRST SECURING OUR WRITTEN PERMISSION.	5969
Dealer Responsibility Dealer to review for final approval, check, and provide all dimensions accordingly for all items before fabrication can proceed. Signature Approval: _____ Name _____ Date _____	SHEET NO.
ITEM NO. 41,42	11 OF 14

FOODSERVICE CONSULTANT
VORNDRAN & ASSOCIATES

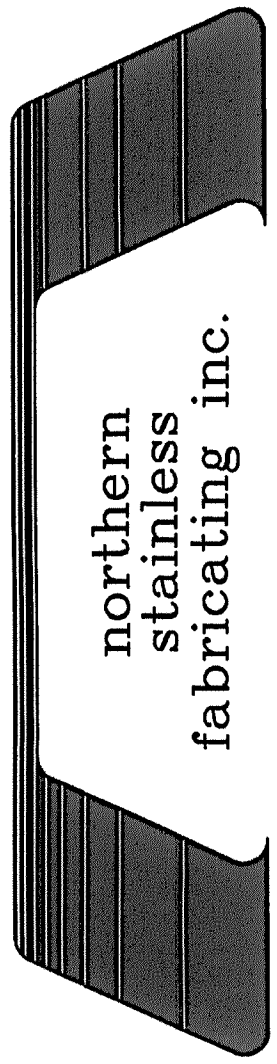JOB TITLE: NEW CHESTERTON HIGH SCHOOL CHESTERTON, INDIANA CUSTOMER: INDIANA RESTAURANT EQUIPMENT CO. WARSAW, INDIANA	DRAWN: BAM CHECKED: MBG APPROVED: _____ DATE: 2-12-98	REVISIONS <table border="1"> <tr><td> </td><td> </td></tr> <tr><td> </td><td> </td></tr> <tr><td> </td><td> </td></tr> <tr><td> </td><td> </td></tr> </table>								
										
THESE PLANS AND THE DESIGNS CONTAINED HEREIN ARE THE PROPERTY OF NORTHERN STAINLESS FABRICATING INC., AND MAY NOT BE REPRODUCED OR USED BY ANYONE, EITHER ALL OR IN PART, WITHOUT FIRST SECURING OUR WRITTEN PERMISSION.										
ITEM NO. 41,42										