

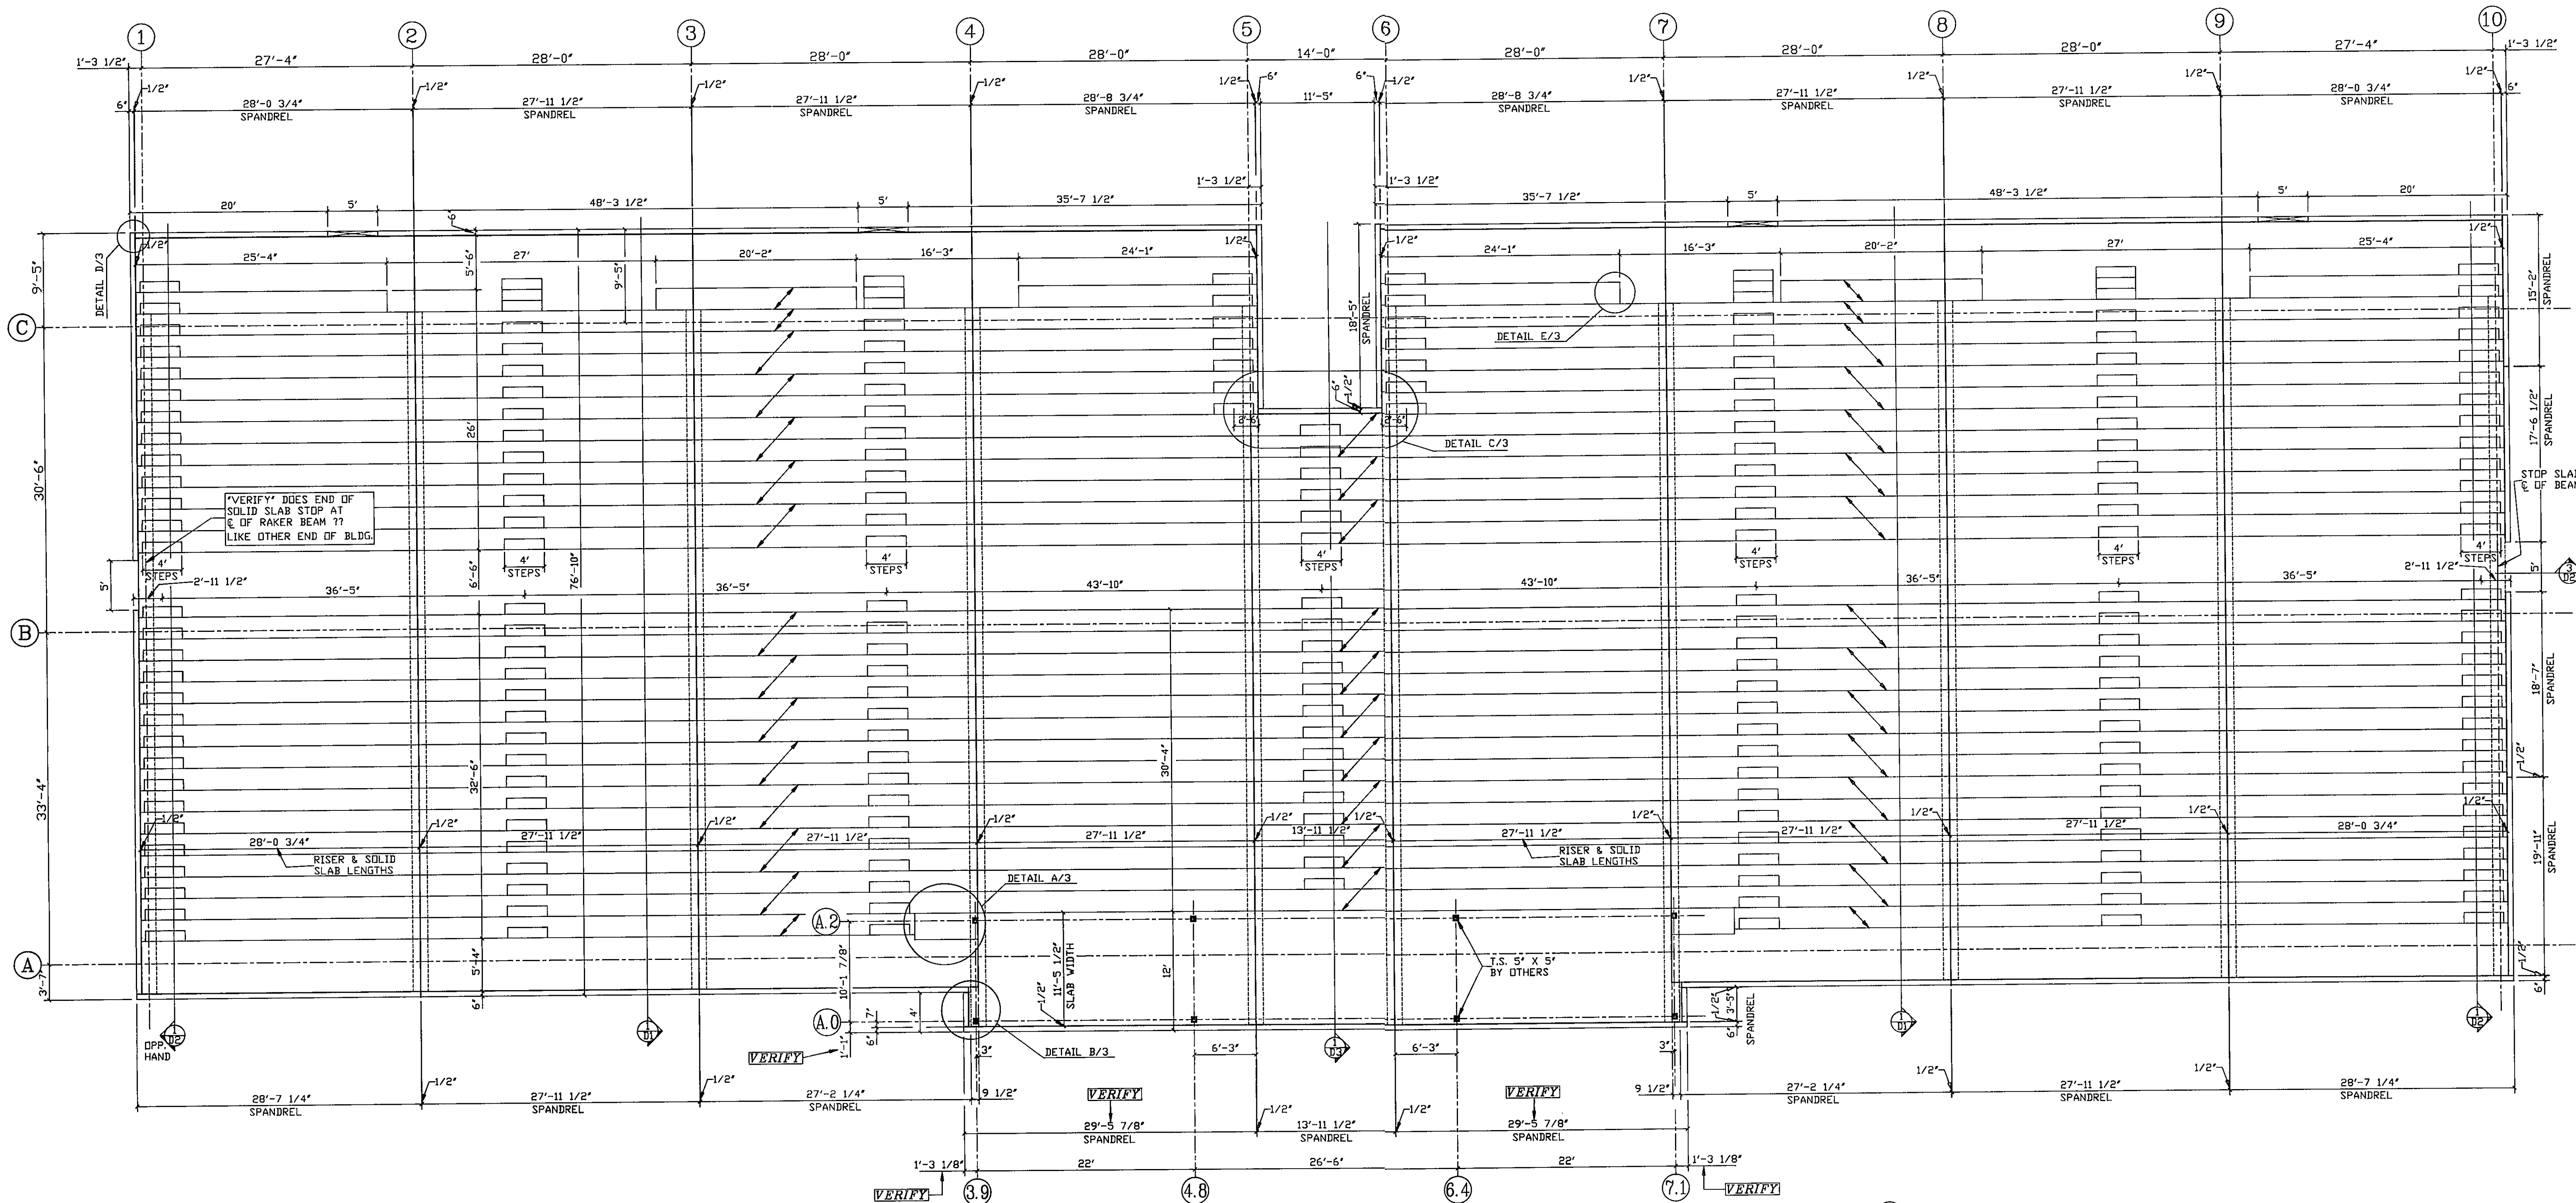
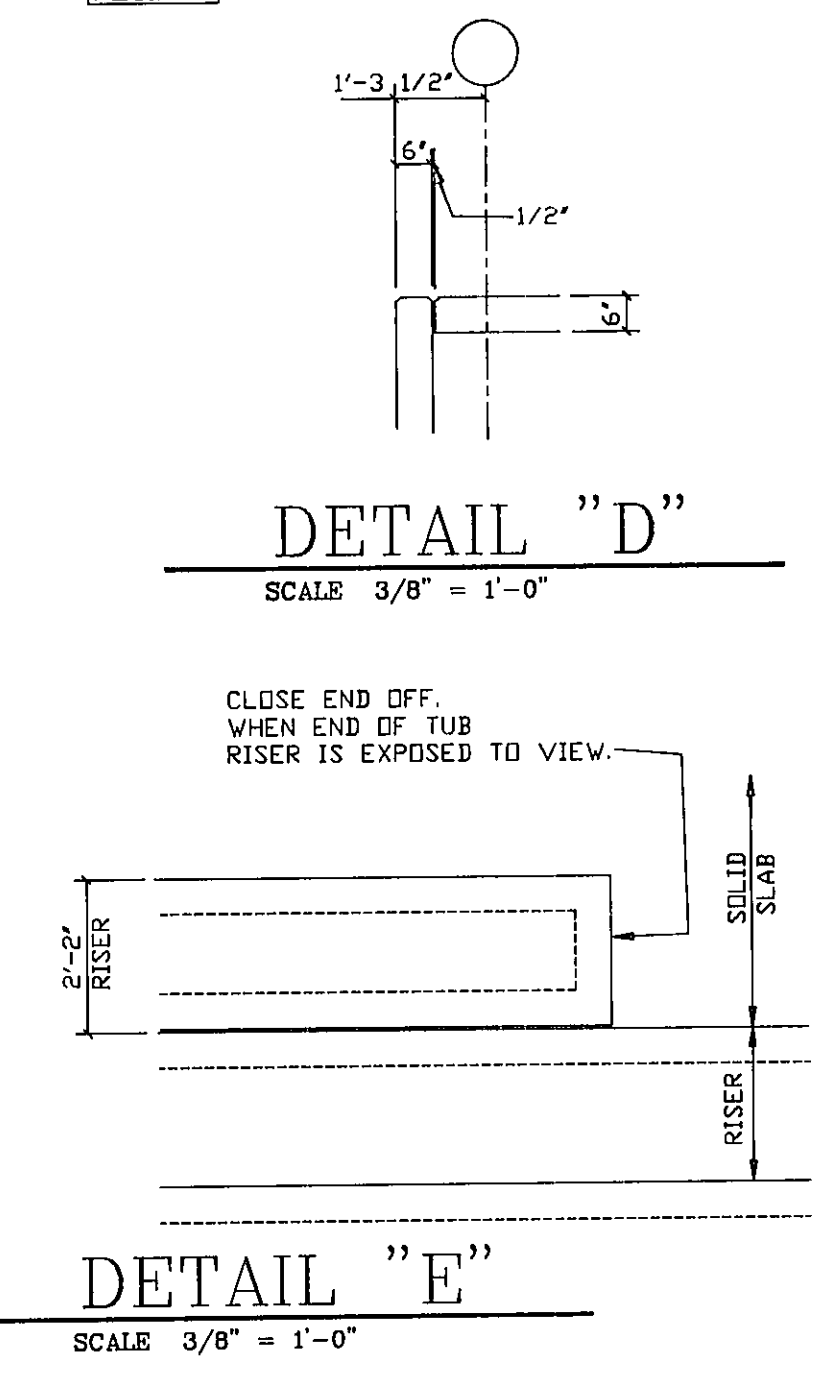
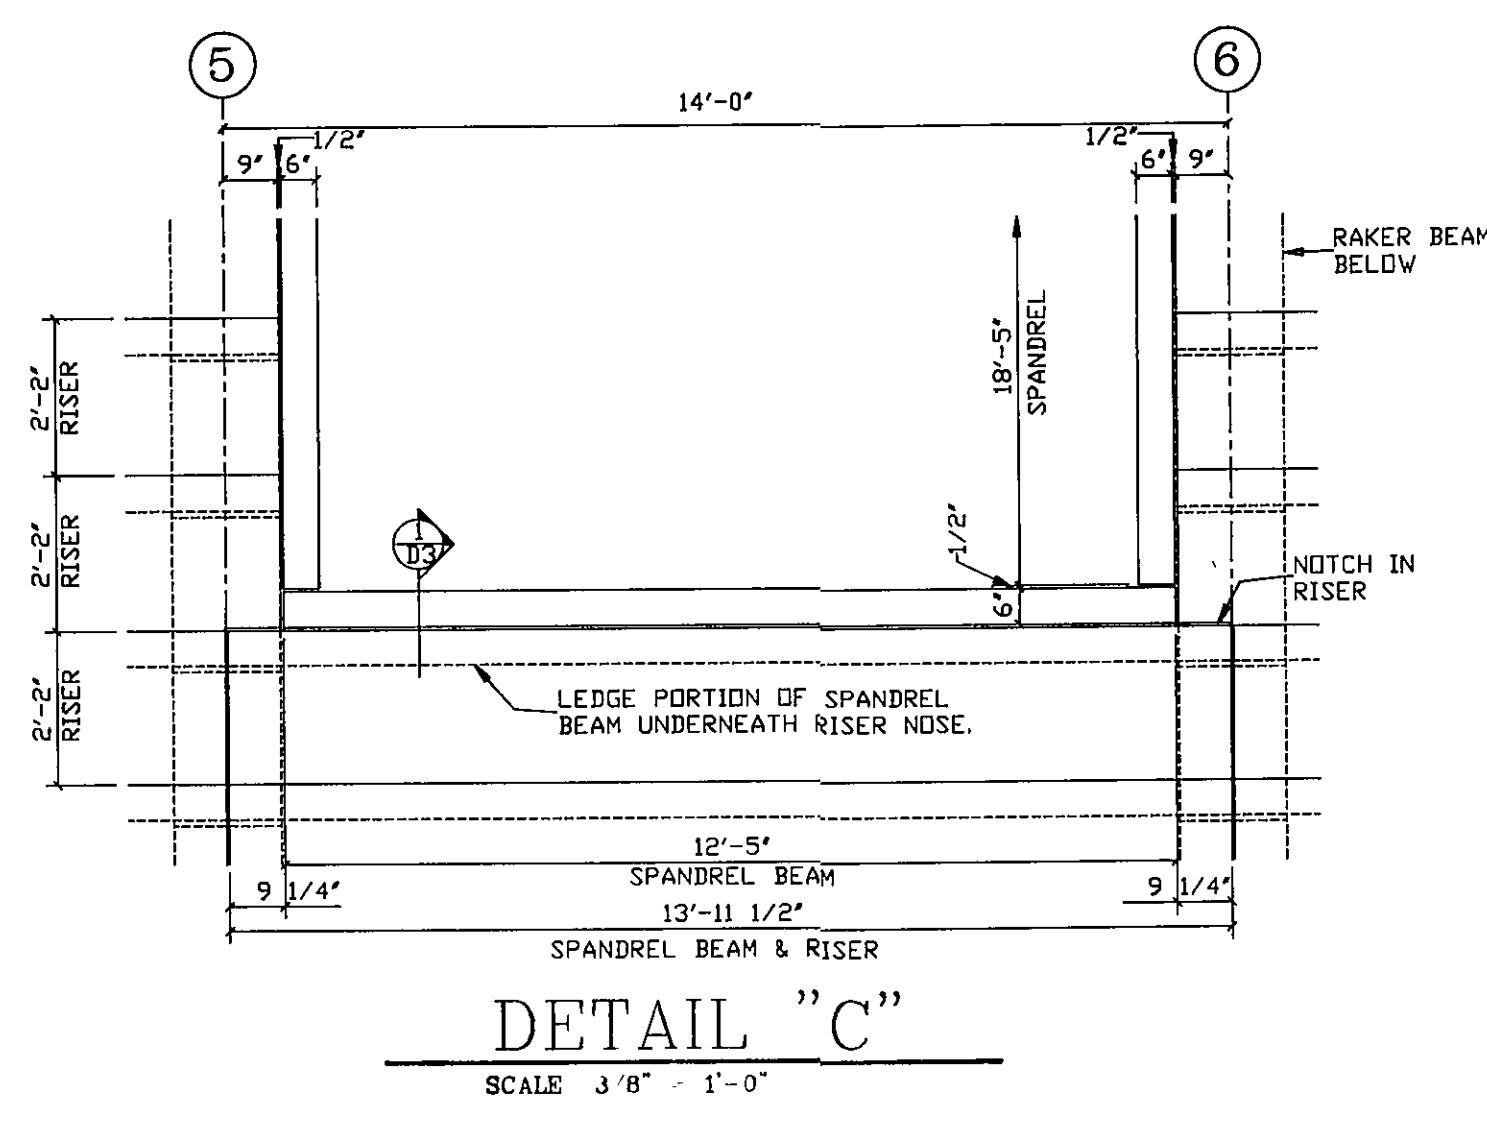


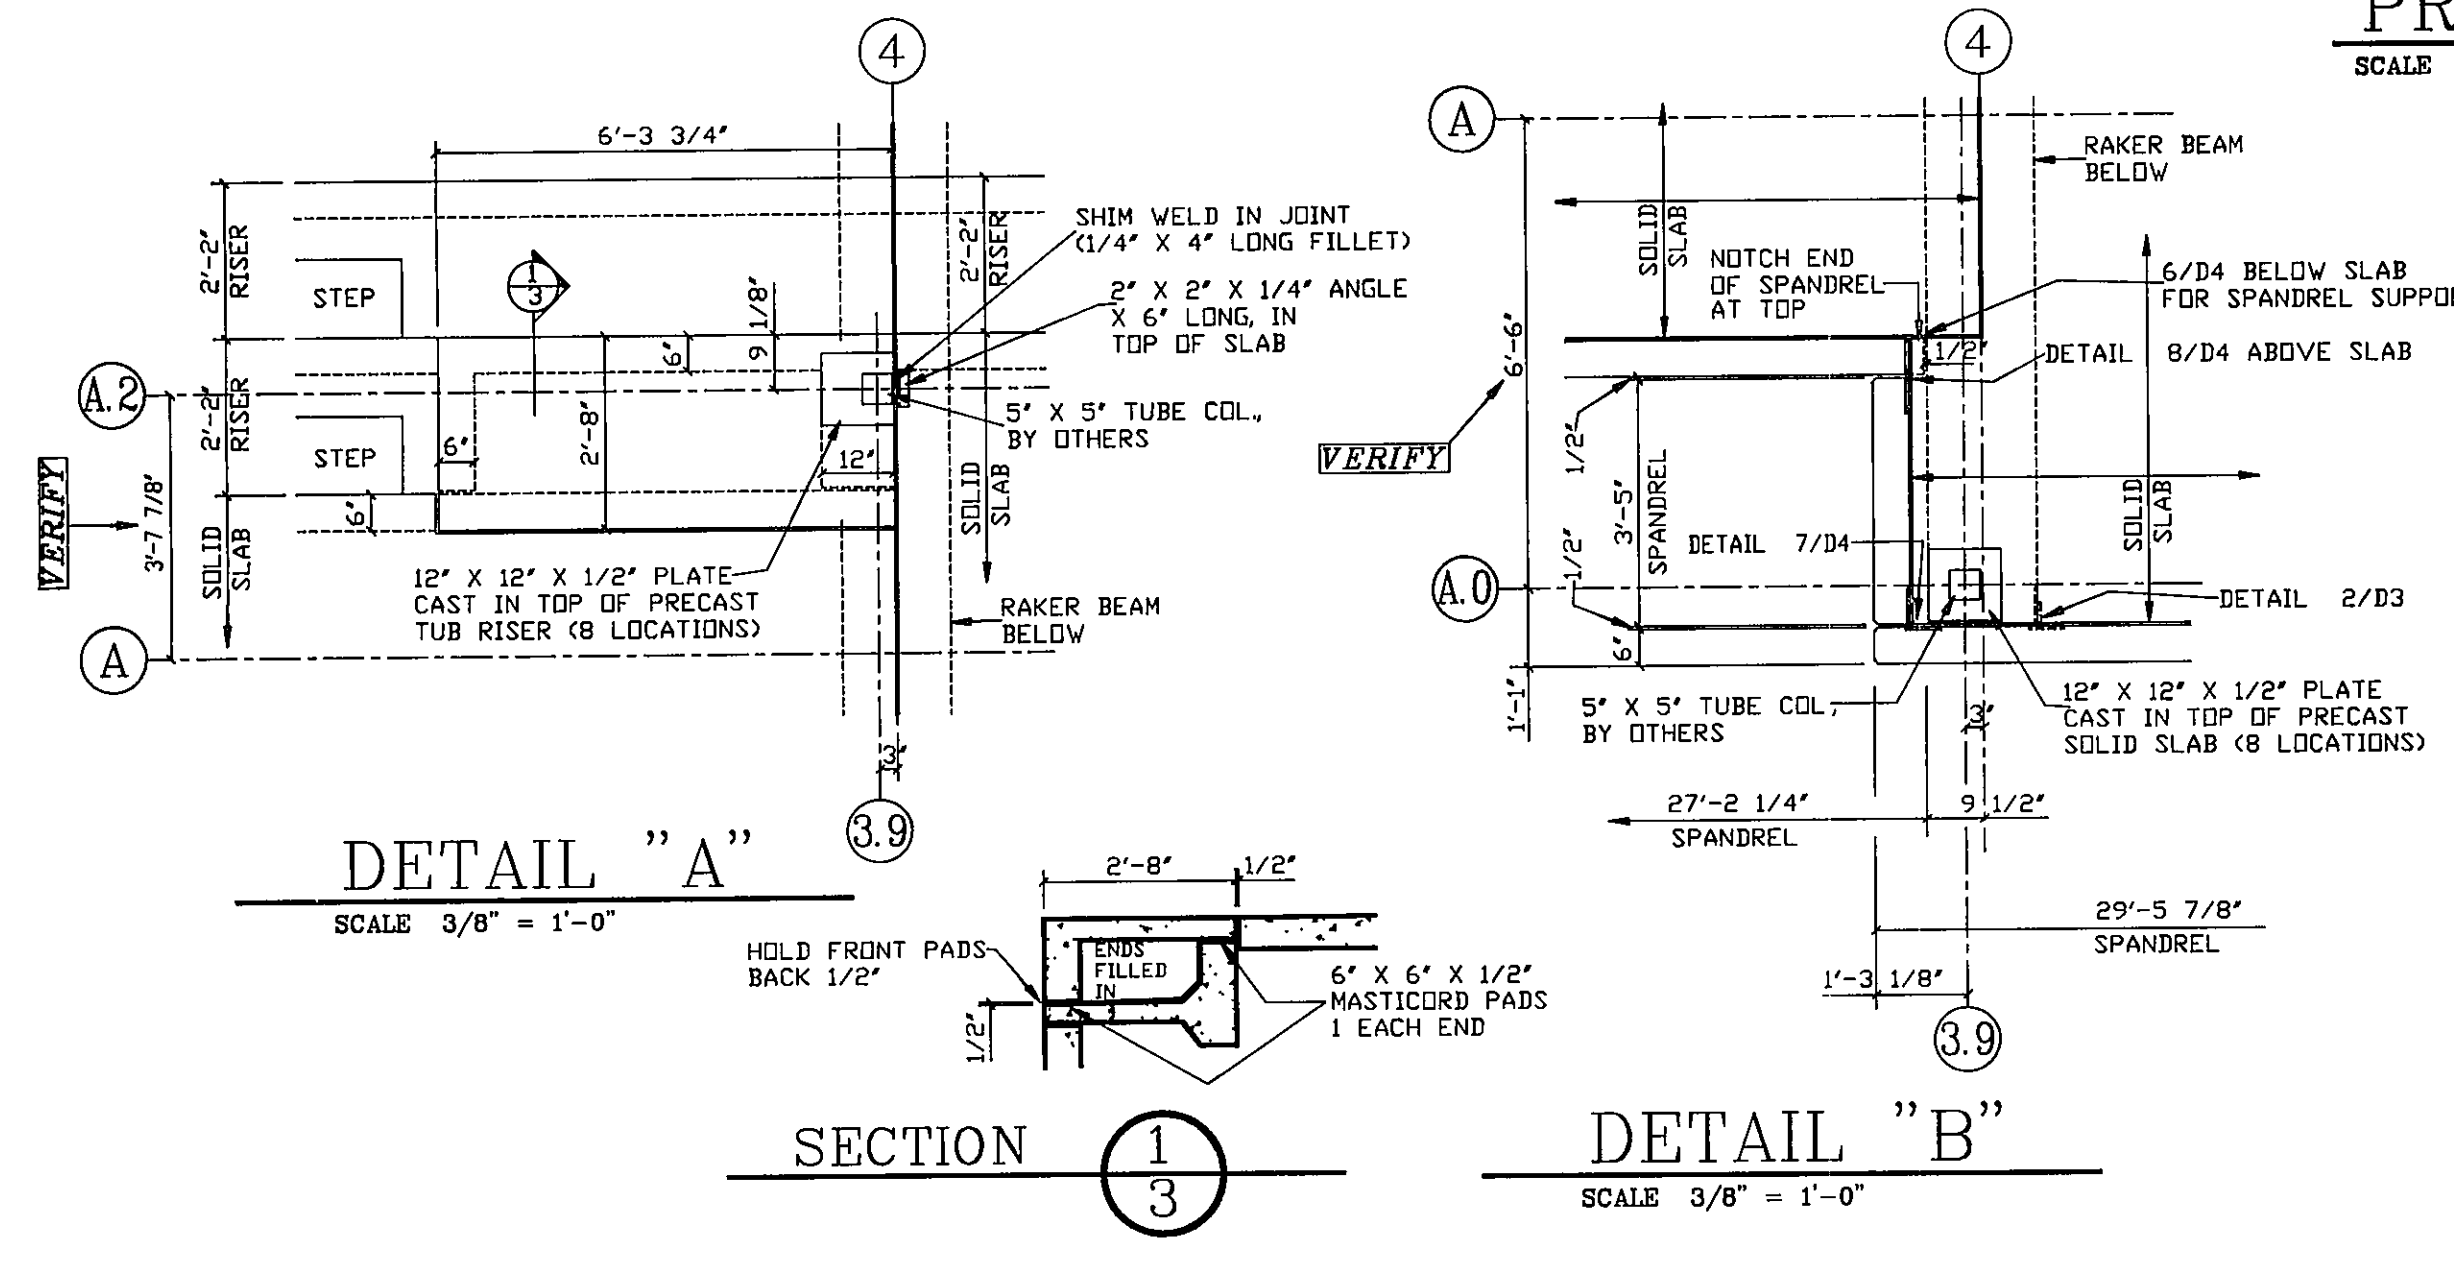

PRECAST RISER & SLAB LAYOUT
SCALE 1/8" = 1'-0"

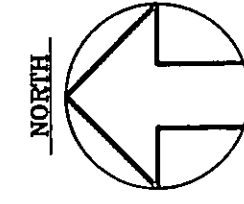

PROJECT: Chesterton High School
CONST. MANAGER: Construction Control
ARCHITECT: Fanning/Howey Assoc., Inc.
GENERAL CONTR: Gough, Inc. Job # 435
SUBMITTED BY: Gough
SECTION # 3400 SUBMITTAL # 1
Reviewed by Gough, Inc. to be in compliance with contract documents. This does not release the supplier from responsibility for quantities, dimensions, performance or other requirements of the existing elements.
SIGNATURE: *[Signature]* DATE: 2-

PROJECT FOR
AMERICAN PRECAST CONCRETE
PREPARED BY
PRECAST CONCRETE SYSTEMS, INC.
1030 S. KITLEY AVE.
INDIANAPOLIS, INDIANA 46203

REVISIONS		REVISIONS		REVISIONS		REVISIONS	
NO.	DATE	NO.	DATE	NO.	DATE	NO.	DATE

ARCHITECT
FANNING-HOWEY ASSOC., INC.

CONTRACTOR
GOUGH INC.

DRAWN BY
MDC

CHECK BY
2-3-98

CHESTERTON HIGH SCHOOL
STADIUM
CHESTERTON, IN

JOB NO.
1278-10

SHEET
3

OF SHEETS
3