
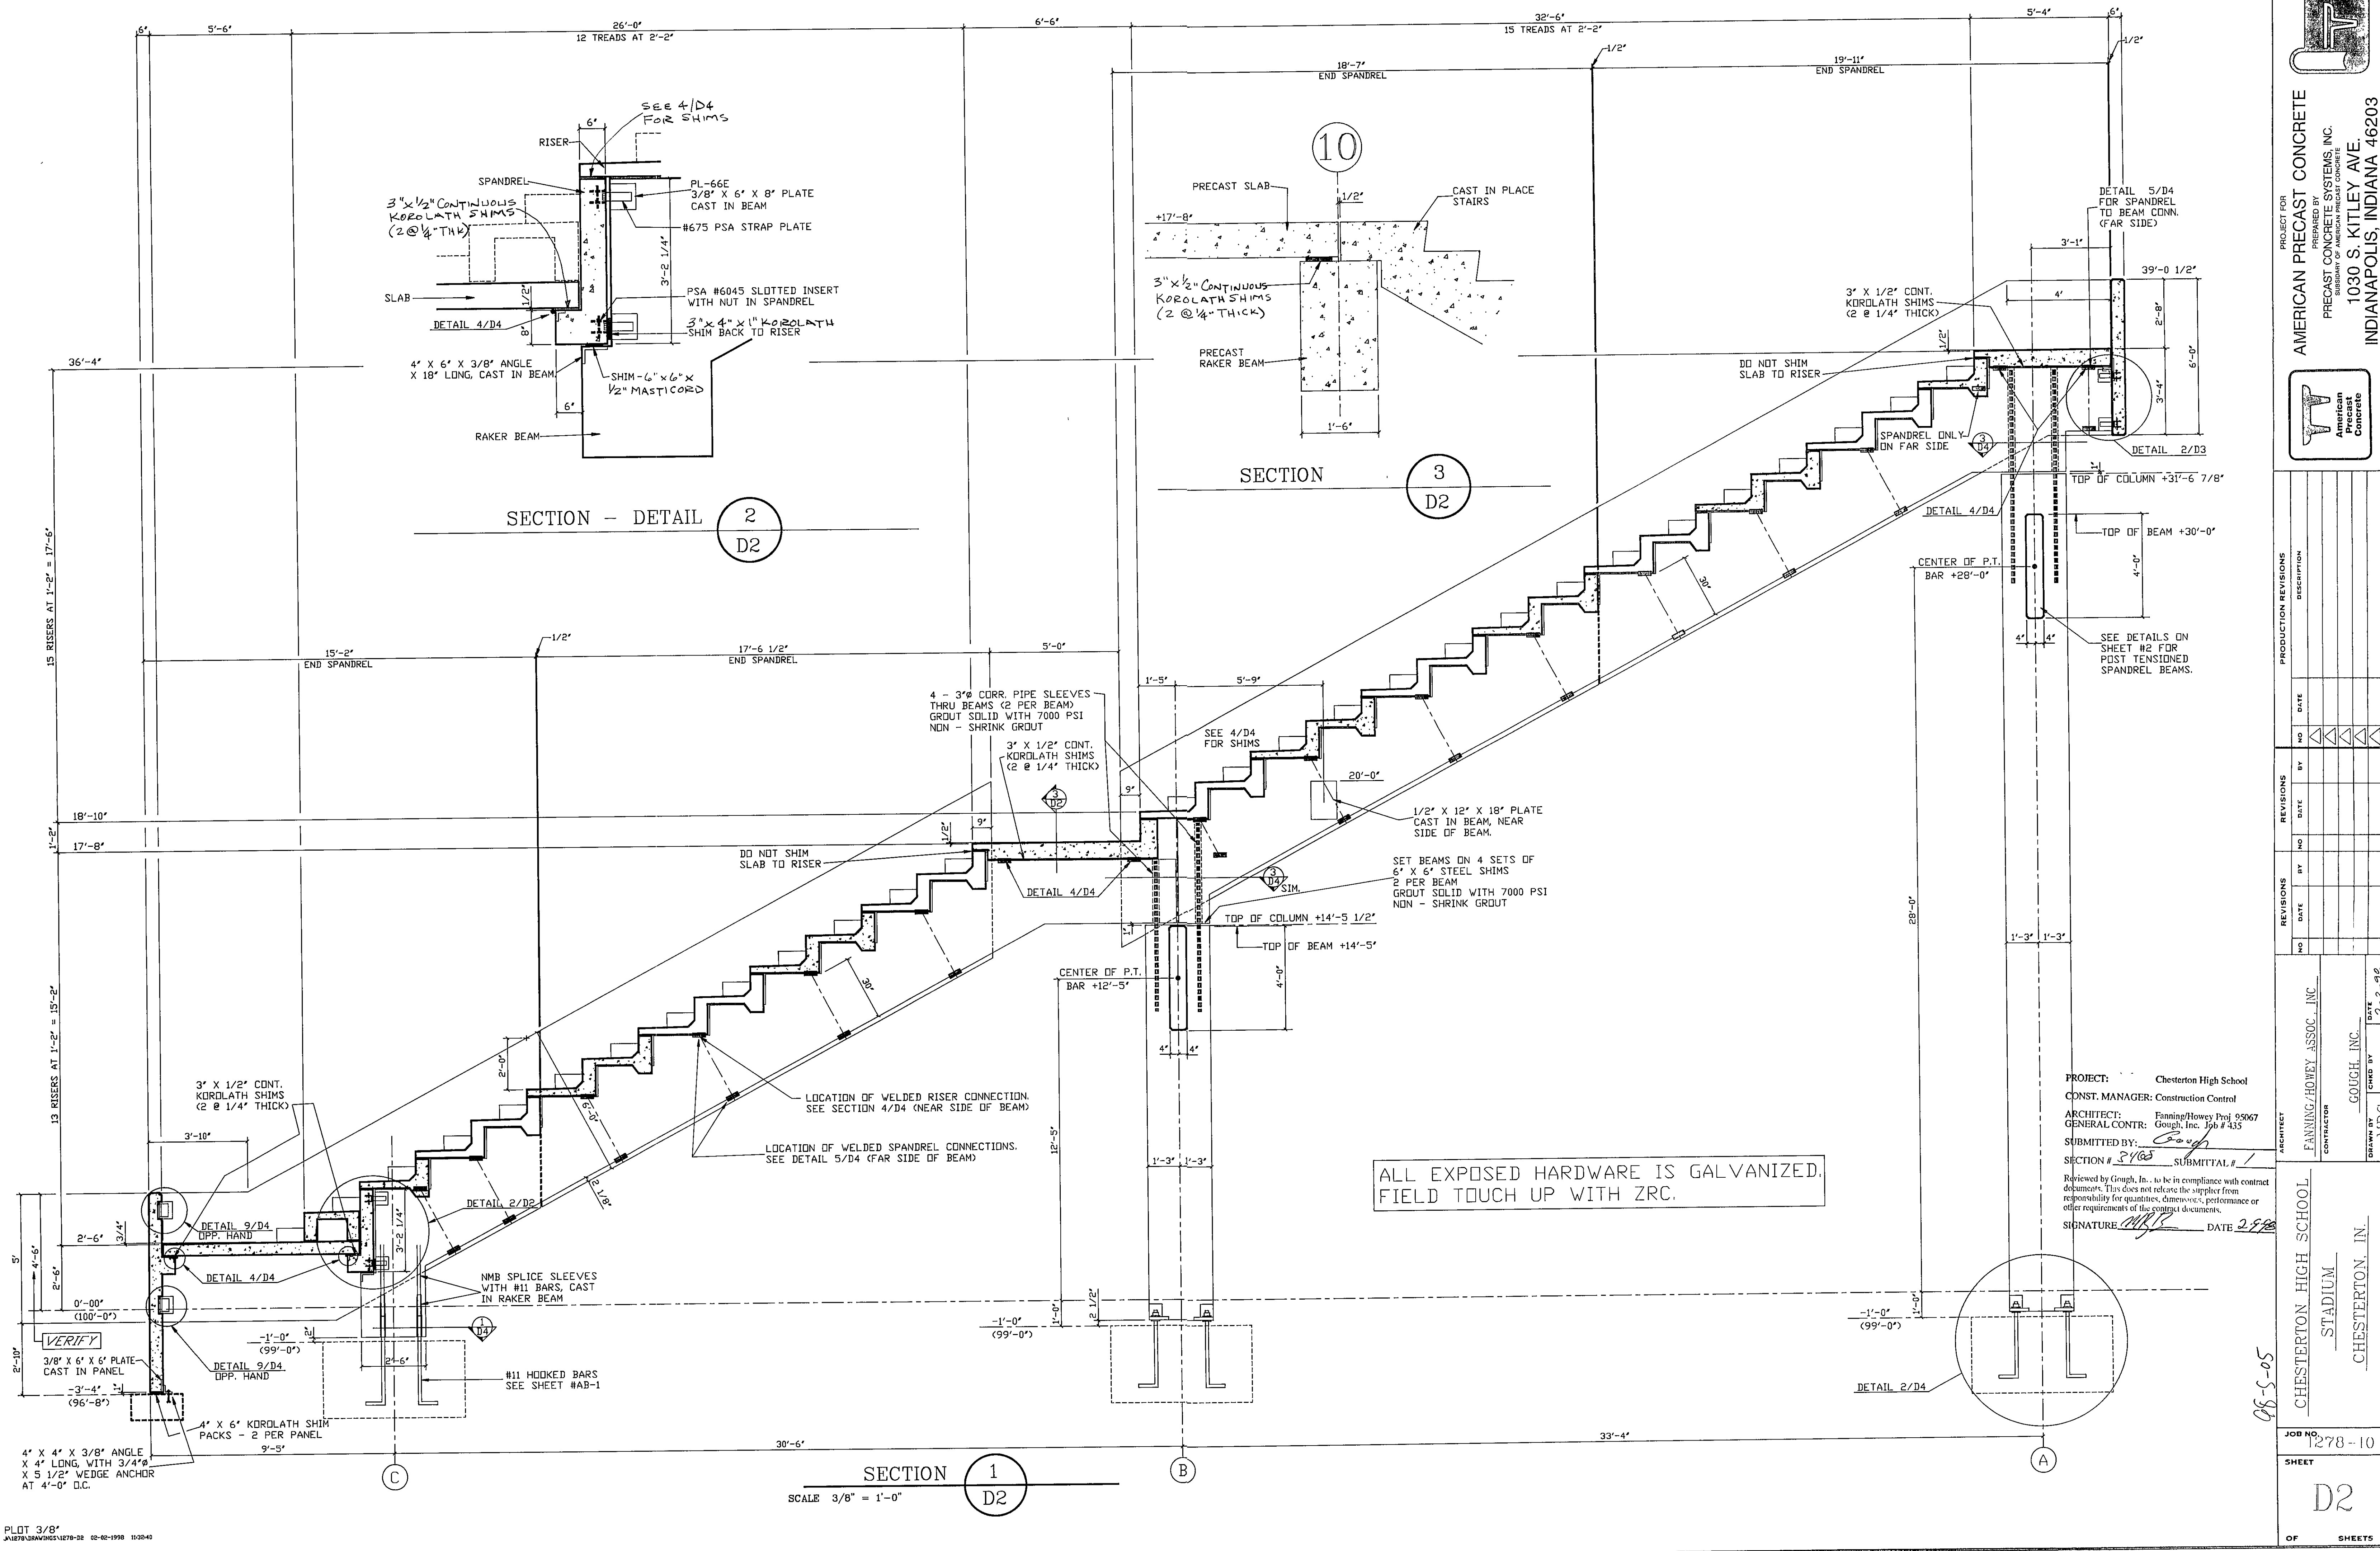


PROJECT FOR
AMERICAN PRECAST CONCRETE
PREPARED BY
PRECAST CONCRETE SYSTEMS, INC.
SUBSIDIARY OF AMERICAN PRECAST CONCRETE
1030 S. KITLEY AVE.
INDIANAPOLIS, INDIANA 46203

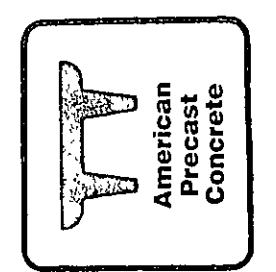

REVISIONS	NO.	DATE	DESCRIPTION


ARCHITECT	FANNING/HOWEY ASSOC., INC.
CONTRACTOR	GOUGH, INC.
DRAWN BY	MDC
CHECKED BY	

CHESTERTON HIGH SCHOOL
STADIUM
CHESTERTON, IN.

JOB NO. 1278-10
SHEET D2
OF SHEETS

PROJECT: Chesterton High School
CONST. MANAGER: Construction Control
ARCHITECT: Fanning/Howey Proj 95067
GENERAL CONTR: Gough, Inc. Job # 435
SUBMITTED BY: [Signature]
SECTION # 2405 SUBMITTAL # 1
Reviewed by Gough, Inc. to be in compliance with contract documents. This does not release the supplier from responsibility for quantities, dimensions, performance or other requirements of the contract documents.

ALL EXPOSED HARDWARE IS GALVANIZED,
FIELD TOUCH UP WITH ZRC.

SECTION 1
D2
SCALE 3/8" = 1'-0"

SECTION 3
D2

SECTION - DETAIL 2
D2