


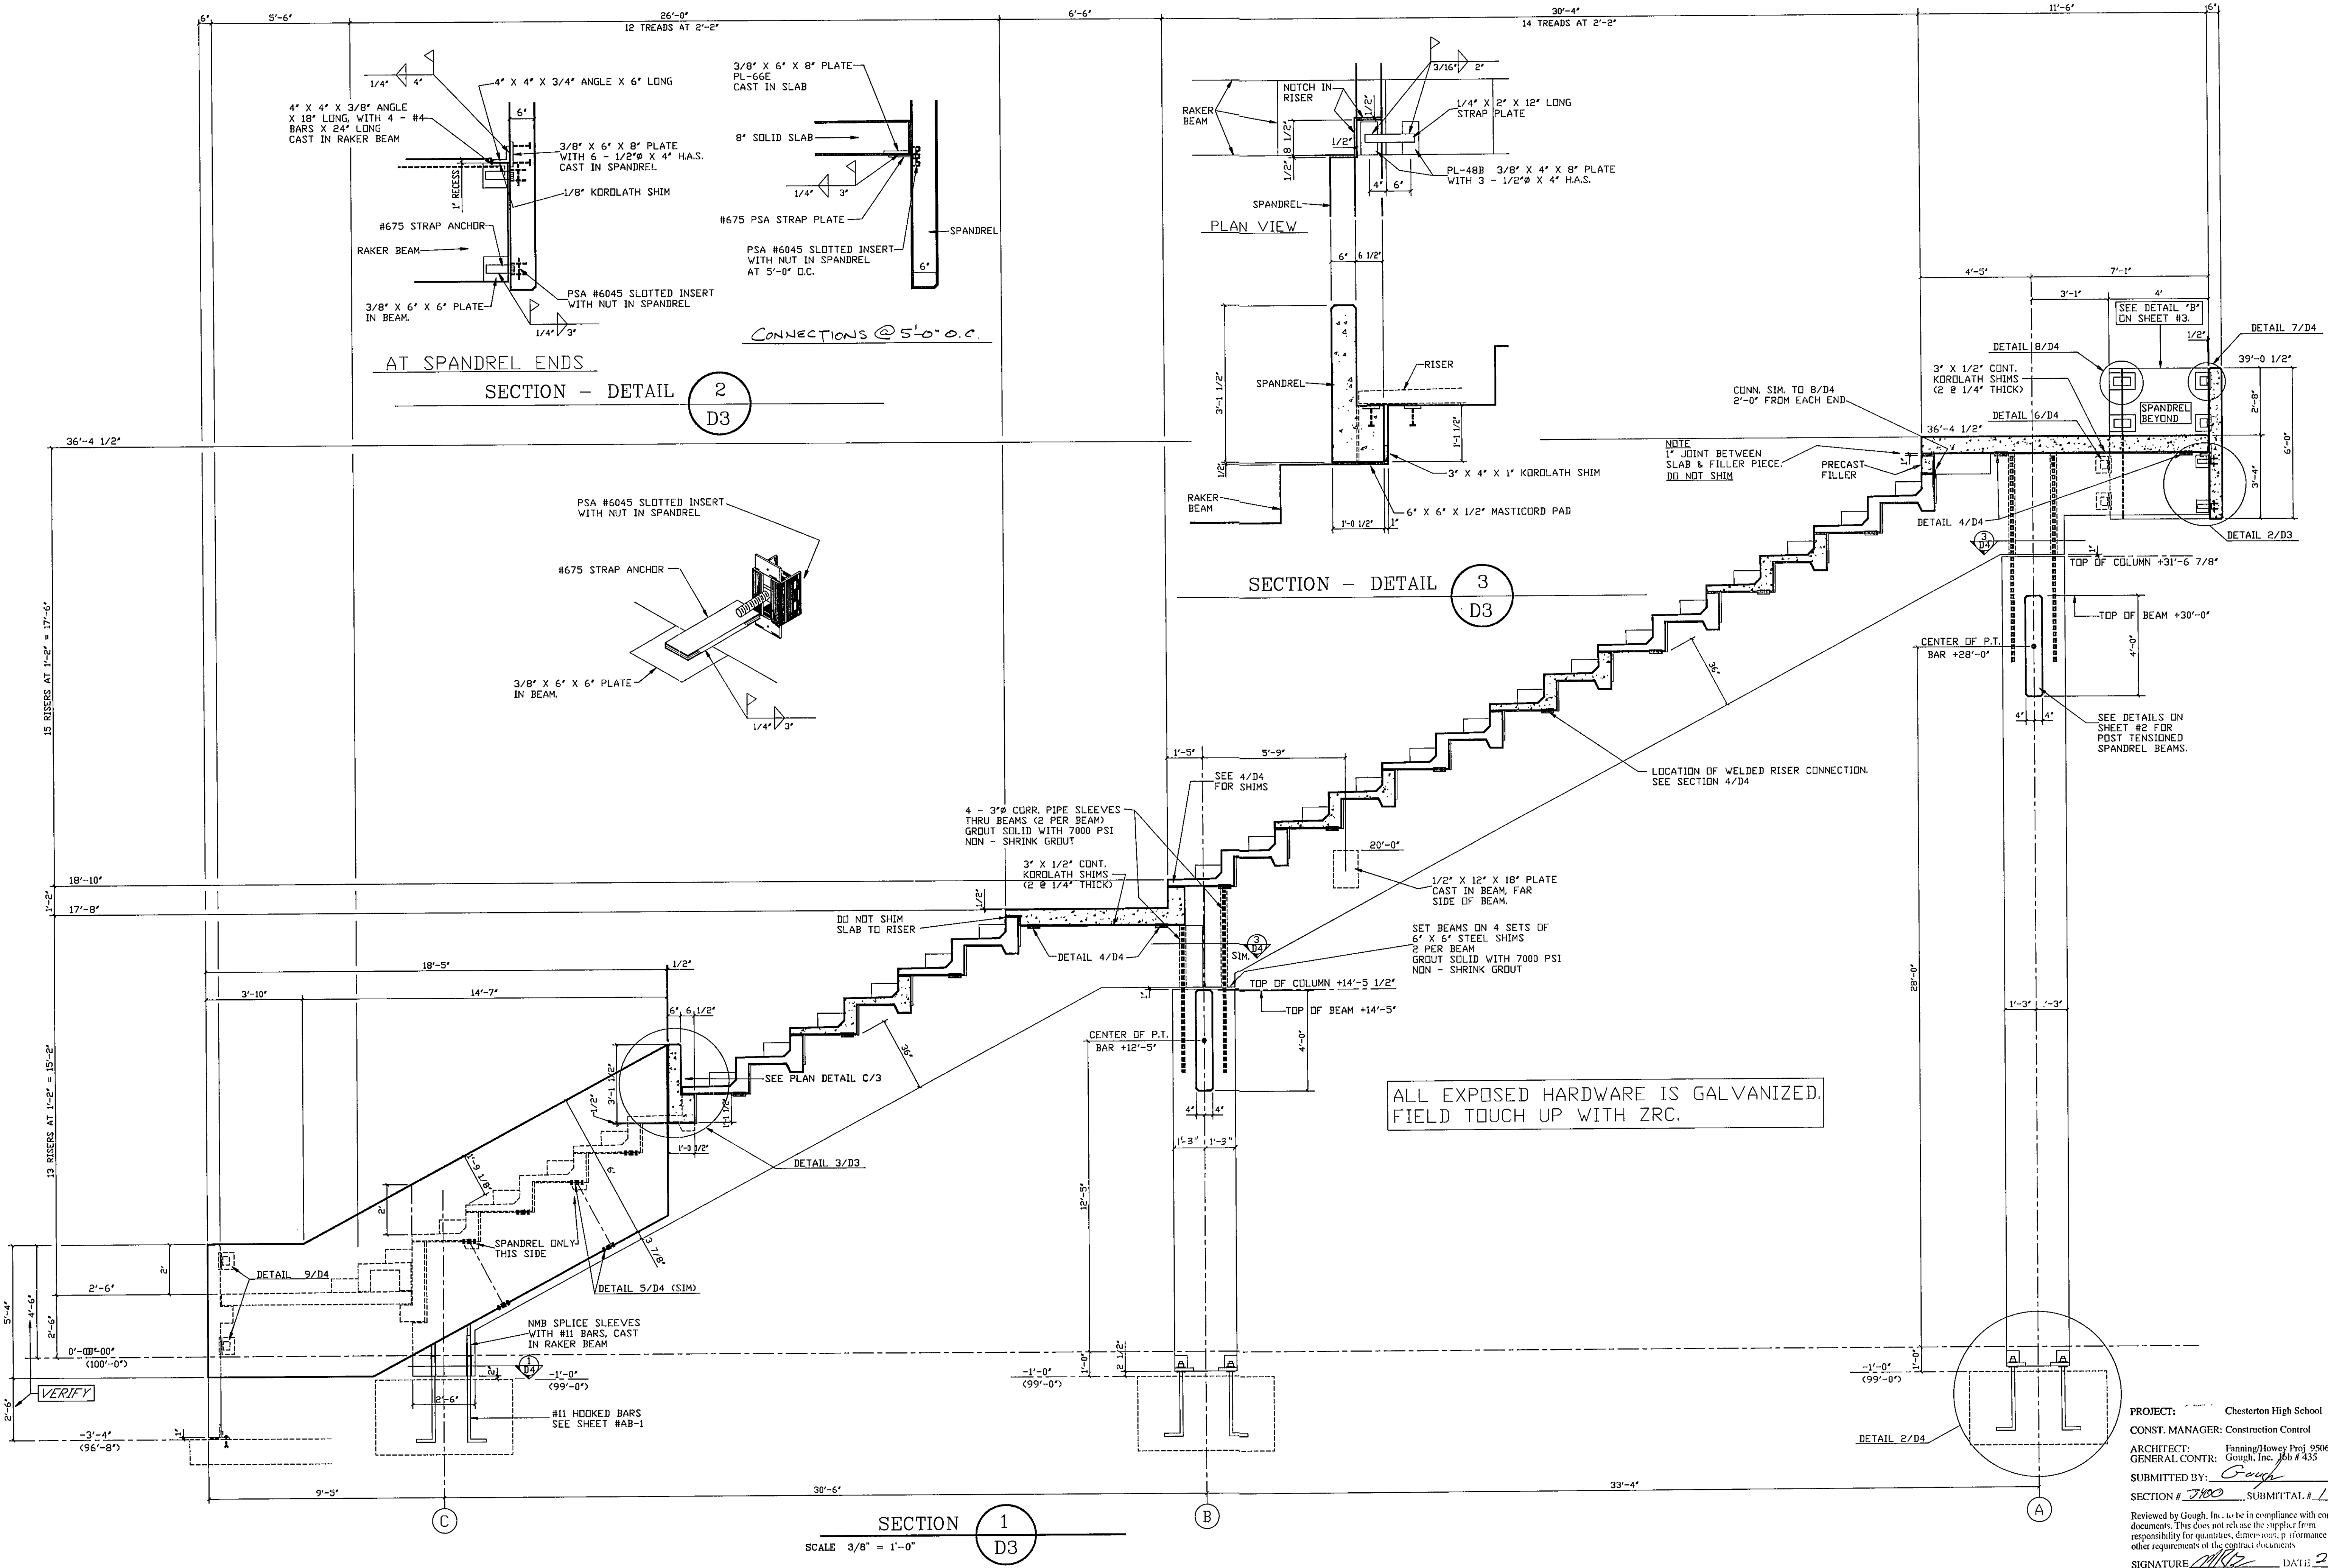

ALL EXPOSED HARDWARE IS GALVANIZED.
FIELD TOUCH UP WITH ZRC.

PROJECT: Chesterton High School
CONST. MANAGER: Construction Control
ARCHITECT: Fanning/Howey Proj 95067
GENERAL CONTR: Gough, Inc. Job # 435
SUBMITTED BY: Gough
Reviewed by Gough, Inc. to be in compliance with contract documents. This does not release the supplier from responsibility for quantities, dimensions, performance or other requirements of the contract documents.
SIGNATURE: [Signature] DATE: 2-5-98

PROJECT FOR
AMERICAN PRECAST CONCRETE
PREPARED BY
PRECAST CONCRETE SYSTEMS, INC.
SUBSIDIARY OF AMERICAN PRECAST CONCRETE
1030 S. KITLEY AVE.
INDIANAPOLIS, INDIANA 46203

American Precast Concrete

PRODUCTION REVISIONS	
NO.	DESCRIPTION

REVISIONS	
NO.	DATE

ARCHITECT: FANNING-HOWEY ASSOC., INC.
CONTRACTOR: GOUGH, INC.
DRAWN BY: MDC
CHKD BY: [Signature]
DATE: 2-5-98

CHESTERTON HIGH SCHOOL
STADIUM
CHESTERTON, IN

JOB NO. 278-10
SHEET D3
OF SHEETS