

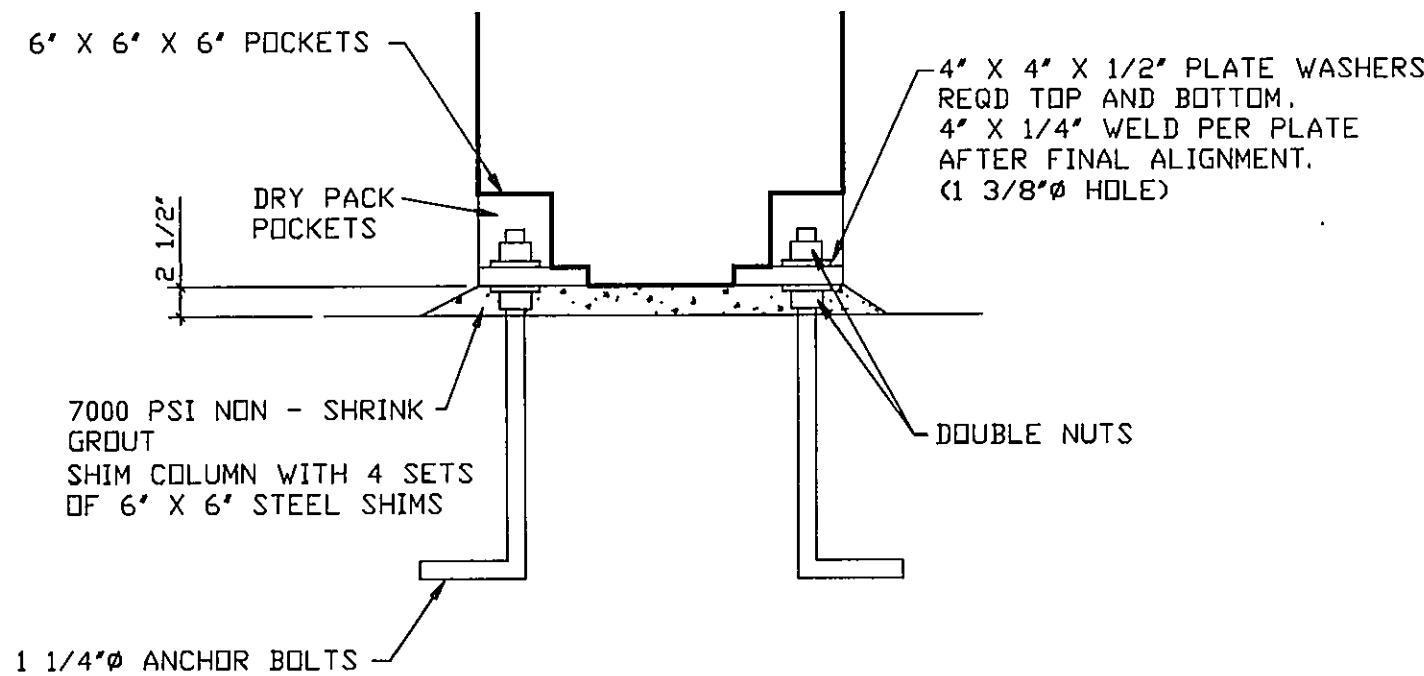
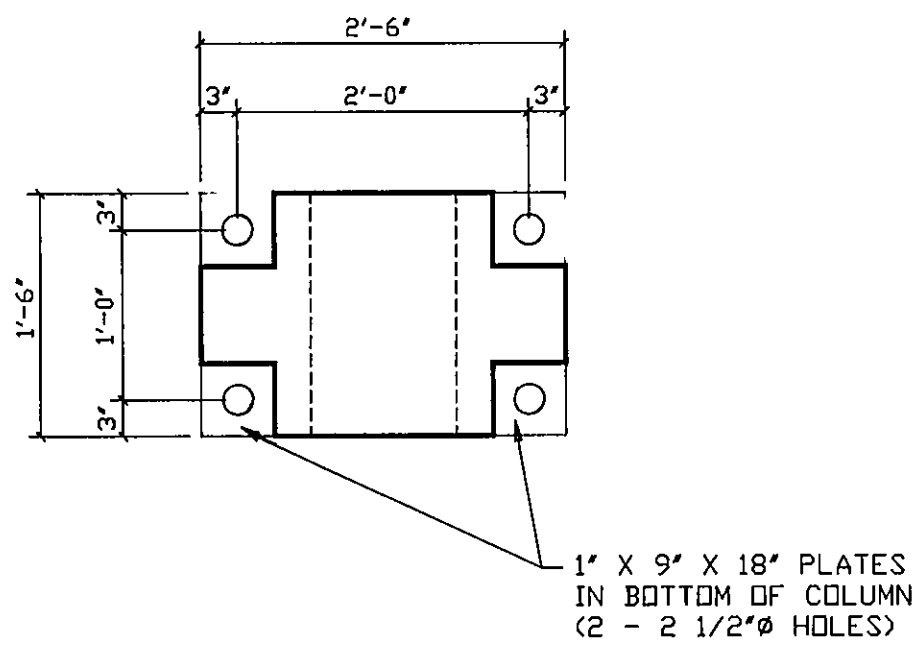



SET BEAM ON 4 SETS OF
6" X 6" STEEL SHIMS
GROUT SOLID WITH 7000 PSI
NDN - SHRINK GROUT (2" JOINT)

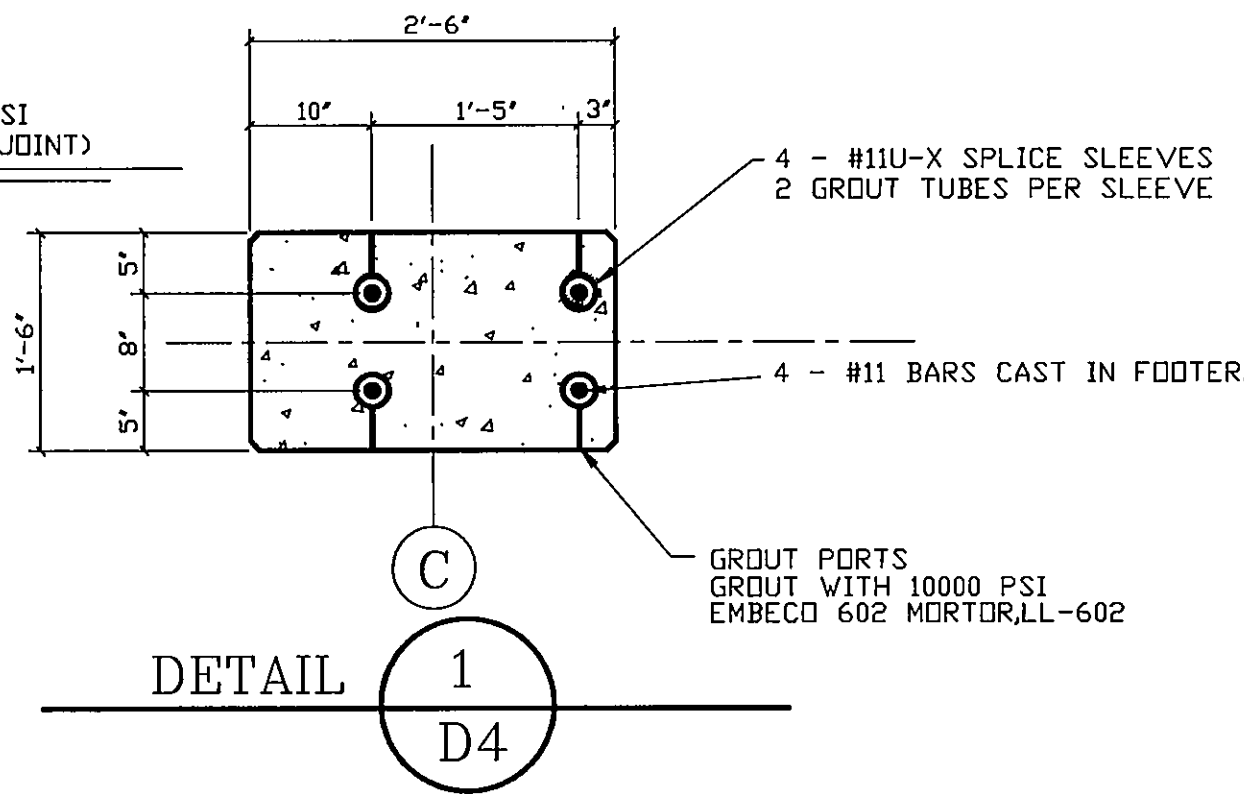

DETAIL 2
D4

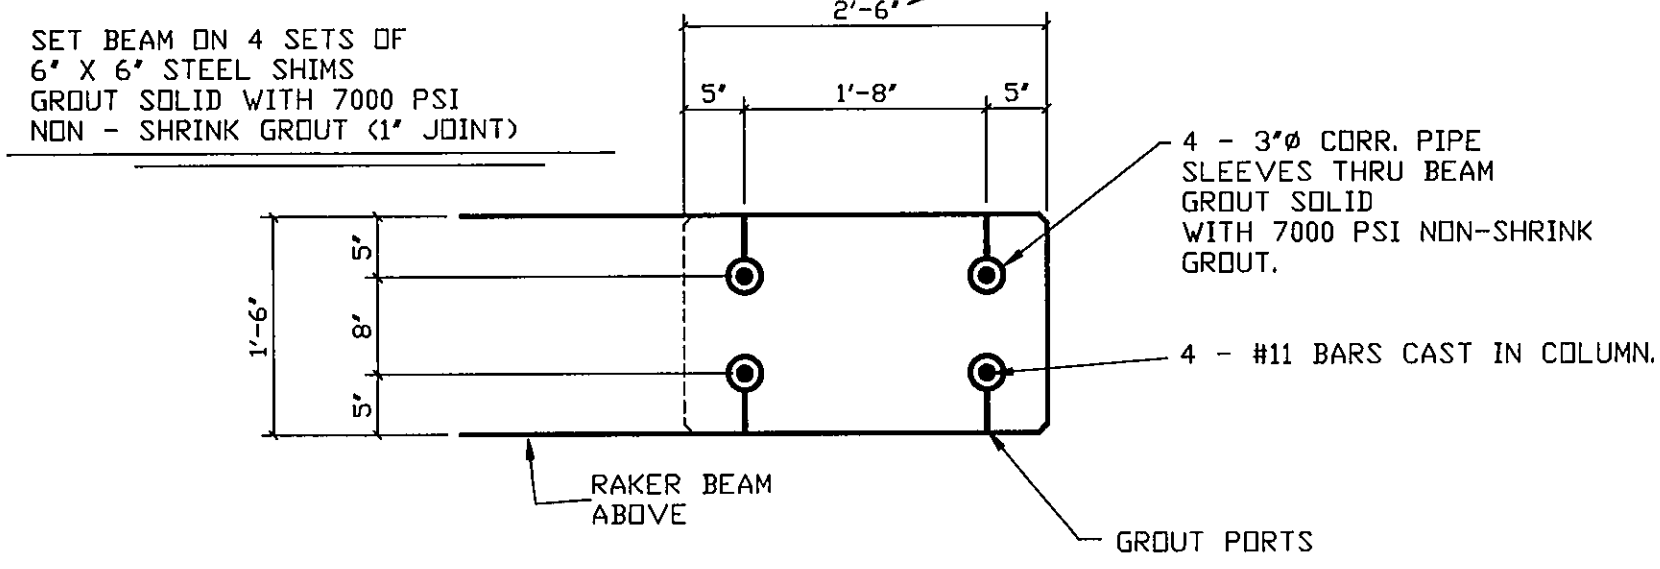


DETAIL 3
D4

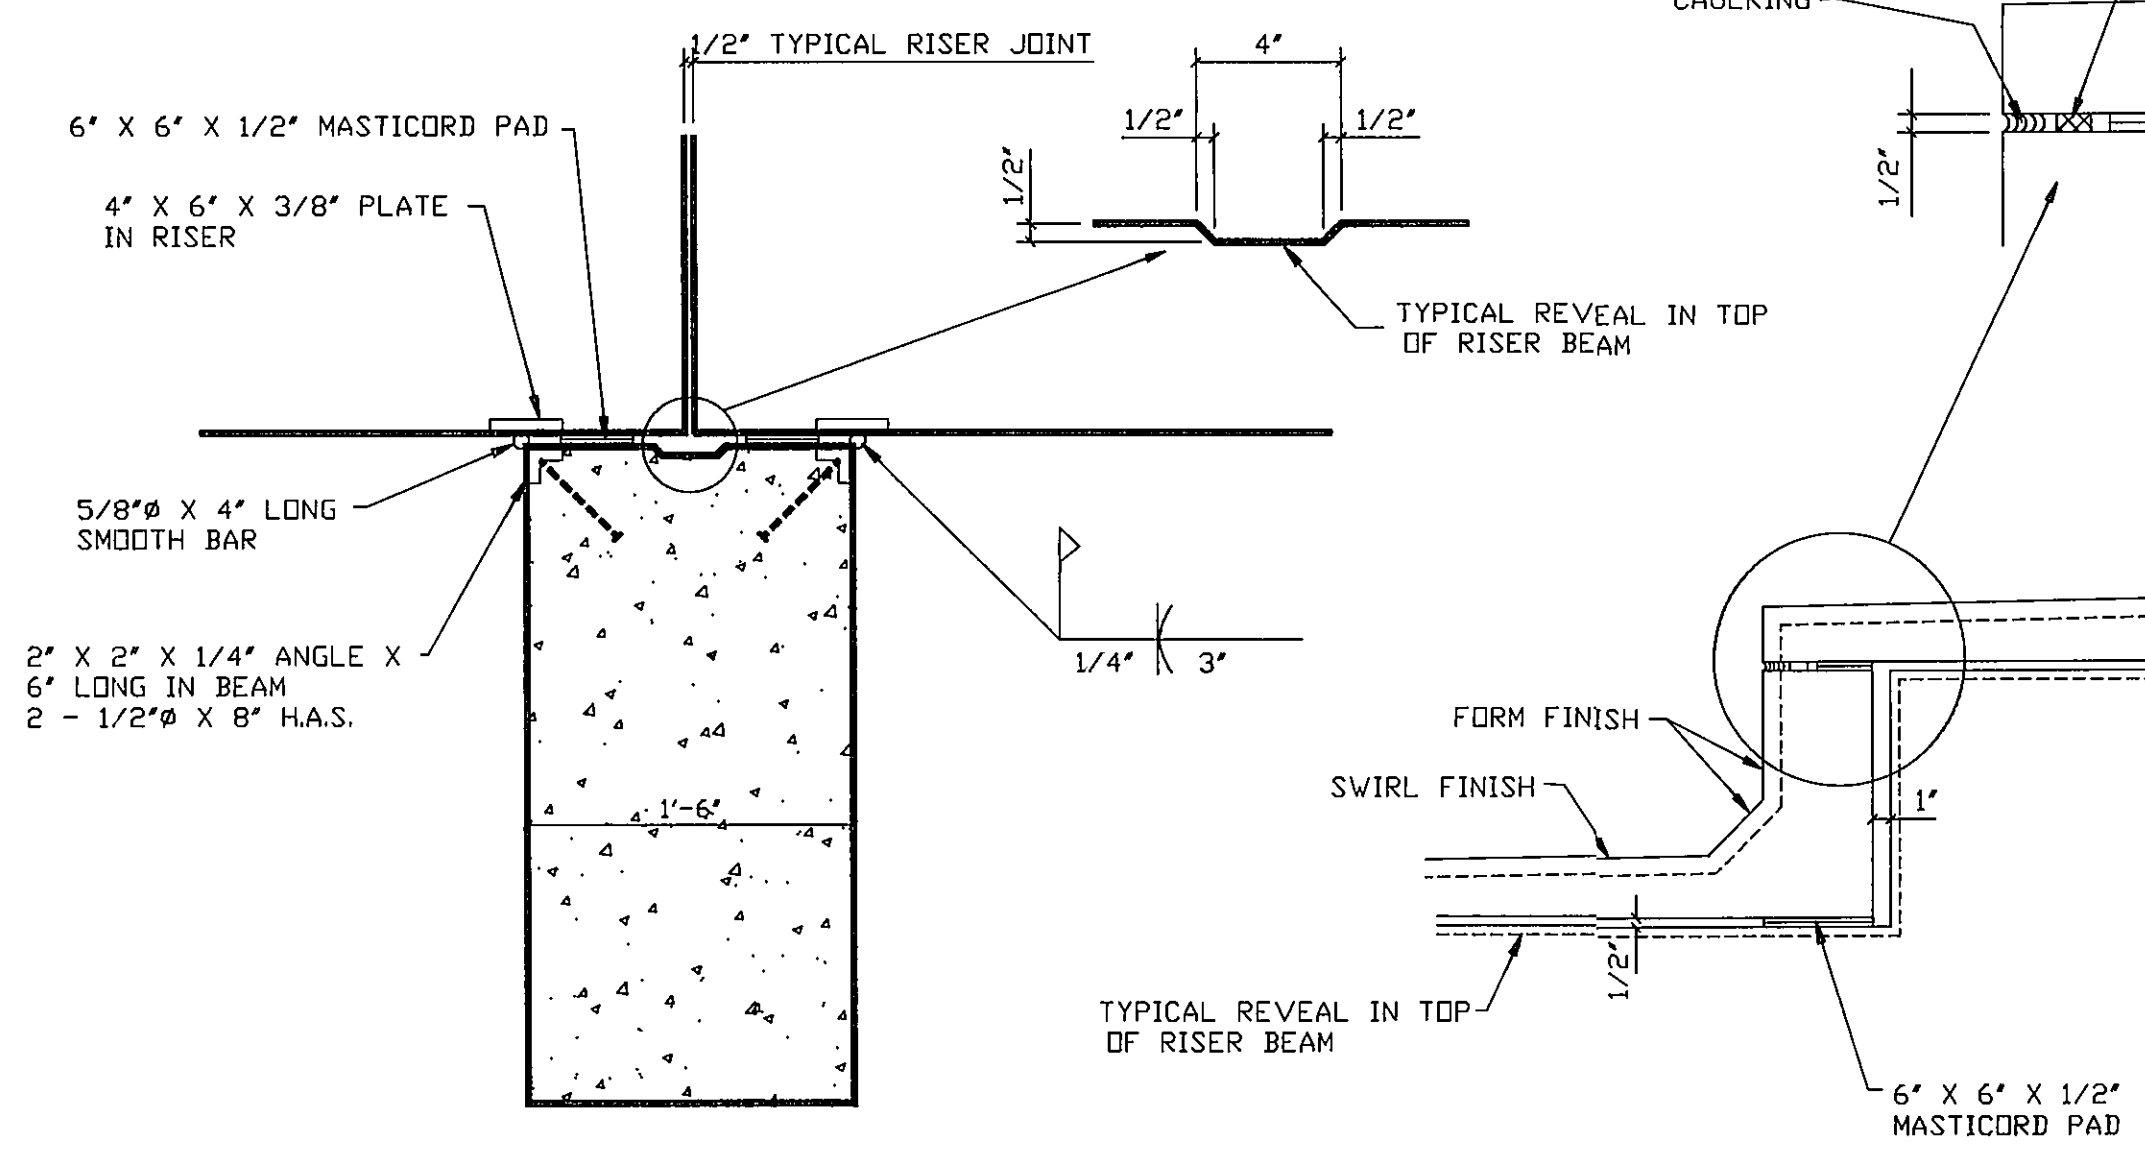


SECTION - DETAIL 4
D4


ALL EXPOSED HARDWARE IS GALVANIZED.
FIELD TOUCH UP WITH ZRC.

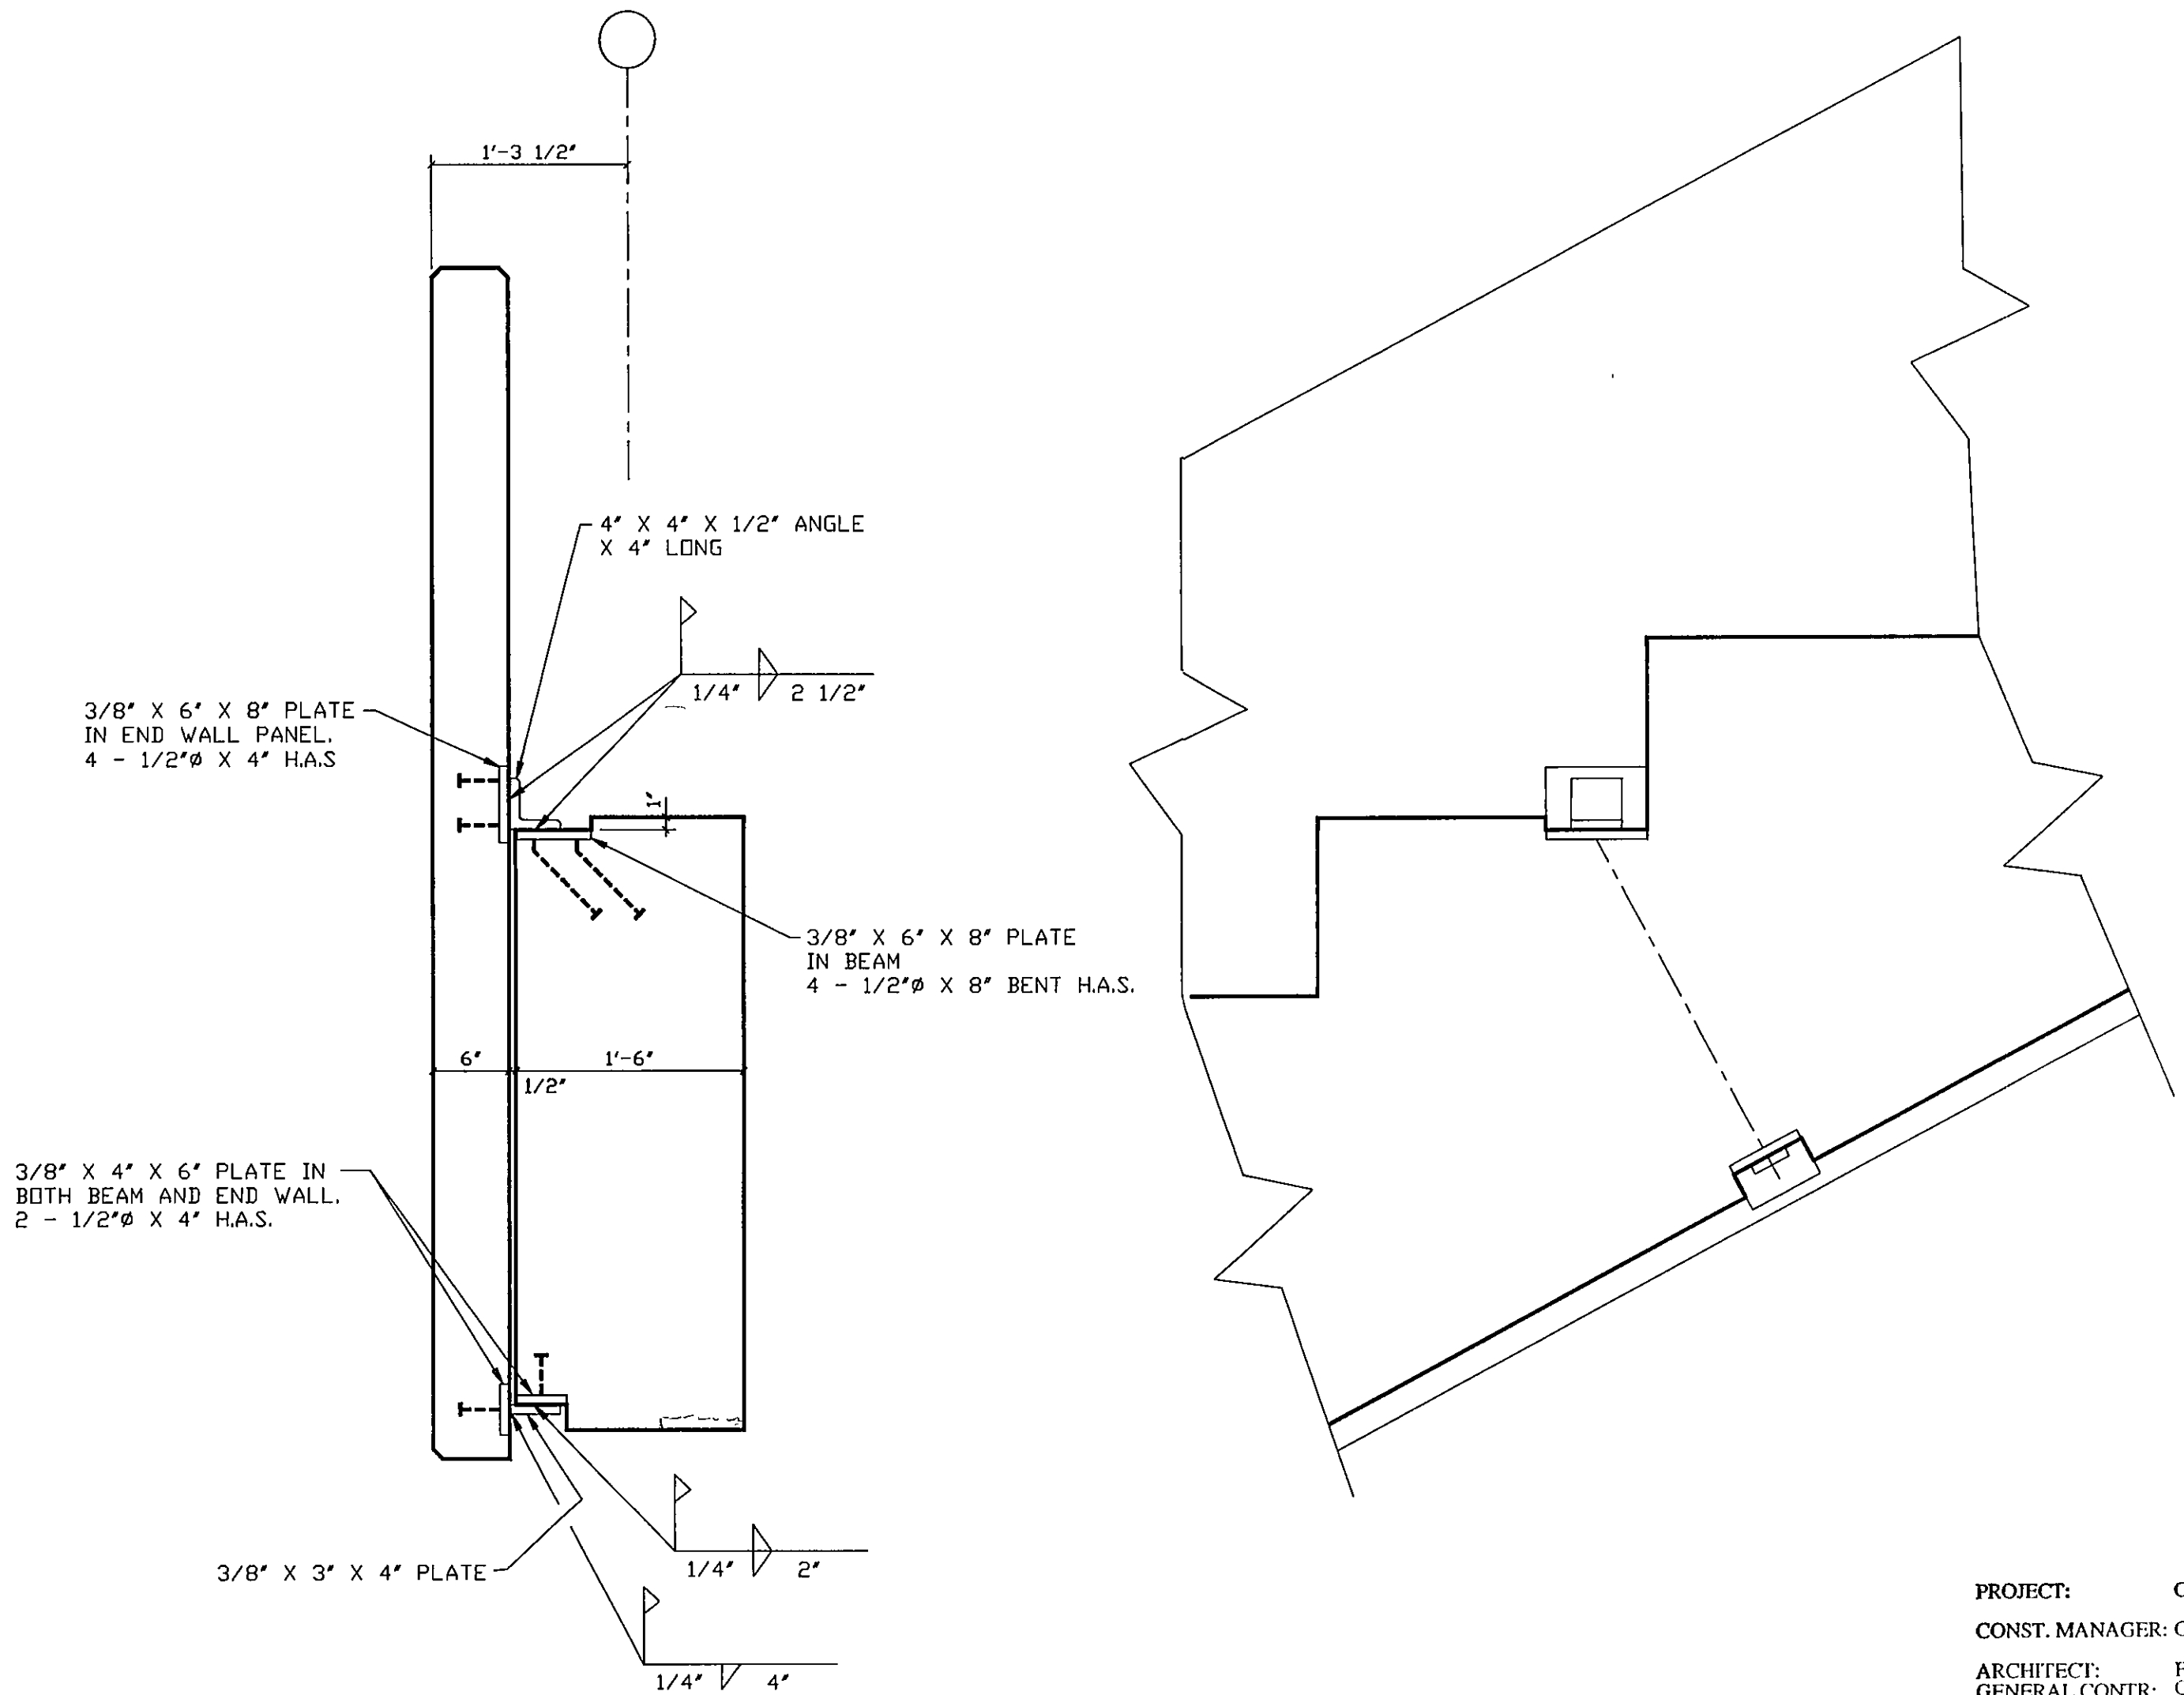


SECTION - DETAIL 5
D4

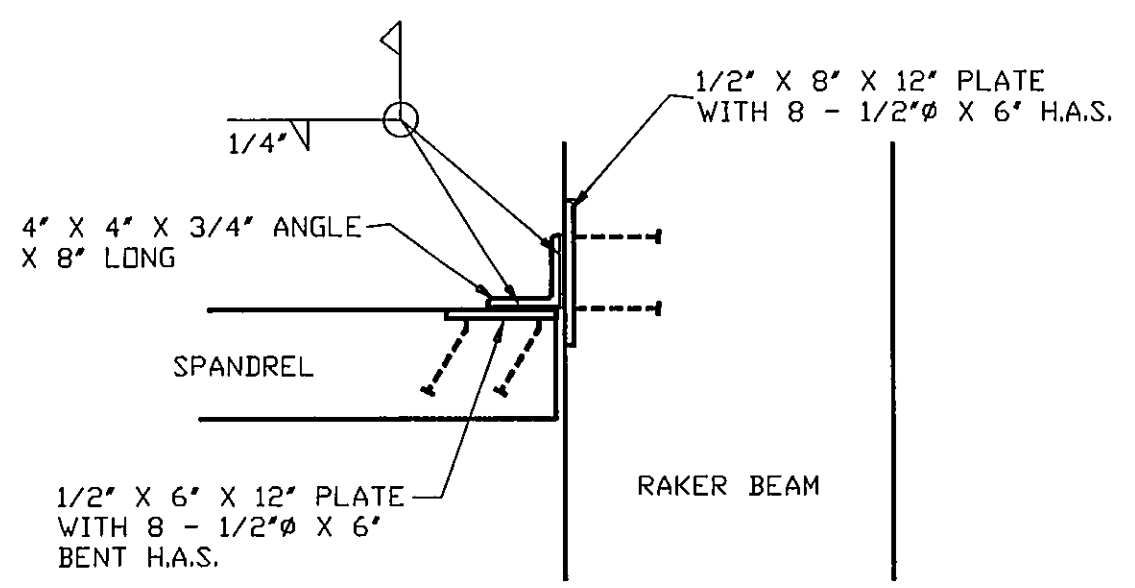


DETAIL 6
D4

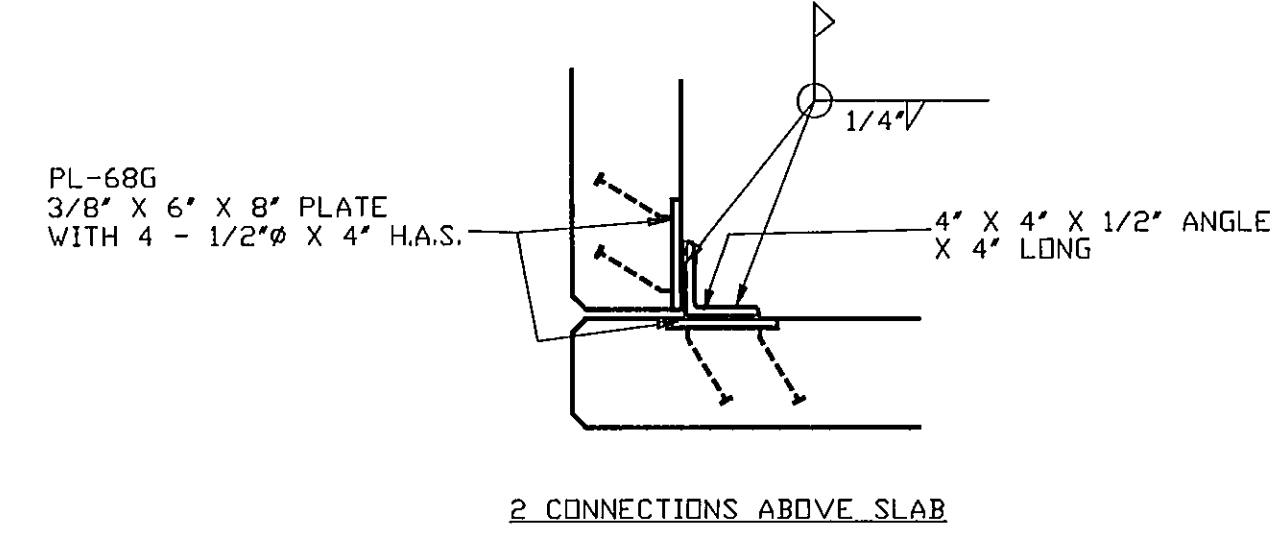

DETAIL 7
D4

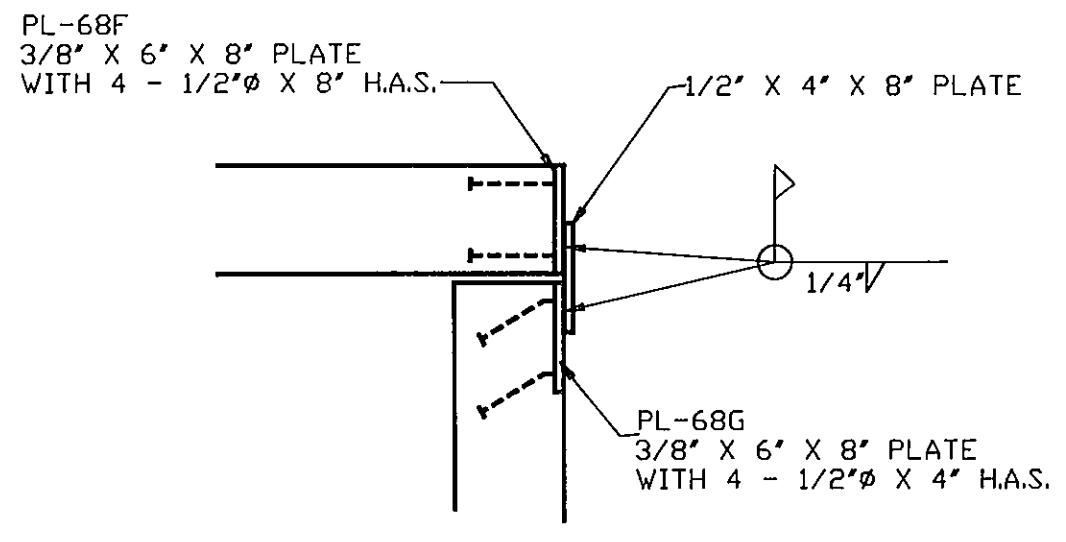

DETAIL 8
D4

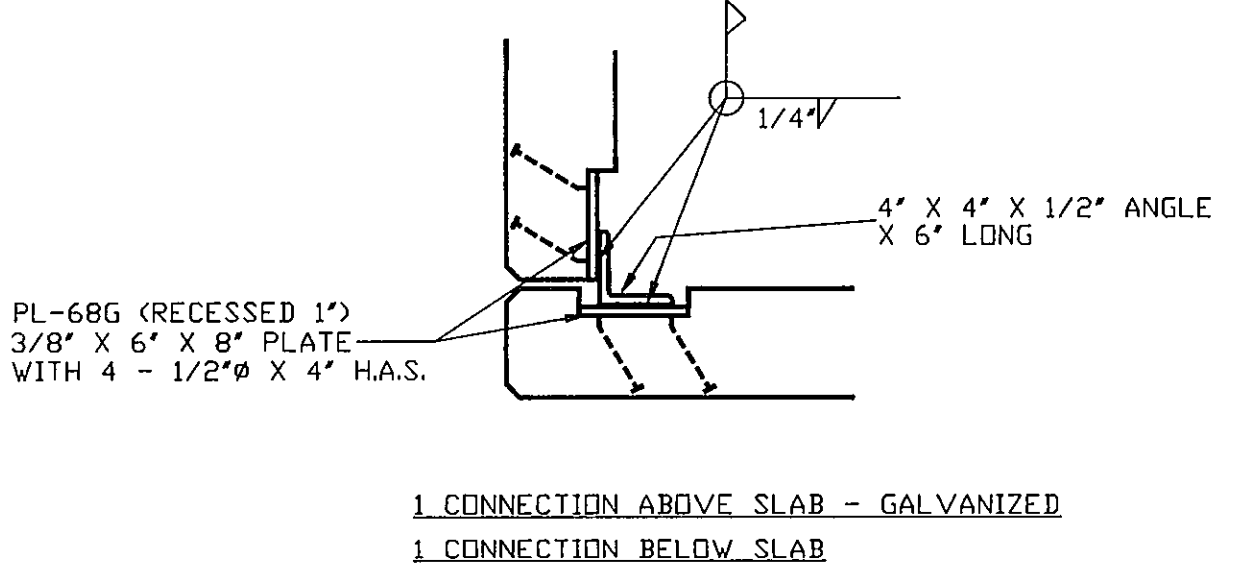

DETAIL 9
D4

PROJECT: Chesterton High School
CONST. MANAGER: Construction Control
ARCHITECT: Fanning/Howey Proj. 55067
GENERAL CONTR: Gough, Inc. Job # 435
SUBMITTED BY: *Gough*
SECTION # 3108 SUBMITTAL # 1
Reviewed by Gough, Inc. to be in compliance with contract documents. This does not release the supplier from responsibility for quantities, dimensions, performance or other requirements of the contract documents.
SIGNATURE: *MDC* DATE: 2-9-98

PROJECT FOR
AMERICAN PRECAST CONCRETE
PREPARED BY
PRECAST CONCRETE SYSTEMS, INC.
A DIVISION OF
AMERICAN PRECAST CONCRETE
1030 S. KITLEY AVE.
INDIANAPOLIS, INDIANA 46203

PRODUCTION REVISIONS	
NO.	DESCRIPTION

REVISIONS	
NO.	DATE

ARCHITECT	CONTRACTOR	DRAWN BY	CHECK BY	DATE
FANNING/HOWEY ASSOC. INC.	GOUGH, INC.	MDC		2-3-98

CHESTERTON HIGH SCHOOL
STADIUM
CHESTERTON, IN.

JOB NO.
1278-10

SHEET
D4

OF SHEETS
3