

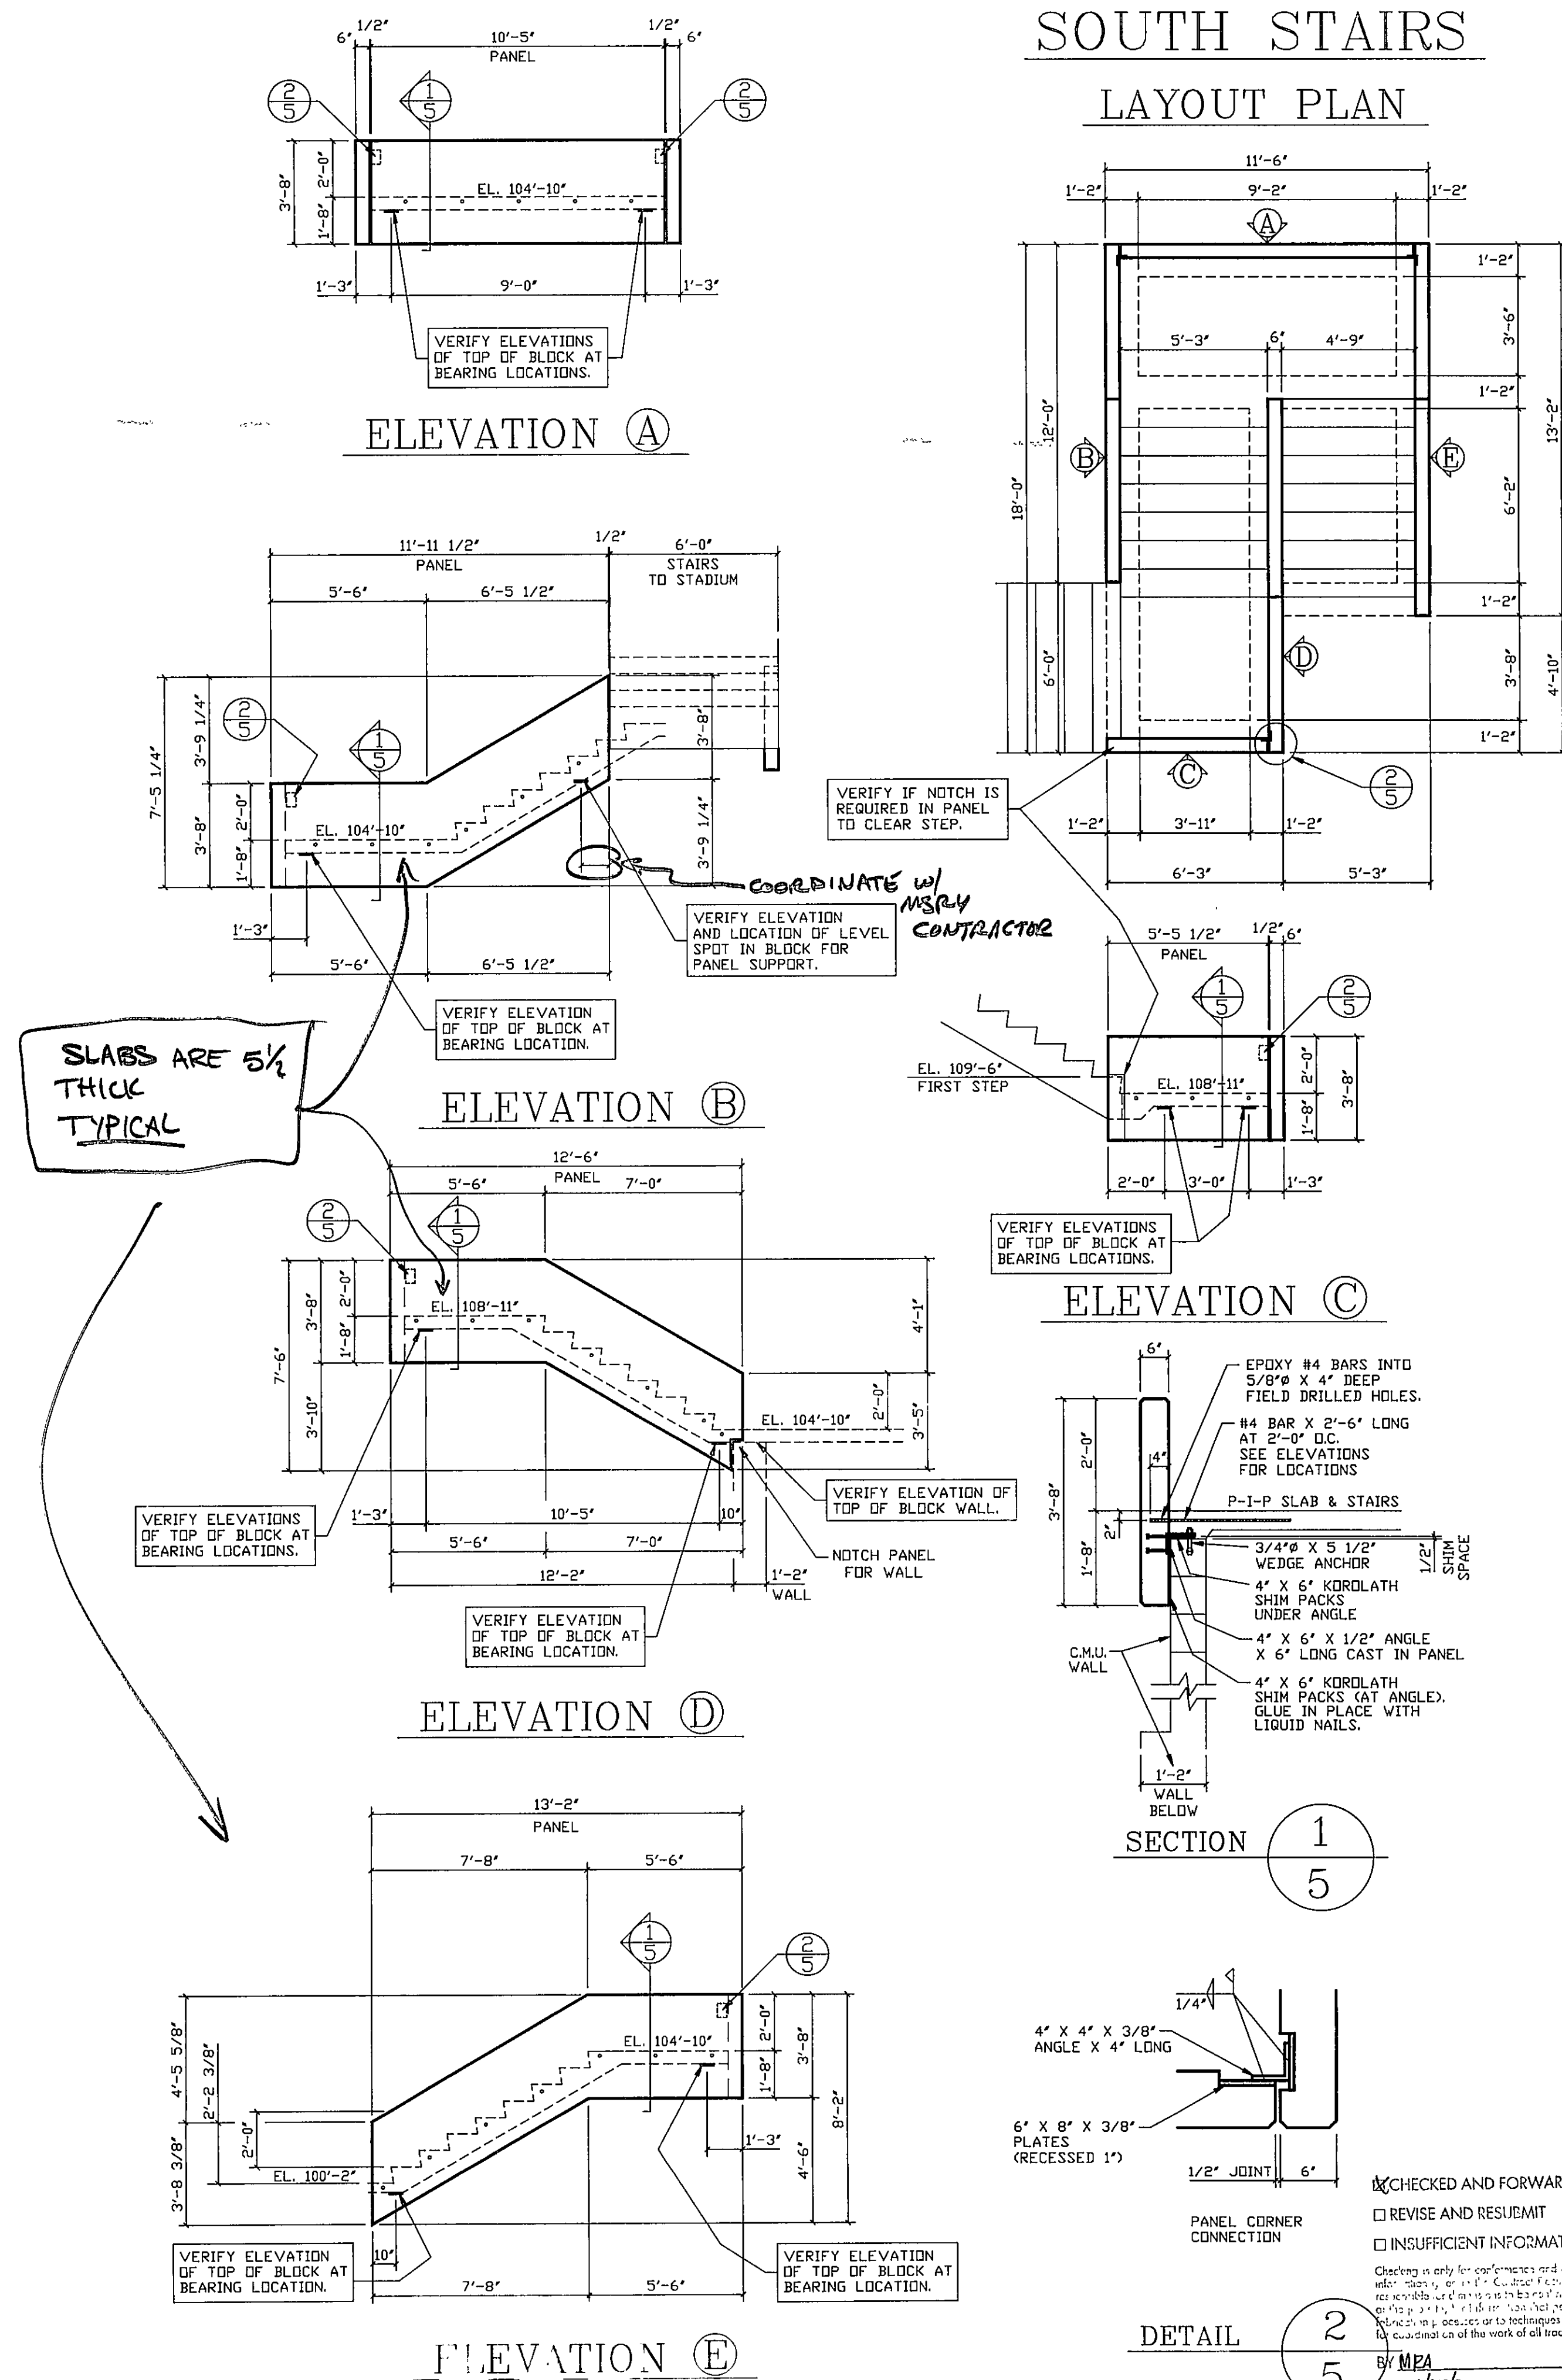


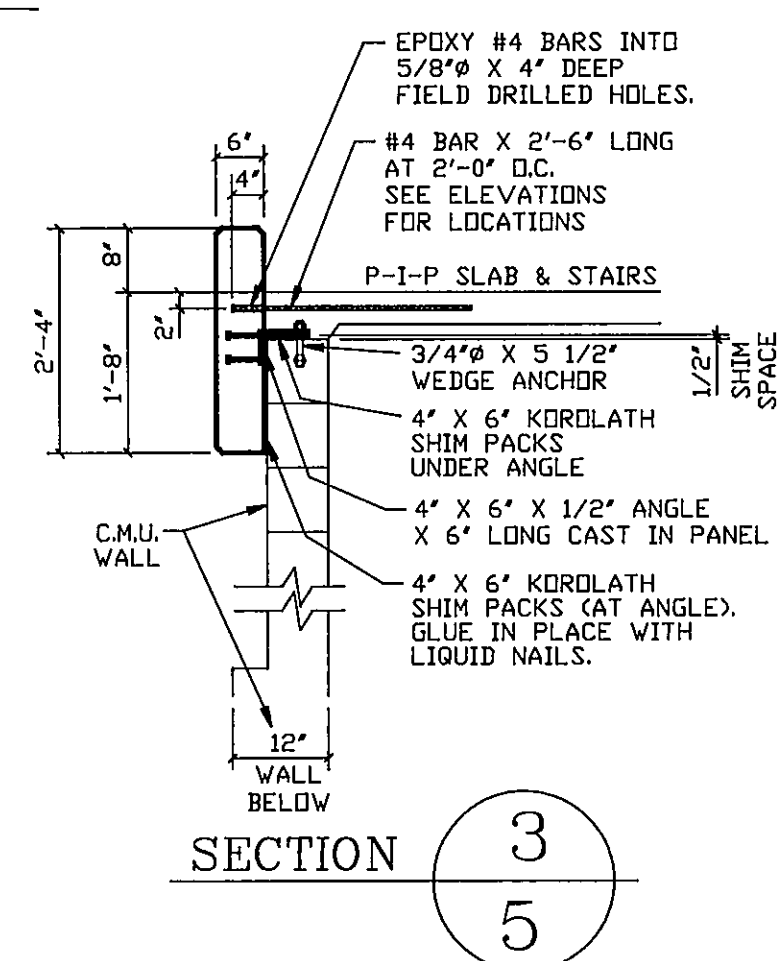

PROJECT FOR  
AMERICAN PRECAST CONCRETE  
  
1030 S. KITLEY AVE.  
INDIANAPOLIS, INDIANA 46203

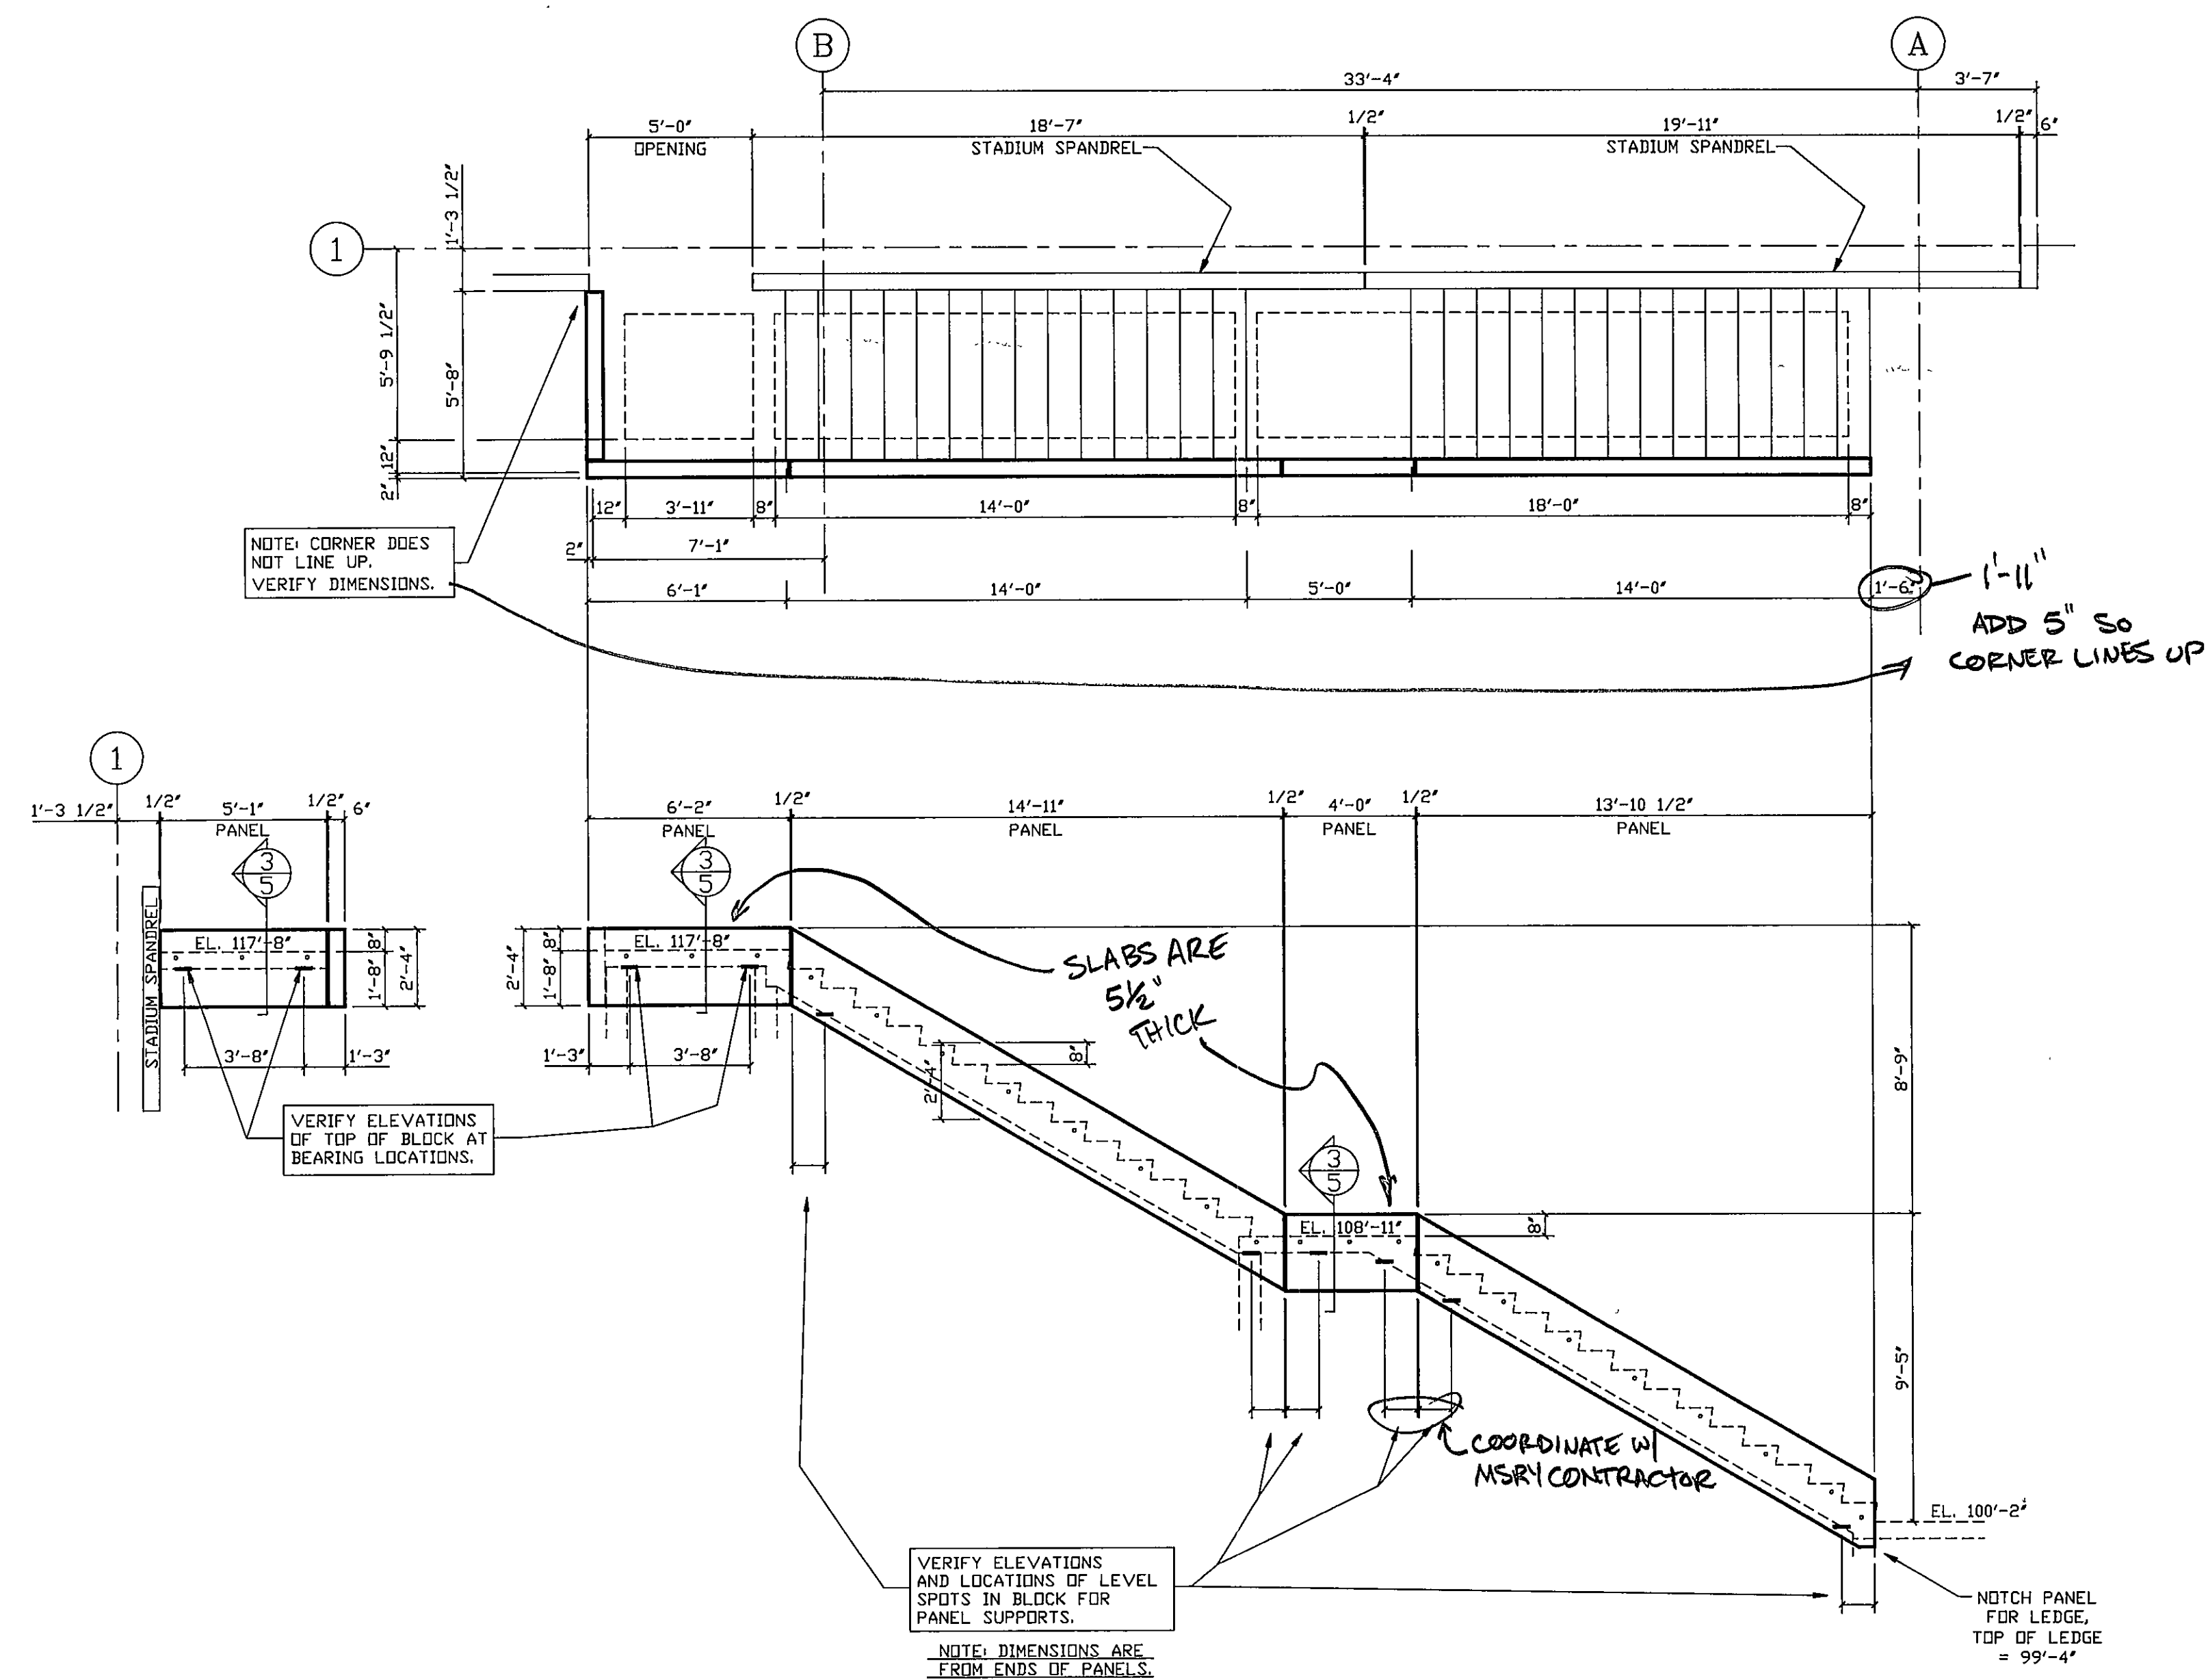

**American  
Precast  
Concrete**

[illegible]

CHESTERTON HIGH SCHOOL  
STADIUM  
CHESTERTON, IN.

JOB NO. 1278-10

**SHEET**

5 ⑤

OF SHEETS