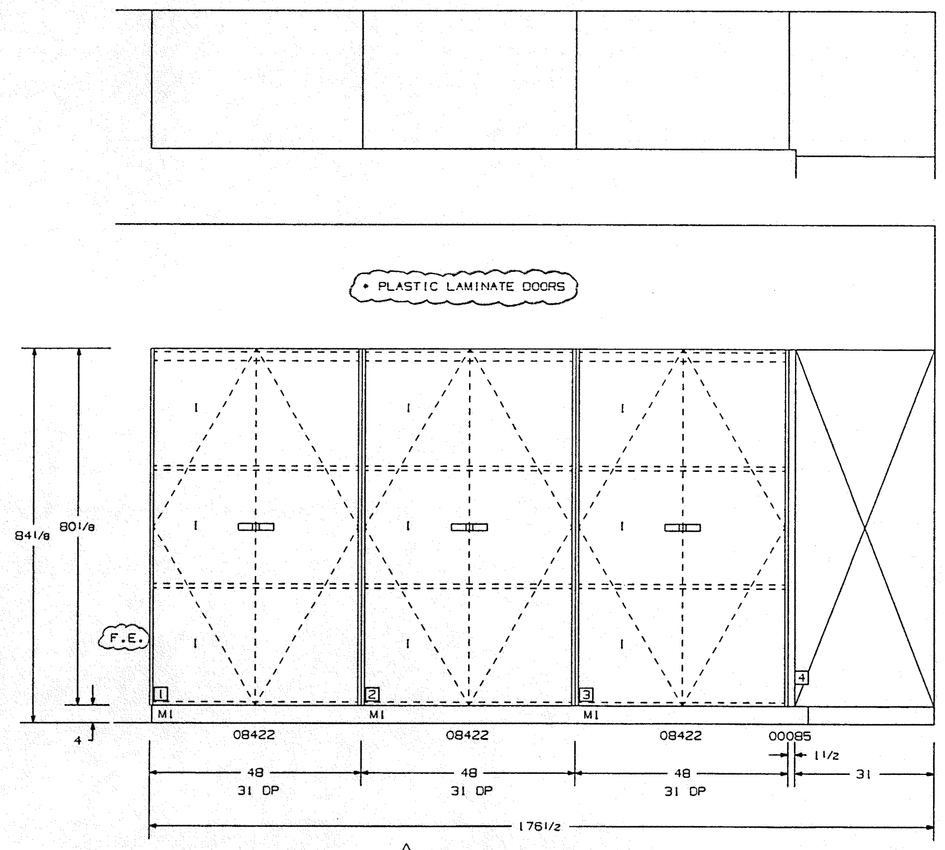


1 ROOM NO. J101

| | | |
|---|---|---|
| I | THUS | ARCH ELEV: SCHEDULE |
| CAB EXT. COLOR: | | |
| CTR. TOP COLOR: | N/A | |
| CAB INT. COLOR: | WHITE | |

NOTE:
ALL SHELVES ON THIS SHEET ARE FIXED.

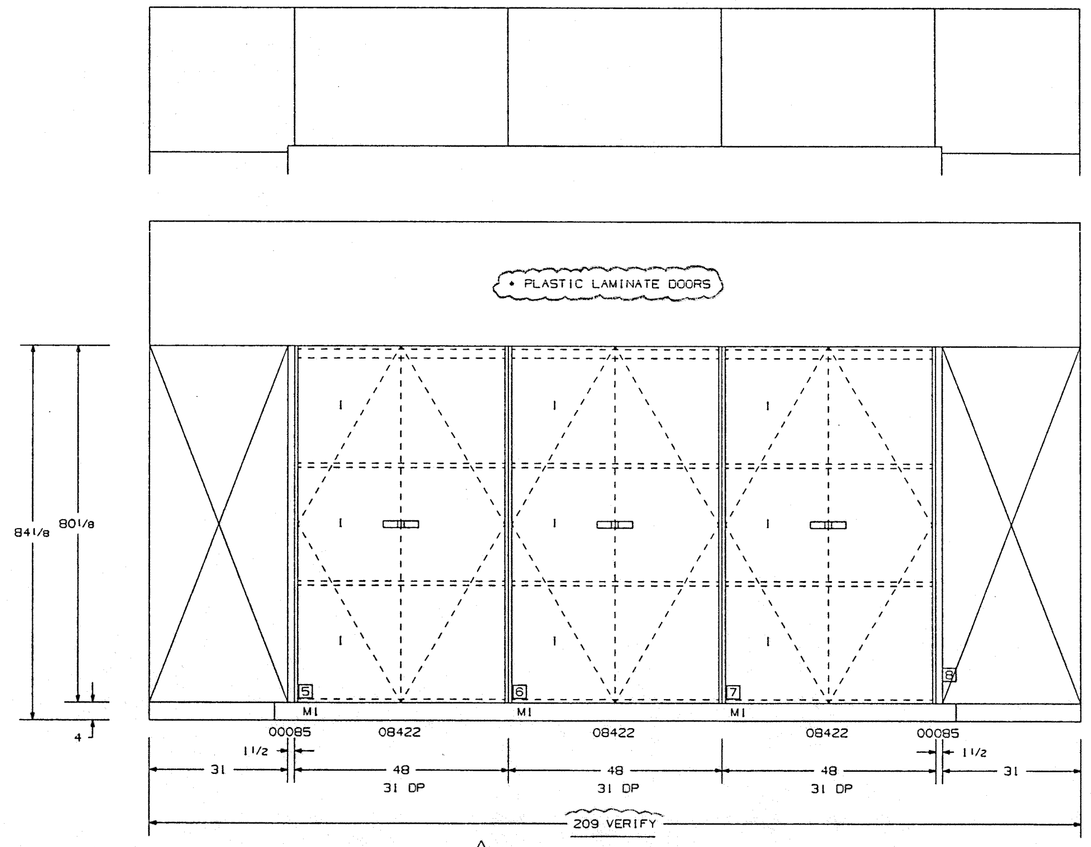


2 ROOM NO. J101

| | | |
|---|---|---|
| I | THUS | ARCH ELEV: SCHEDULE |
| CAB EXT. COLOR: | | |
| CTR. TOP COLOR: | N/A | |
| CAB INT. COLOR: | WHITE | |

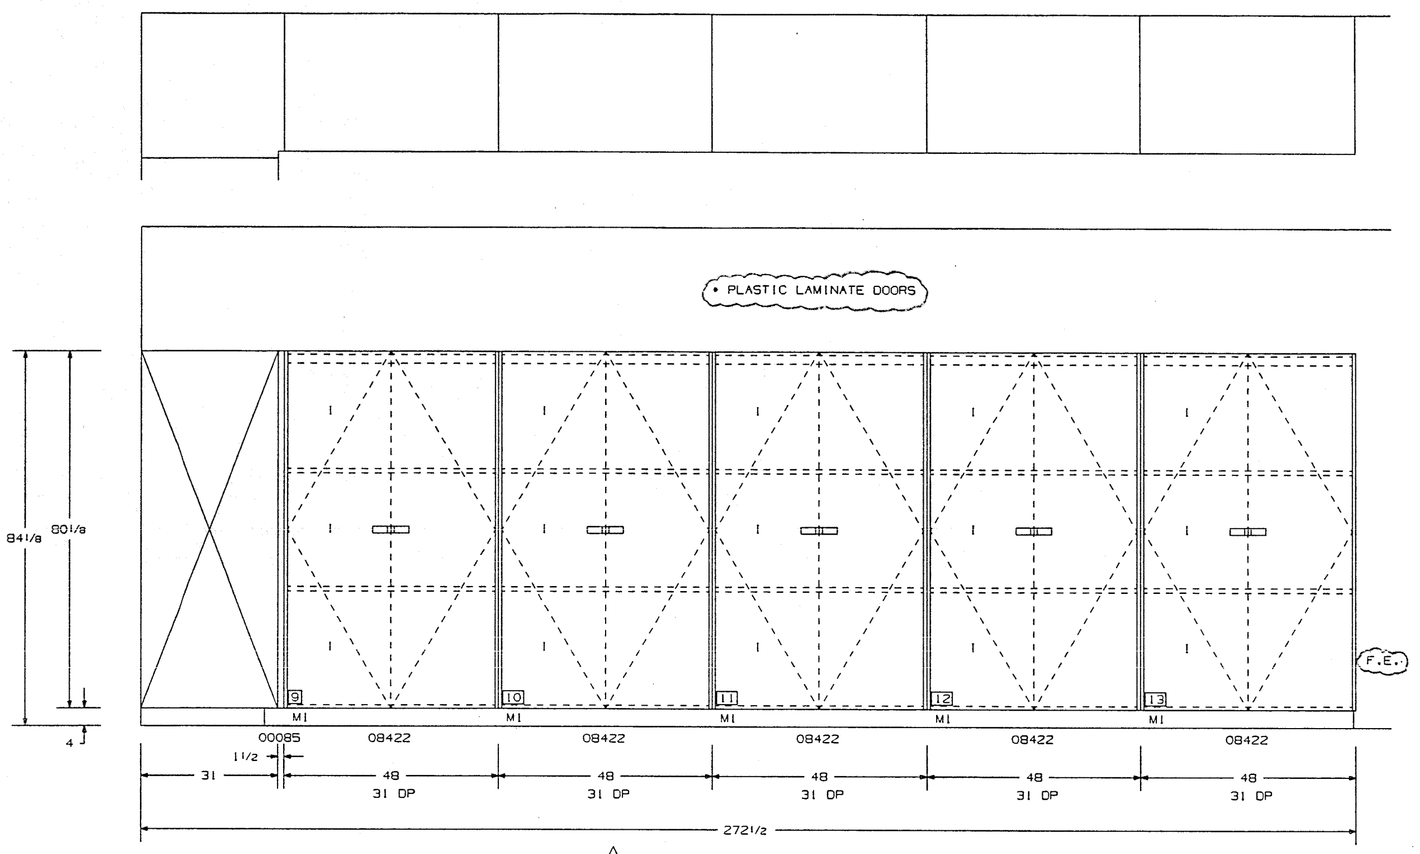


3 ROOM NO. J101

| | | |
|---|---|---|
| I | THUS | ARCH ELEV: SCHEDULE |
| CAB EXT. COLOR: | | |
| CTR. TOP COLOR: | N/A | |
| CAB INT. COLOR: | WHITE | |

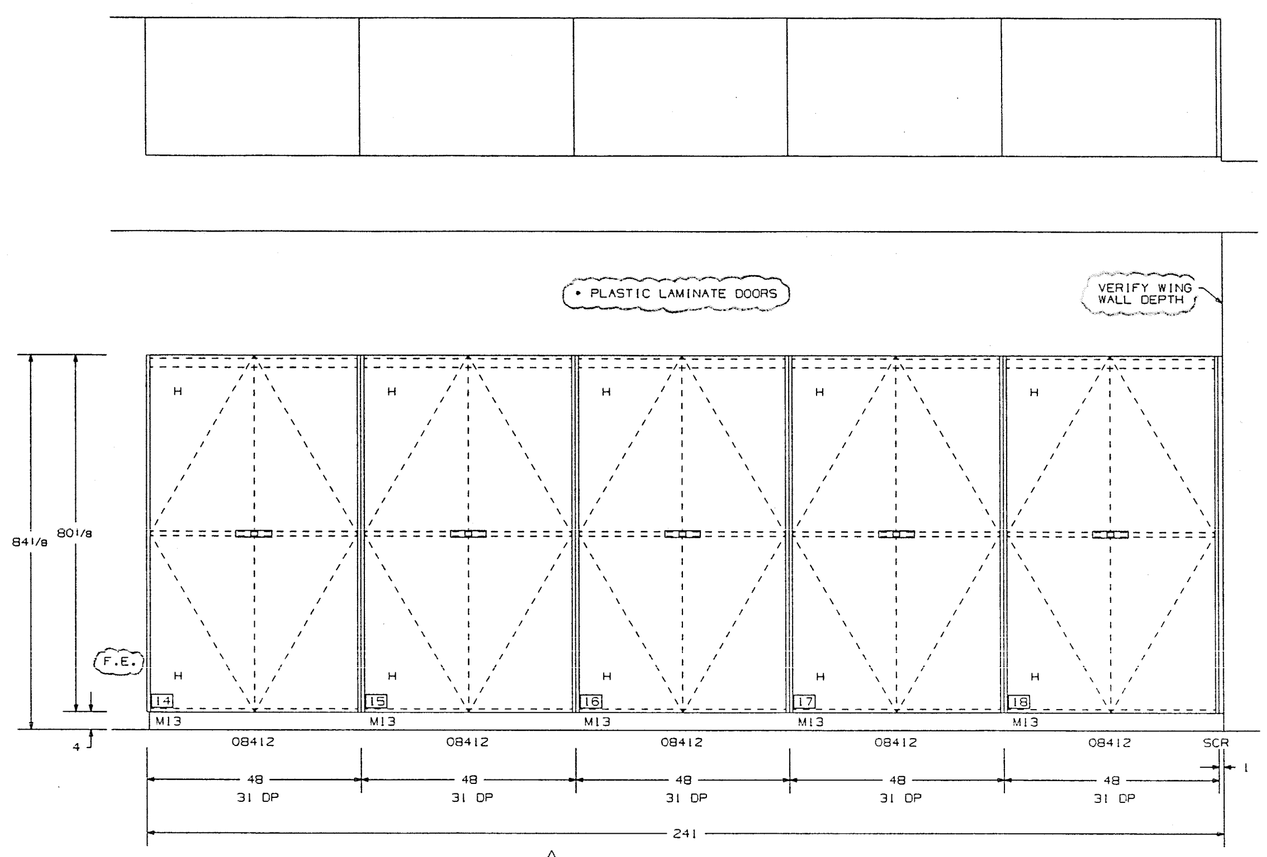


4 ROOM NO. J101

| | | |
|---|---|---|
| I | THUS | ARCH ELEV: SCHEDULE |
| CAB EXT. COLOR: | | |
| CTR. TOP COLOR: | N/A | |
| CAB INT. COLOR: | WHITE | |

98m-A-03

14625_001.PRT

| | | |
|---|---|---|
| Chesterton High School | | |
| ELEV. 1 THRU 4 | LSI PROJECT NO. | SHEET NO. |
| CABT. 1 THRU 18 | 14625 | 3 of 8 |