

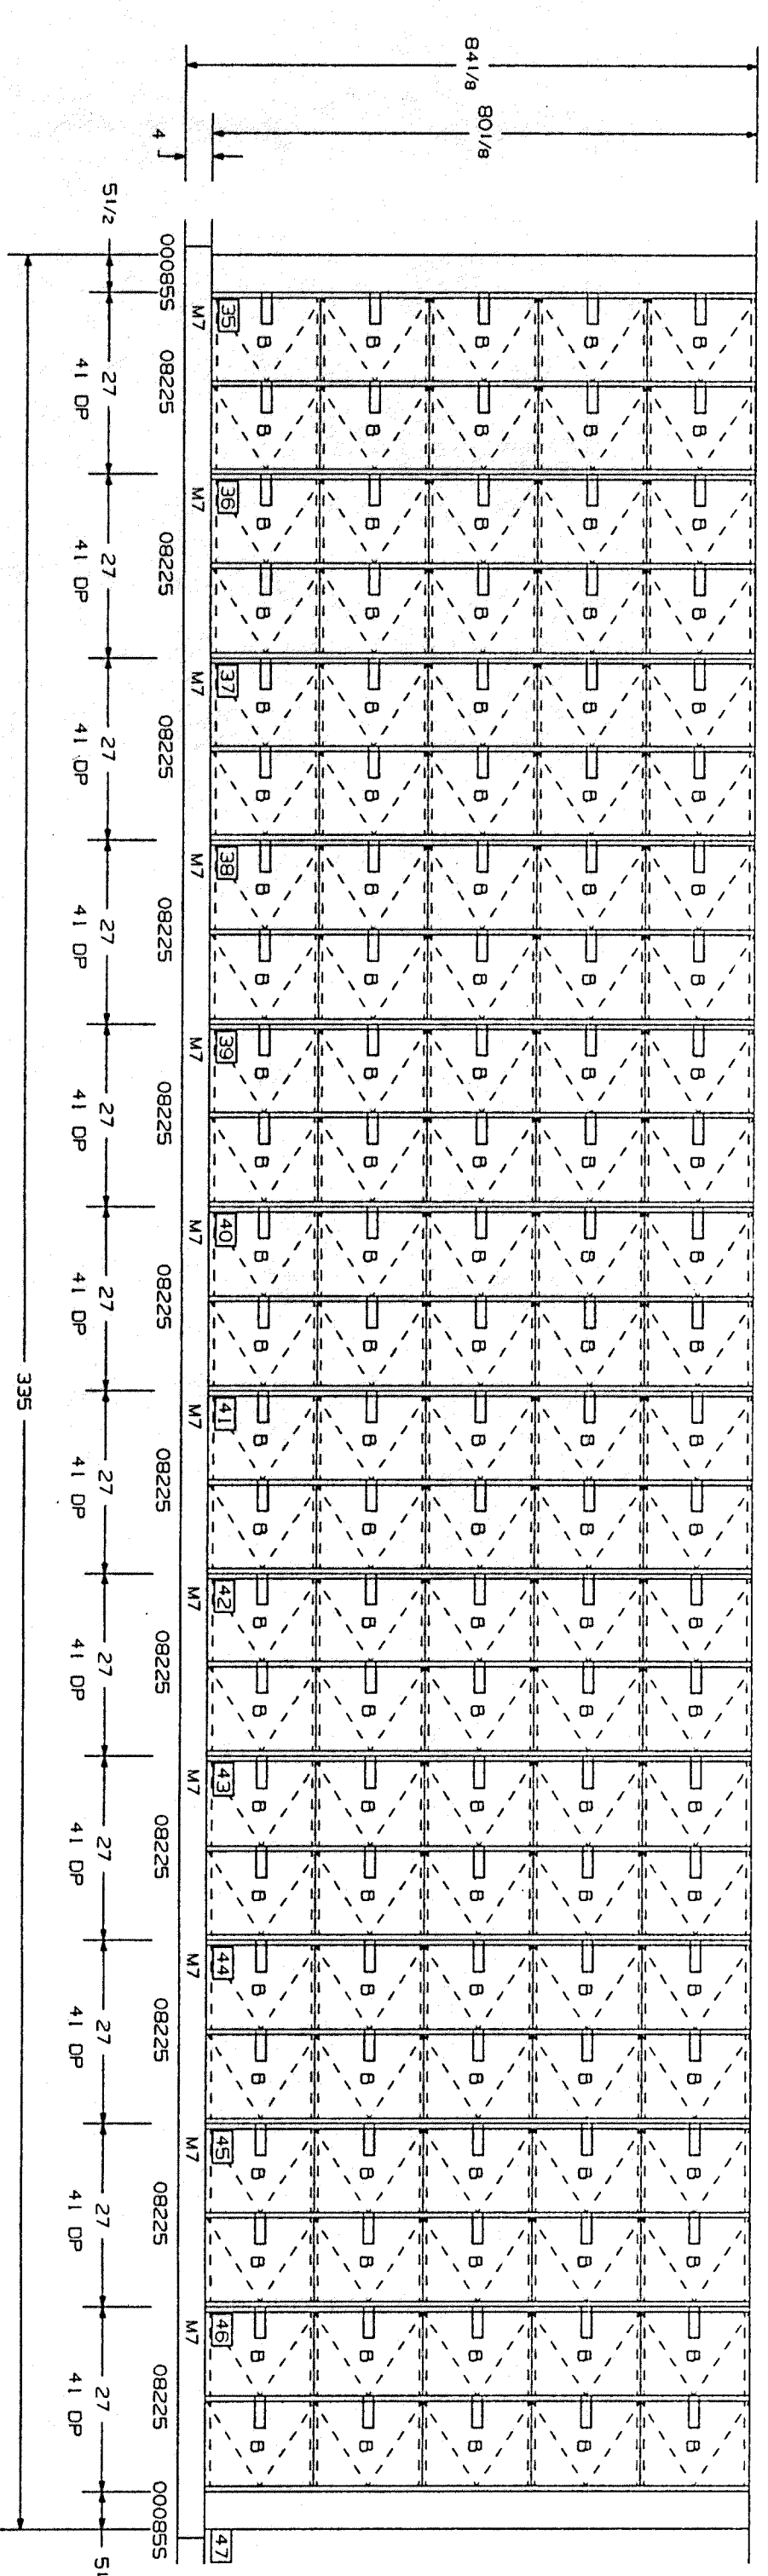
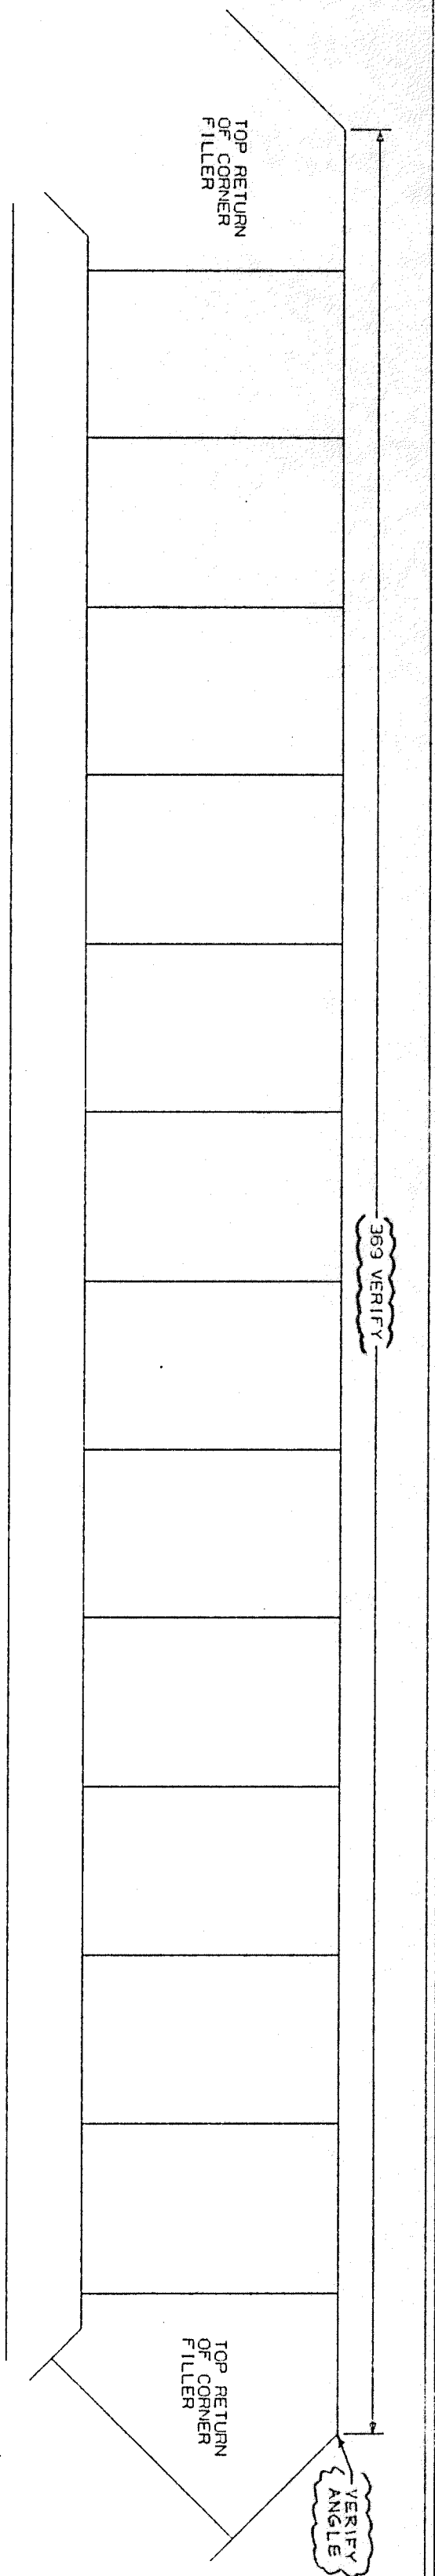


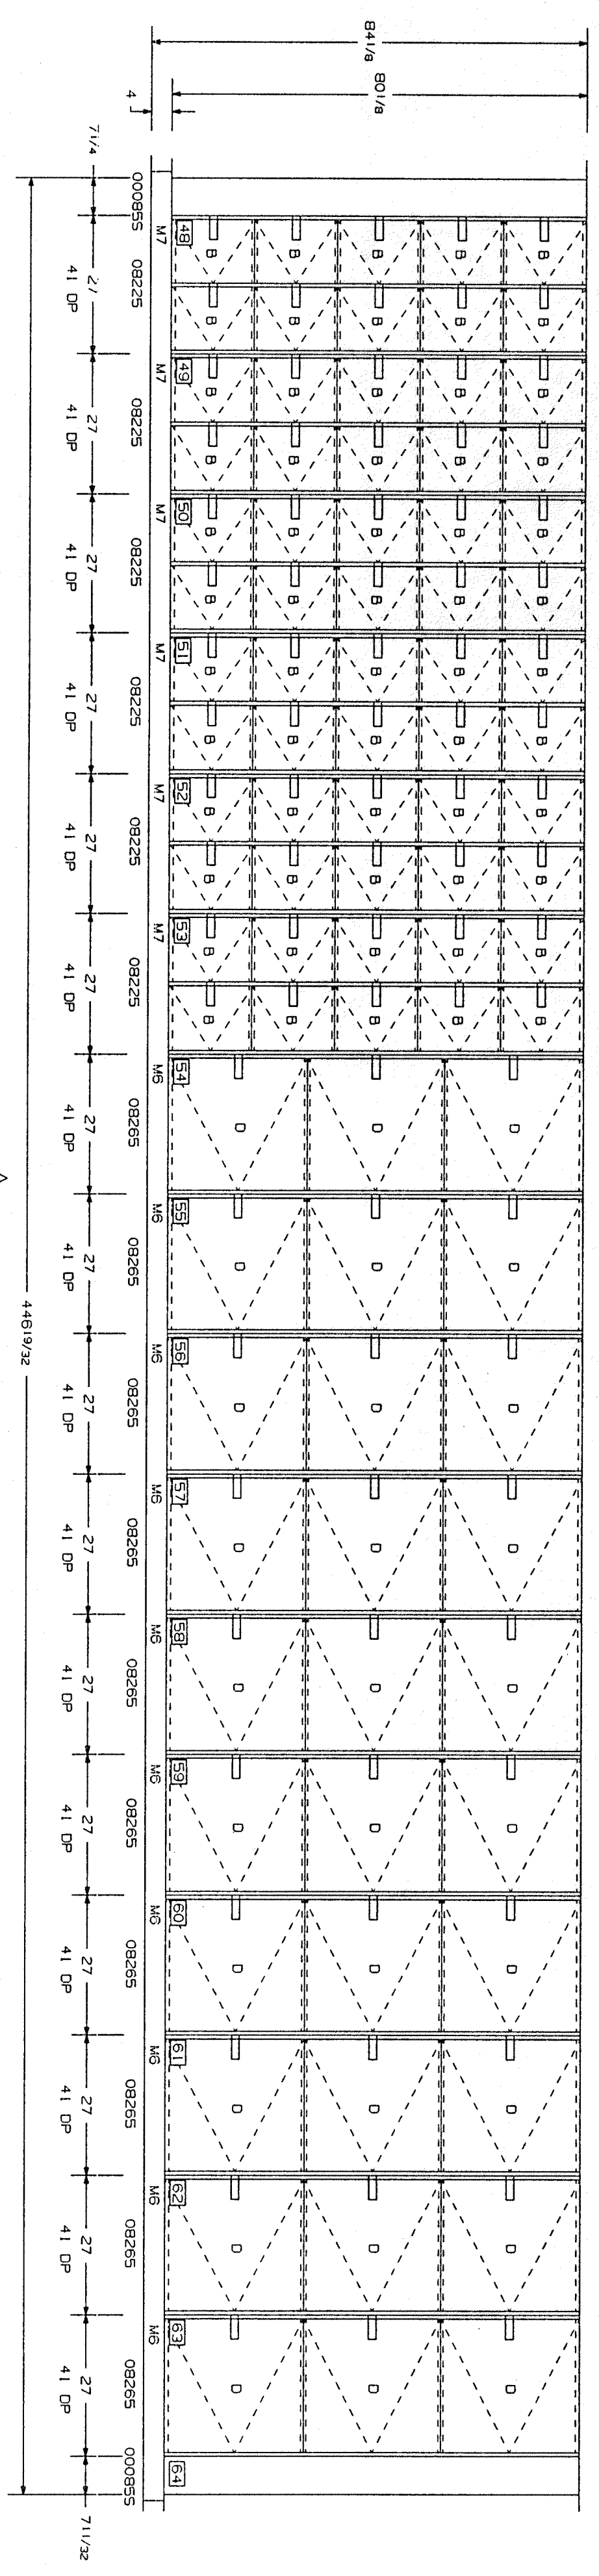

NOTE:
ALL SHELVES ON THIS
SHEET ARE FIXED.

ROOM NO. J112	
1	THIS ARCH ELEV. SCHEDULE
CAB. EXT. COLOR:	N/A
CAB. INT. COLOR:	WHITE

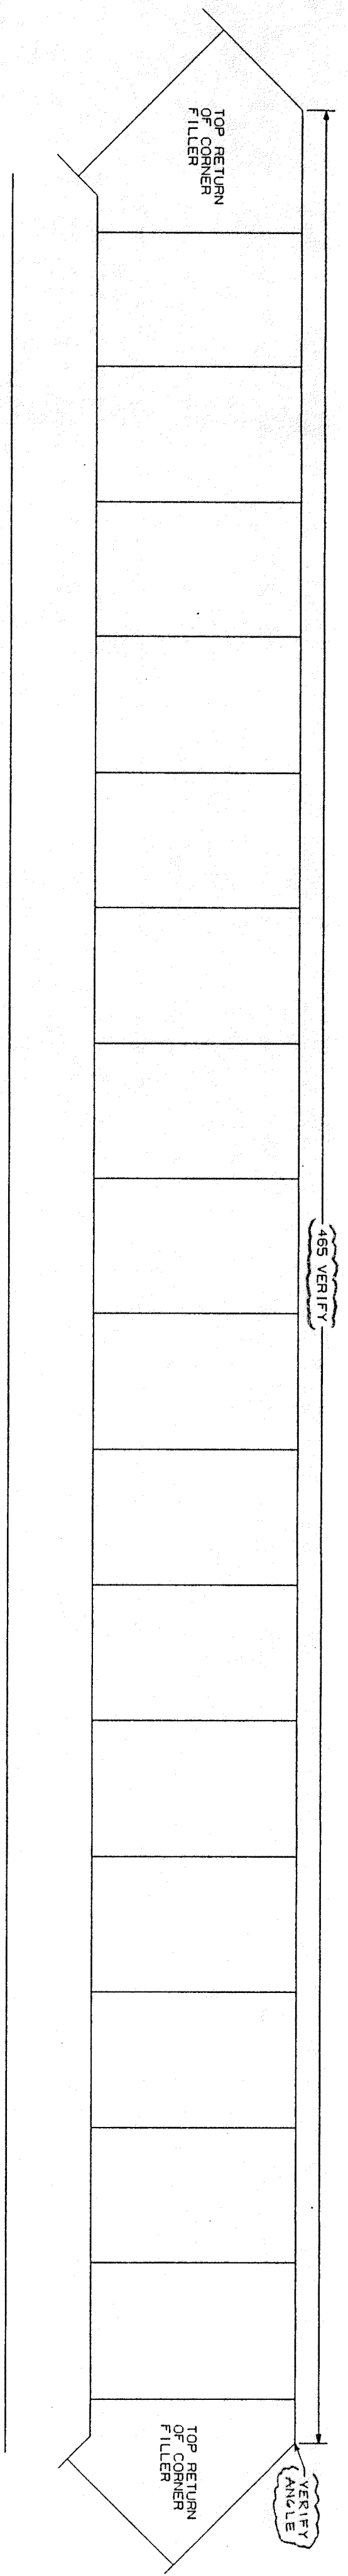

ROOM NO. J112	
1	THIS ARCH ELEV. SCHEDULE
CAB. EXT. COLOR:	N/A
CAB. INT. COLOR:	WHITE

98W-1A-05