
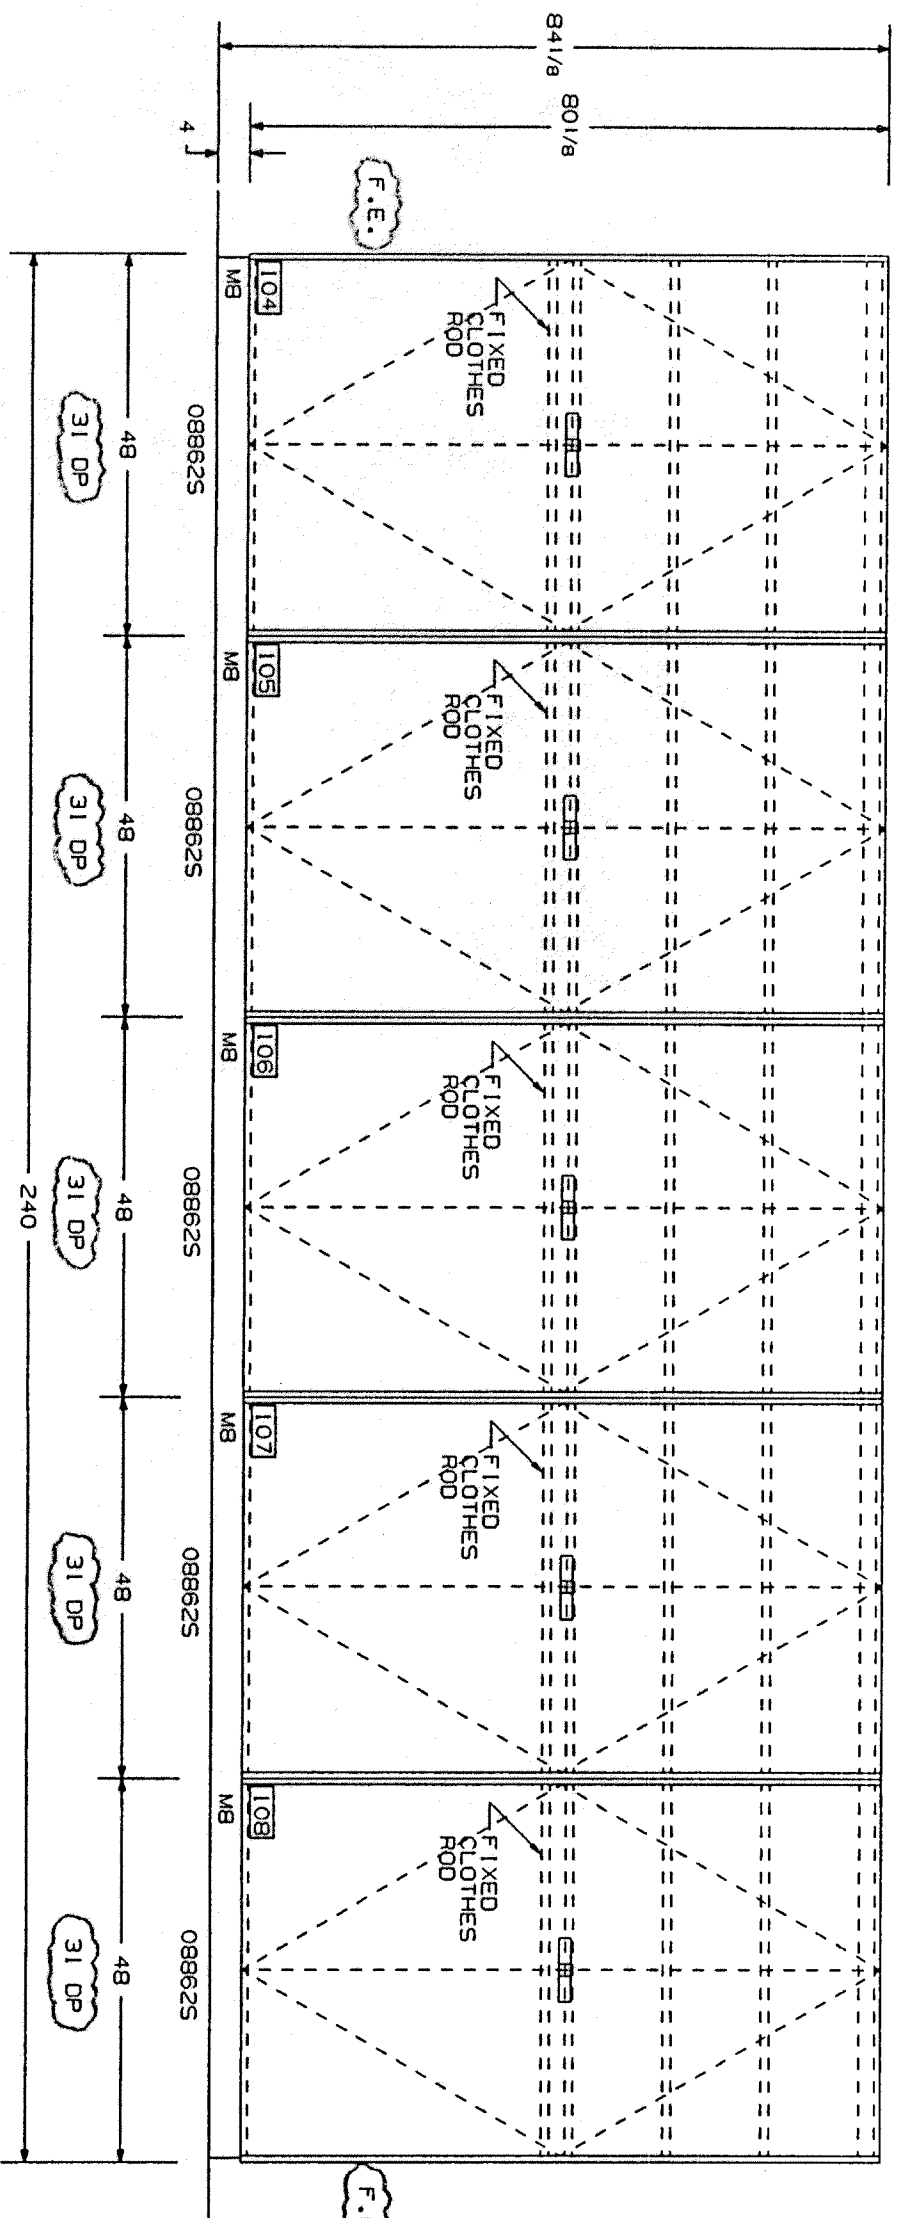


PLASTIC LAMINATE DOORS

NOTE: MINIMUM COMPARTMENT SIZE FOR A 4780 UNIT IS 14 5/8" X 15 5/8" (14 1/2" X 15 1/2") PROJECT 16 PLEASE VERIFY IF OTHERS WILL MEET THE OWNERS INTENDED USE.

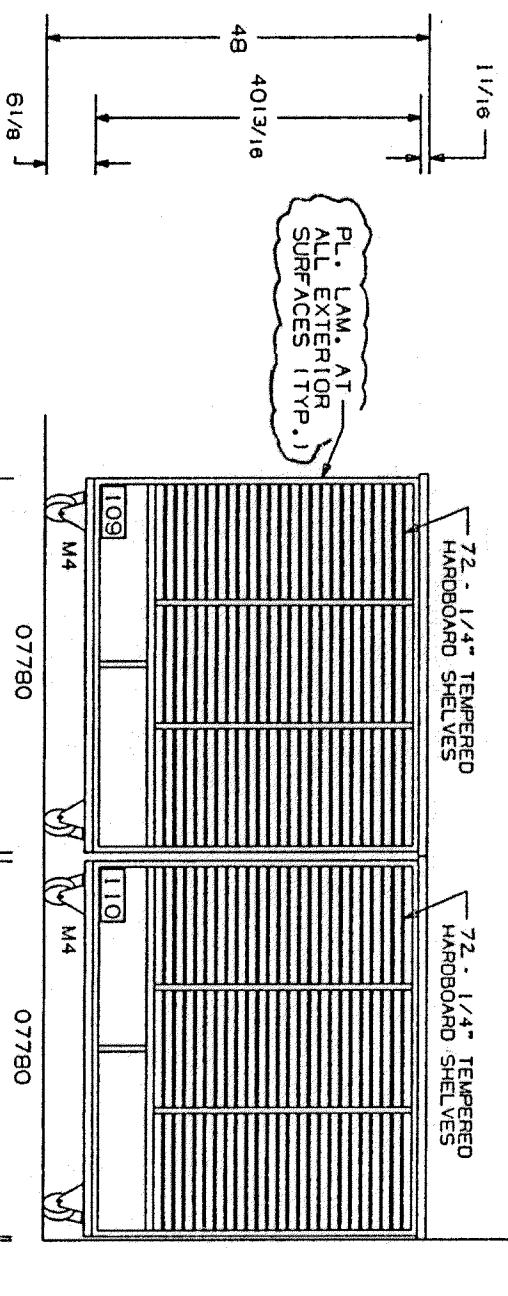

ROOM NO. J122

THIS ARCH ELEV. SCHEDULE
CAB EXT. COLOR: N/A
CTR. TOP COLOR: N/A
CAB INT. COLOR: WHITE



ROOM NO. J125

THIS ARCH ELEV. SCHEDULE
CAB EXT. COLOR: N/A
CTR. TOP COLOR: N/A
CAB INT. COLOR: WHITE

ROOM NO. J126


THIS ARCH ELEV. SCHEDULE
CAB EXT. COLOR: N/A
CTR. TOP COLOR: N/A
CAB INT. COLOR: WHITE

NOTE: SHELVES IN CABINETS 104, 119, AND 120 ARE FIXED.

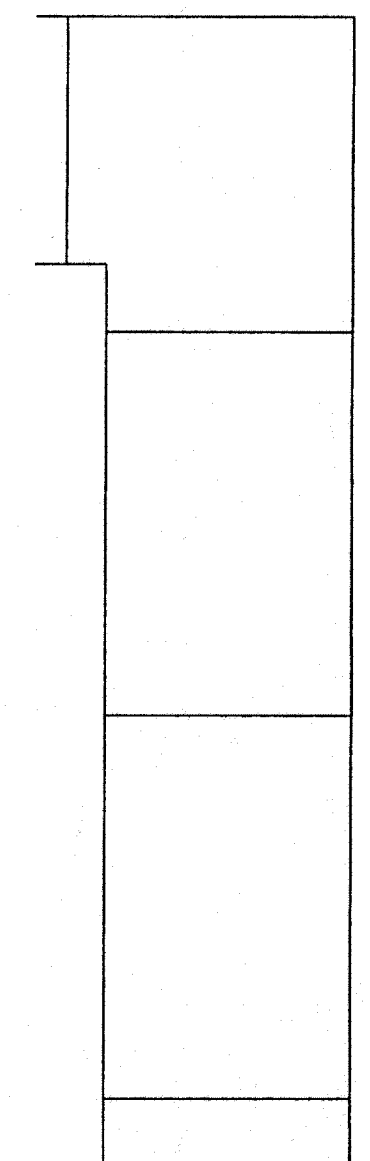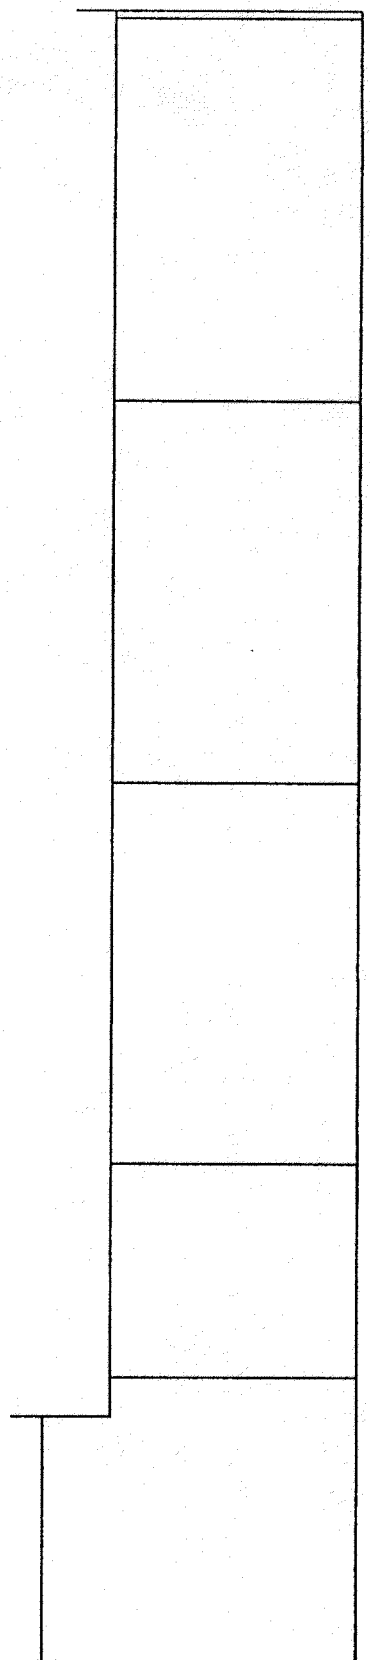


PLASTIC LAMINATE DOORS

PLASTIC LAMINATE DOORS

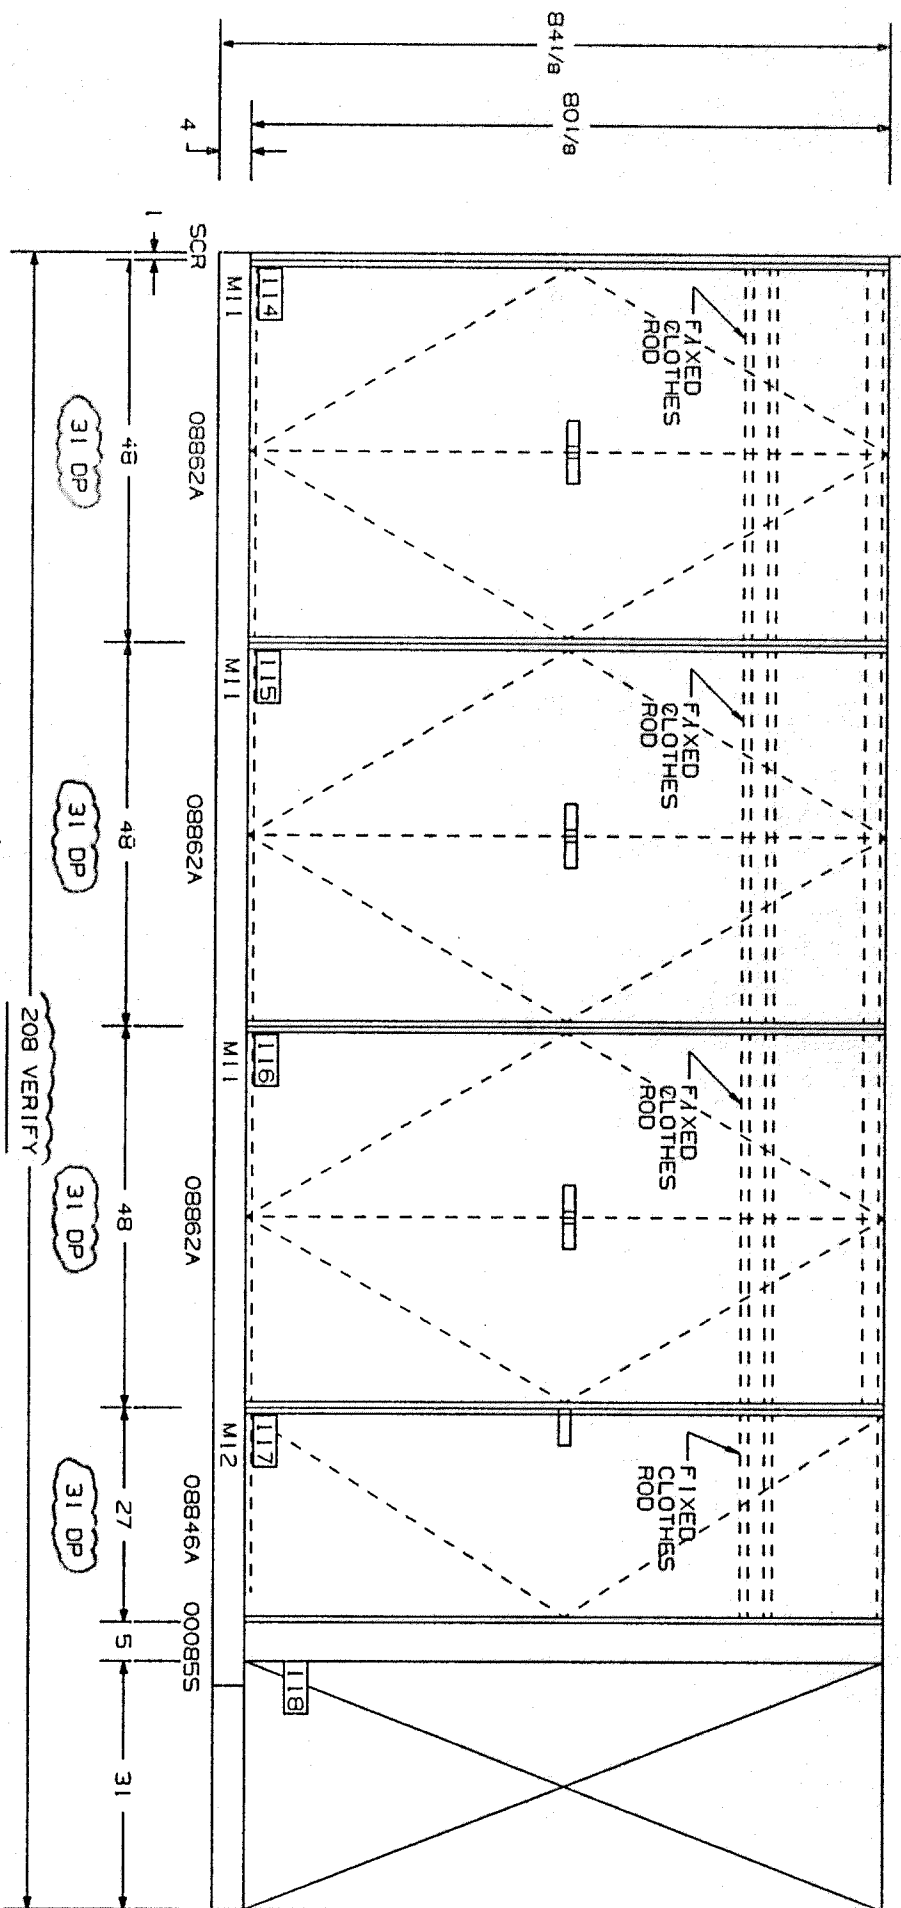

ROOM NO. J126

THIS ARCH ELEV. SCHEDULE
CAB EXT. COLOR: N/A
CTR. TOP COLOR: N/A
CAB INT. COLOR: WHITE

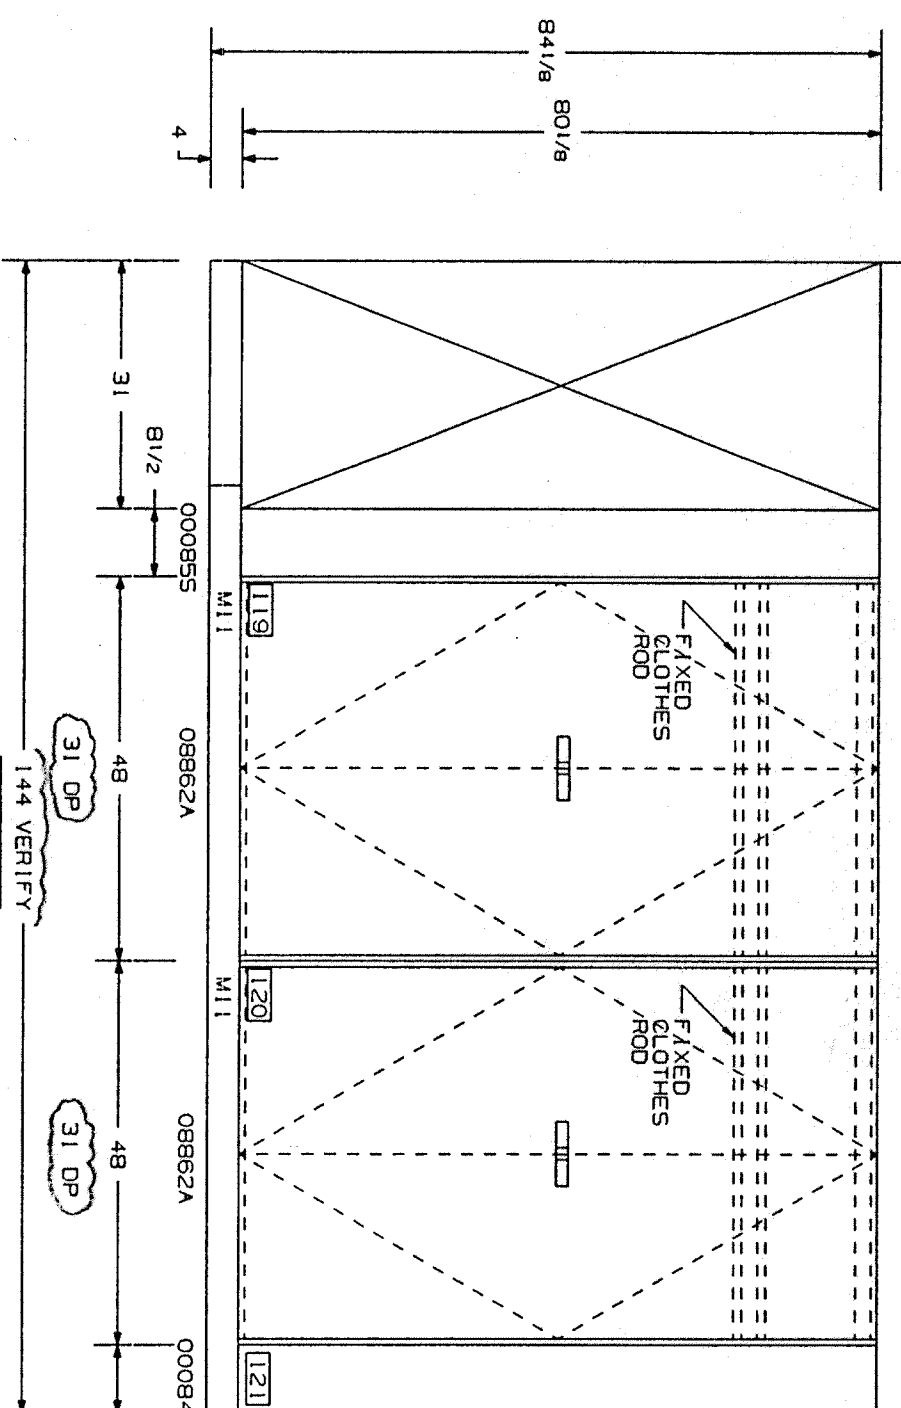

ROOM NO. J126




THIS ARCH ELEV. SCHEDULE
CAB EXT. COLOR: N/A
CTR. TOP COLOR: N/A
CAB INT. COLOR: WHITE


ROOM NO. SEE SCHEDULE

THIS ARCH ELEV. SCHEDULE


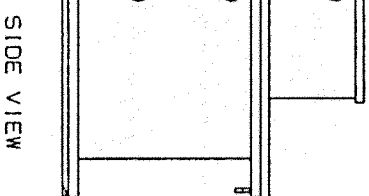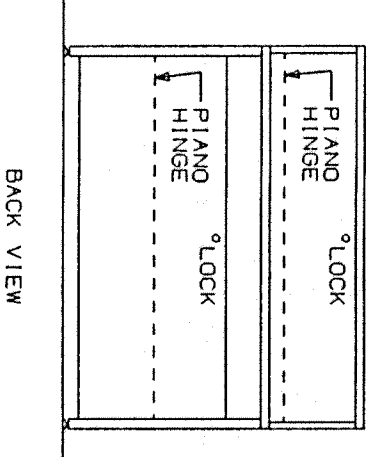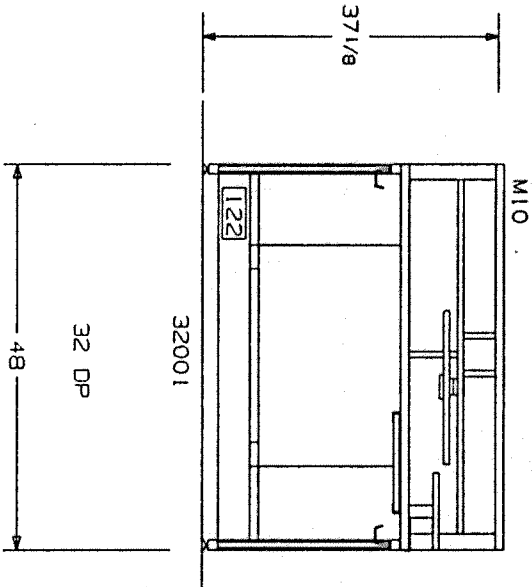


98w-A-08

Chesterston High School
ELEV. 19 THRU 24
PROJECT NO. 14625
CABT. 104 THRU 140
SHEET NO. 8 of 8