




ROOM LEGEND Q2			
ROOM NO.	ROOM NAME	AREA S.F.	CEILING HEIGHT
Q201	MEZZANINE	2043	---
Q202	MEZZANINE	159	---

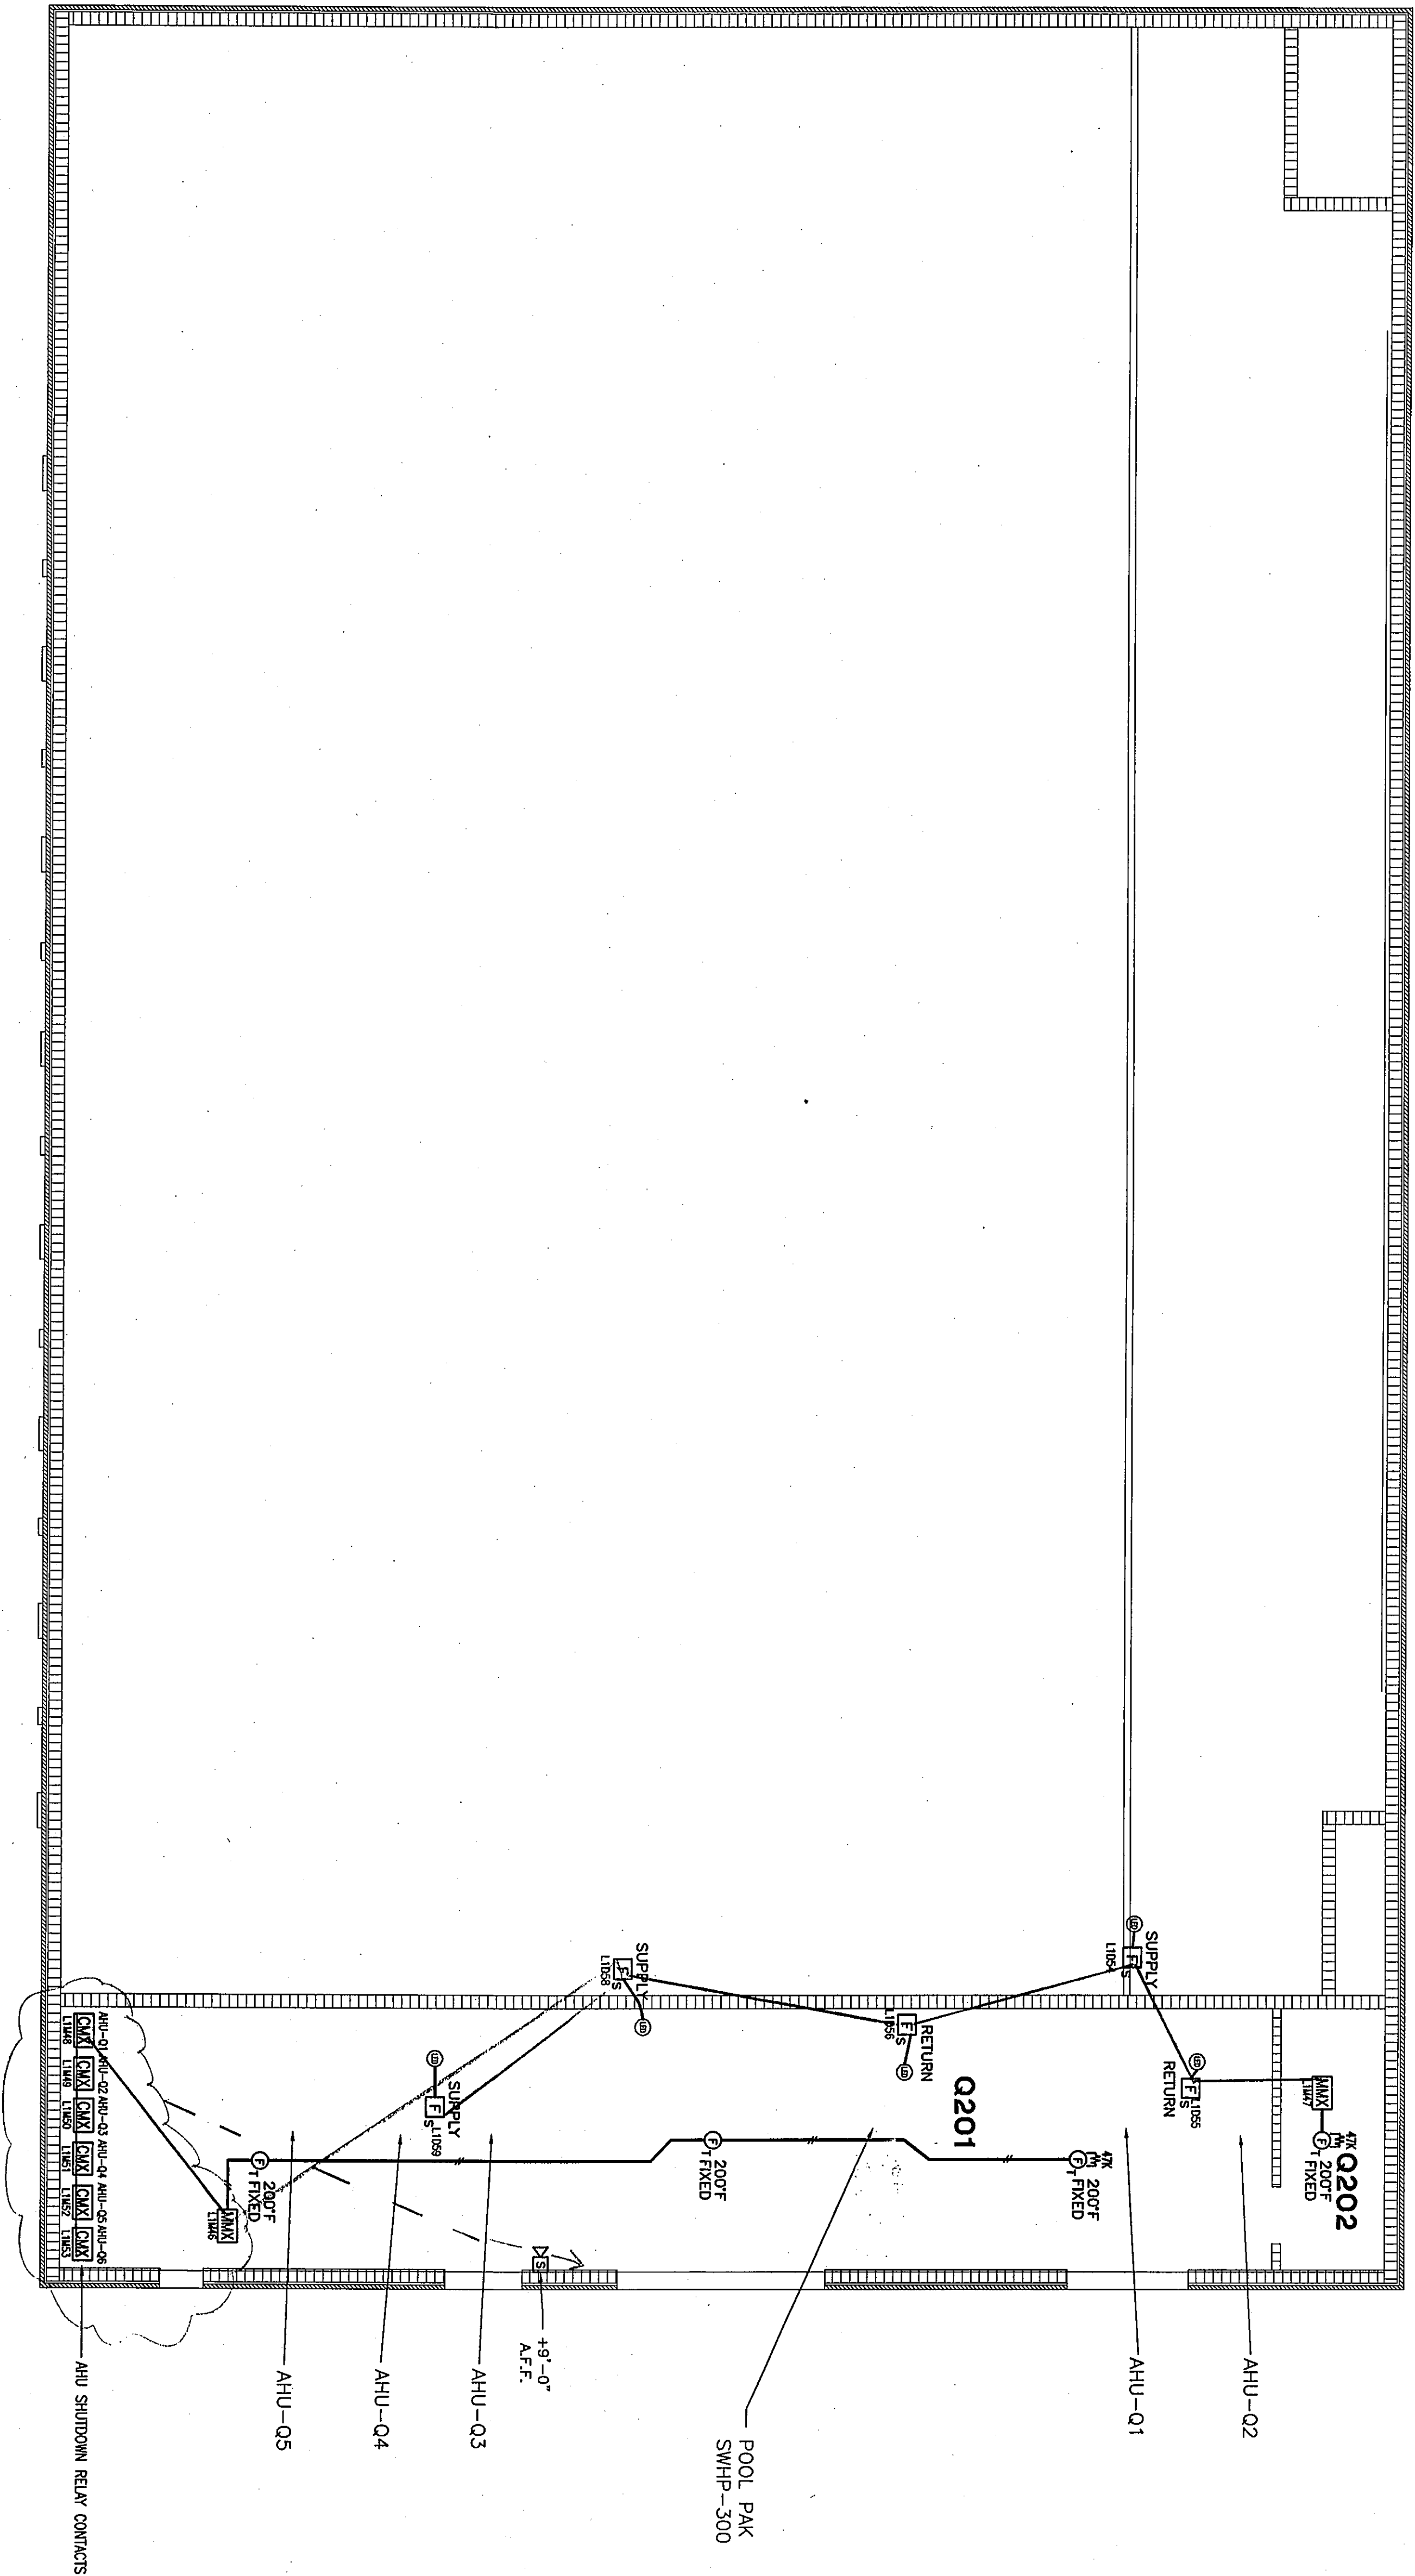

- LEGEND**
- SWM DESCRIPTION
- [FAP] FIRE ALARM PANEL
 - [FAN] FIRE ANNUNCIATOR
 - [E] MANUAL PULL STATION
 - [AH] ALARM HORN/STROBE
 - [AH] ALARM HORN/STROBE, WEATHERPROOF
 - [AS] ALARM STROBE
 - [AS] ALARM SPEAKER
 - [SD] SMOKE DETECTOR
 - [SD] HEAT DETECTOR
 - [E] DUCT MOUNTED SMOKE DETECTOR
 - [E] DUCT MOUNTED SMOKE DETECTOR WITH INTEGRAL RELAY
 - [E] MONITORING LED
 - [CM] CONTROL MODULE
 - [MM] MONITOR MODULE

AUXILIARY PLAN UNIT Q2

SCALE 1/8" = 1'-0"

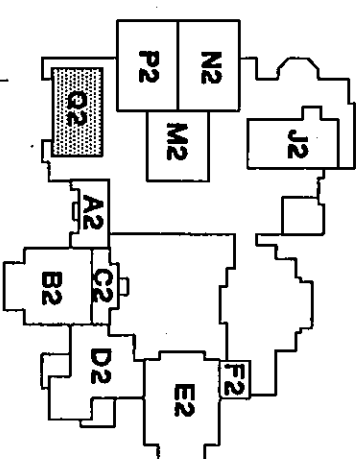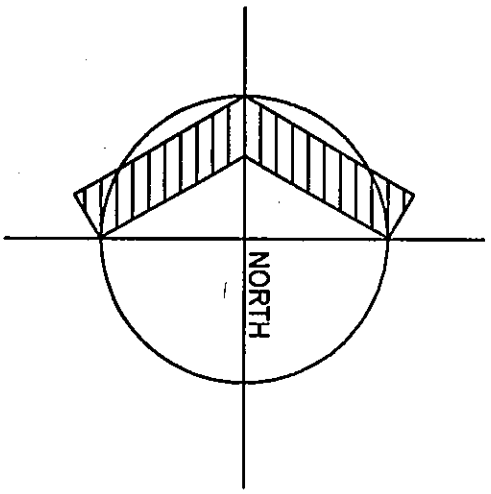

NORTH KEYPLAN

REFERENCE DRAWINGS		NO.		DATE		REVISIONS	
DWG. NO.	DESCRIPTION						
72703E26	FIRE ALARM WIRING RISER DIAGRAM						
72703E25	FIRE ALARM WIRING DETAILS & NOTES						
PROJECT INFORMATION		PROJECT NO.		PROJECT NAME		PROJECT ADDRESS	
		72703		FIRE SYSTEM		1055 N. JULET RD. • P.O. BOX 70 VALPARAISO, INDIANA 46385 (219)-462-0571	
REVISION		ISSUED FOR CONSTRUCTION		ISSUED FOR PERMITS		ISSUED FOR REVIEW	
Sheet 1/8"=1'-0"							
drawing by 5966700							
checked by J. J. CAMPBELL							
approved by K. A. LUNDSTEDT						DATE 7/16/98	
PROJECT NO.		PROJECT NAME		PROJECT ADDRESS		PROJECT CITY	
72703E25		FIRE ALARM & DETECTION SYSTEM		CHESTERION HIGH SCHOOL		2125 S. 11TH STREET	
REV.		UNIT 02		CHESTERION, INDIANA			
1 OF 1		DEVICE LAYOUT					
SHEET NO.							