DRAWING NO: 72703E26

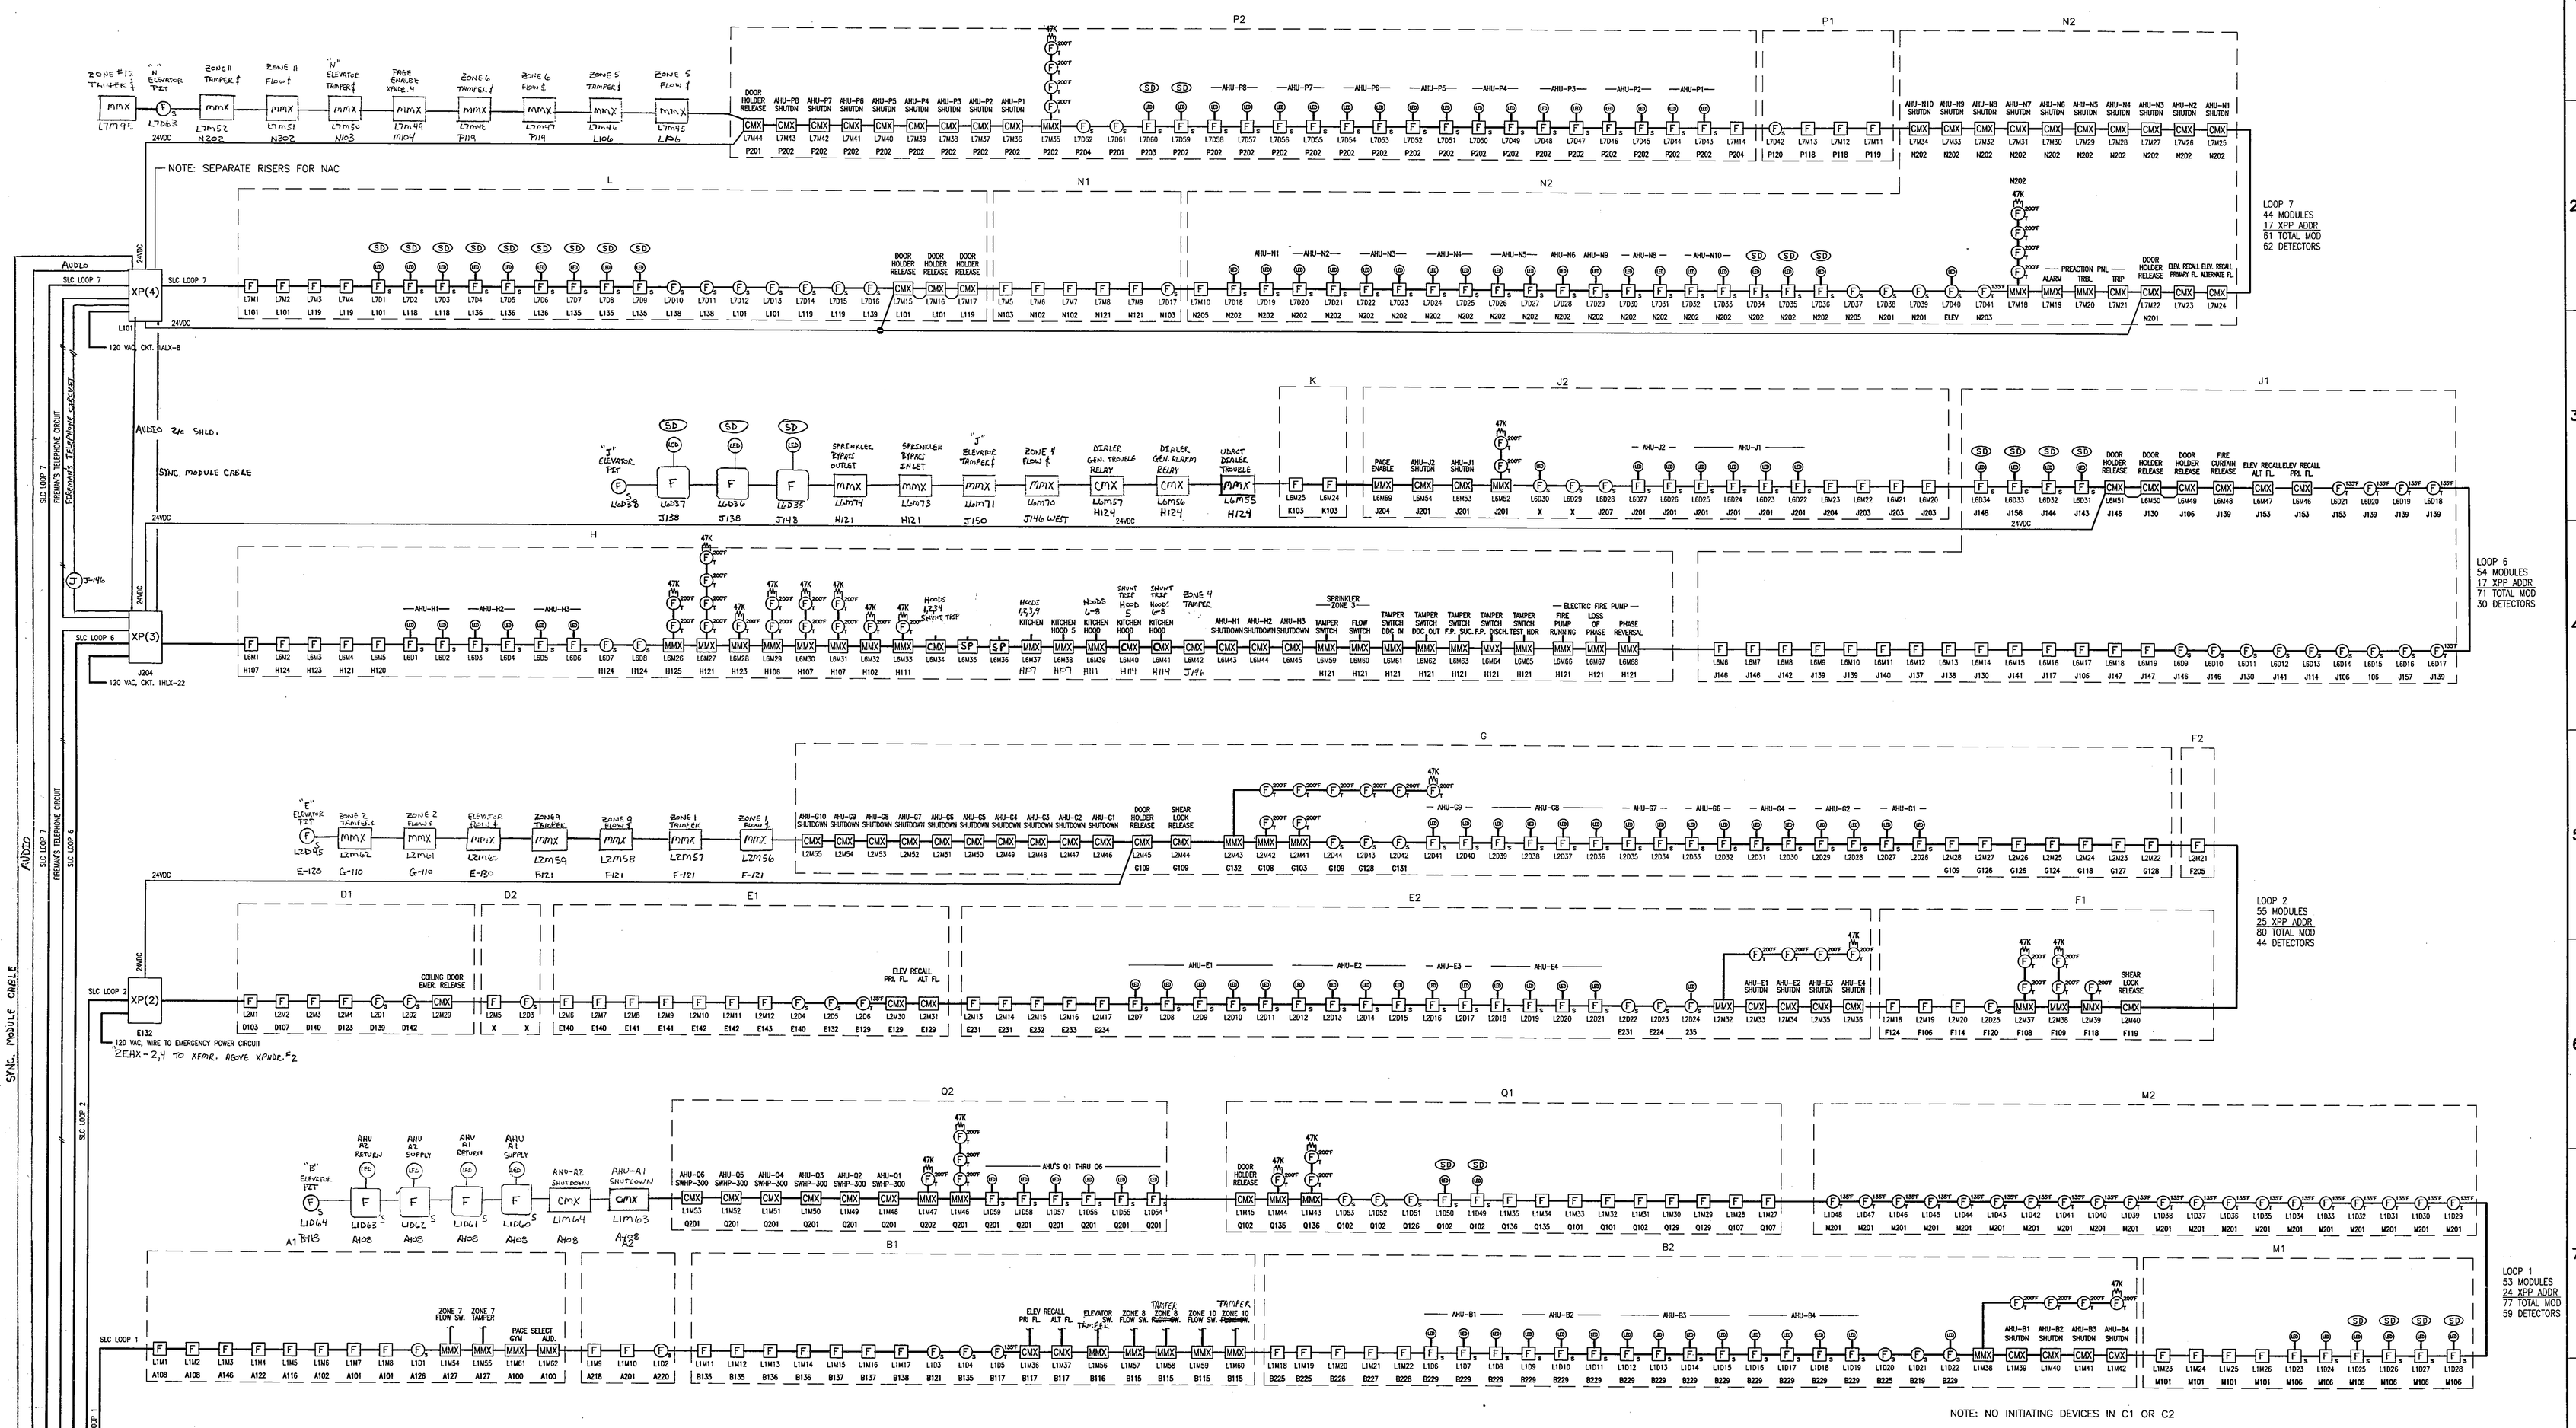

REFERENCE DRAWINGS	
DWG. NO.	DESCRIPTION
72703E35	FIRE ALARM WIRING DETAILS & NOTES

MCDANIEL FIRE SYSTEMS
1055 W.JOLIET RD. • P.O.BOX 70
VALPARAISO, INDIANA 46385
(219)-462-0571

MFS JOB NO. 72703
INSURANCE
SCALE NONE
SPECIFICATION 95067.00
DESIGNED BY J. J. GAWRYSIAK | CHECKED BY K. A. LINDSTEDT | DATE 7/16/98

NO.	DATE	BY	REVISIONS
0	11/11/98	KAL	ISSUED FOR CONSTRUCTION
A	7/16/98	KAL	ISSUED FOR REVIEW

CHESTERTON HIGH SCHOOL
2125 S. 11TH STREET
CHESTERTON, INDIANA

FIRE ALARM & DETECTION SYSTEM

DEVICE WIRING RISER DIAGRAM

DRAWING NO.: 72703E26 | REV. 0 | SHEET NO. 1 of 2