


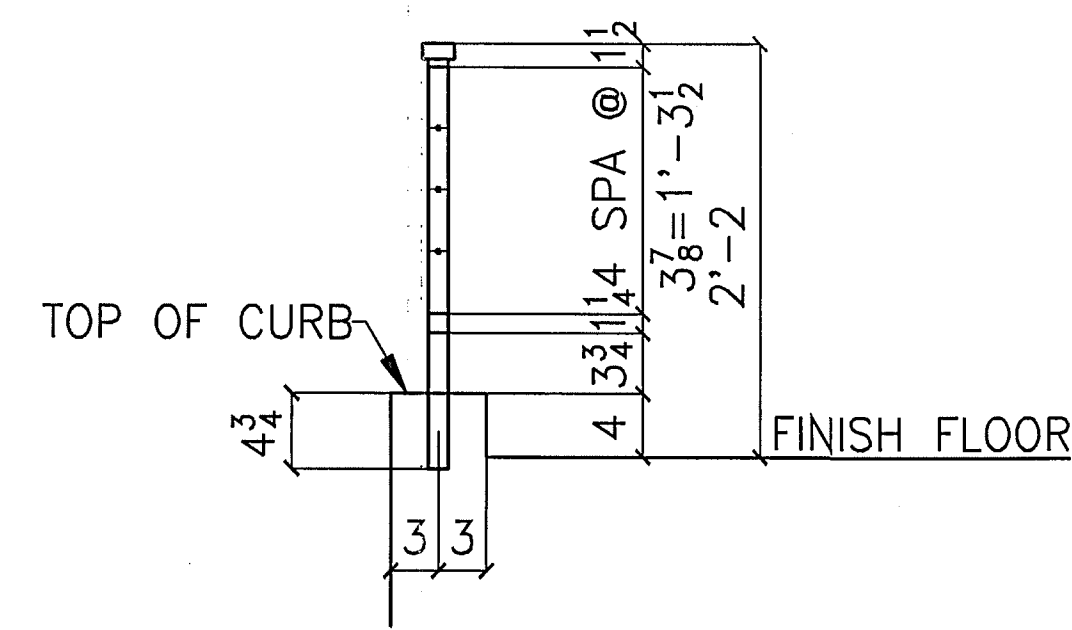
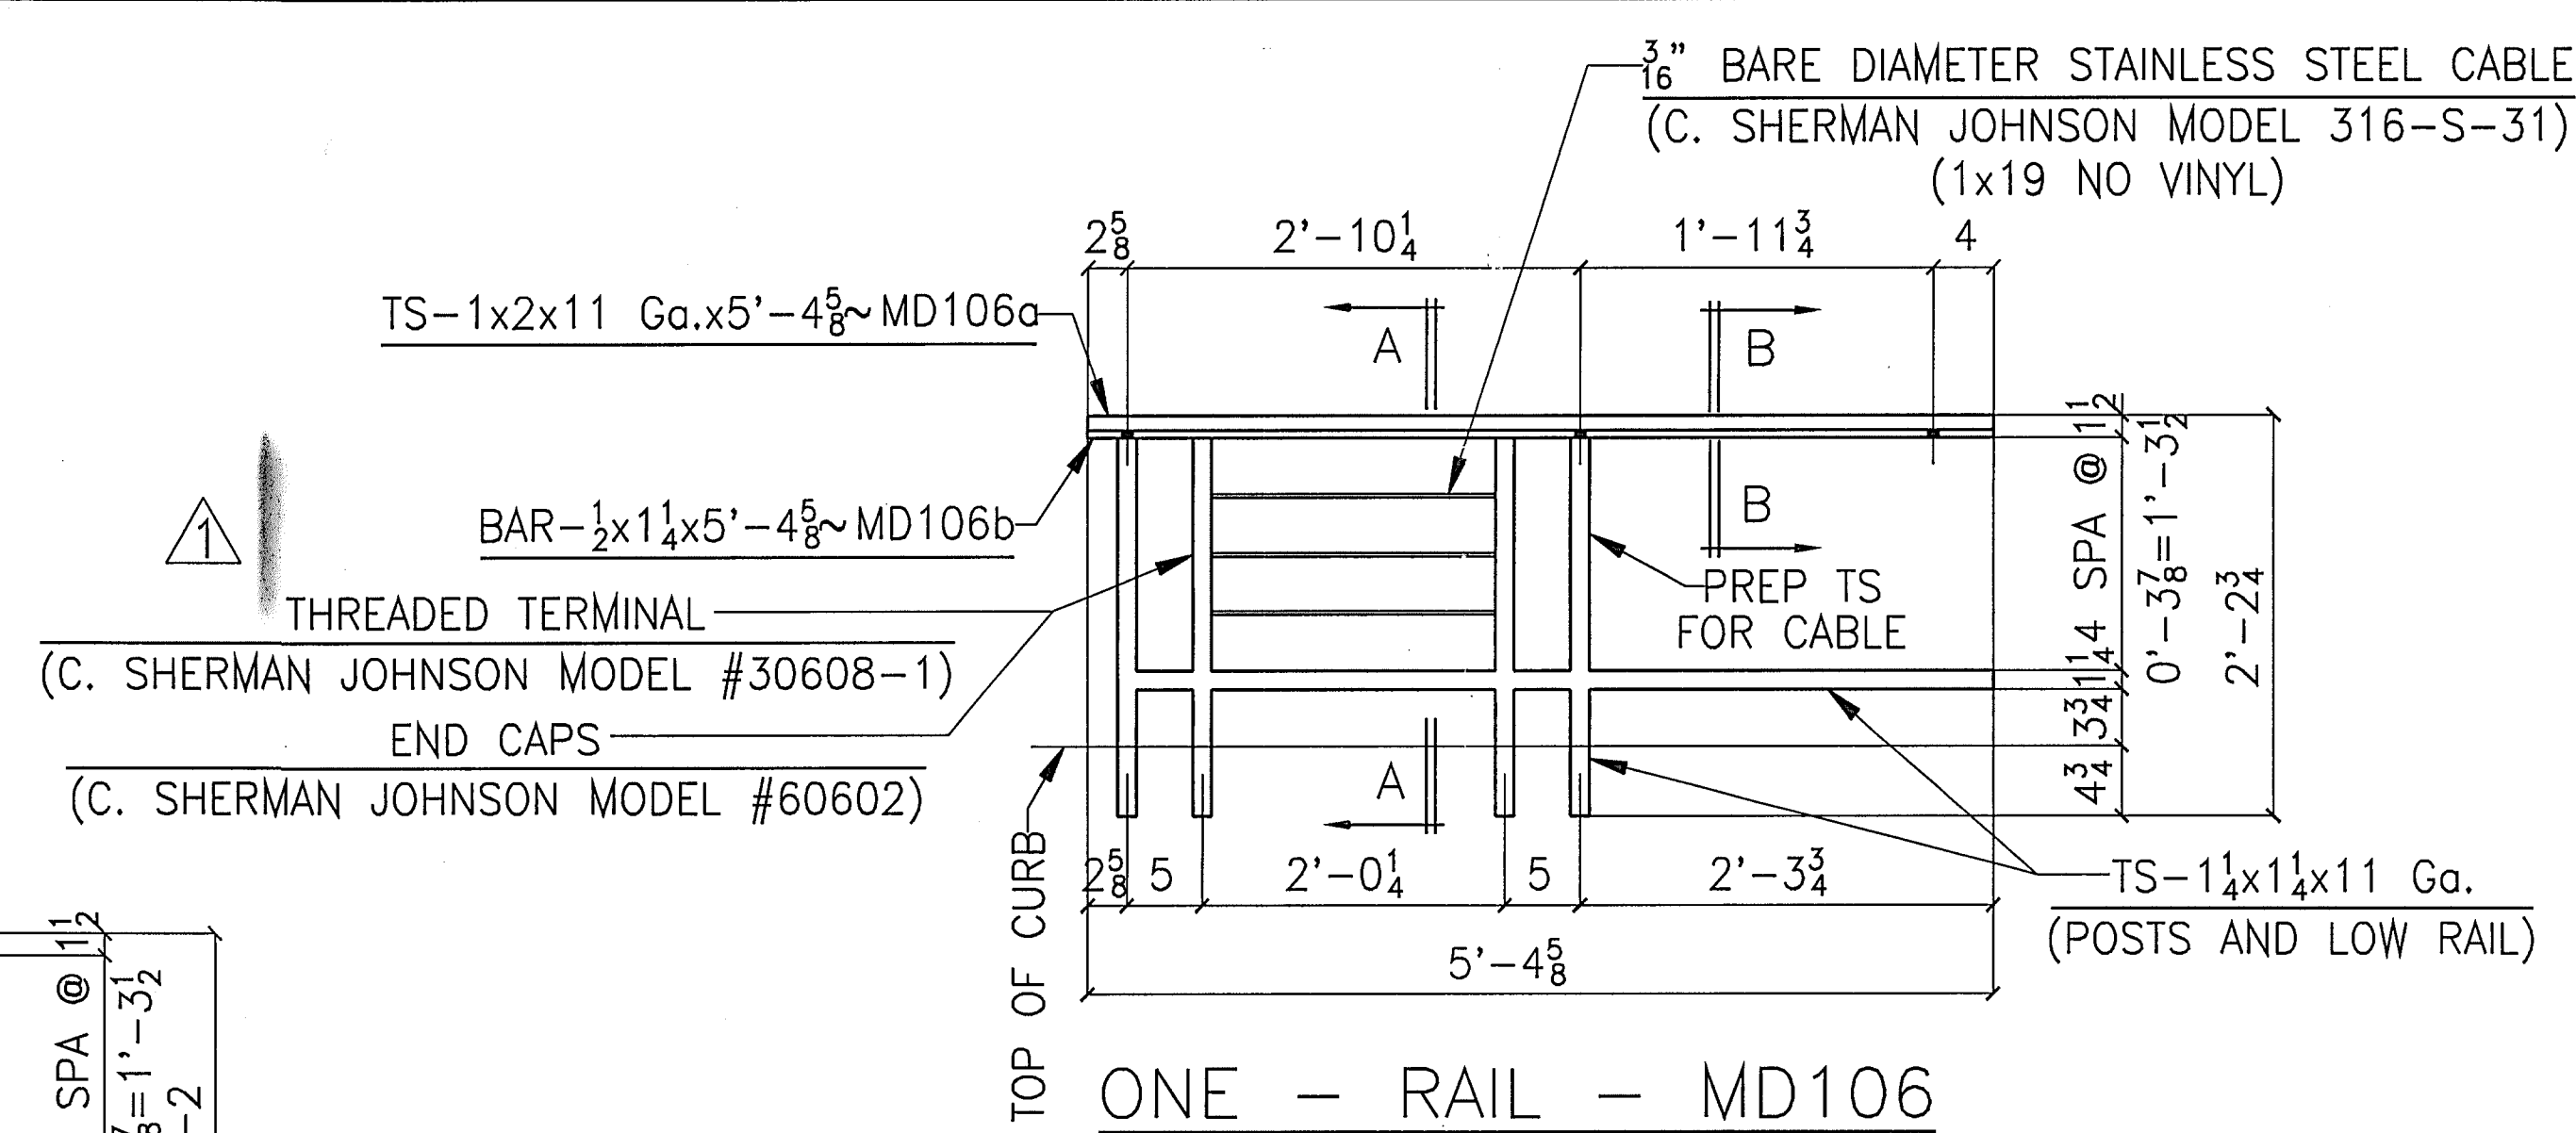


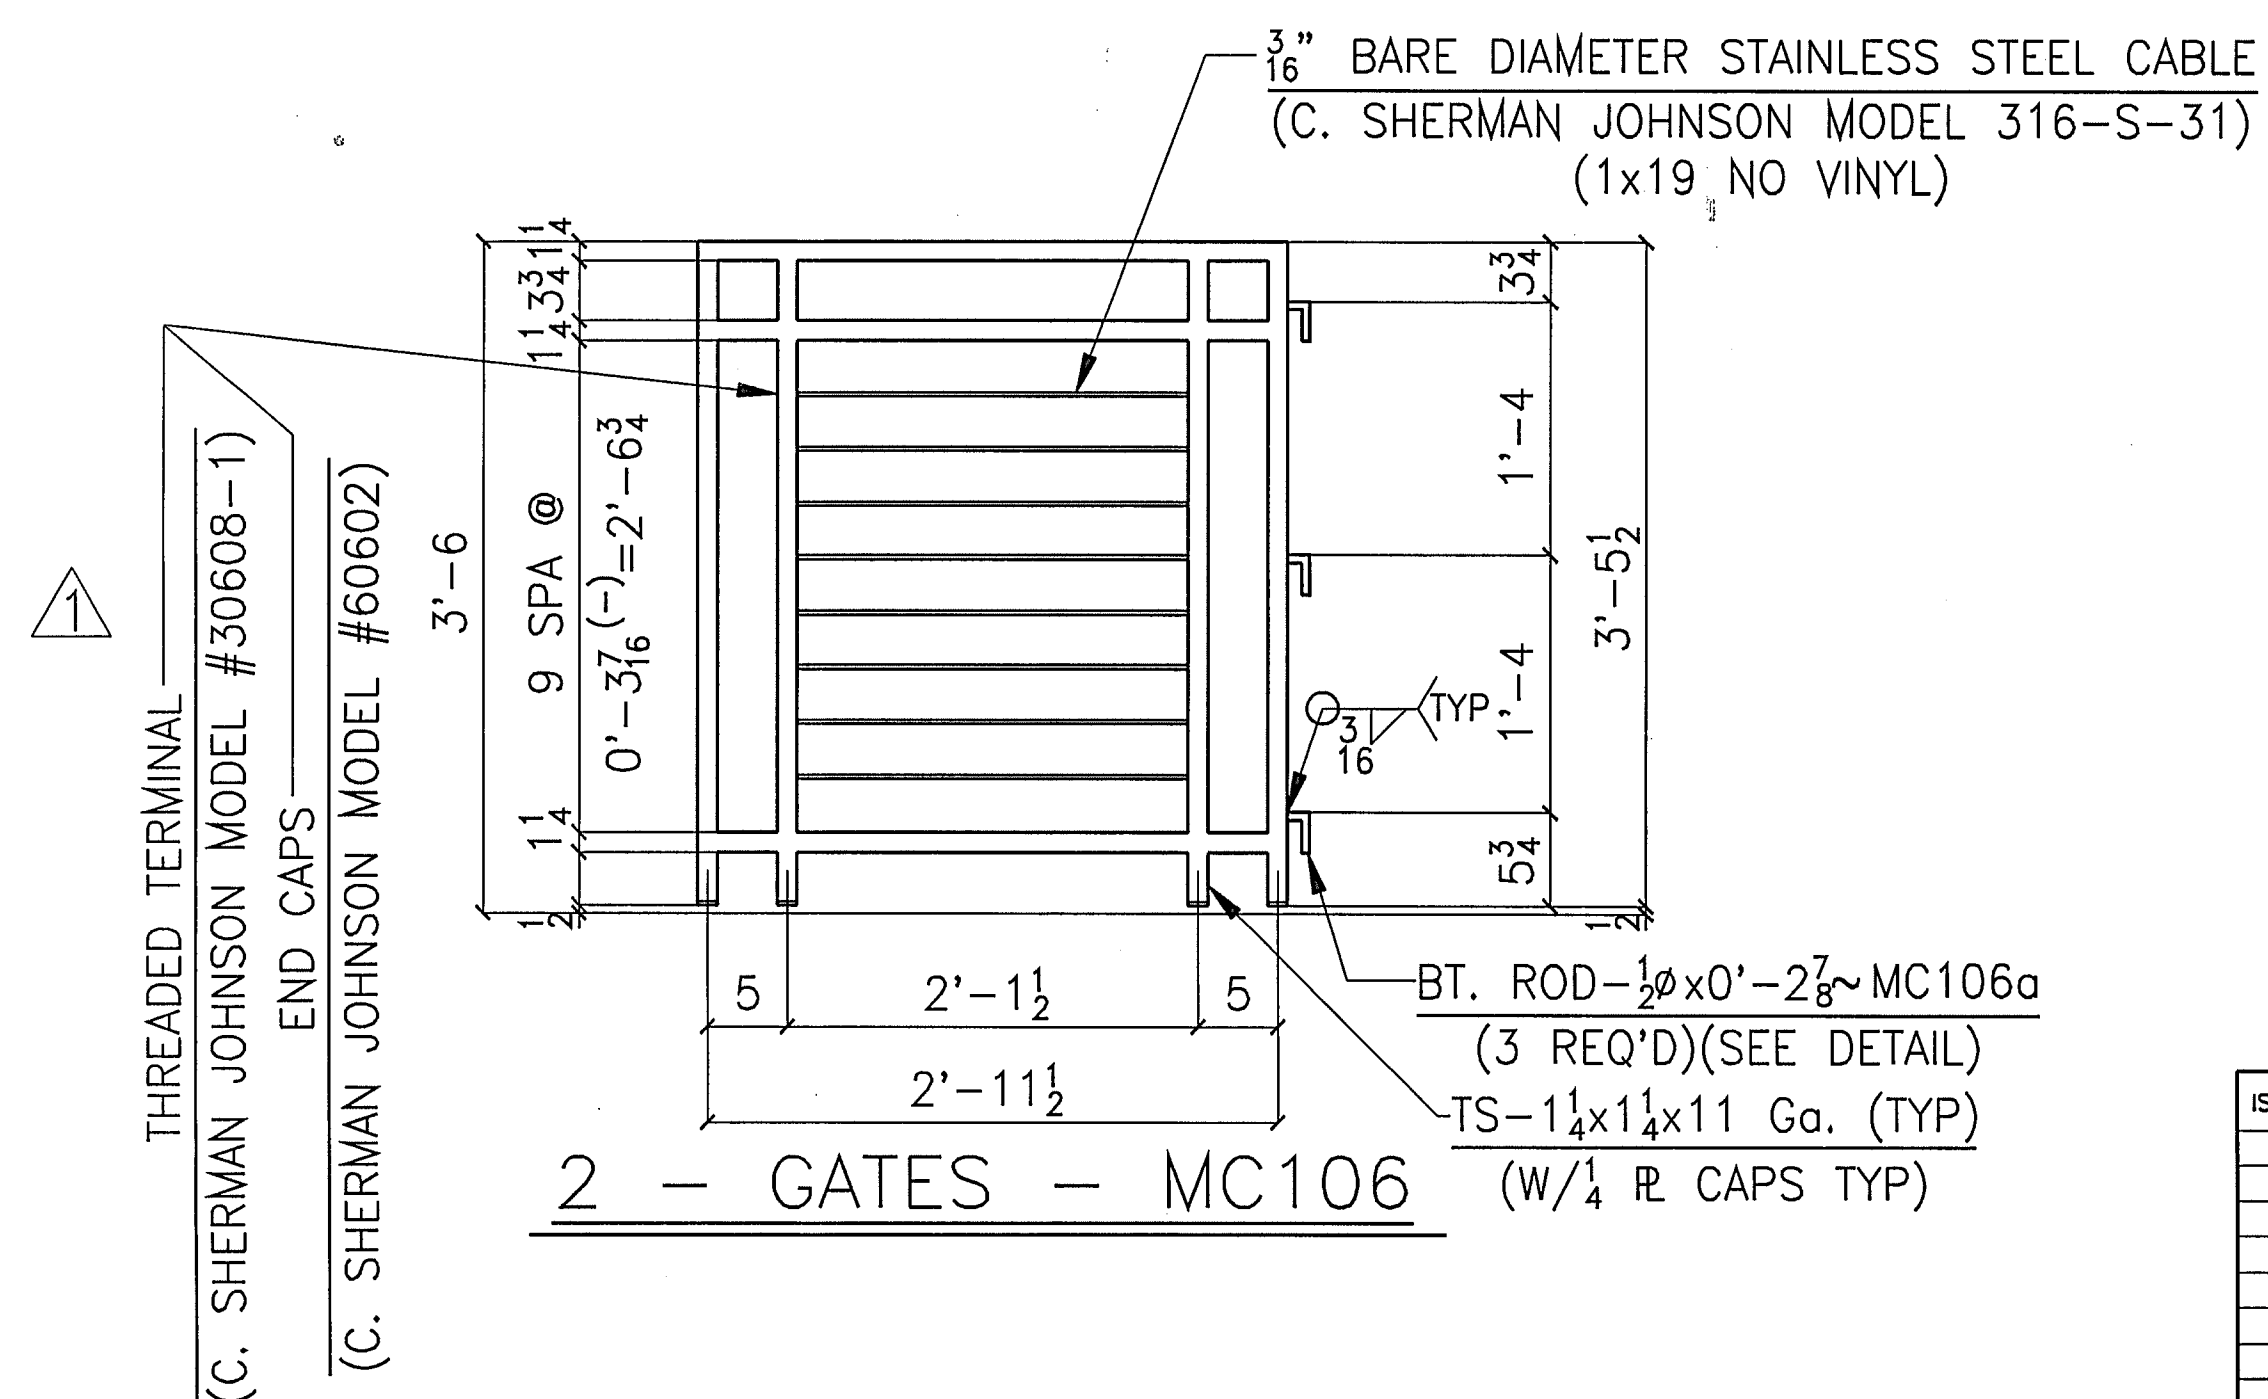



SECTION - "A~A"

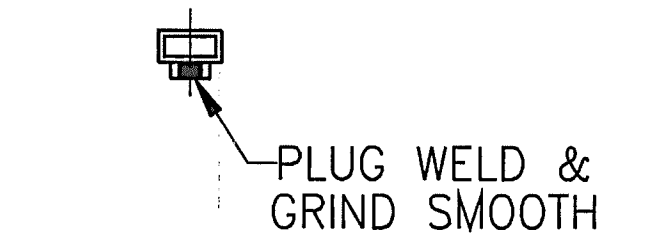

SECTION - "B~ B"

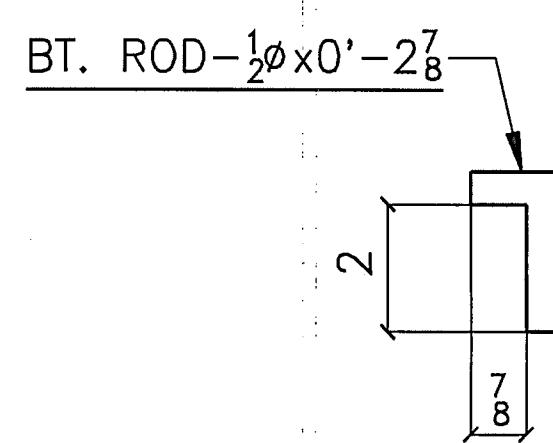

DETAIL BT. ROD~MC106a

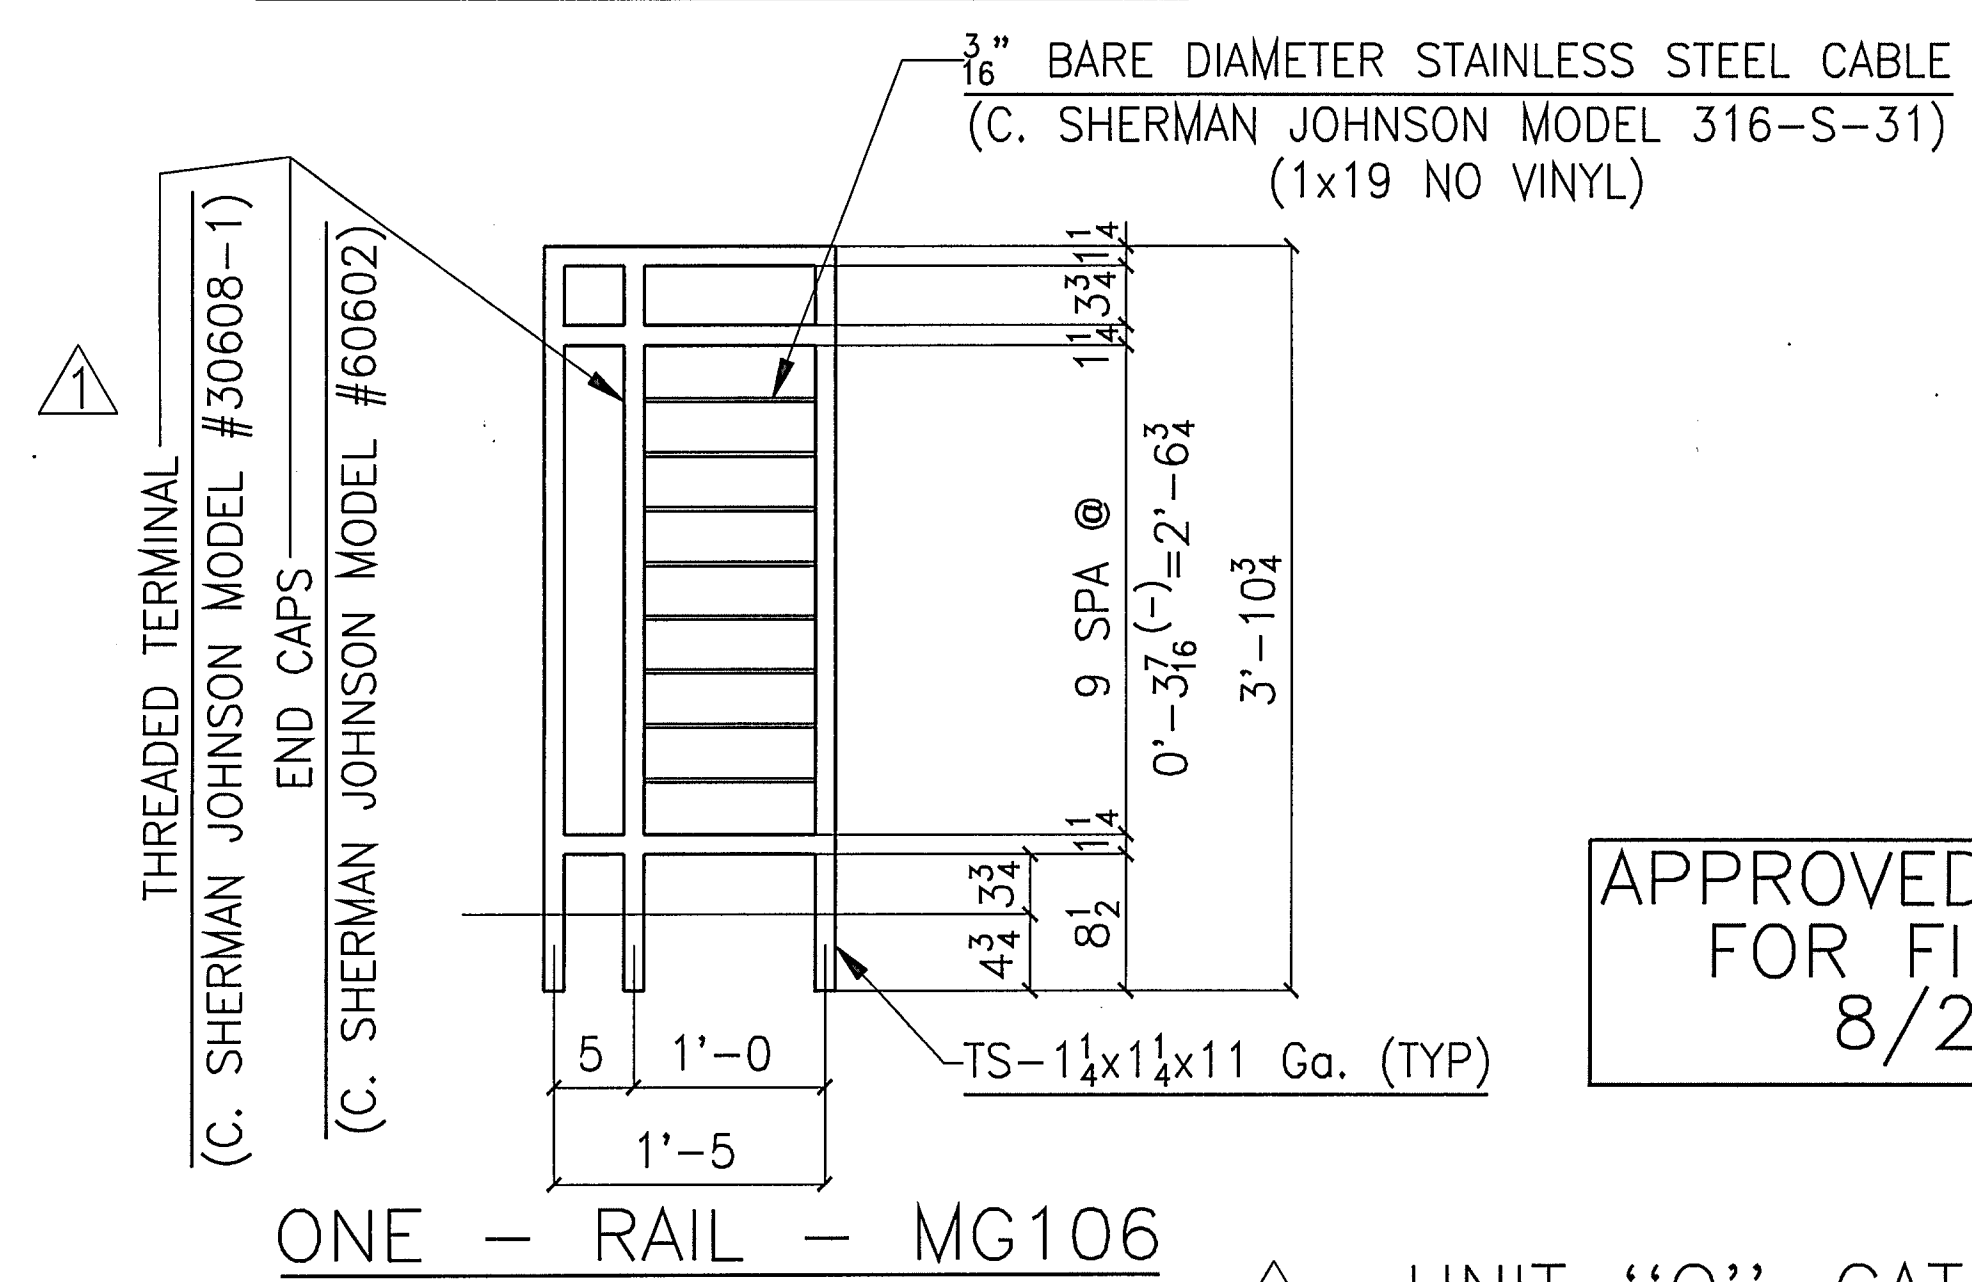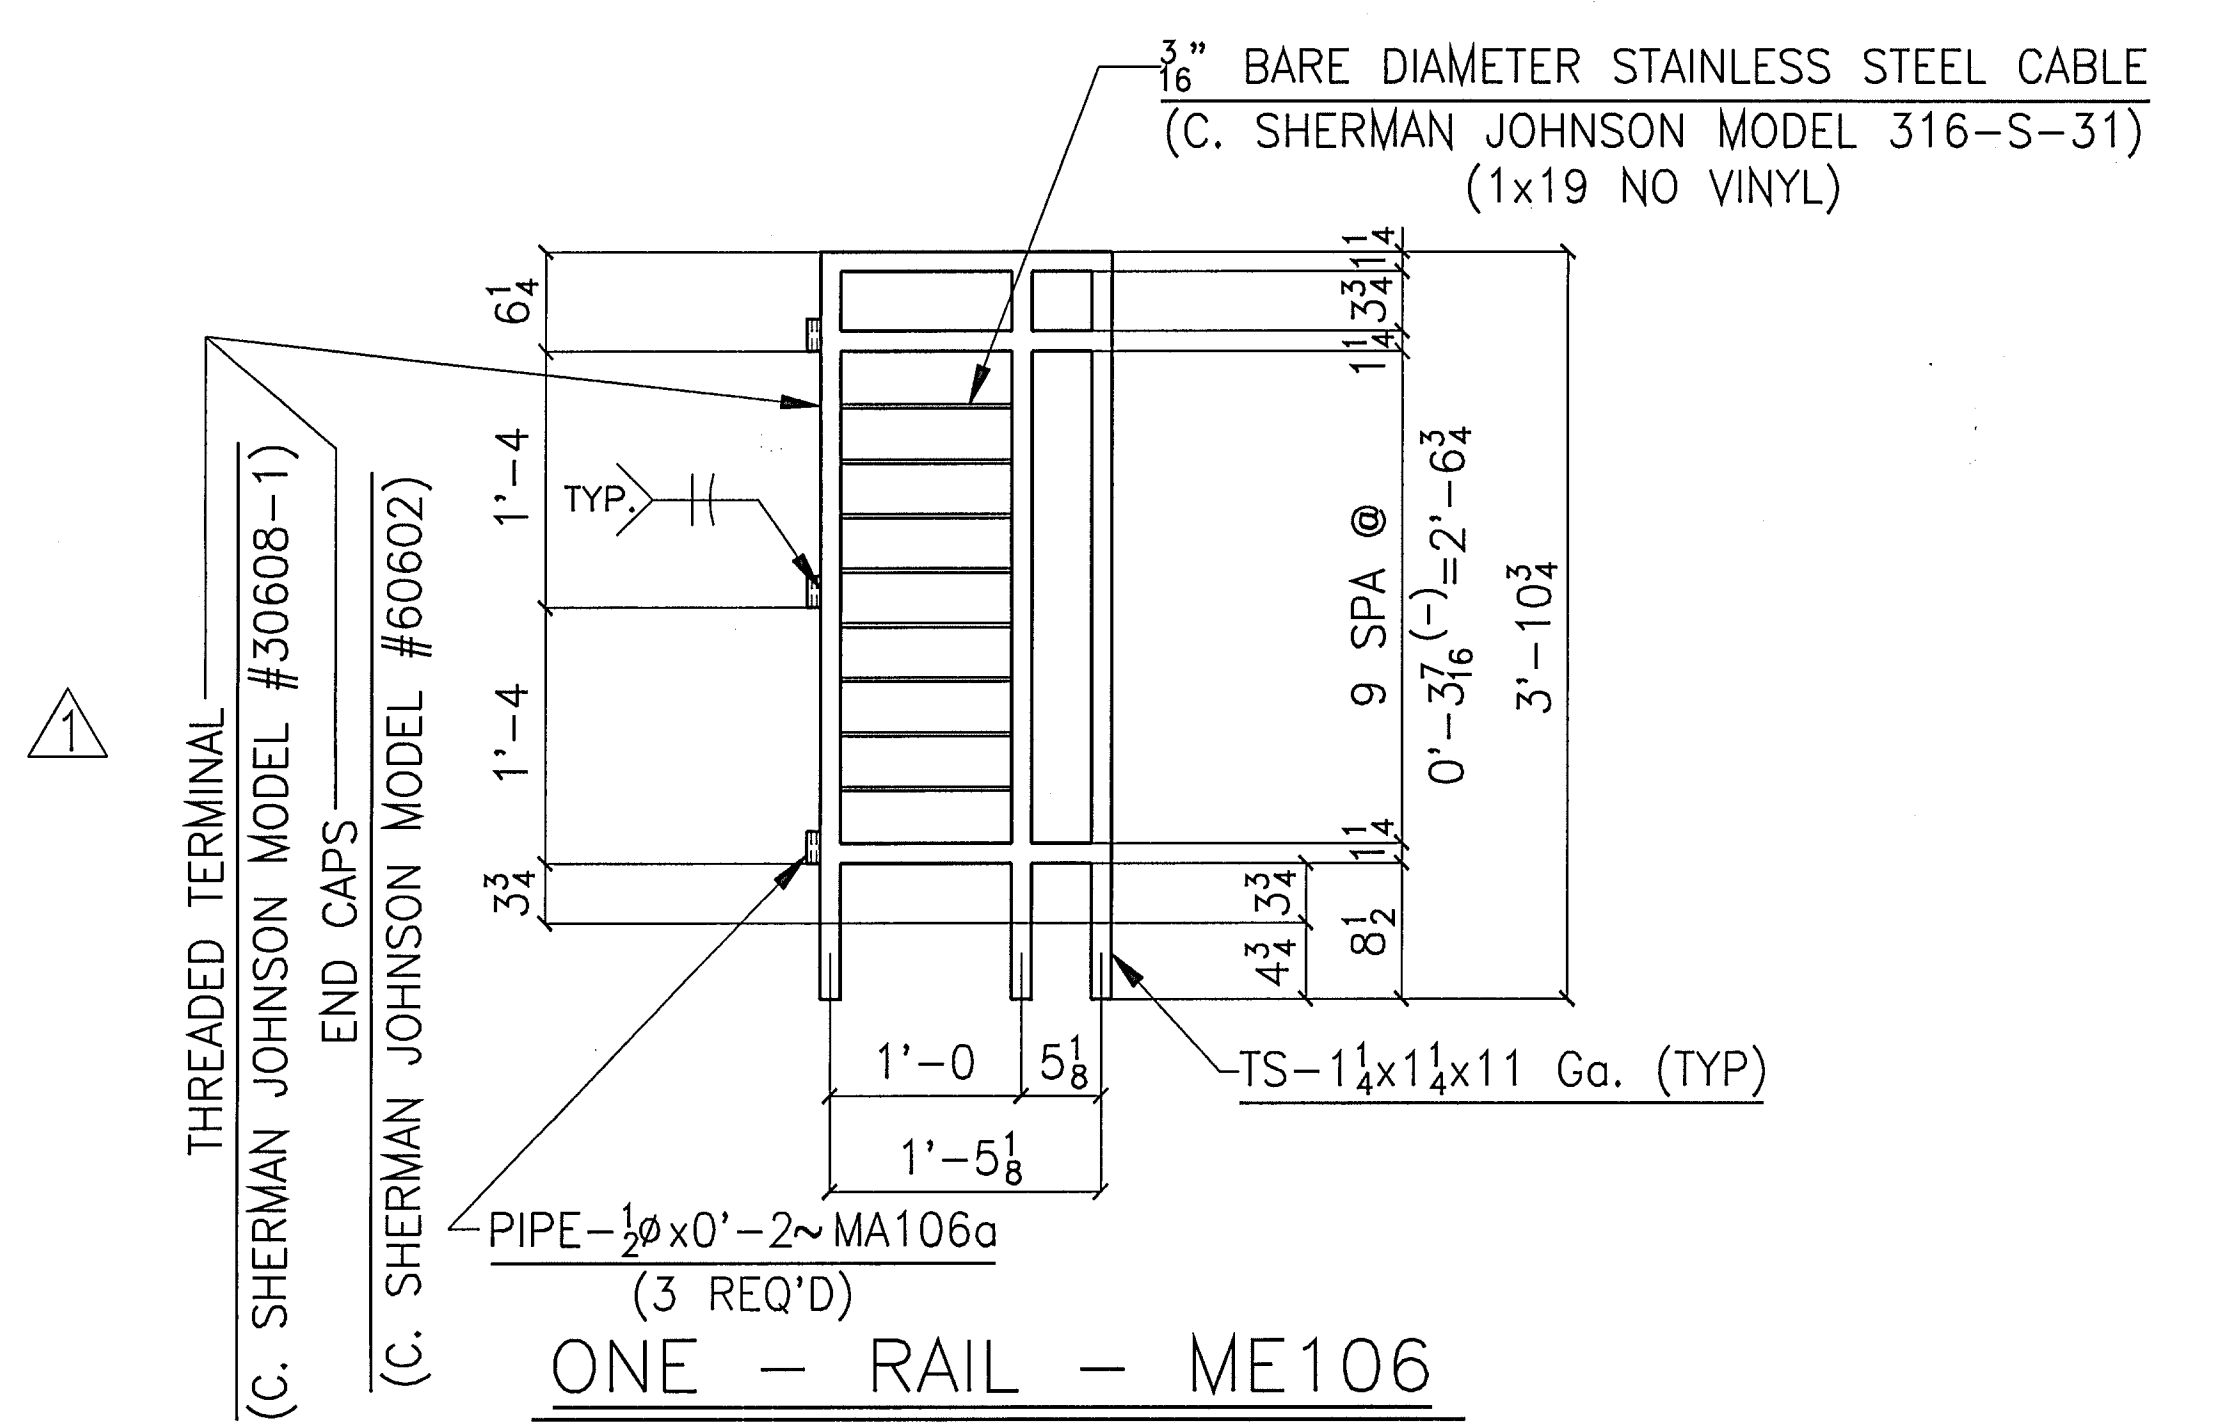

APPROVED DRAWINGS
FOR FIELD USE
8/28/00

PRODUCT NOTE:

ALL CABLE ASSEMBLIES PROVIDED BY
BOATERS WORLD CHICAGO YACHTING
PHONE-(773) 227-7900-FAX (773) 227-8655

SHOP NOTE #1:

HOLES @ CABLES TO BE	$\frac{5}{16}\phi$
HOLES @ $\frac{1}{2}$ " BARS TO BE	$\frac{13}{16}\phi$

ISSUE	#BP	FOR	DATE	BY	ISSUE	#BP	FOR	DATE	BY							ASTM MATERIAL SPECIFICATIONS: PIPES-- A53 W SHAPES-- A36 TUBES-- A500 GR.B WT SHAPES-- A36 ANGLES-- A36 M SHAPES-- A36 PLATES-- A36 S SHAPES-- A36 BOLTS-- A325 C SHAPES-- A36 HEADED STUDS-- A108	 INTERSTATE WELDING & FABRICATION, INC. 1670 E. DAVIS DRIVE • TERRE HAUTE, INDIANA 47802	DWN. BY KG	
					9	6B	FIELD	8/16/00	KG									CHESTERTON HIGH SCHOOL DUNELAND SCHOOL CORPORATION CHESTERTON, INDIANA	CHK'D BY
					8	2B	FAB	8/15/00	TE										JOB #
					7	1B	FIELD	8/15/00	KG										7601
					6	6B	FIELD	6/22/00	KG	Δ	8/28/00	REVISED PAINT AND CLEANING	KG						SHT. #
					5	2B	FAB	6/21/00	TE	Δ		REVISED CABLE ASSEMBLIES						M106	
					4	1B	FIELD	6/21/00	KG		6/21/00	ADDED FIELD MEASURES							
12	6B	FIELD	8/28/00	KG	3	6B/1V	APP	9/15/99	KG		9/15/99	APPROVAL CHANGES MADE	KG			AWS WELDING SPECIFICATION: CATEGORY I ---E70XX CATEGORY II ---E70XX(LH)			
11	2B	FAB	8/28/00	TE	2	1B	CHEK	7/22/99	KG		DATE	DESCRIPTION	MADE			REF. DWG'S. ME38			
10	1B	FILE	8/28/00	KG		6B/1V	APP	7/21/99	KG	REV.									