


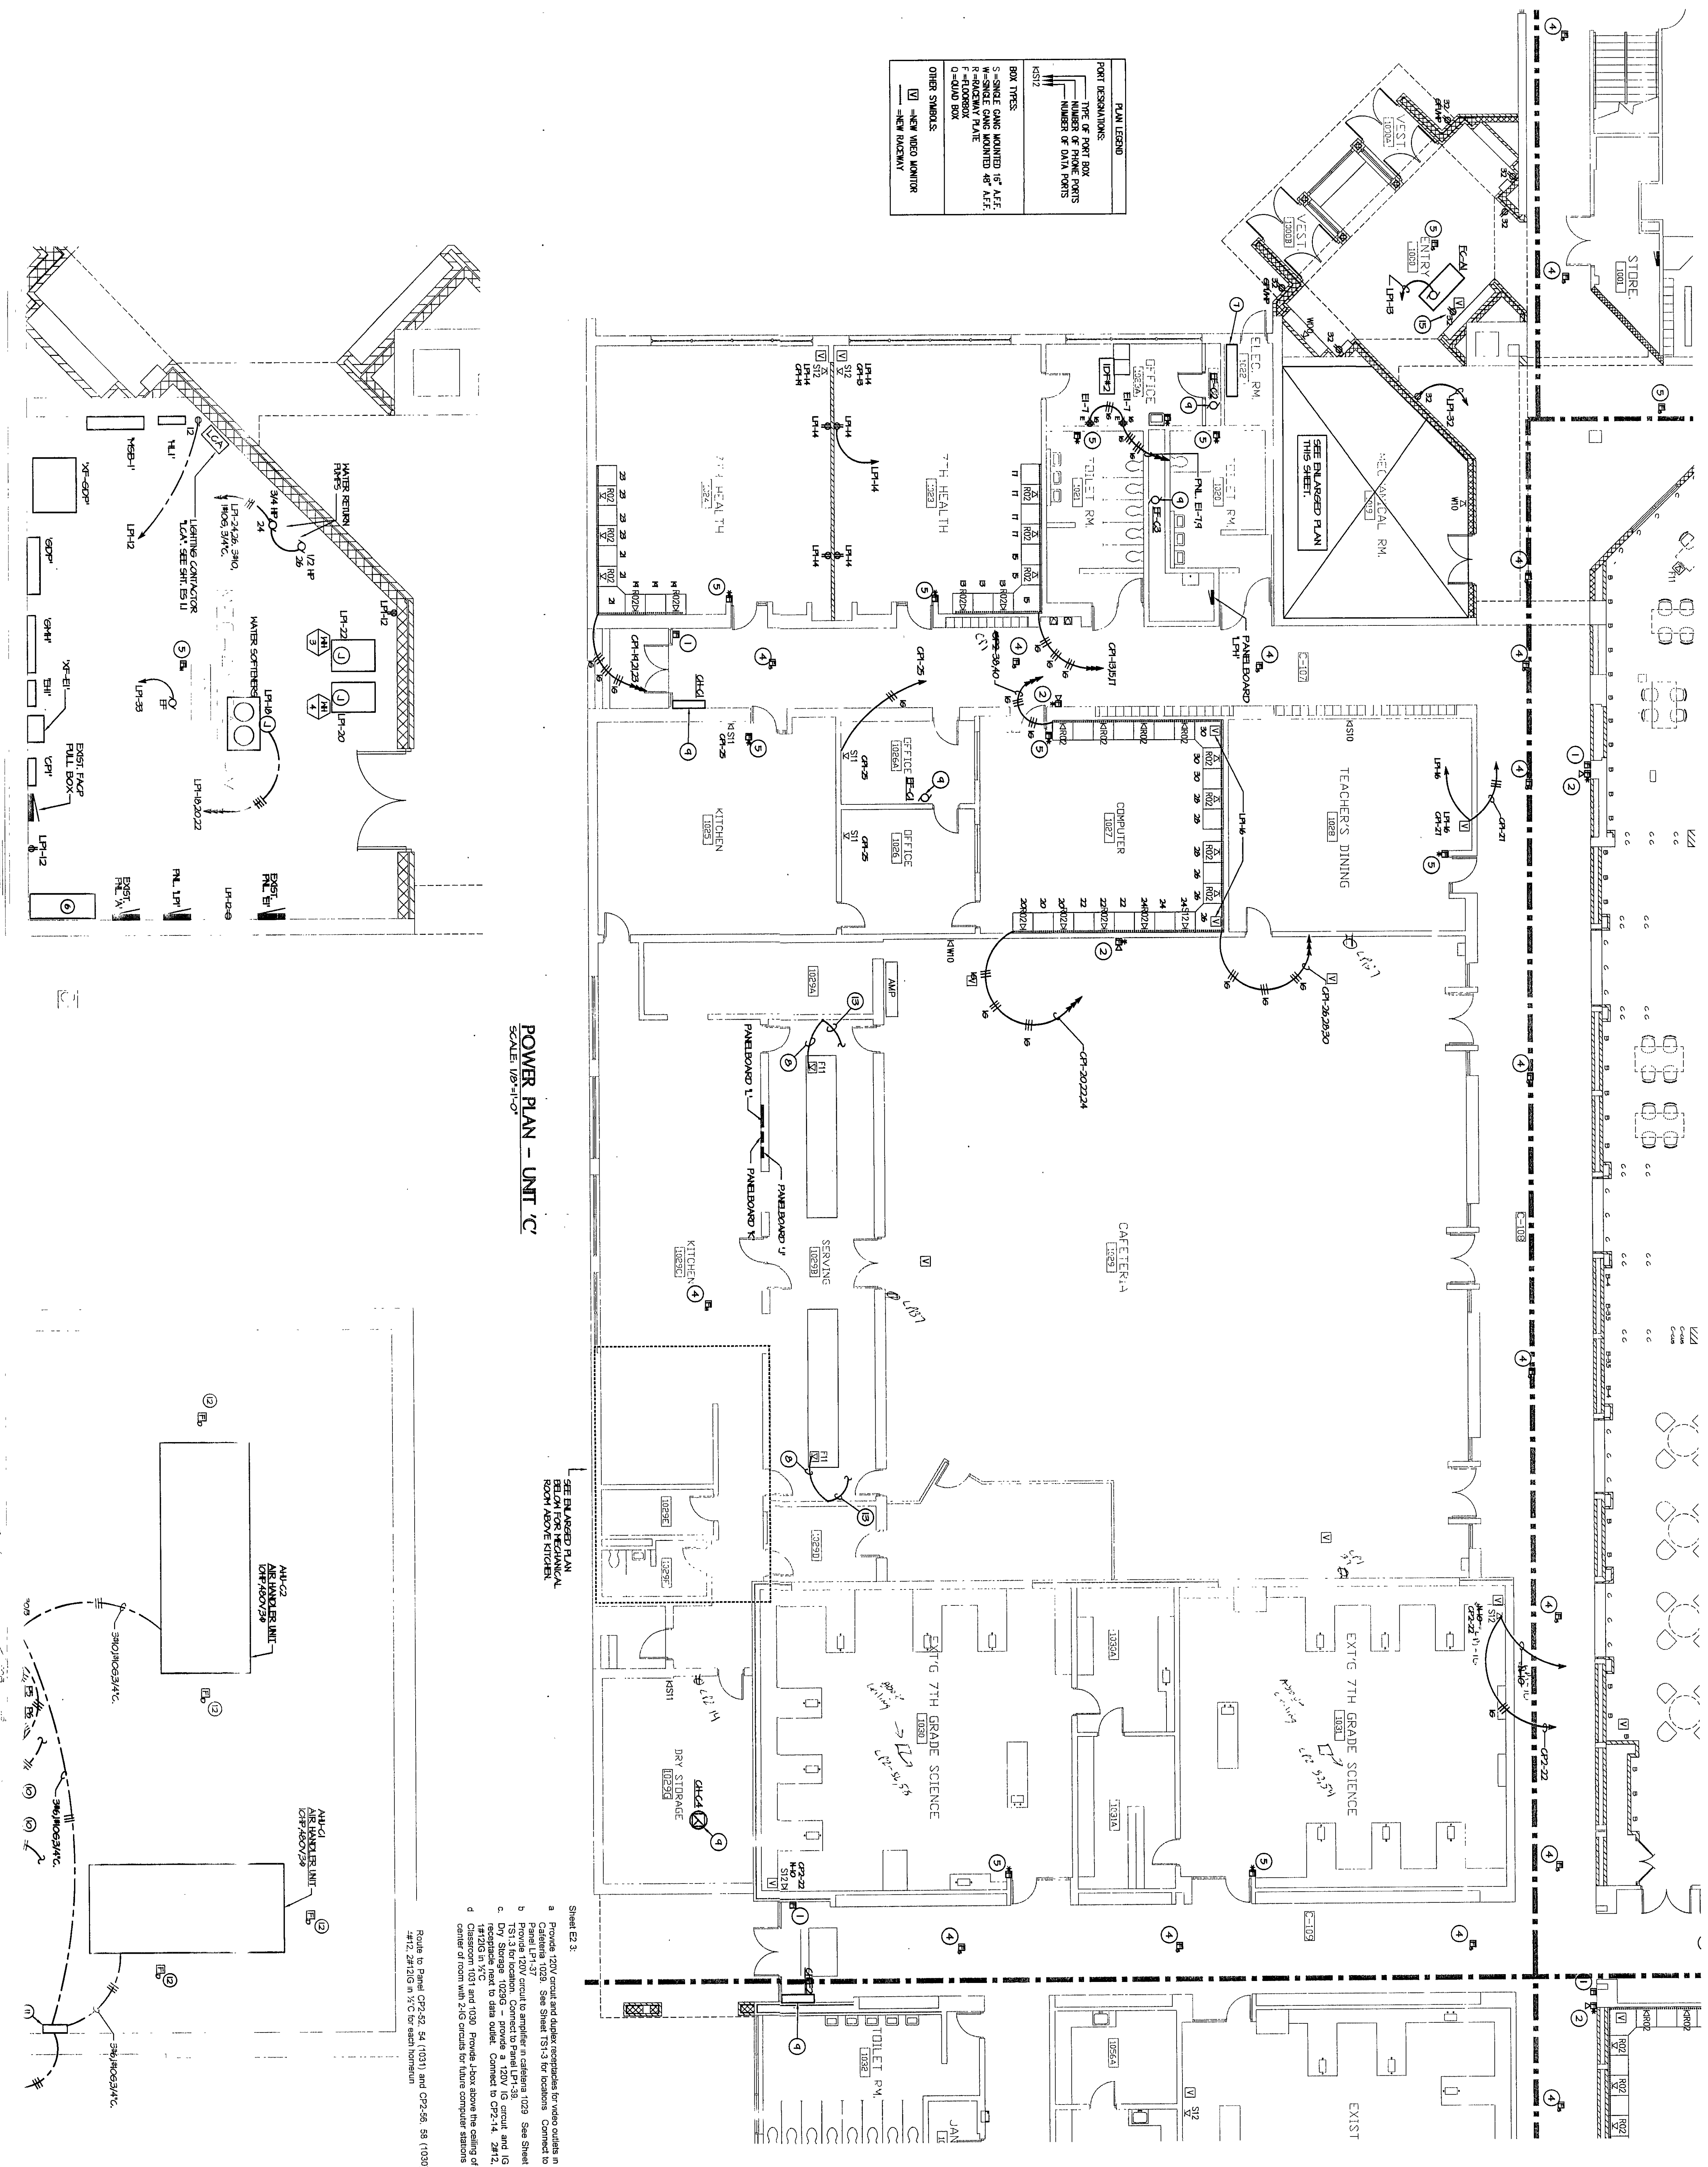


GENERAL ELECTRICAL NOTES

- A. FOR TYPICAL COMPUTER CIRCUITS AND LAYOUT REQUIRED IN CLASSROOMS, OFFICES, LABS, ETC. SEE TYPICAL LAYOUT ELEVATIONS ON SH. E 81. COORDINATE INSTALLATION OF ALL SURFACE MOUNTED RACEWAY WITH DN.-17.


NOTES:

- 9 RECONNECT. NEW MECHANICAL EQUIPMENT TO EXISTING CIRCUIT.
- 10 300X300X9/16 DISCONNECT FOR COOLERS AND FREEZER AS REQUIRED.
- 13 3/4"X6 SHUTTERED OUT TO ABOVE CEILING.
- 14 NOT USED.
- 15 VERIFY EXIST LOCATIONS PRIOR TO REMOVAL.

WIRING SIZING FOR VOLTAGE DROP (20A, 120V, CIRCUITS)	
340'	#10 AWG
375'	#8 AWG
3275'	#6 AWG

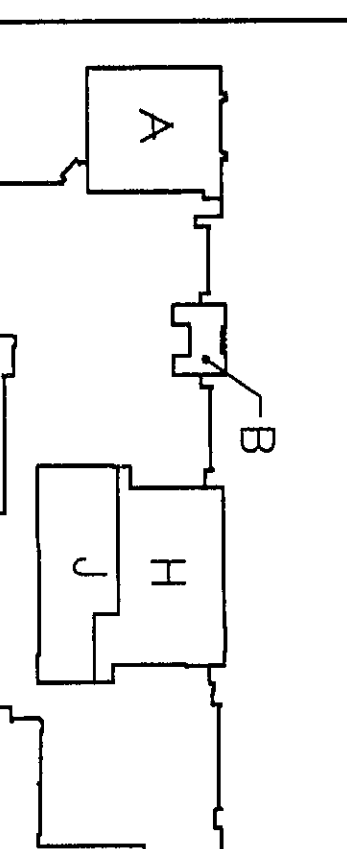

UPPER LEVEL KEY PLAN

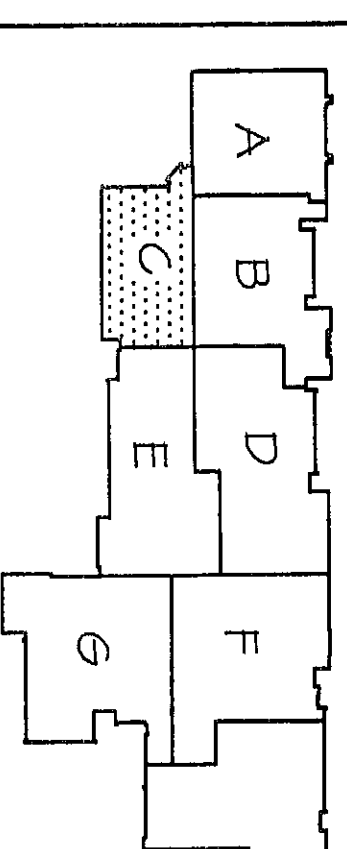

LOWER LEVEL KEY PLAN


NORTH
SCALE: 1/8" = 1'-0"

ARCHITECTS
ENGINEERS
PLANNERS

VEAZEY
PARROTT
&
DURKIN
SHOULDERS

RENOVATION PROJECT FOR:
CHESTERTON, INDIANA

Drawing Title

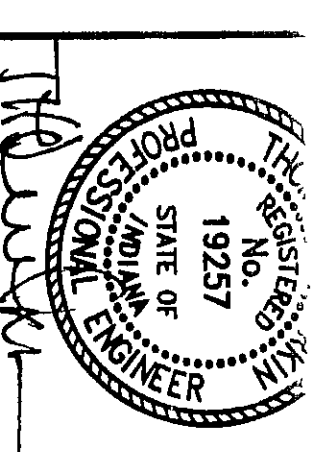

Drawn By:	BMH
Approved By:	TLM
Drawing No:	E 2.3