



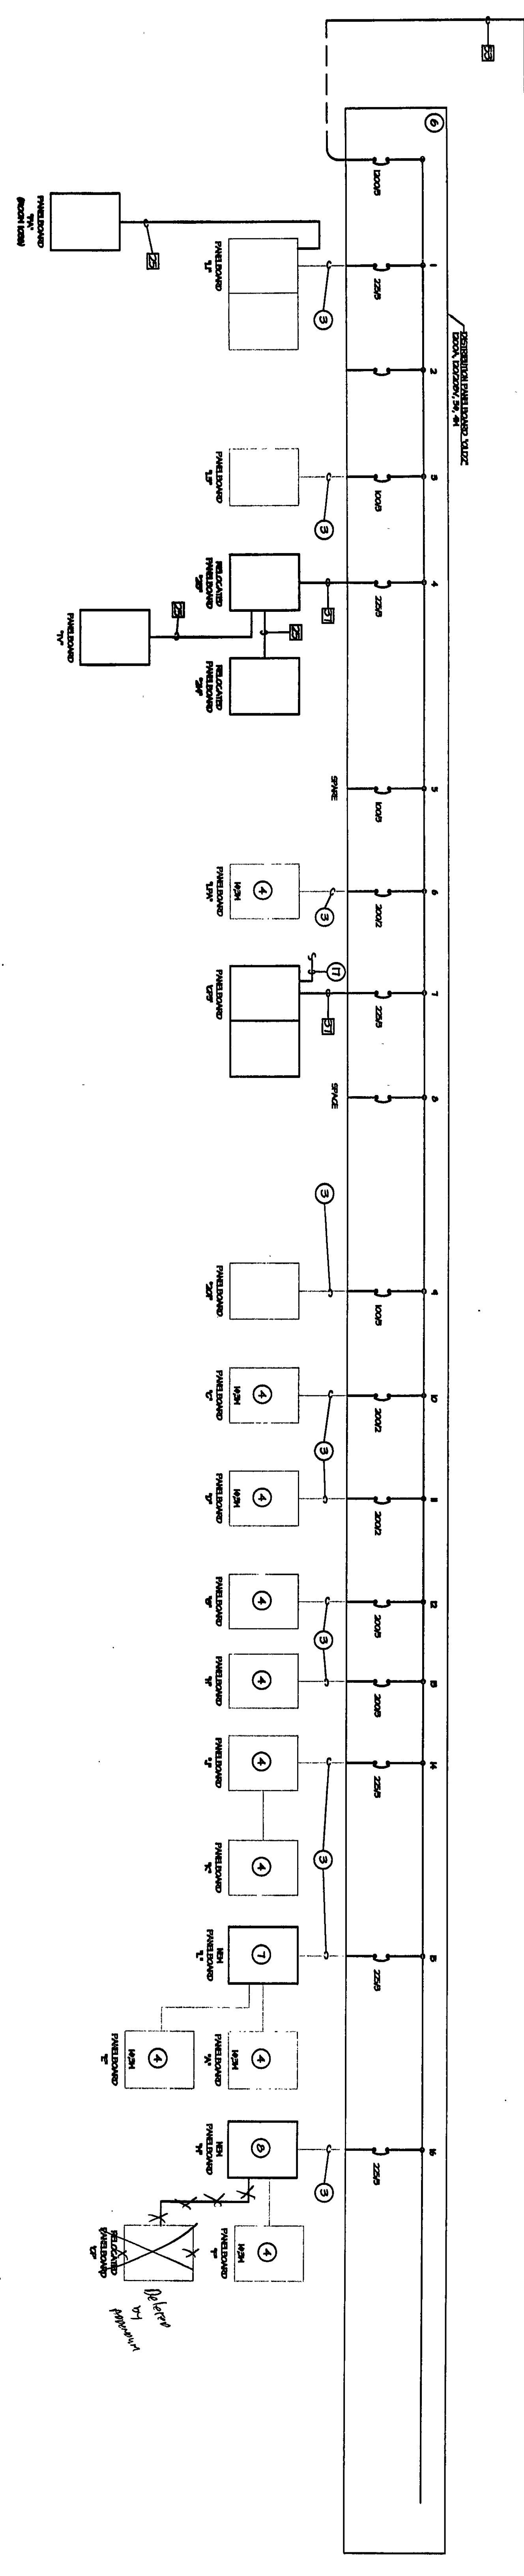







[illegible][illegible]

We ENDED up
Rebuilding from 17"
as per the archiver
and the school on the
Allowance floor (Aug-2001)


[illegible]

GENERAL ELECTRICAL NOTES:

A. COORDINATE MAIN LINE LOCATION IN ALL NEW PANELS AND NEW PANEL WIRINGS PRIOR TO INSTALLATION AND CONNECTION TO EXISTING FEEDER CONDUCTORS. VERIFY TOP OR BOTTOM FEED.

NOTES:

- 1 PROVIDE ISOLATED GROUND BUS.
- 2 PROVIDE NEAR CONDUCTIONS IN EXISTING CONDUIT.
- 11 SEE CONDUCTION LUGS DETAIL ON SHEET B.0.
- 12 RECONNECT TO EXISTING 2000 BUS DUCT, PROVIDE NEW CARGAL REBARERS, AND PAVEL COVER CONDUIT, TO EXISTING FEEDER.
- 13 TALL BOX #1 LOCATED IN MECHANICAL ROOM 102Z.
- 14 TALL BOX #2 LOCATED IN MECHANICAL ROOM 101A.
- 15 NEW ISOLATED GROUND FOR ISOLATED GROUND BUS IN 102C, TO GROUND BUS OF NEW.
- 16 NEW ISOLATED GROUND FOR ISOLATED GROUND BUS IN 101A, TO GROUND BUS OF NEW.
- 17 NEW ISOLATED GROUND FOR ISOLATED GROUND BUS IN 102C, TO GROUND BUS OF NEW.

**VEAZEY
PARROT
DURKIN
&
SHOULDERS**

**ARCHITECT
ENGINEERS
PLANNERS**

155 Park Street
Rm. 400
Beverly, MA 01923

**RENOVATION PROJECT FOR:
DUNELAND SCHOOL CORP.
CHESTERTON HIGH SCHOOL/MIDDLE SCHOOL
CHESTERTON, INDIANA**

ELECTRICAL RISER DIAGRAM



Project No:	9480.00
Project Date:	JUNE 2000
Drawn By:	BY:HM
Approved By:	TLM
Drawing No:	E 6.0