


① PROVIDE ISOLATION VALVES AT ALL NEW BRANCH MAINS AND OTHER LOCATIONS AS SHOWN.

- Sheet M1.0 - See attached sketch SK-M32 for further detail.

NOTE: TUNEL PIPING MAY CONTAIN ASBESTOS. OWNER SHALL BE RESPONSIBLE FOR ALL ASBESTOS ABATEMENT. SECT. 1503 SHALL COORDINATE ALL WORK. SECT. 1502 SHALL INSULATE NEW PIPING ONLY, INCLUDING NEW EXPANSION JOINTS.

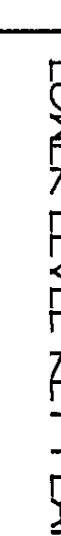

ARCHITECT
ENGINEERS
PLANNERS



VEAZEY
PARROTT
DURKIN &
SHOULDERS


RENOVATION PROJECT FOR:
DUNEAND SCHOOL CORP.
CHESTERTON HIGH SCHOOL/MIDDLE SCHOOL
CHESTERTON, INDIANA

DEMOITION & NEW WORK	Project No. 9480.00
	Project Date: JUNE 200 Drawn By: Approved By: Issuing No.
1	M 10

[illegible]

MECHANICAL TUNNEL PLASMA
SCALE: 1/6" = 1'-0"

2000-24-06