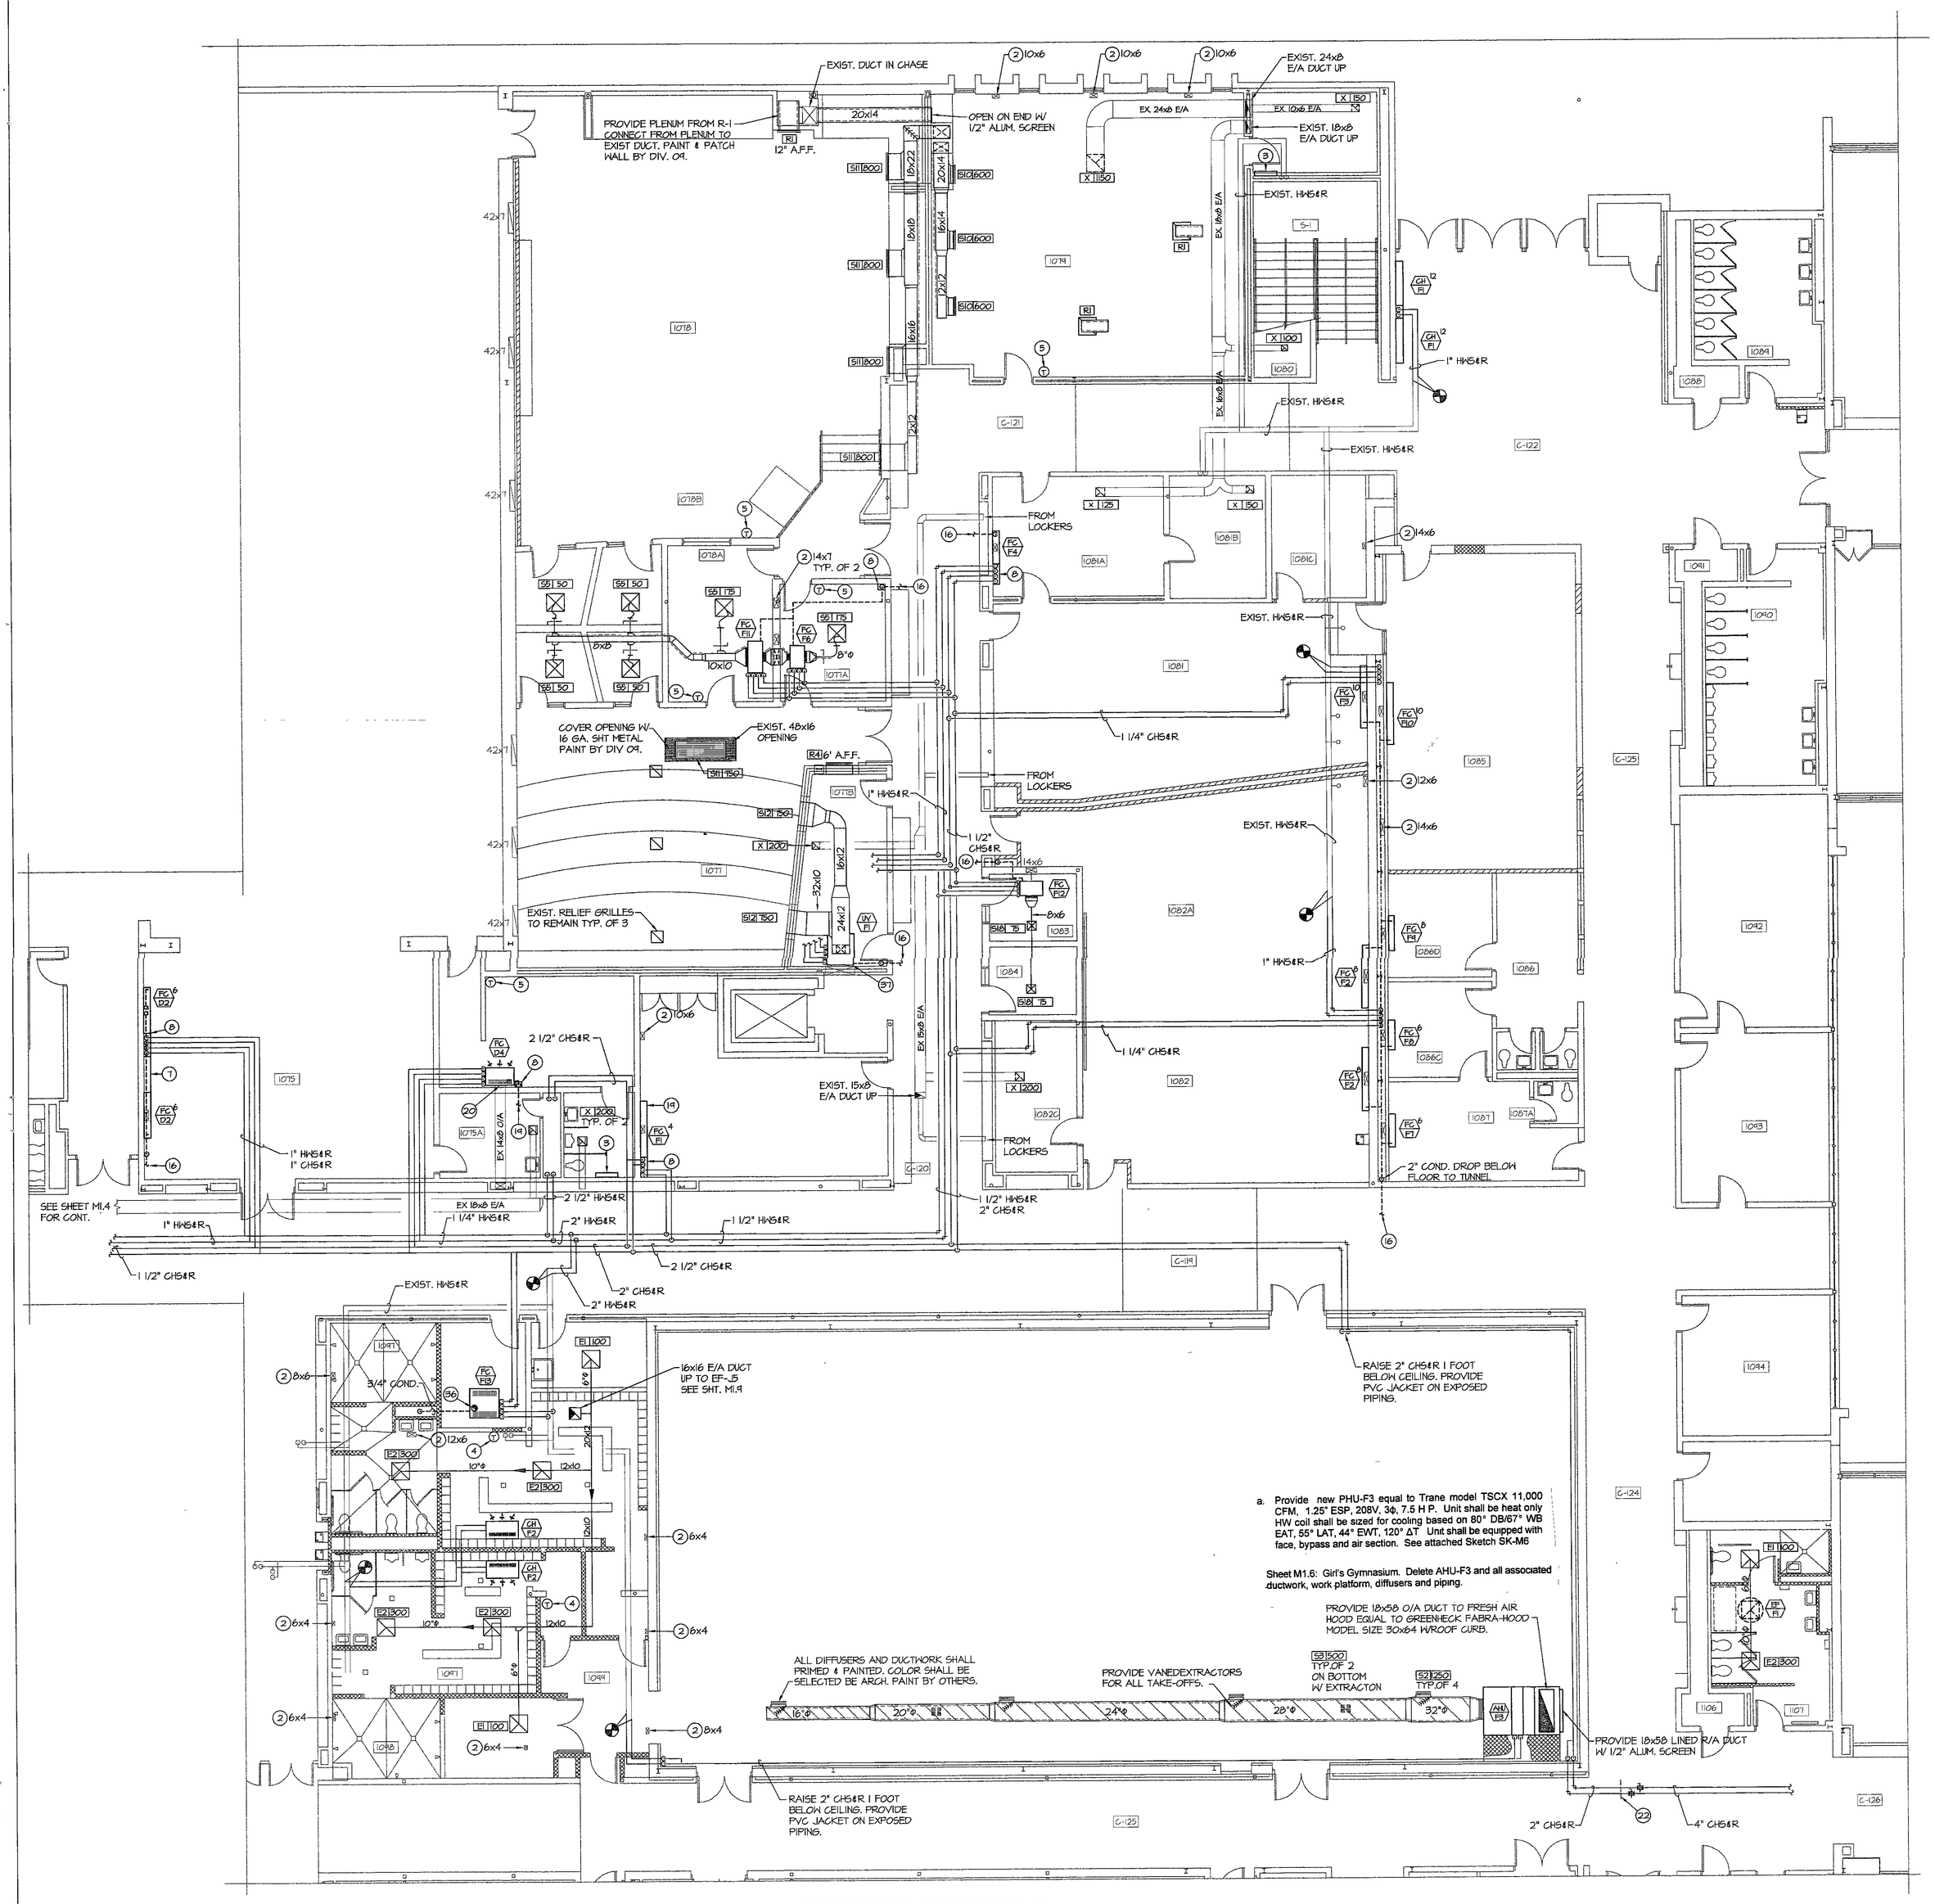
EXIST. DUCT IN CHASE
PROVIDE PLENUM FROM R-1 CONNECT FROM PLENUM TO EXIST DUCT. PAINT & PATCH WALL BY DIV. 09.
20x14
12" A.F.F.
OPEN ON END W/ 1/2" ALUM. SCREEN
EXIST. 24x8 E/A DUCT UP
EX 24x8 E/A
EX 10x6 E/A
EXIST. 18x8 E/A DUCT UP
EXIST. HWS&R
EX 16x8 E/A
EX 16x16 E/A
EX 18x8 E/A
EX 15x6 E/A DUCT UP
EX 16x8 O/A
EX 16x6 E/A
1" HWS&R
EXIST. HWS&R
FROM LOCKERS
1 1/4" CHS&R
1" HWS&R
1 1/2" CHS&R
EXIST. RELIEF GRILLES TO REMAIN TYP. OF 3
COVER OPENING W/ 16 GA. SHT METAL PAINT BY DIV 09.
EXIST. 48x16 OPENING
16" A.F.F.
2 1/2" CHS&R
1" HWS&R
1" CHS&R
2 1/2" HWS&R
1/4" HWS&R
2" HWS&R
1 1/2" HWS&R
2 1/2" CHS&R
1 1/2" CHS&R
2" CHS&R
2" HWS&R
EXIST. HWS&R
3/4" COND.
16x16 E/A DUCT UP TO EF-15 SEE SHT. M1.4
RAISE 2" CHS&R 1 FOOT BELOW CEILING. PROVIDE PVC JACKET ON EXPOSED PIPING.
2" COND. DROP BELOW FLOOR TO TUNNEL
1/2" HWS&R
2" CHS&R
PROVIDE 18x58 LINED R/A DUCT W/ 1/2" ALUM. SCREEN
2" CHS&R
4" CHS&R
ALL DIFFUSERS AND DUCTWORK SHALL PRIMED & PAINTED. COLOR SHALL BE SELECTED BE ARCH. PAINT BY OTHERS.
PROVIDE VANEDEXTRACTORS FOR ALL TAKE-OFFS.
16'-0"
20'-0"
24'-0"
28'-0"
32'-0"
RAISE 2" CHS&R 1 FOOT BELOW CEILING. PROVIDE PVC JACKET ON EXPOSED PIPING.
SEE SHEET M1.4 FOR CONT.
1" HWS&R
1 1/2" CHS&R
