

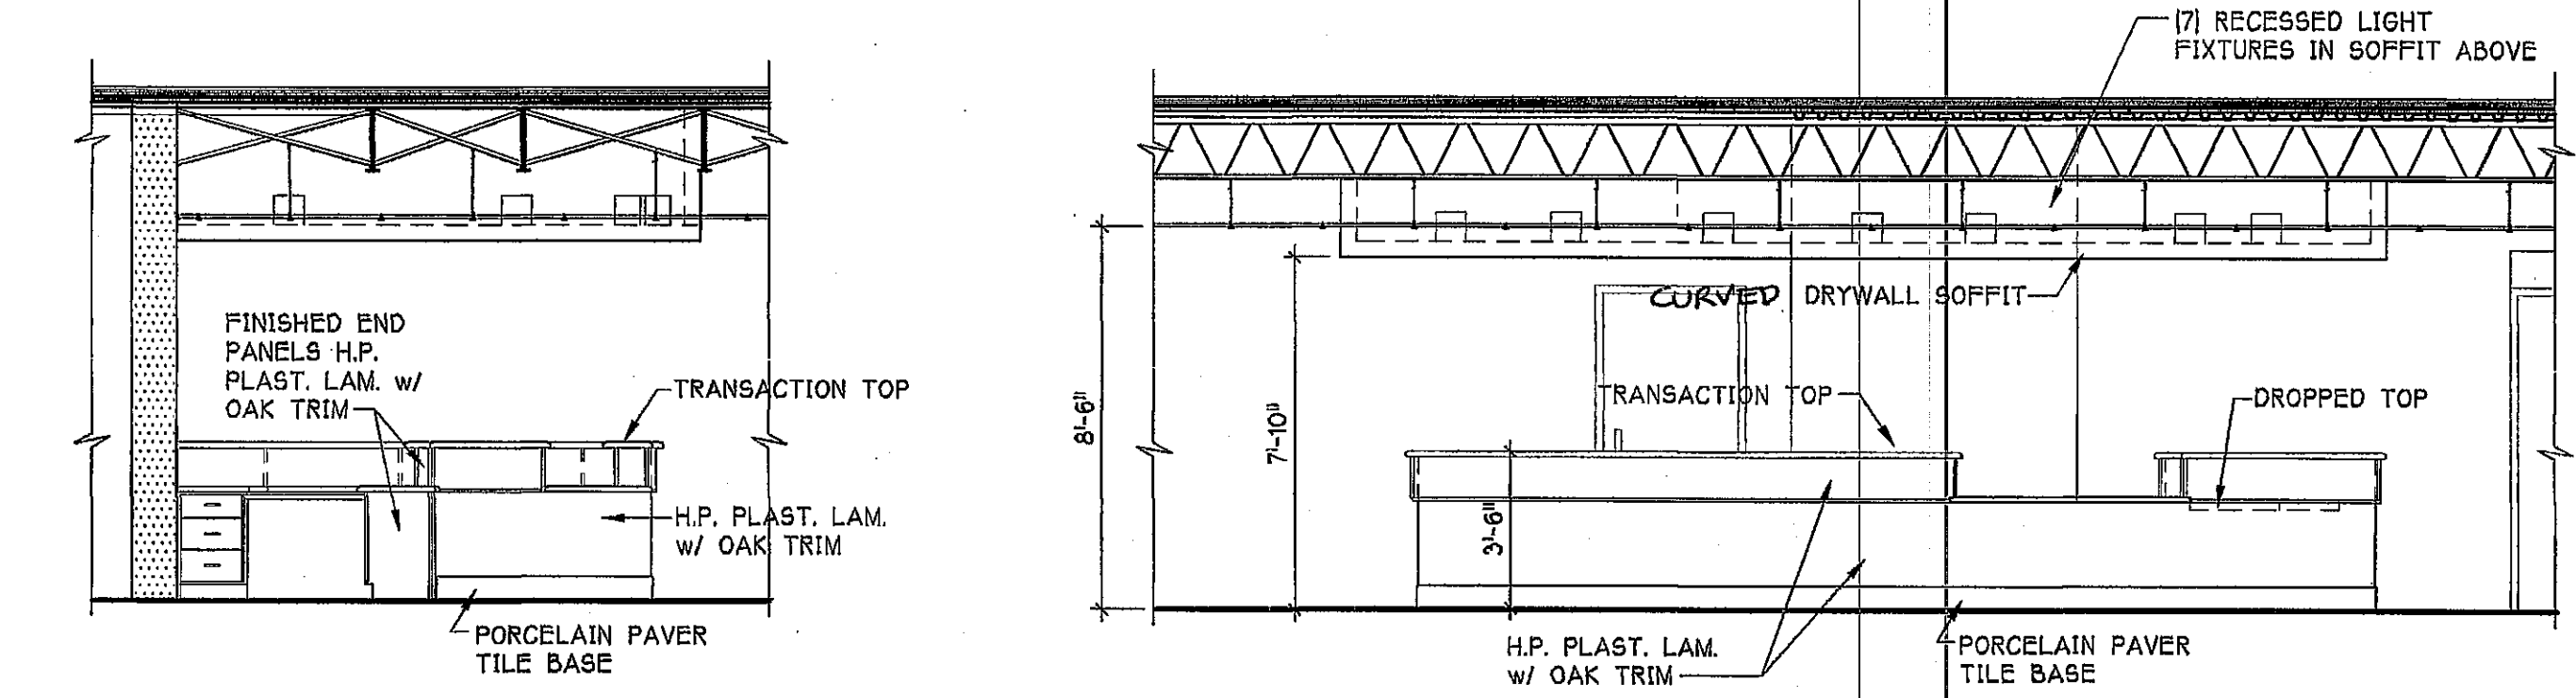
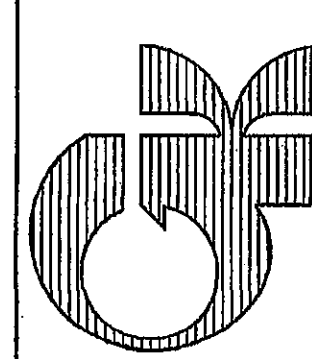


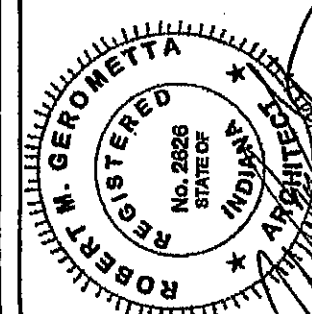



**A ELEVATION**  
A6.1 1/4"=1'-0"

**B ELEVATION**  
A6.1 1/4"=1'-0"

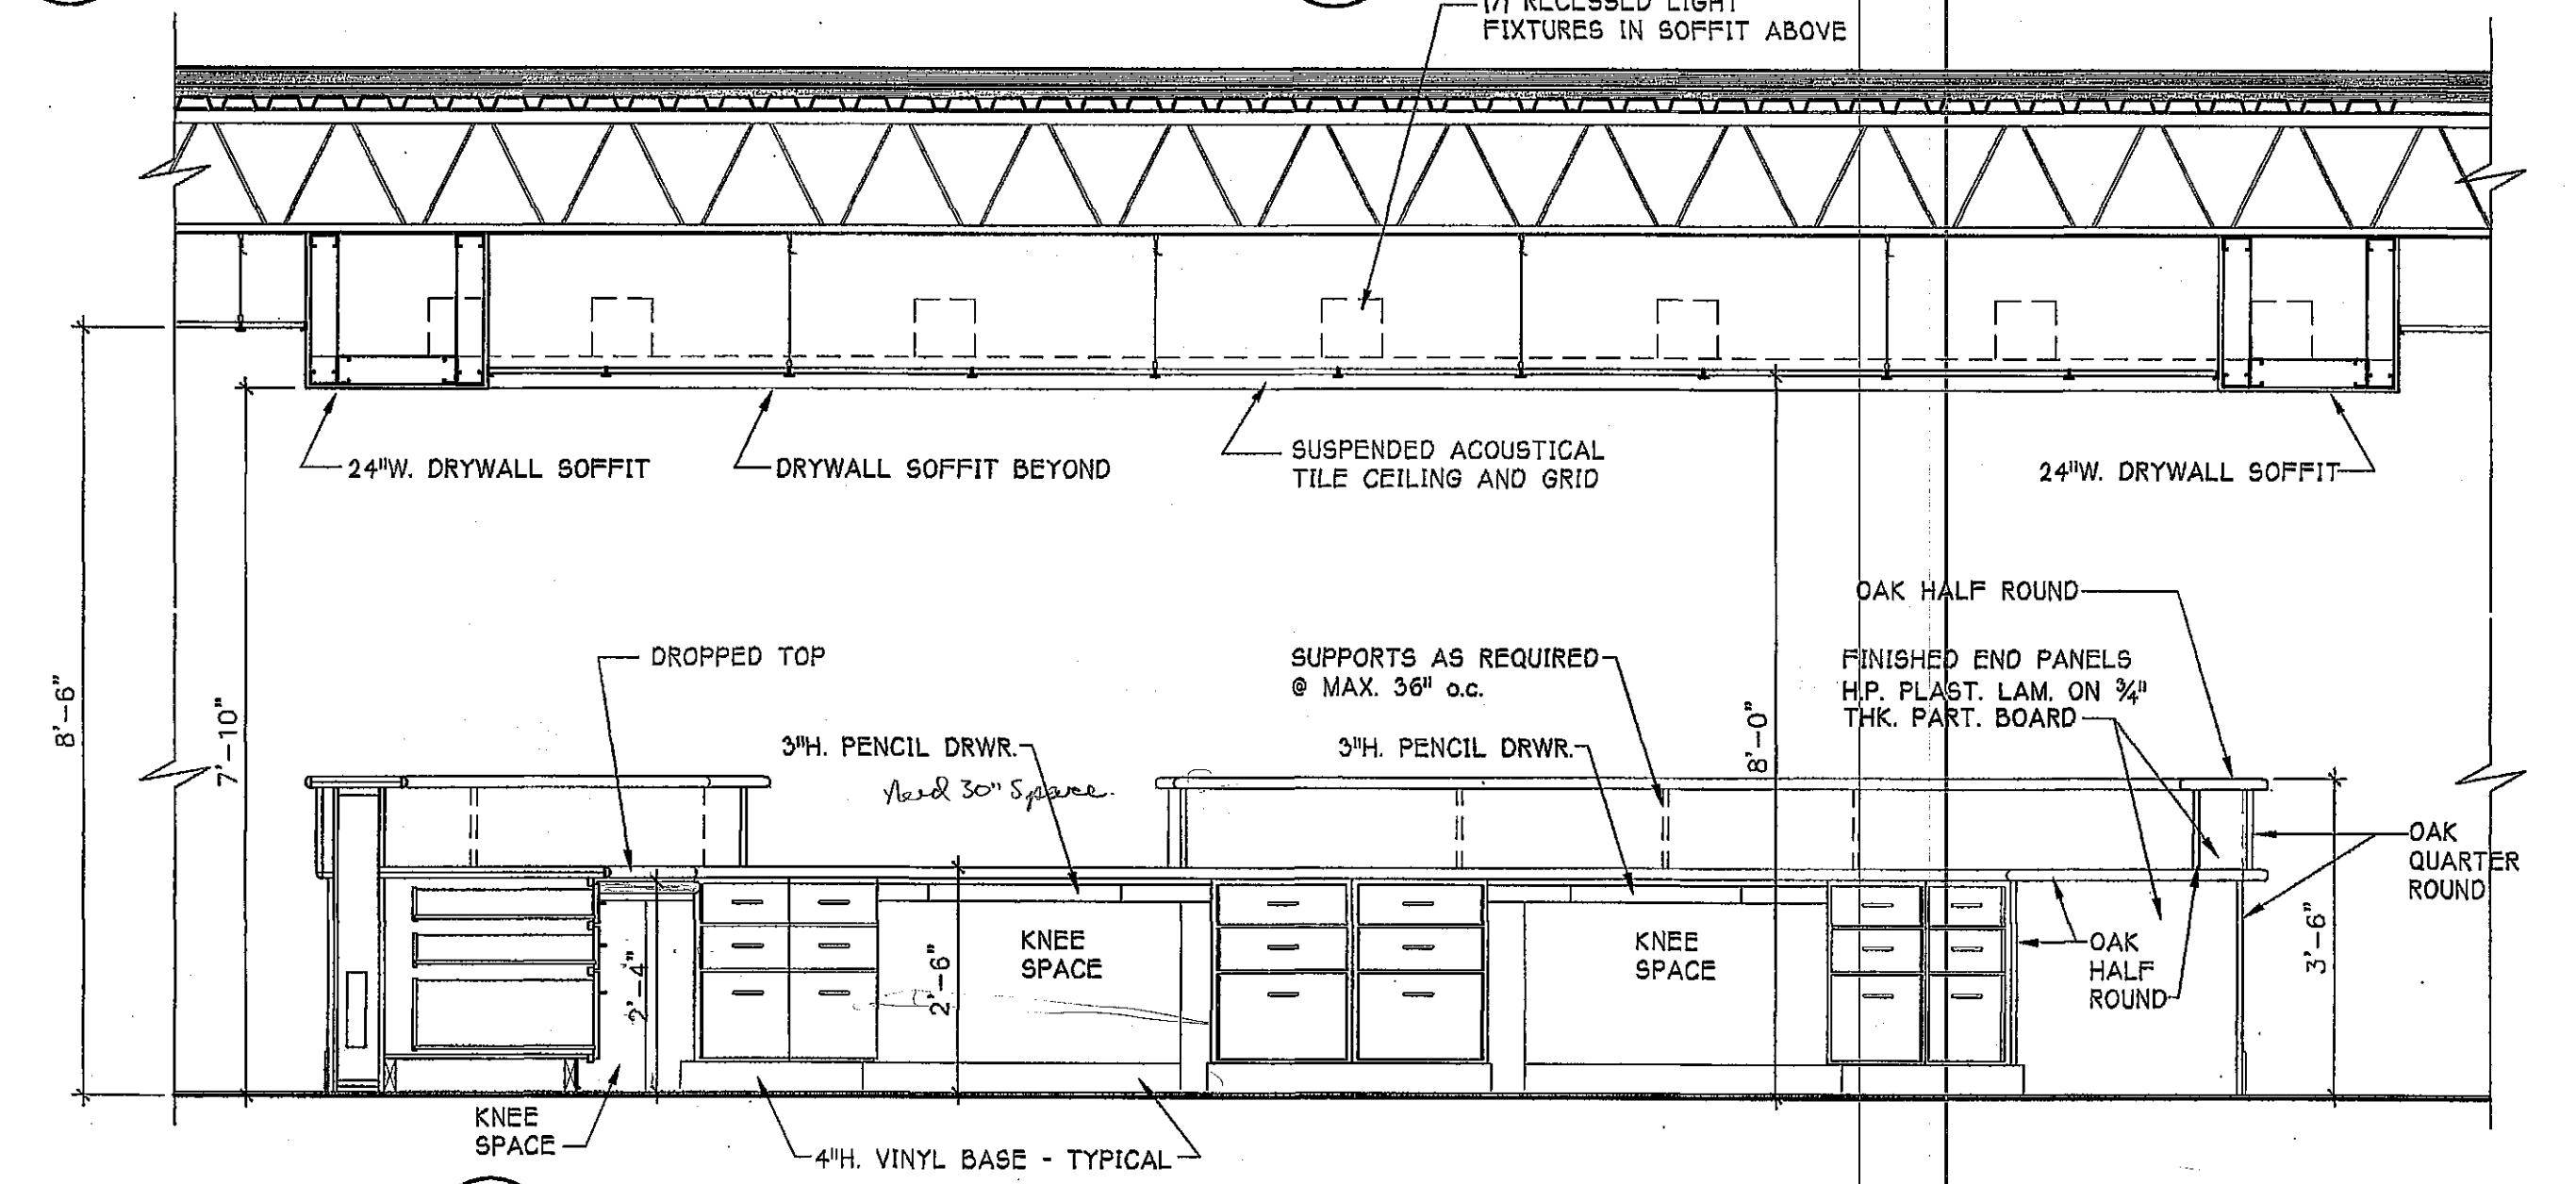


**C ELEVATION**  
A6.1 1/4"=1'-0"


**D ELEVATION**  
A6.1 1/4"=1'-0"

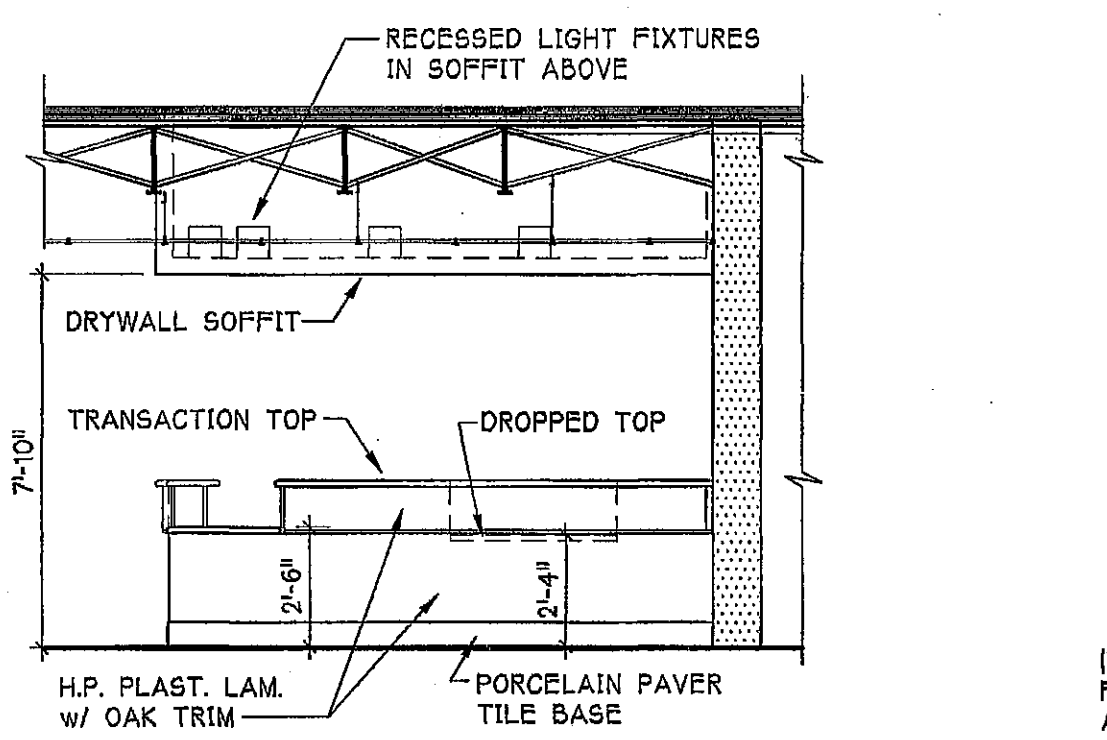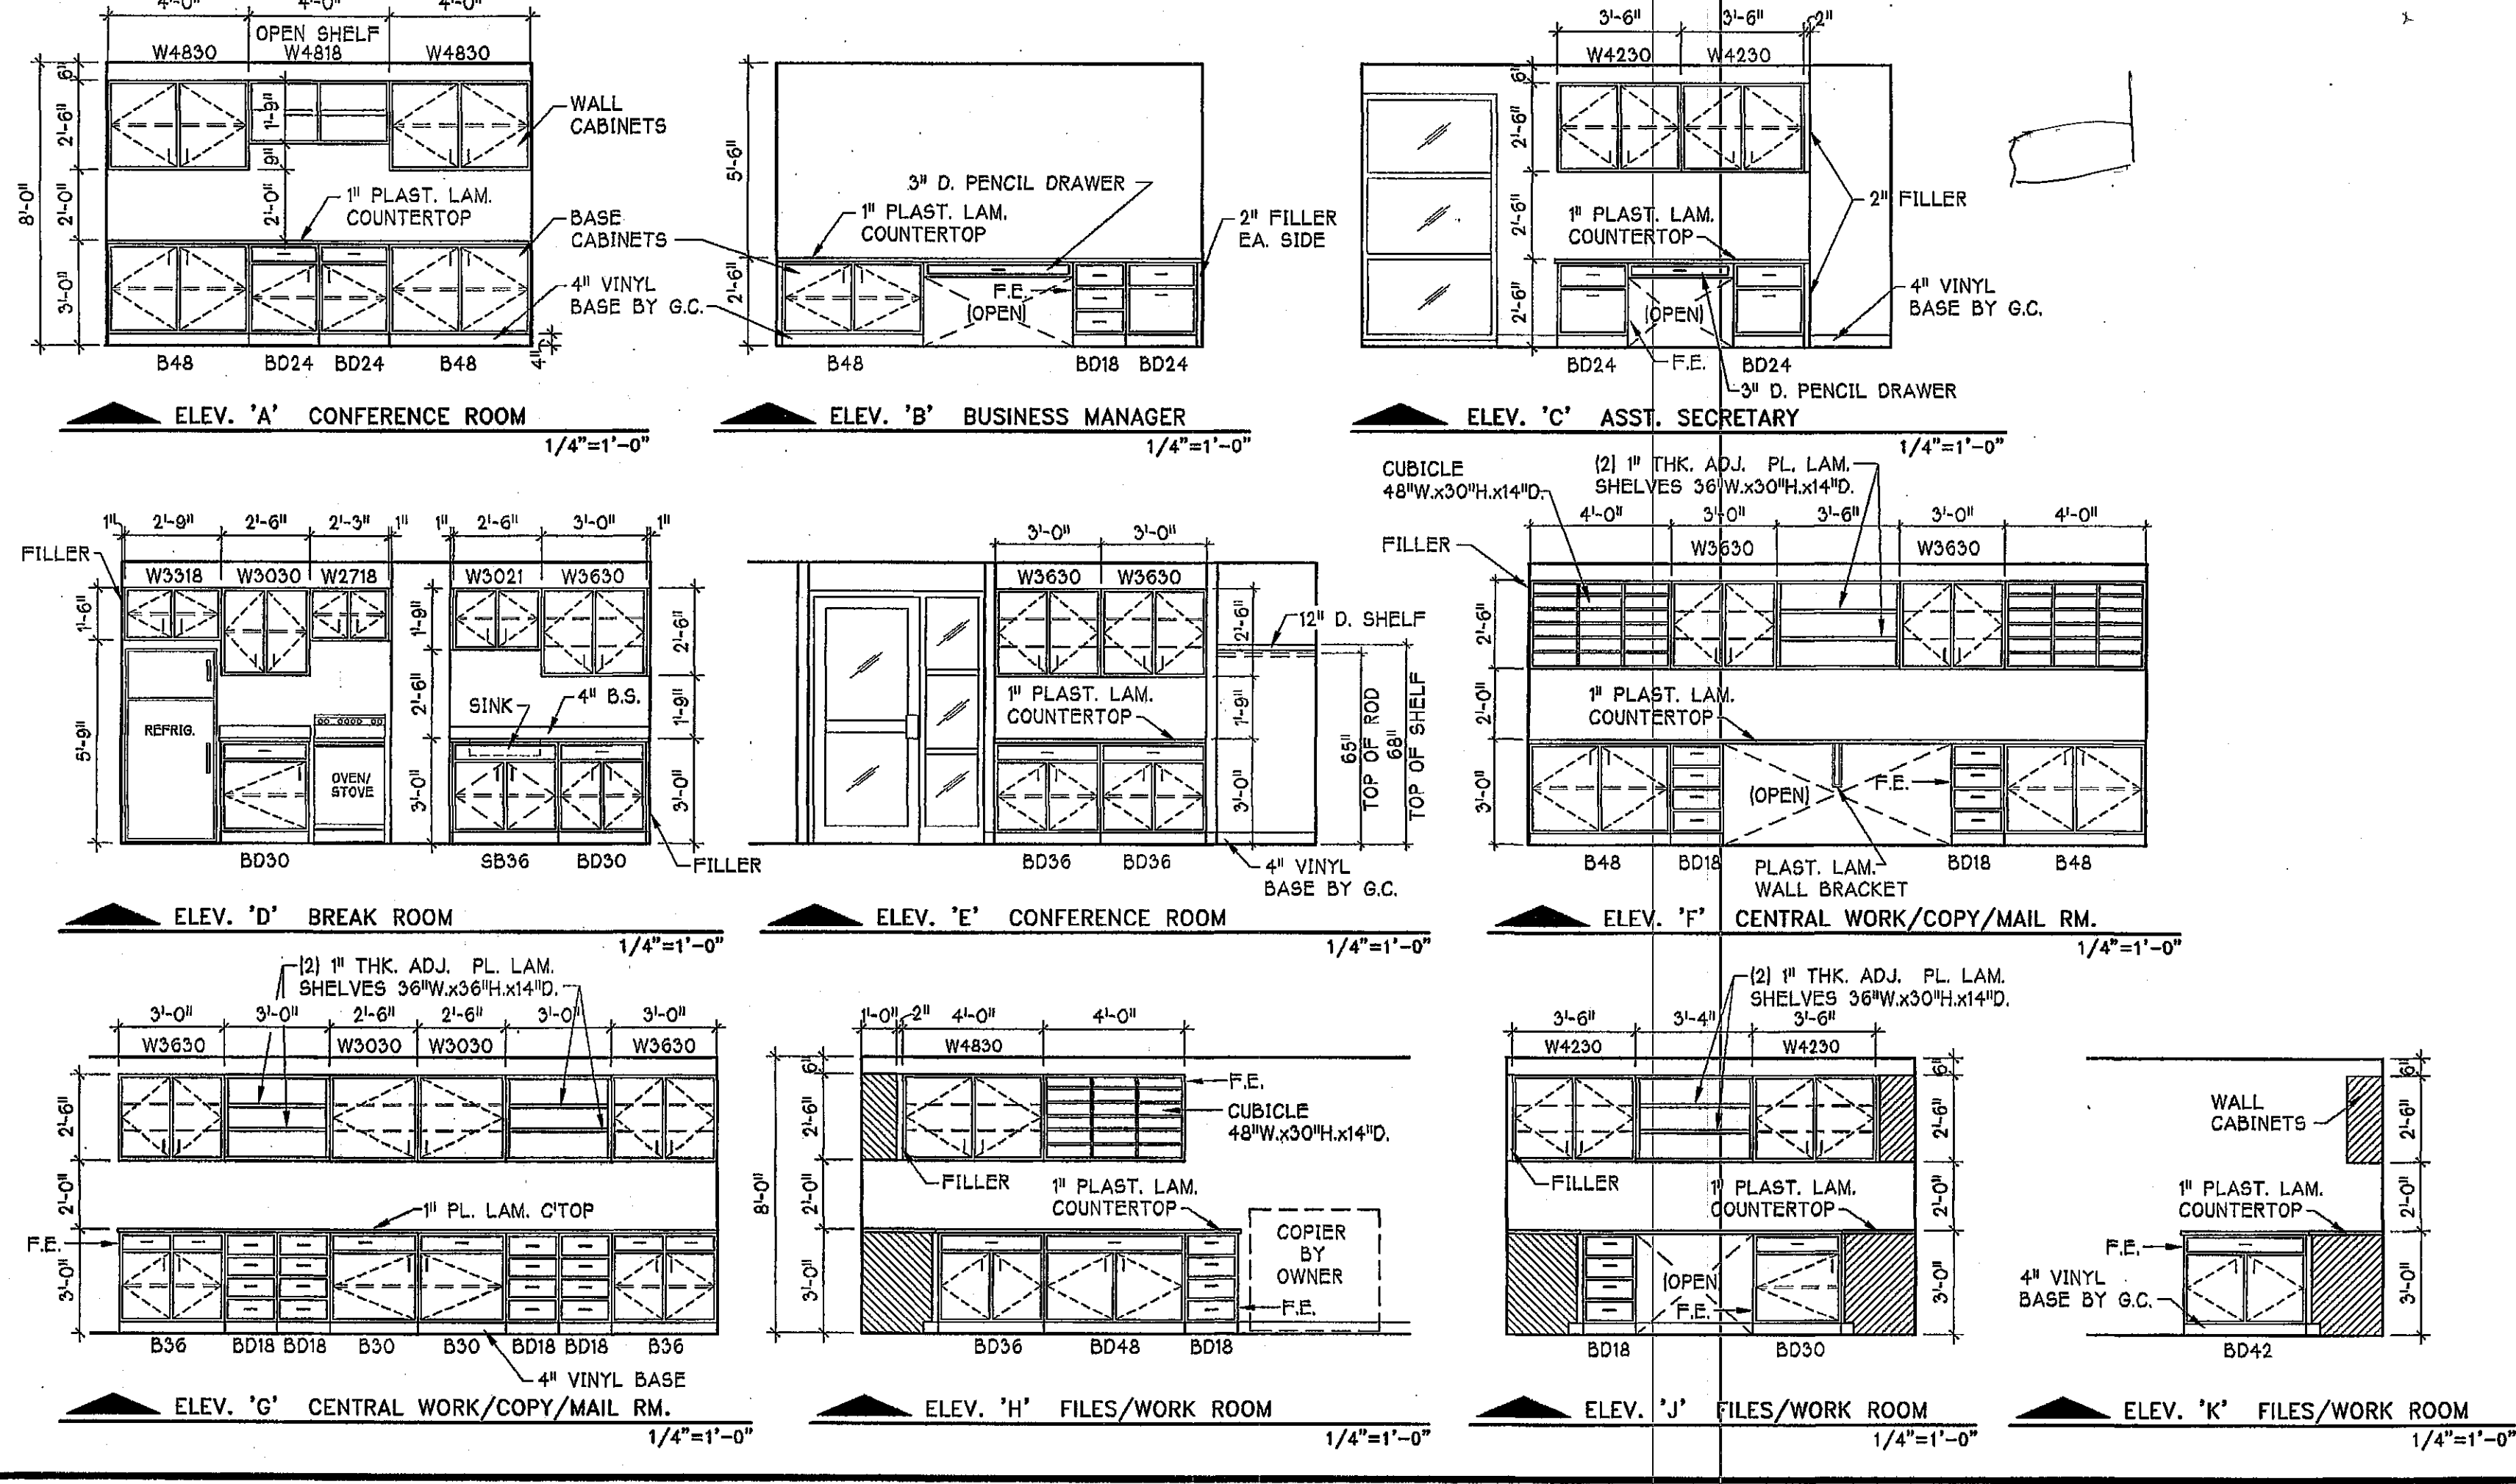



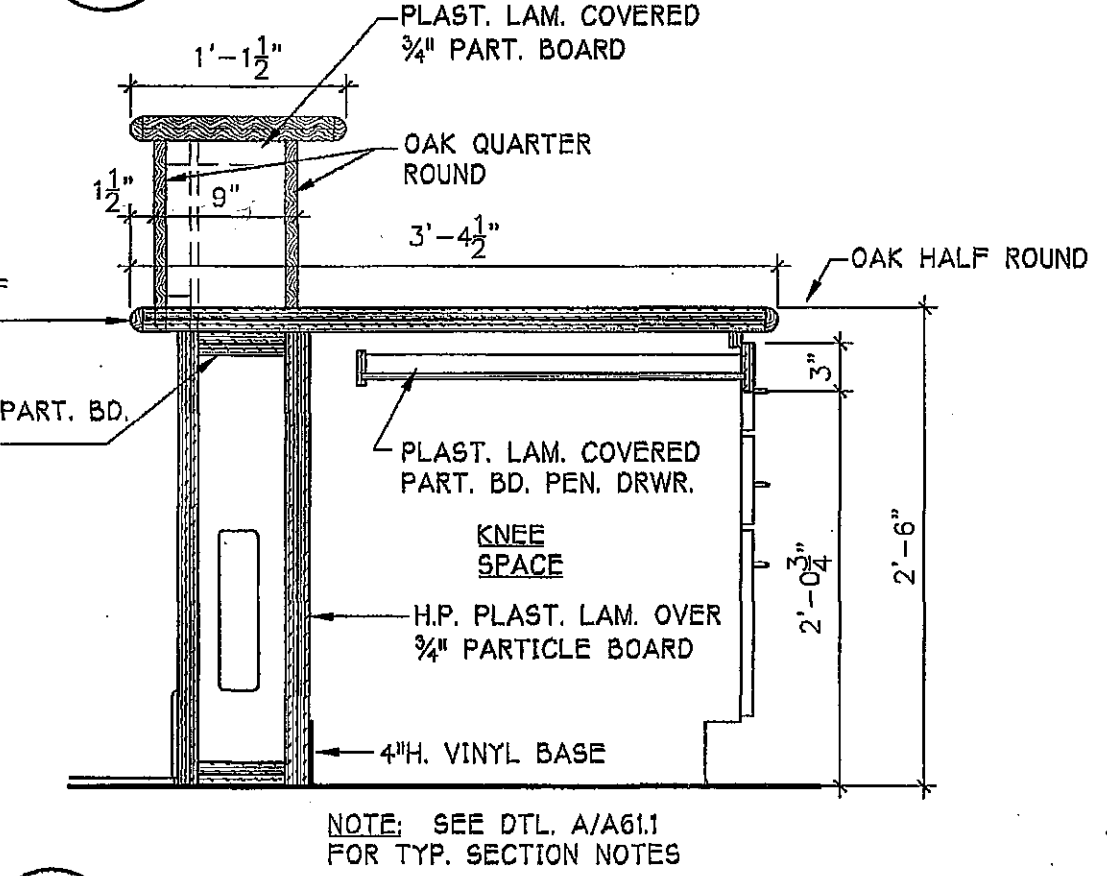


**2 SECTION THRU KNEE SPACE**  
A6.1 1"=1'-0"

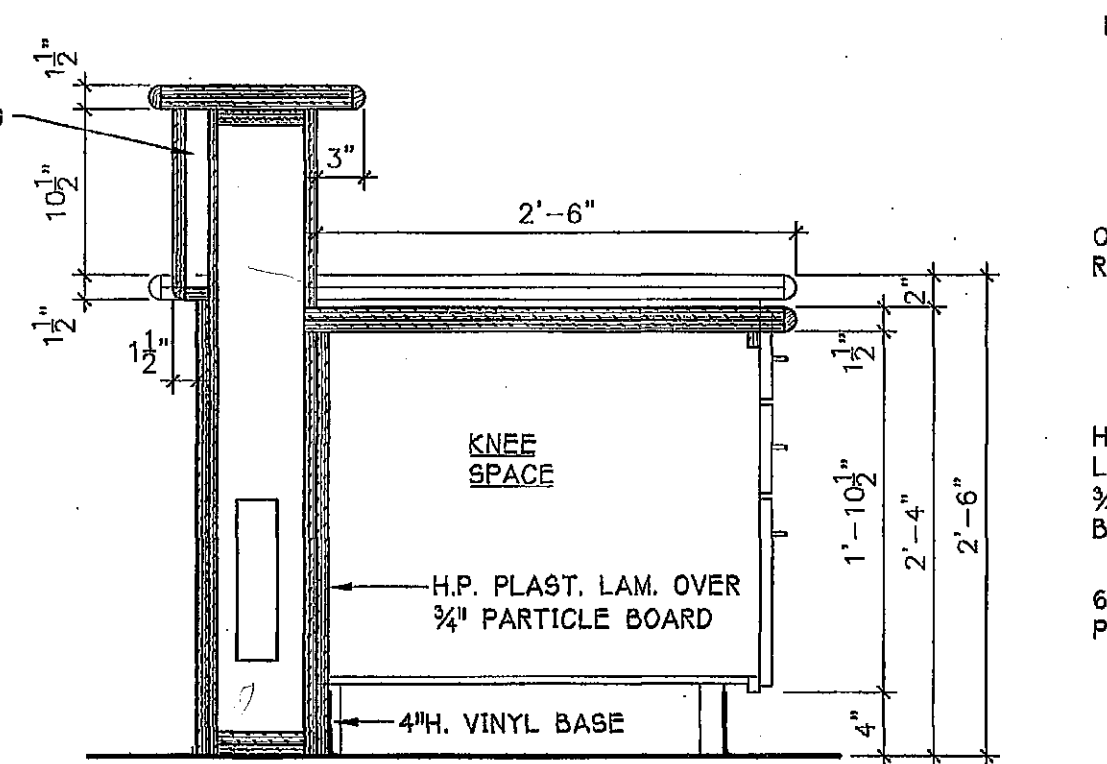


**4 SECTION THRU DROPPED TOP**  
A6.1 1"=1'-0"

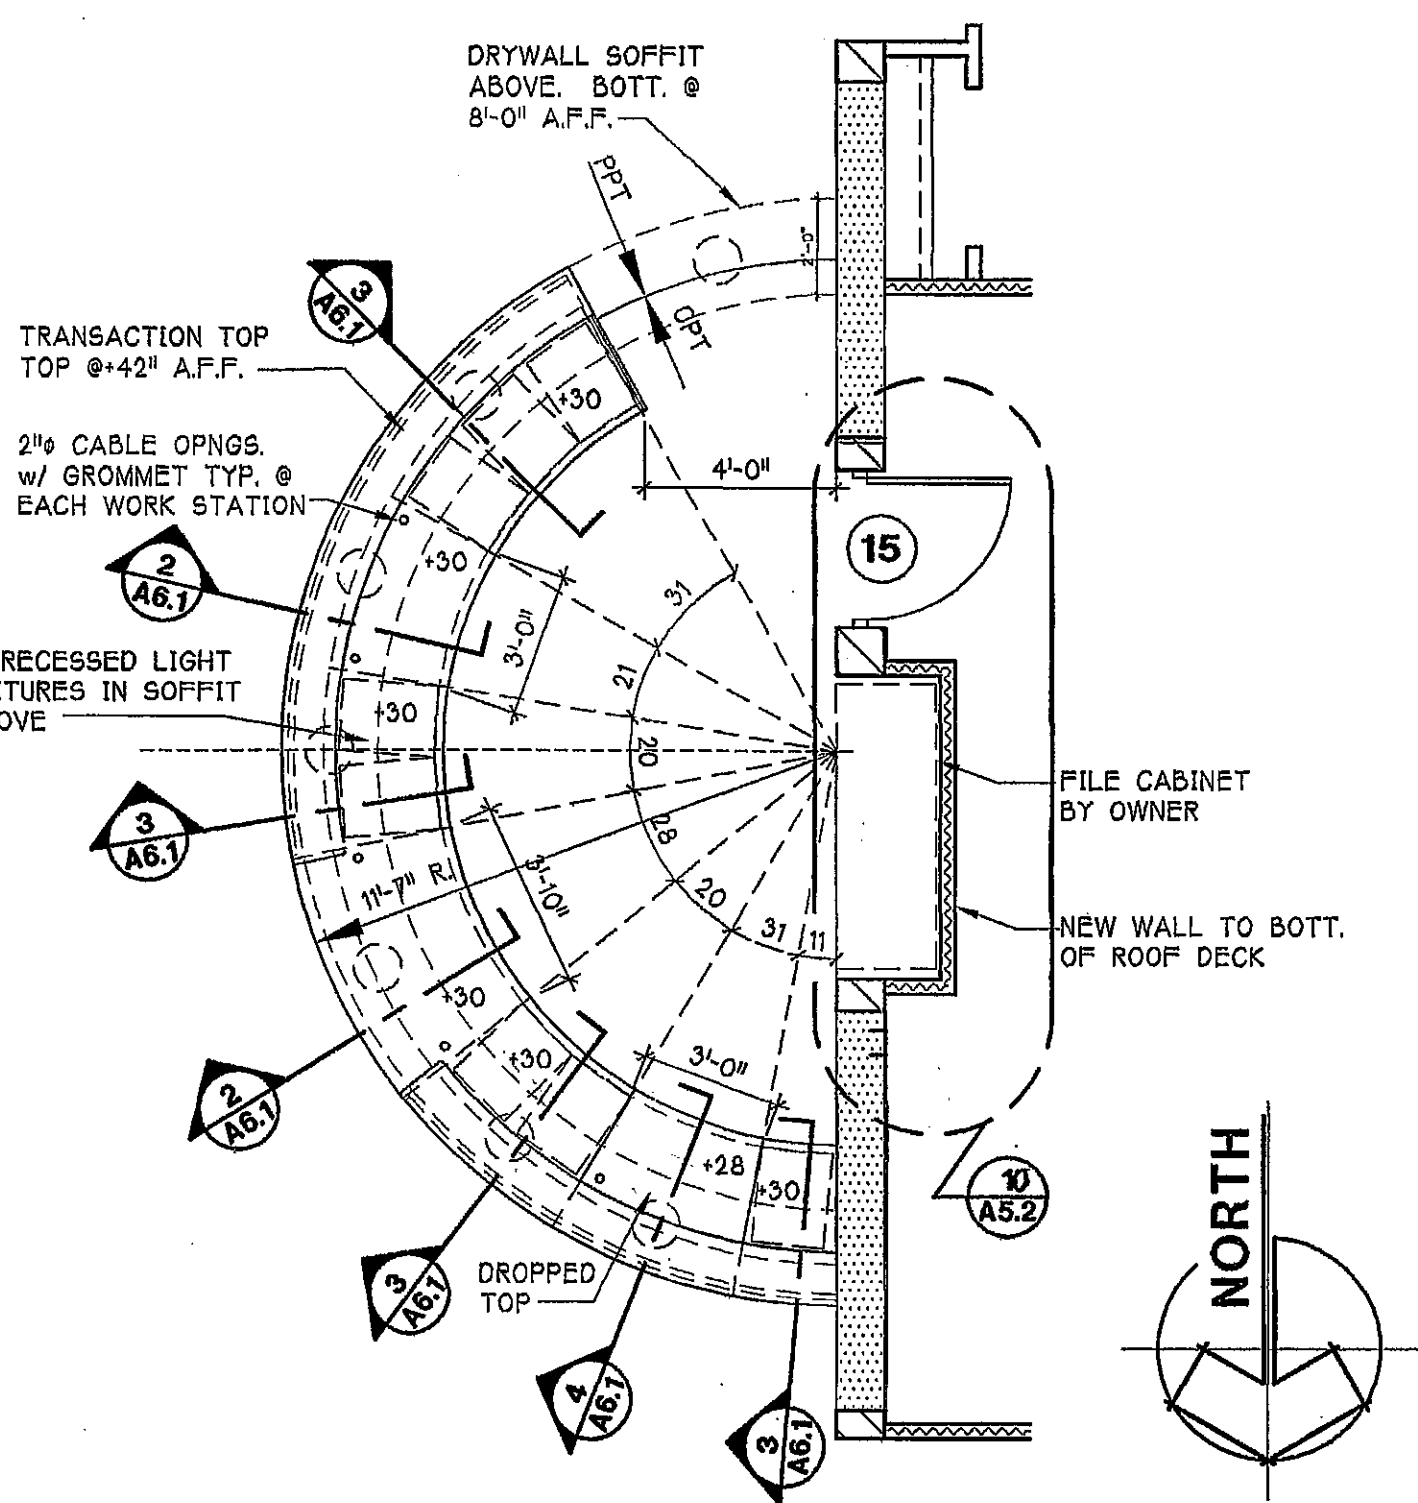

**RECEPTION DESK PLAN**  
1/4"=1'-0"

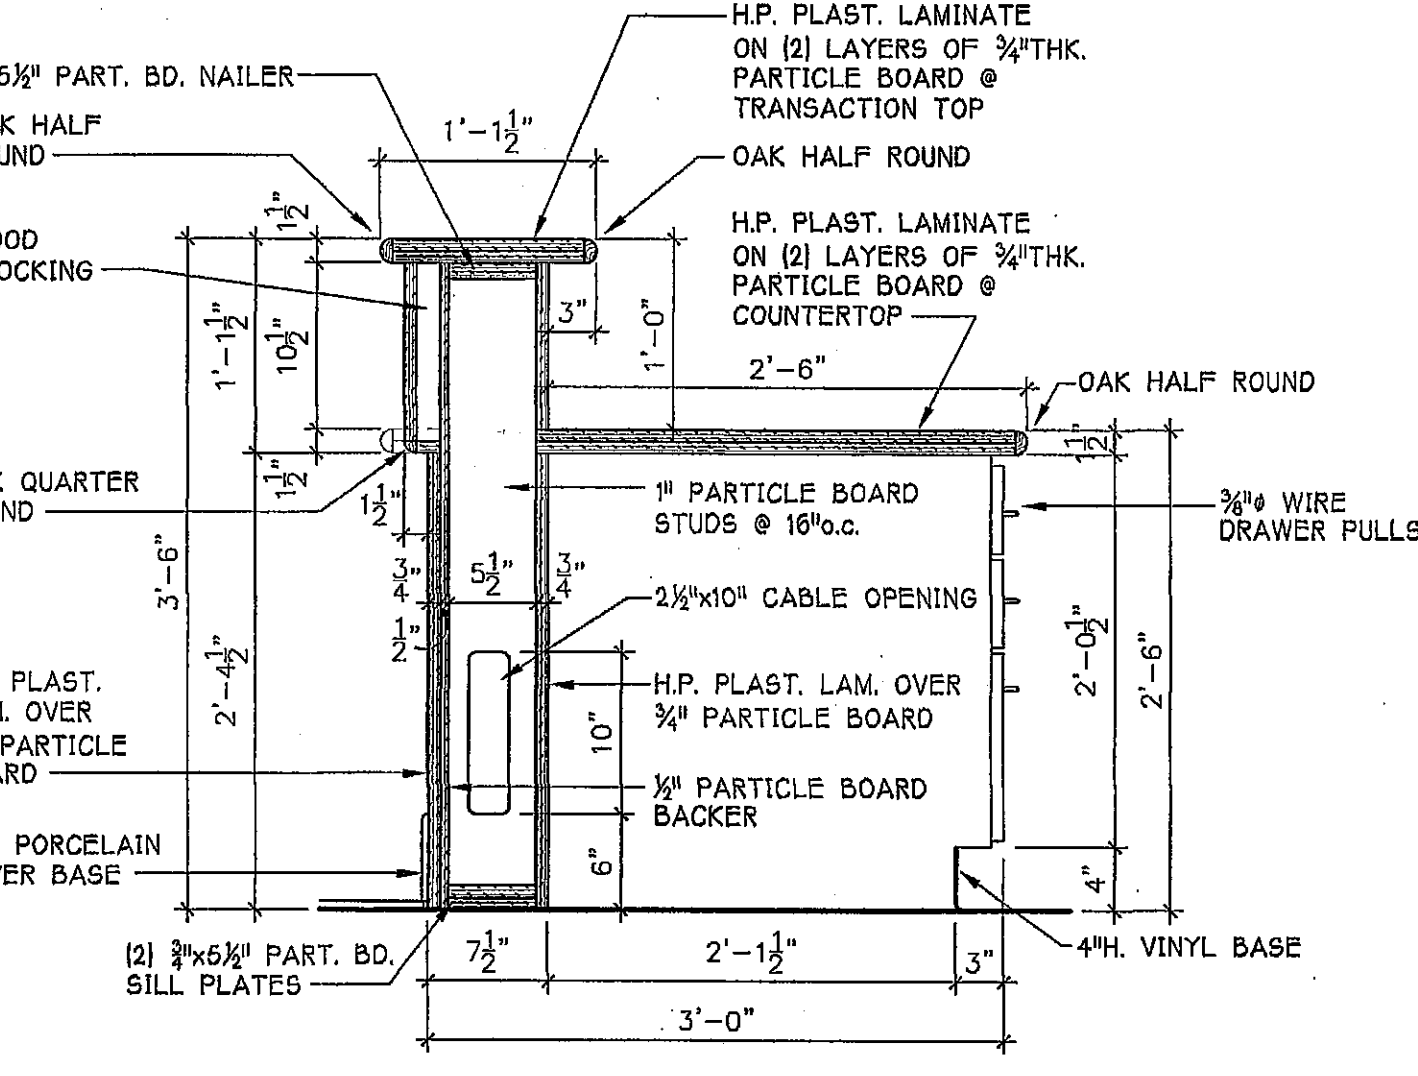

**1 TYP. CASEWORK SECTION**  
A6.1 1"=1'-0"

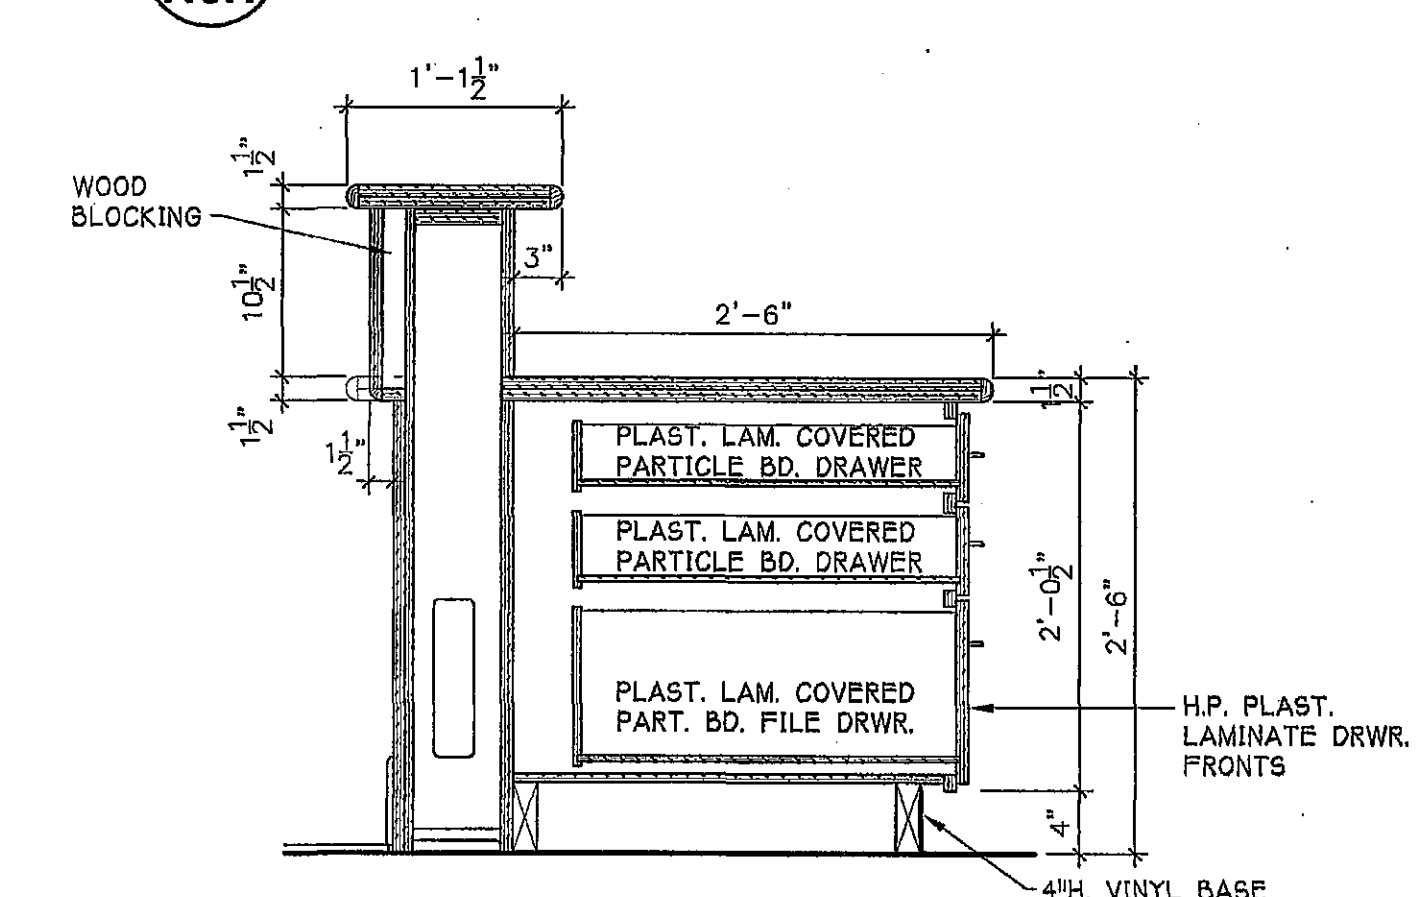

**3 SECTION THRU DRAWERS**  
A6.1 1"=1'-0"

04-A-17