



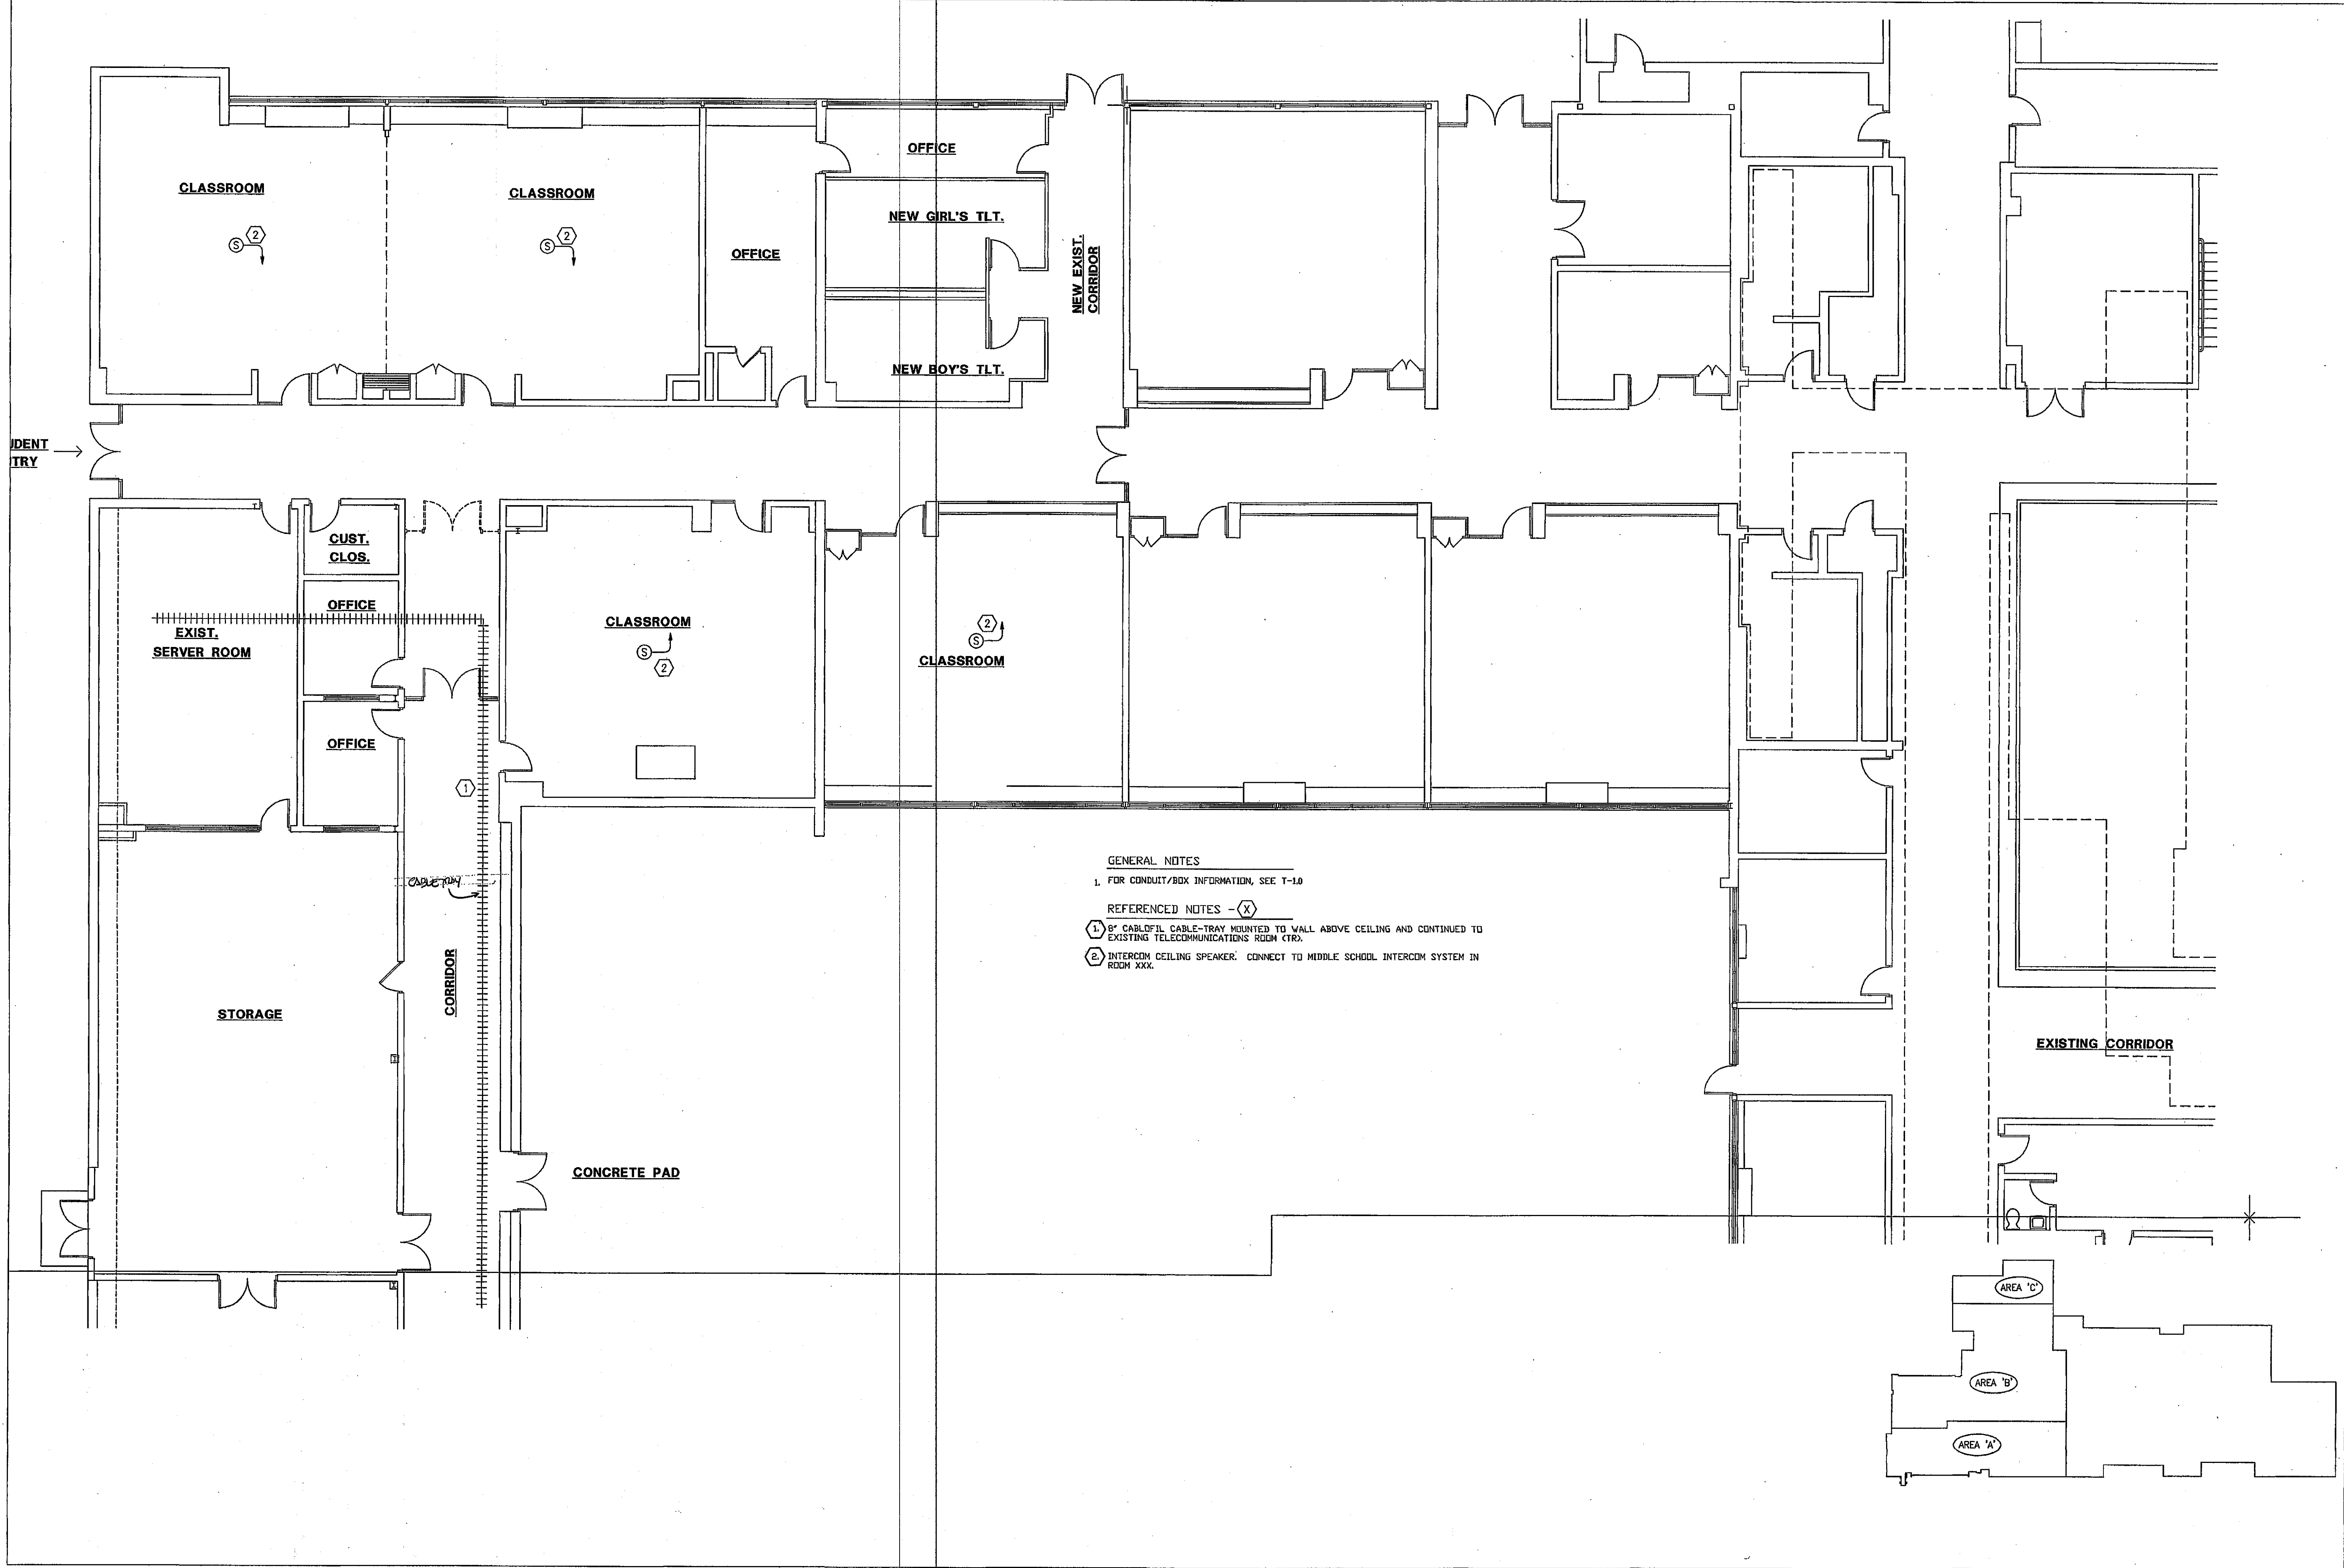

REVISIONS

BY

DSA, Inc.
Technology Design Consultants
16618 East 196 th Street
Noblesville, IN 46060-9530
(765) 534-5152

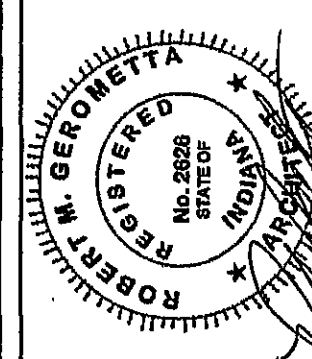


UNIT "B" TECHNOLOGY REFLECTED CEILING

DUNELAND SCHOOLS ADMINISTRATION CENTER
651 W. MORGAN AVENUE
CHESTERTON, IN

gerometta & kinel architects, inc.

chesterton, Indiana

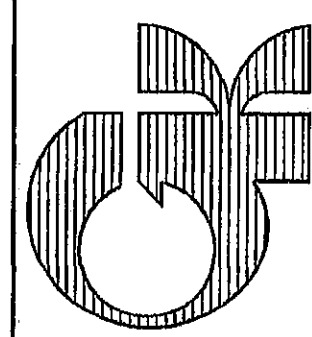

DATE 10-06-04

SCALE

DRAWN

JOB 2103

SHEET

T2.2

OF 37 SHEETS

04-TE-06