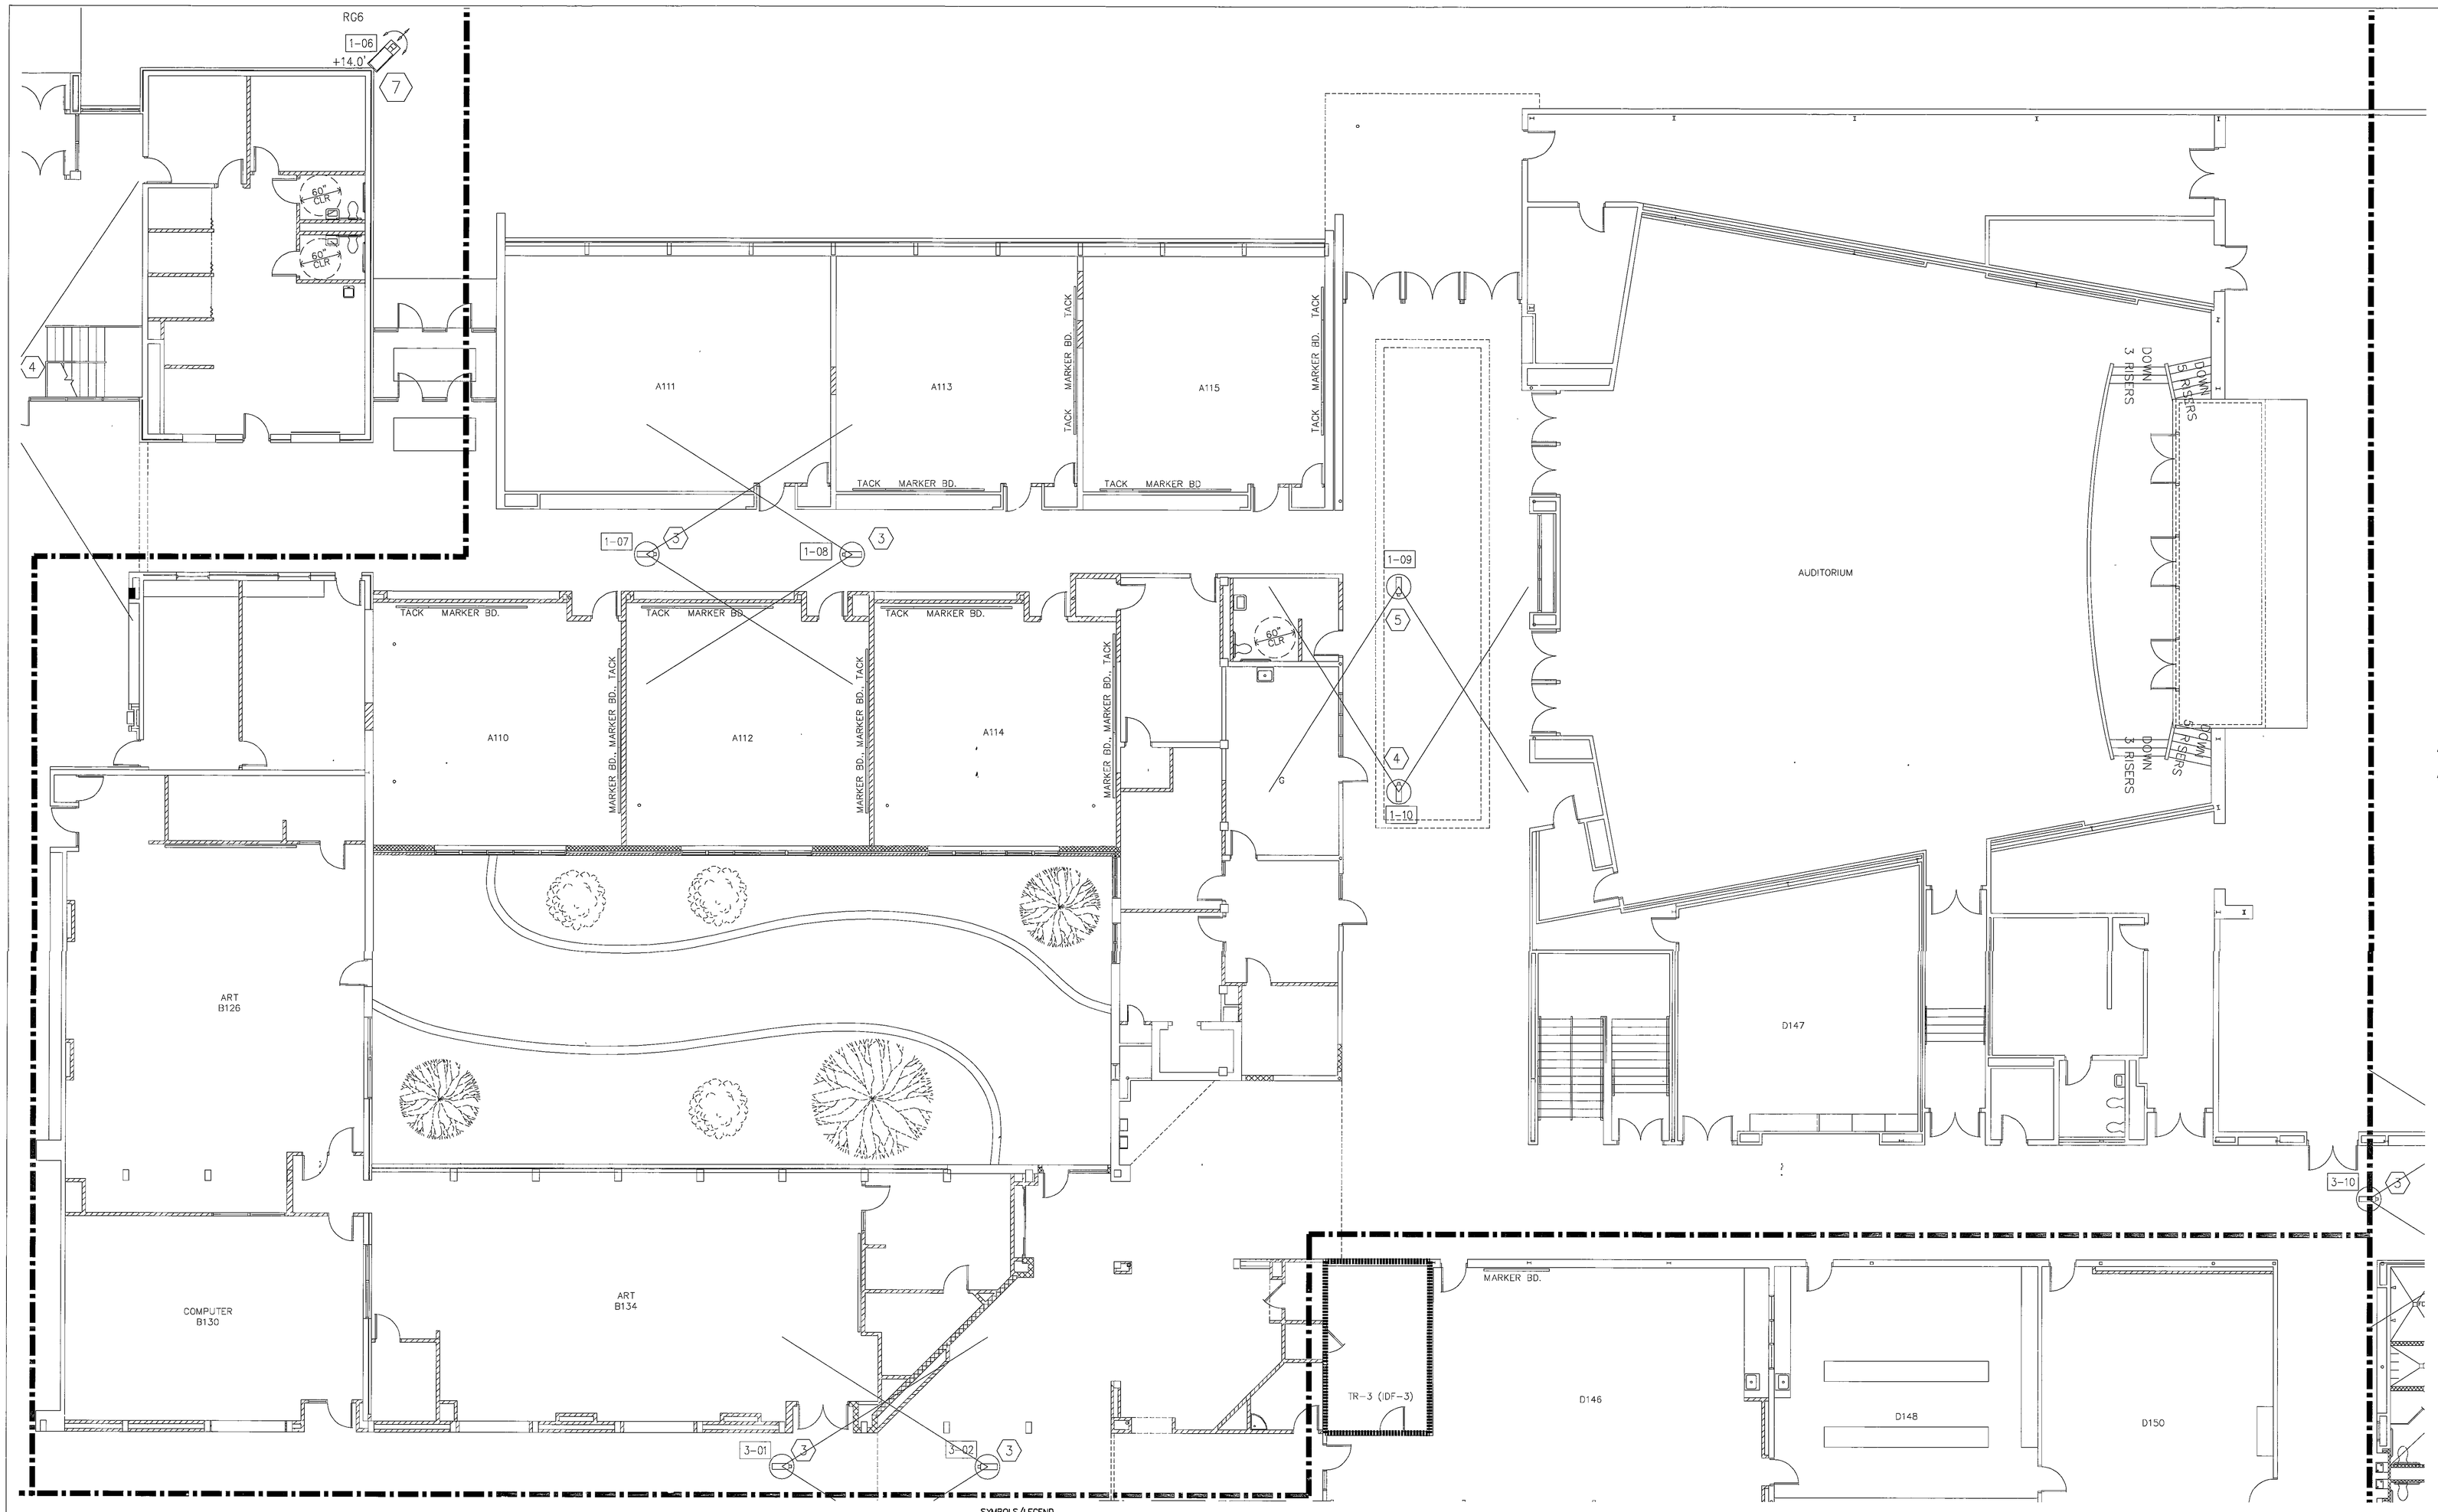

1 / T2.4 FLOOR PLAN – UNIT "D"
SCALE. 1/8"=1'-0" FIRST FLOOR

SYMBOLS/LEGEND

(X-XX) IDF # – CAMERA IDENTIFICATION NUMBER

GENERAL NOTES

1. ROUTE COAX CABLES (PLENUM RG-6 TYPE)TO EQUIPMENT ROOM (ER), TERMINATE BOTH ENDS AND TEST.
2. ROUTE POWER CABLE (PLENUM, SIZE PER MFG. REQUIREMENTS)TO EQUIPMENT ROOM (ER) OR TELECOMMUNICATION ROOM (TR) AS SHOWN IN DRAWING 4.1 (1). OUTDOOR CAMERAS TO HAVE A SEPARATE POWER RUN FOR THE HEATER.
3. ROUTE DATA CABLE (RS-485) FOR OUTDOOR P&T/ZOOM CAMERAS PER MFG. REQUIREMENTS TO EQUIPMENT ROOM (ER) AS SHOWN IN DRAWING 4.1 (1).
4. ROUTE COAX AND POWER CABLES IN EXISTING TELECOMMUNICATION TRAYS WHERE POSSIBLE.
5. REFERENCED NOTES BELOW ARE NOT NECESSARILY USED ON EVERY DRAWING.

REFERENCED NOTES (X)

1. EXISTING TRAY SYSTEM
2. INDOOR CAMERA, WV-CW474AF MOUNTED IN DROP CEILING. SEE DRAWING 5.1 (4).
3. INDOOR CAMERA, WV-224CF, MOUNTED IN DROP CEILING, SEE DRAWING 5.1 (4).
4. INDOOR CAMERA, WV-CW474AS MOUNTED ON WALL, SEE DRAWING 5.1 (3).
5. INDOOR CAMERA, WV-CW224CF MOUNTED ON WALL, SEE DRAWING 5.1 (3)
6. OUTDOOR FIXED CAMERA, WV-CW374 MOUNTED AS SHOWN ON DRAWING 5.1 (6).
7. OUTDOOR PAN & TILT/ZOOM CAMERA, WV-CW-864A MOUNTED AS SHOWN ON DRAWING 5.1 (2).

KEY PLAN

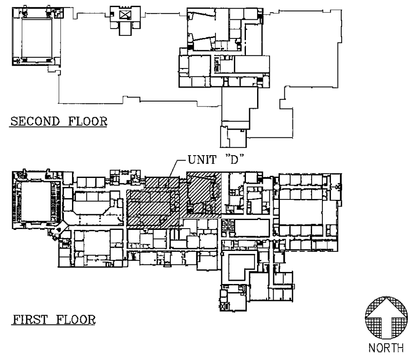

2005-8-06

REVISIONS/DATE
1. 11/16/05 AS-BUILDS

DUNELAND SCHOOL CORPORATION
CHESTERTON MIDDLE SCHOOL
CHESTERTON, INDIANA
CCTV SYSTEM

PROJECT: 04-1033
DRAWN BY : RJJ
CHECKED BY : LMD
SCALE : 1/8"=1'-0"
DATE : 04.28.2005

DSA, Inc.
Technology Design Consultants
16618 East 196 th Street
Noblesville, IN 46060-9530
(765) 534-5152

DRAWING NUMBER
T2.4