



1. CCTV EQUIPMENT RACK  
TS.1 SCALE: NTS  
IDF ROOMS

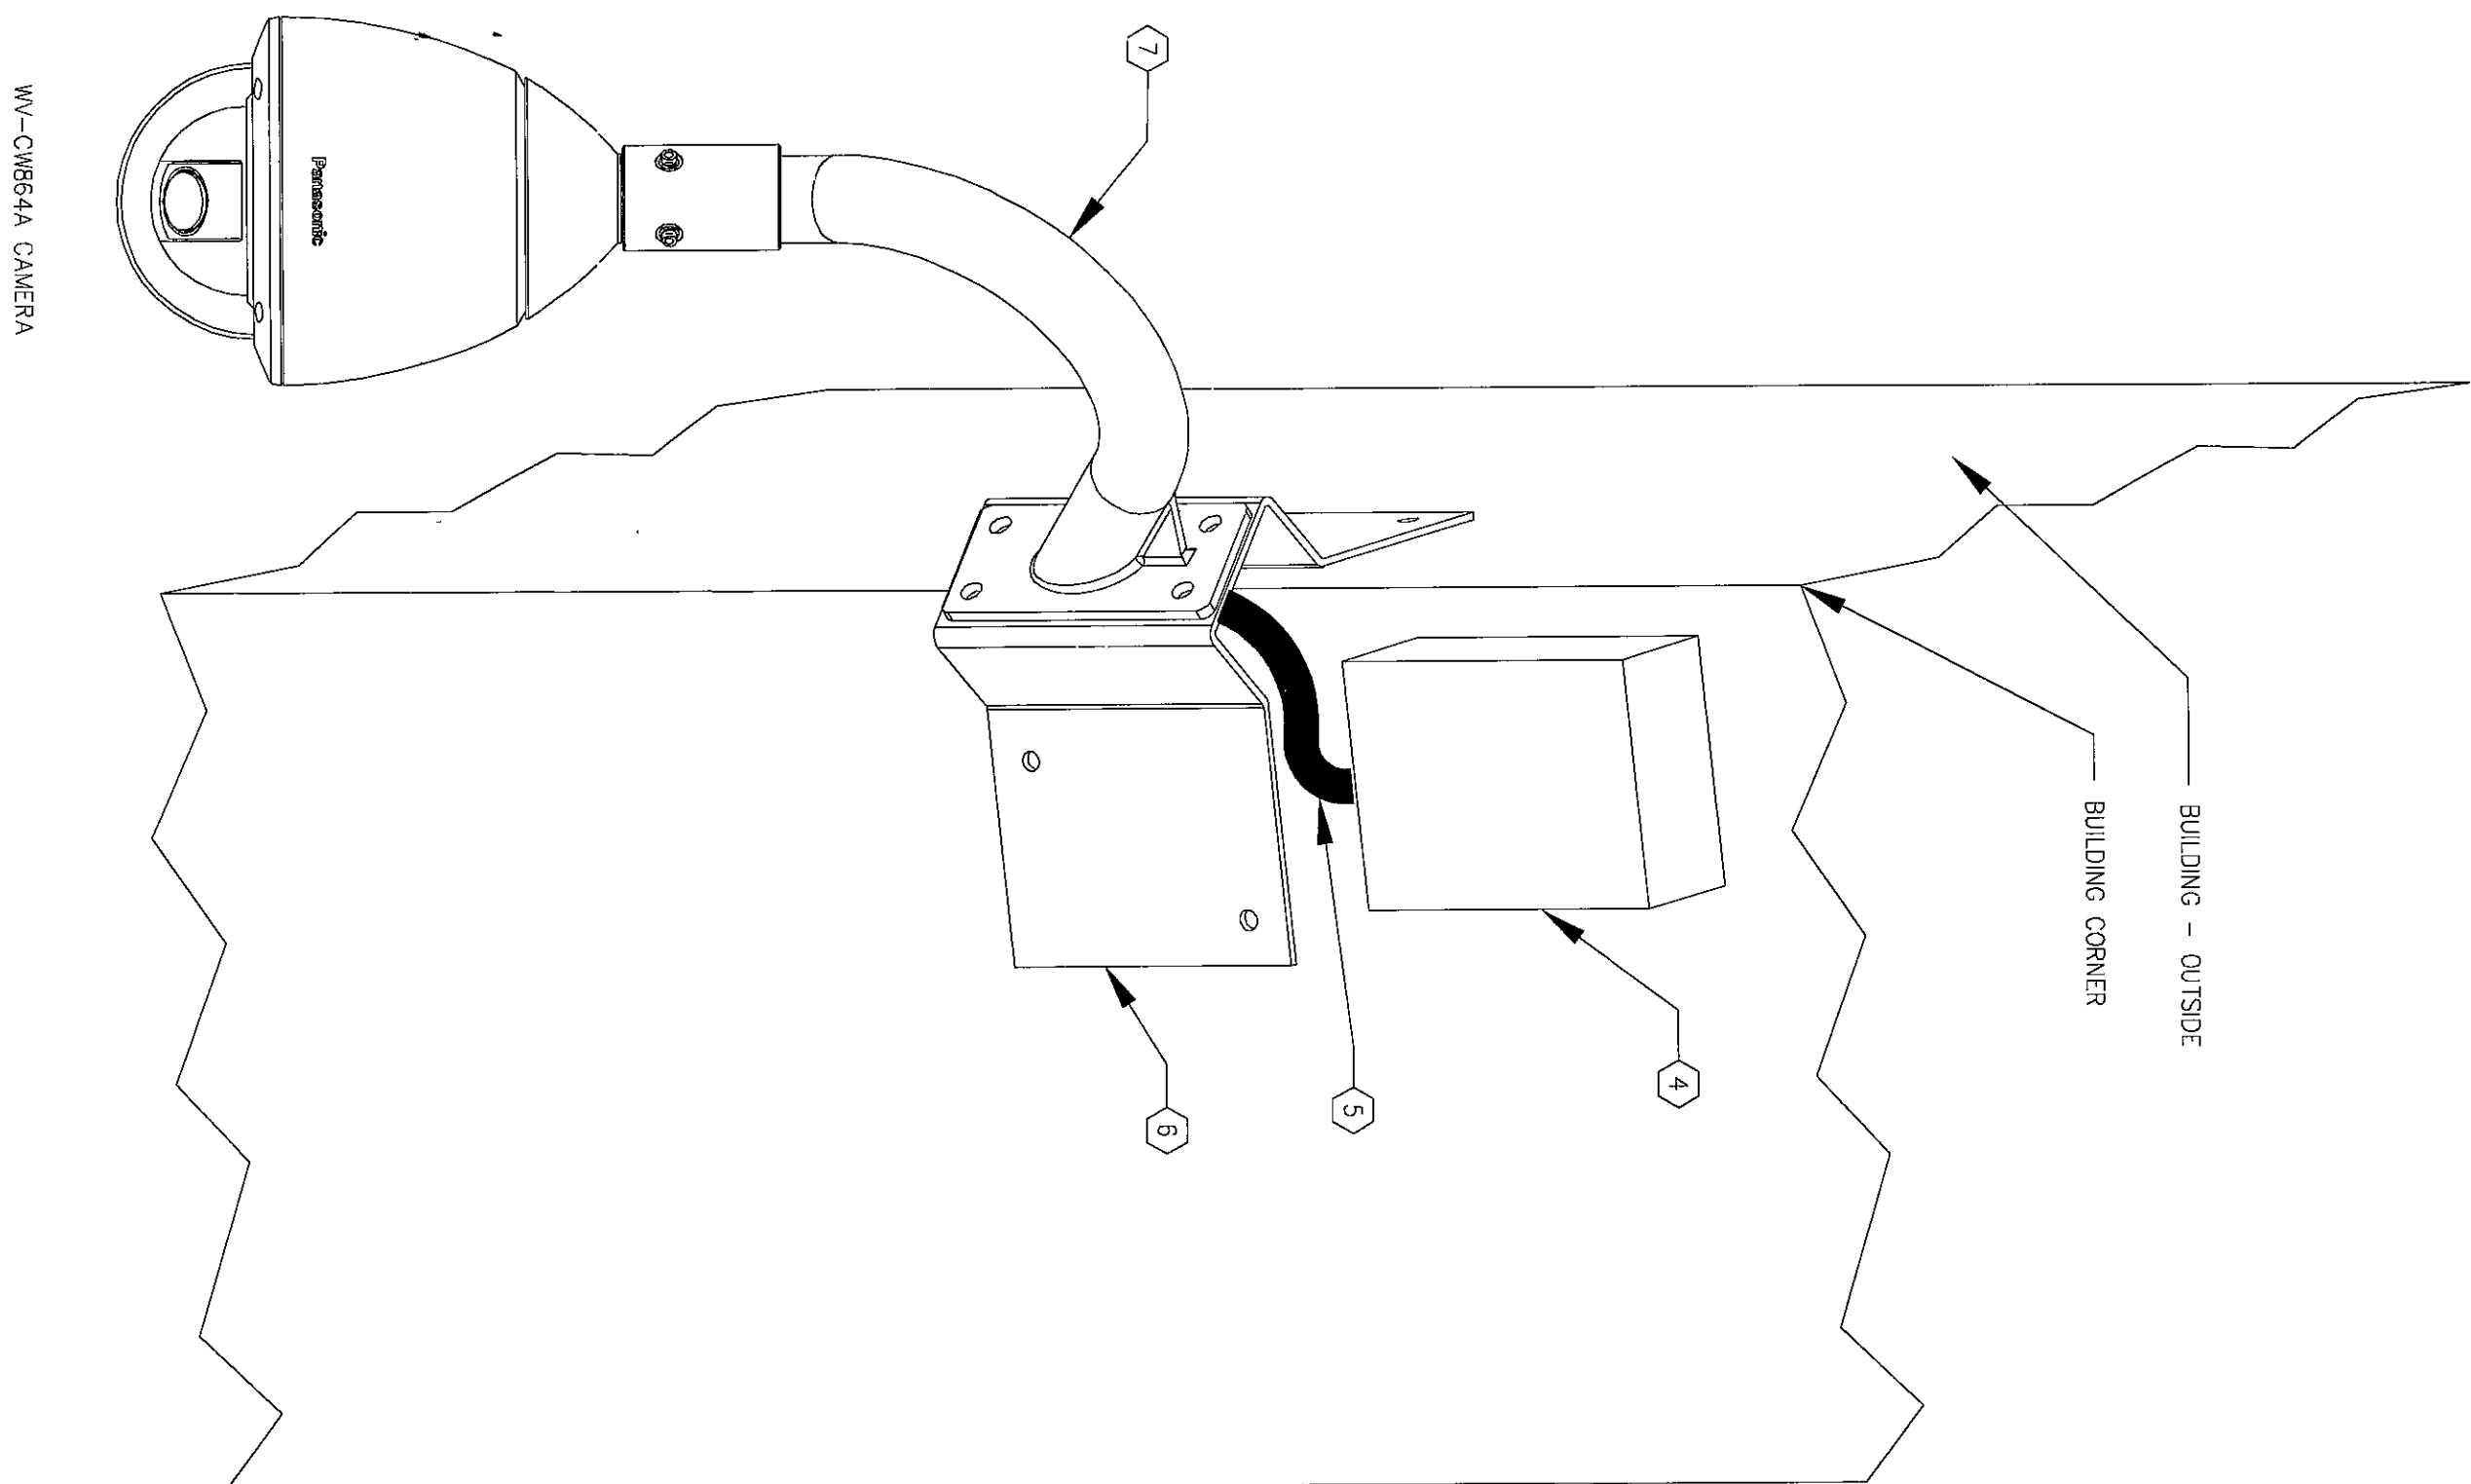


2. OUTSIDE PTZ CAMERA DETAIL  
TS.1 SCALE: NTS  
OUTSIDE BUILDING


- REFERENCED NOTES
1. 120VAC 20A CIRCUIT FOR RACK BY 1000 CONTRACTOR
  2. RACKS TO INCLUDE MULTI-QUANTITY SHOWN TO BOX WITH USE TYPE FLEX CABLE
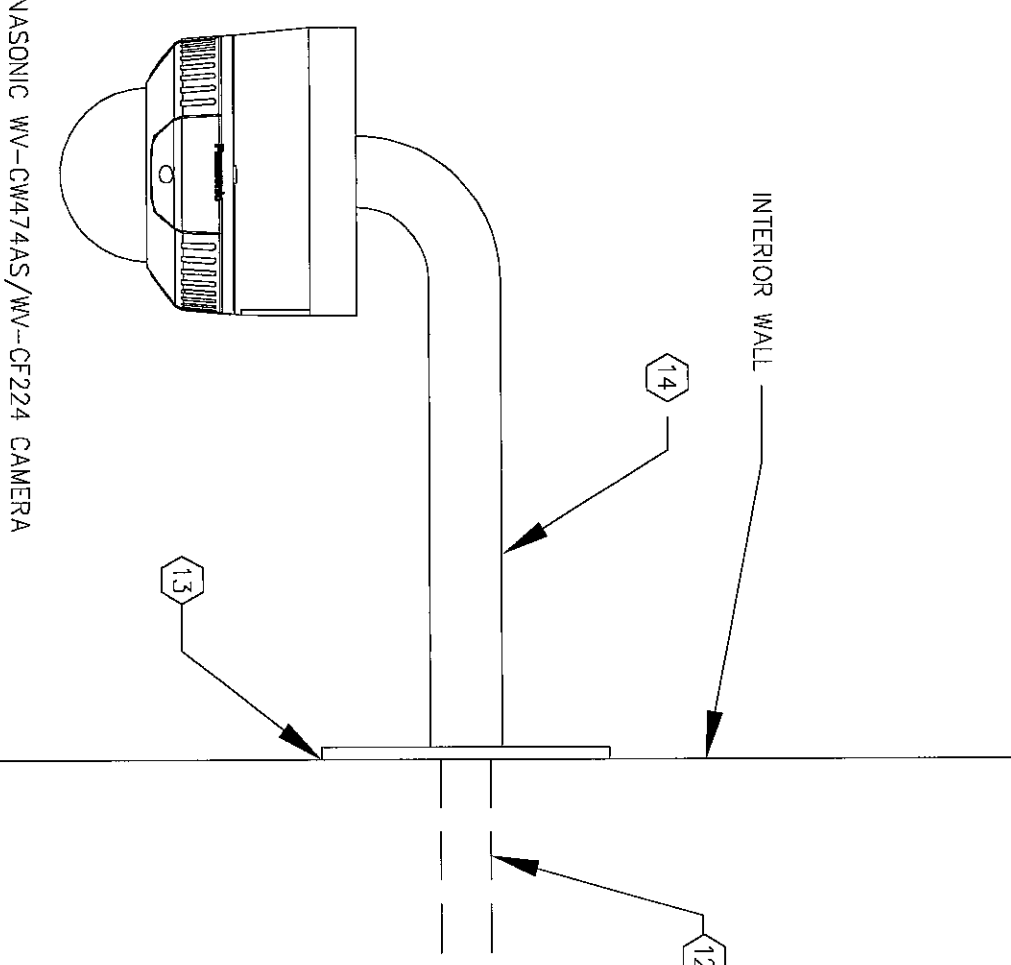


3. INTERIOR CAMERA - WALL MOUNT TYPE DETAIL  
TS.1 SCALE: NTS  
INSIDE BUILDING

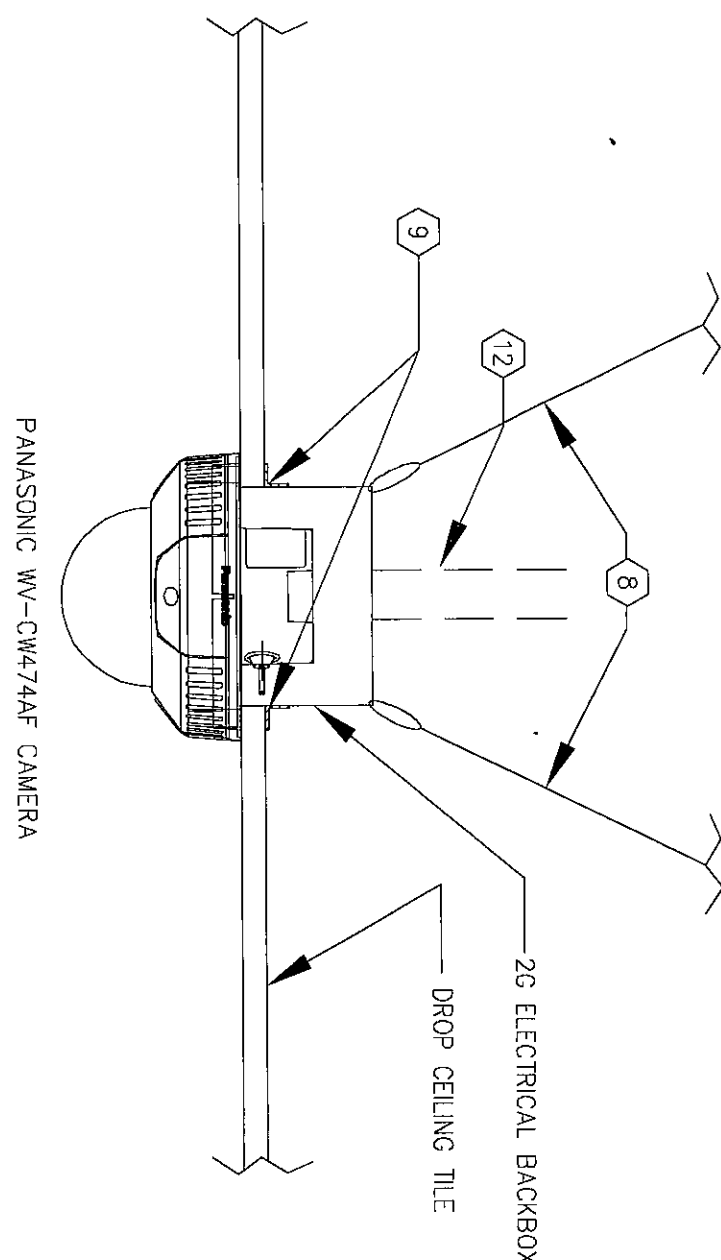

4. INTERIOR CAMERA - CEILING, DROP CEILING TYPE DETAIL  
TS.1 SCALE: NTS  
INSIDE BUILDING

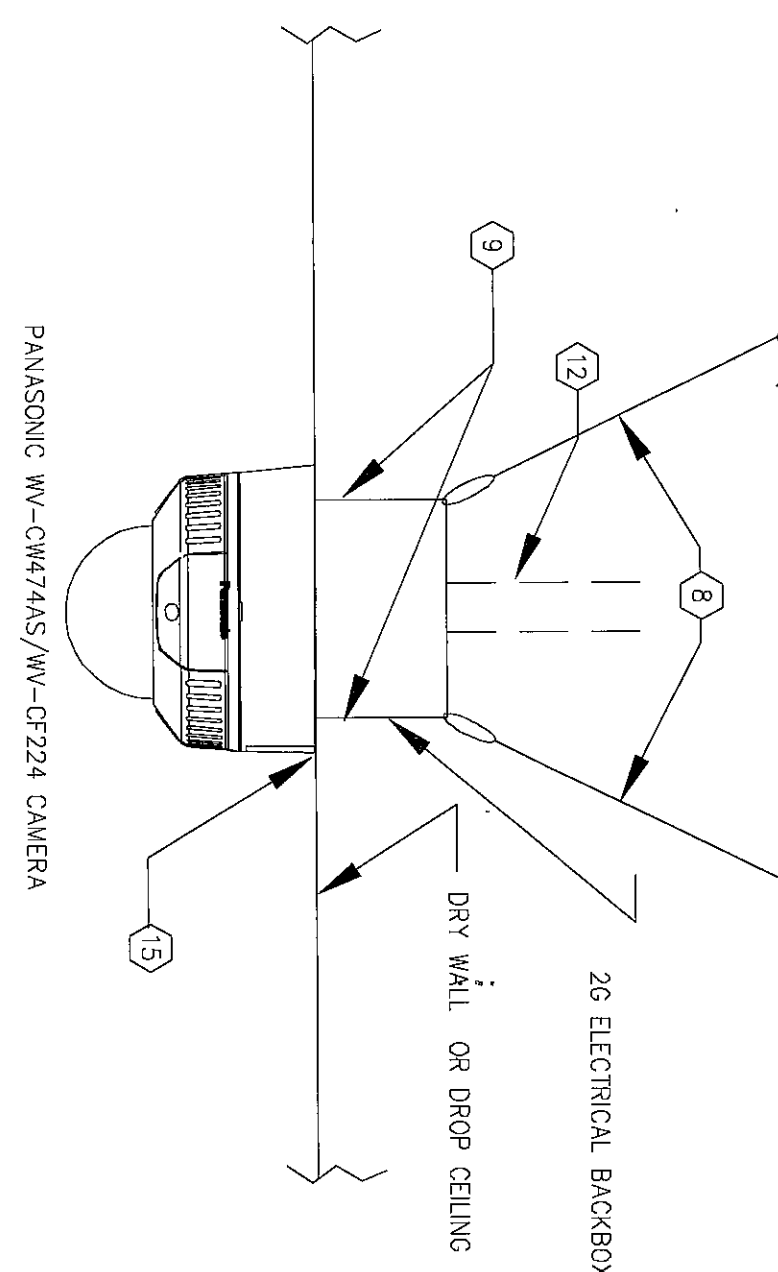

5. INTERIOR CAMERA - CEILING, DRY WALL / DROP CEILING DETAIL  
TS.1 SCALE: NTS  
INSIDE BUILDING

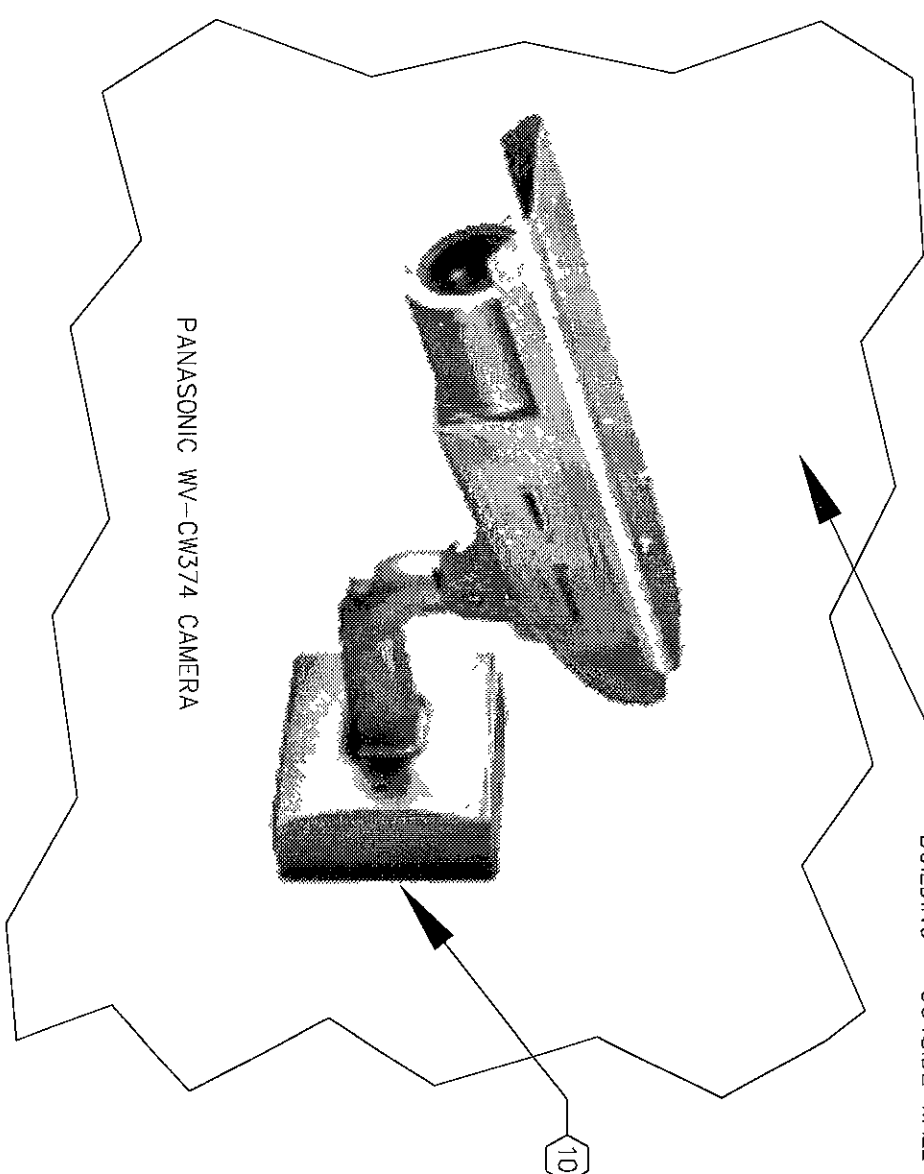

6. OUTSIDE FIXED LENS CAMERA DETAIL  
TS.1 SCALE: NTS  
OUTSIDE

DUNELAND SCHOOL CORPORATION  
CHESTERTON MIDDLE SCHOOL  
CHESTERTON, INDIANA  
CCTV SYSTEM

PROJECT: 04-1033  
DRAWN BY: RJJ  
CHECKED BY: LMD  
SCALE: 1/8"=1'-0"  
DATE: 04.28.2005

**DSA, Inc.**  
Technology Design Consultants  
16618 East 196 th Street  
Noblesville, IN 46060-9530  
(765) 534-5152

REVISIONS/DATE  
1. 11/16/05 AS-BUILDS

DRAWING NUMBER  
T5.1

2005-11-11