6 FT

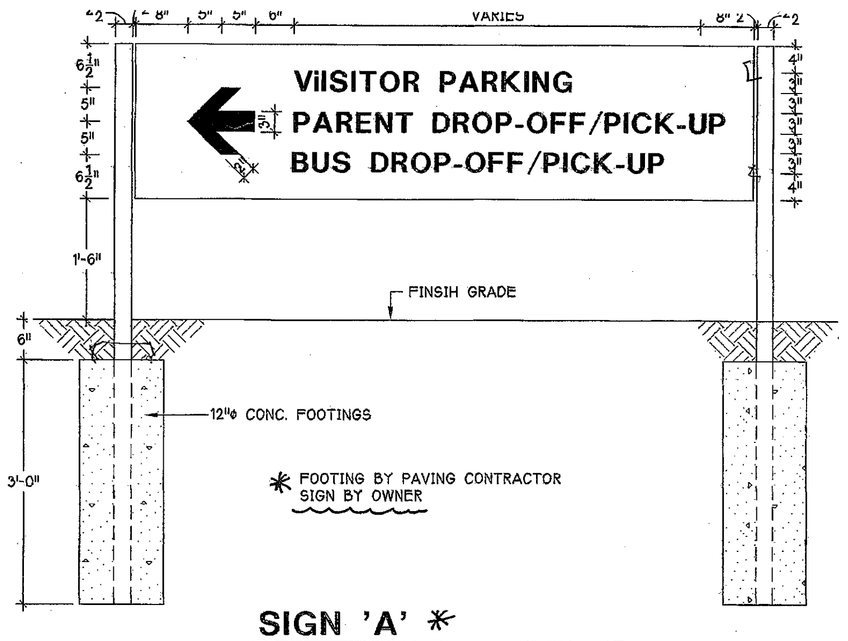

SIGN 'A' *

NO SCALE

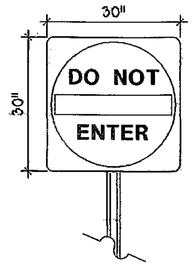

"DO NOT ENTER" SIGN SHALL BE TYPE R5-1 AS SHOWN IN THE CURRENT MUTCD MANUAL. THIS SIGN SHALL BE PLACED AND SHALL BE IN ACCORDANCE WITH ALL CURRENT MUTCD, INDOT, AND FHWA GUIDELINES AND SPECIFICATIONS.

SIGN 'B'

NO SCALE

DEMOLITION NOTES

1. REMOVE EXISTING TREE AND ROOT BALL TO MIN. 3 FT. BELOW GRADE AND DISPOSE OF OFF SITE.
2. SAWCUT EXISTING PAVEMENT, AND EXISTING ASPHALT CURB AND DISPOSE OF OFF SITE.
3. REMOVE EXISTING CONCRETE AND DISPOSE OF OFF SITE. TOPSOIL AND SEED DISTURBED AREA AS REQUIRED.
4. REMOVE EXISTING GRAVEL AND DISPOSE OF OFF SITE. TOPSOIL AND SEED DISTURBED AREA.

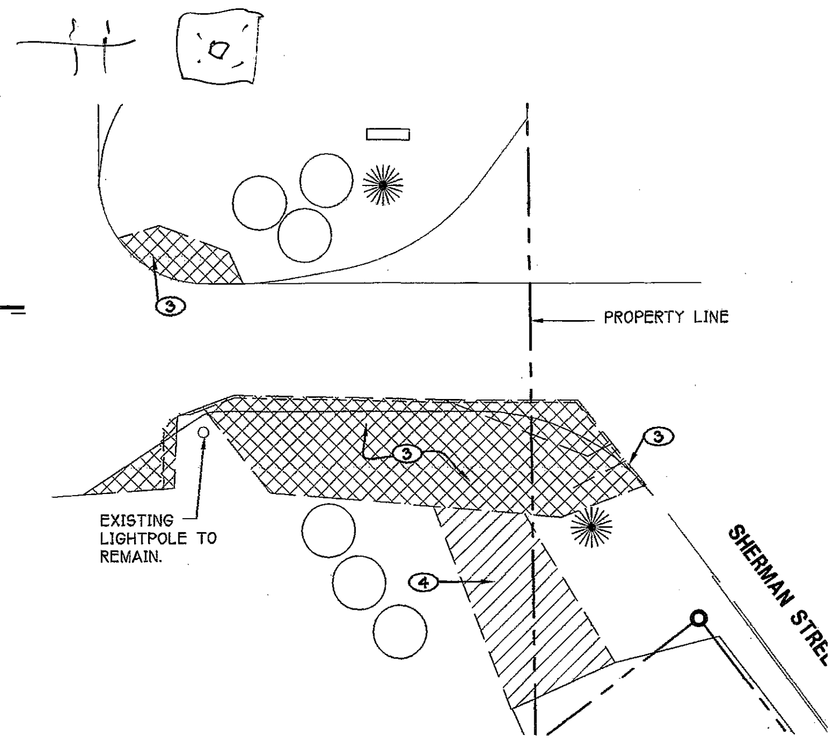

AA / SP-1b **SOUTH ENTRY DEMO PLAN**

1" = 20'-0"

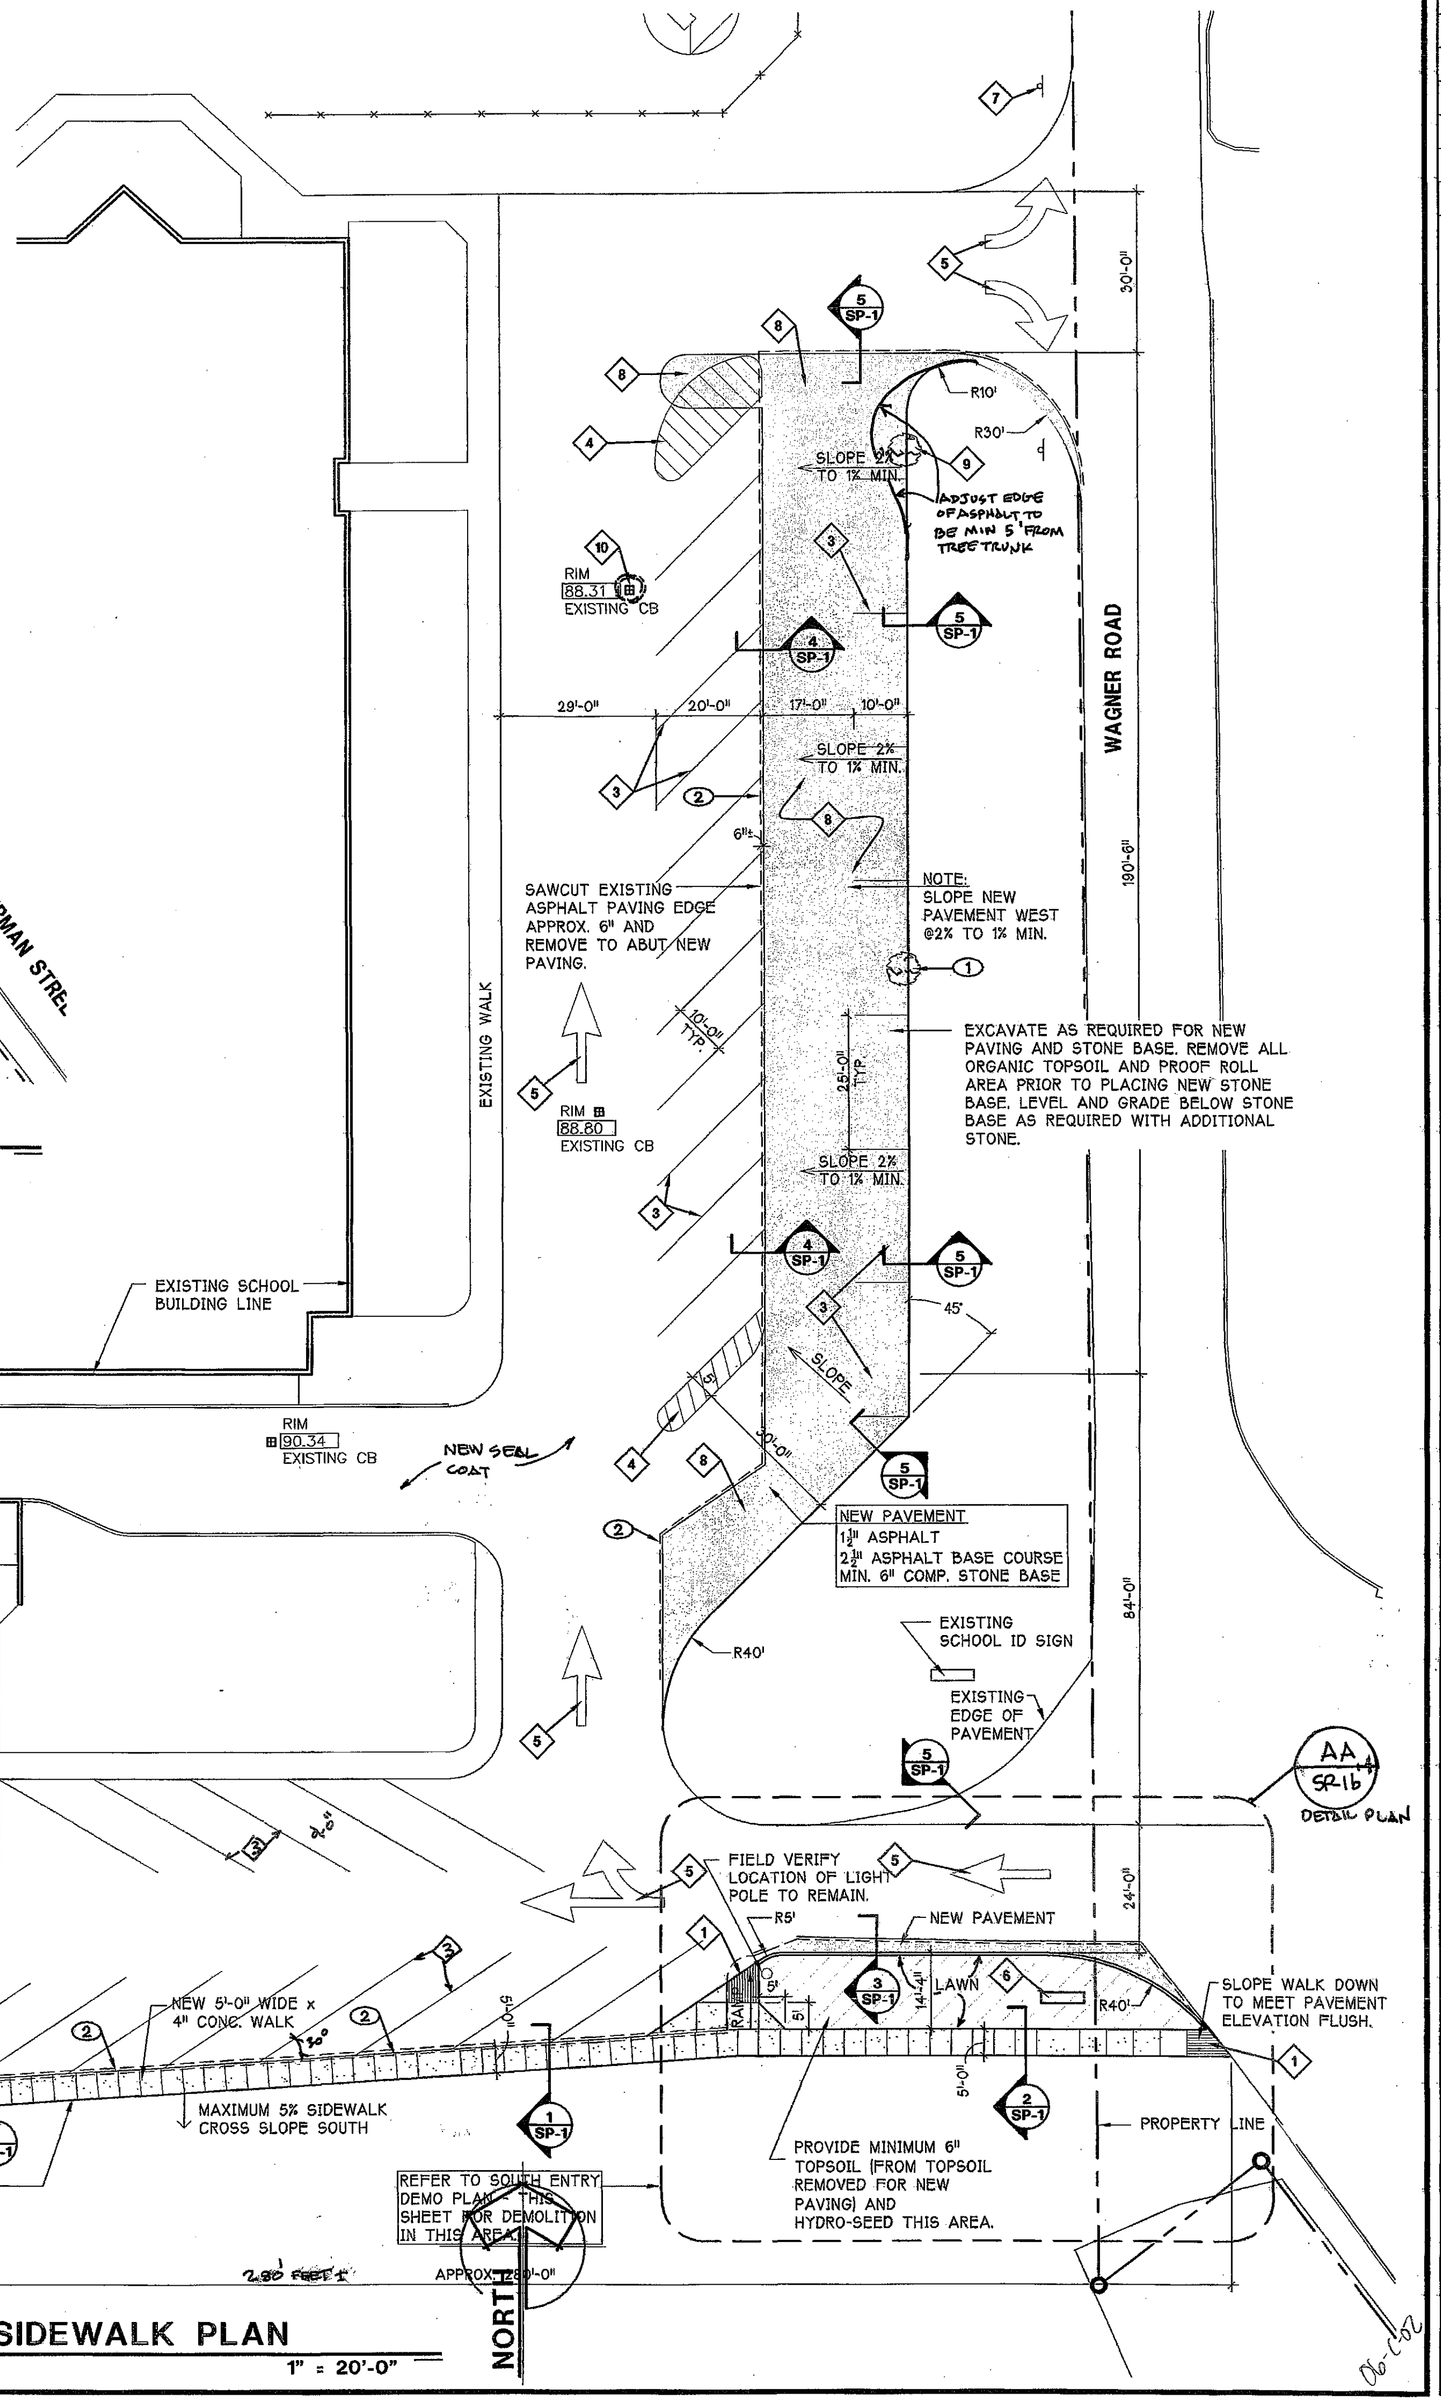

PLAN NOTES

1. HANDICAPP RAMP. REFER TO DETAIL 6/SP-1b.
2. PAINTED CROSSWALK. 4" WIDE DIAGONAL LINES 2'-0" O.C.
3. 4" WIDE PAINTED STRIPE.
4. 4" WIDE PAINTED STRIPE 3'-0" O.C.
5. PAINTED PAVEMENT ARROW
6. DIRECTIONAL SIGN, REFER TO SIGN 'A' THIS SHEET.
7. 'DO NOT ENTER' SIGN. REFER TO SING 'B' THIS SHEET.
8. NEW PAVEMENT AND STONE BASE.
9. FIELD VERIFY LOCATION AND PROTECT EXISTING TREE TO REMAIN.
10. CUT OUT PAVEMENT 2' AROUND CATCH BASIN CASTING, FILL AND COMPACT WITH STONE AND REPLACE WITH 2"+2" ASPHALT.

PARKING LOT/SIDEWALK PLAN

1" = 20'-0"

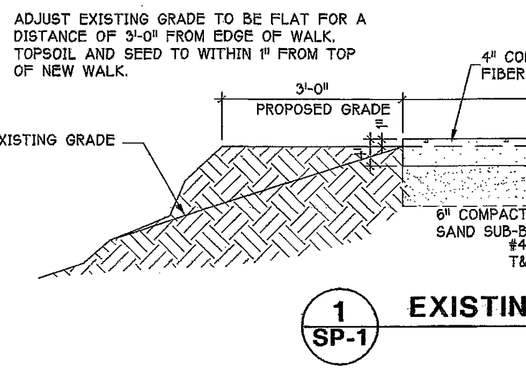

1/SP-1 **EXISTING PVMT @ CURB/WALK**

3/4" = 1'-0"

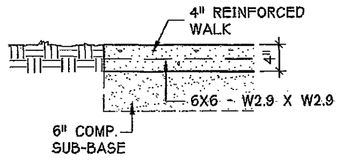

2/SP-1 **CONCRETE WALK**

3/4" = 1'-0"

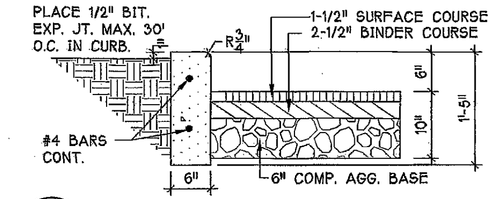

3/SP-1 **NEW PVMT @ NEW CURB**

3/4" = 1'-0"

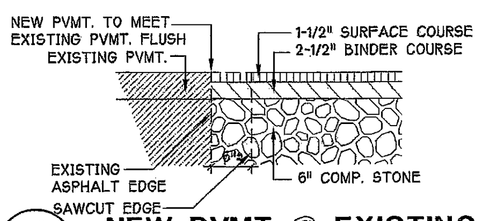

4/SP-1 **NEW PVMT @ EXISTING PVMT**

3/4" = 1'-0"

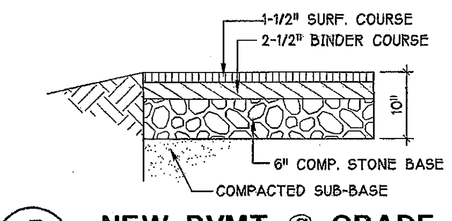

5/SP-1 **NEW PVMT @ GRADE**

3/4" = 1'-0"

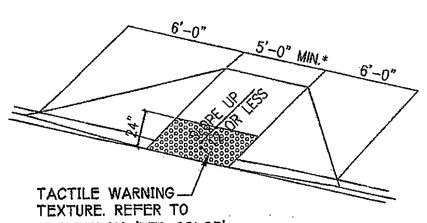

*NOTE: RAMP WIDTH IS TO BE 5' UNLESS OTHERWISE NOTED ON THE PLAN.

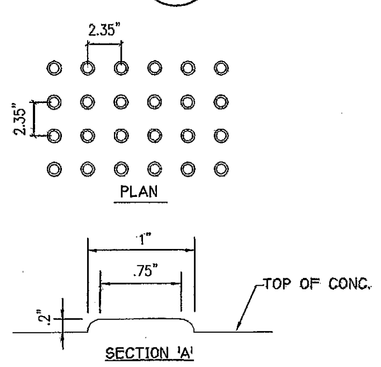

NOTE: INSTALL TACTILE WARNING TEXTURE AT THE TOP OF ALL EXTERIOR STEPS AND RAMPED WALKS THAT EXCEED 1:20 SLOPE, IN A BAND 3'-0" DEEP x WIDTH OF STEPS OR WALK.

6/SP-1 **CURB RAMP**

NOT TO SCALE

REVISIONS	BY

SITE IMPROVEMENT PLANS & DETAILS

YOST ELEMENTARY SCHOOL PARKING

CHESTERTON, INDIANA

100 BEAM STREET

gerometta & kinel architects, inc.

chesterton, Indiana

DATE	7-27-06
SCALE	AS NOTED
DRAWN	NJK
JOB	2623a
SHEET	SP-1b
OF	3 SHEETS