

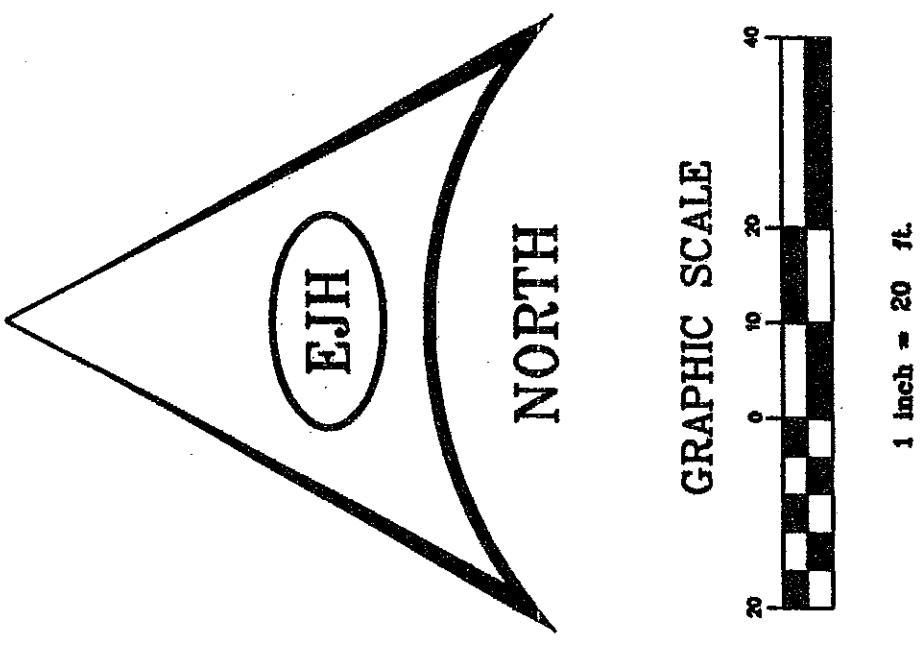


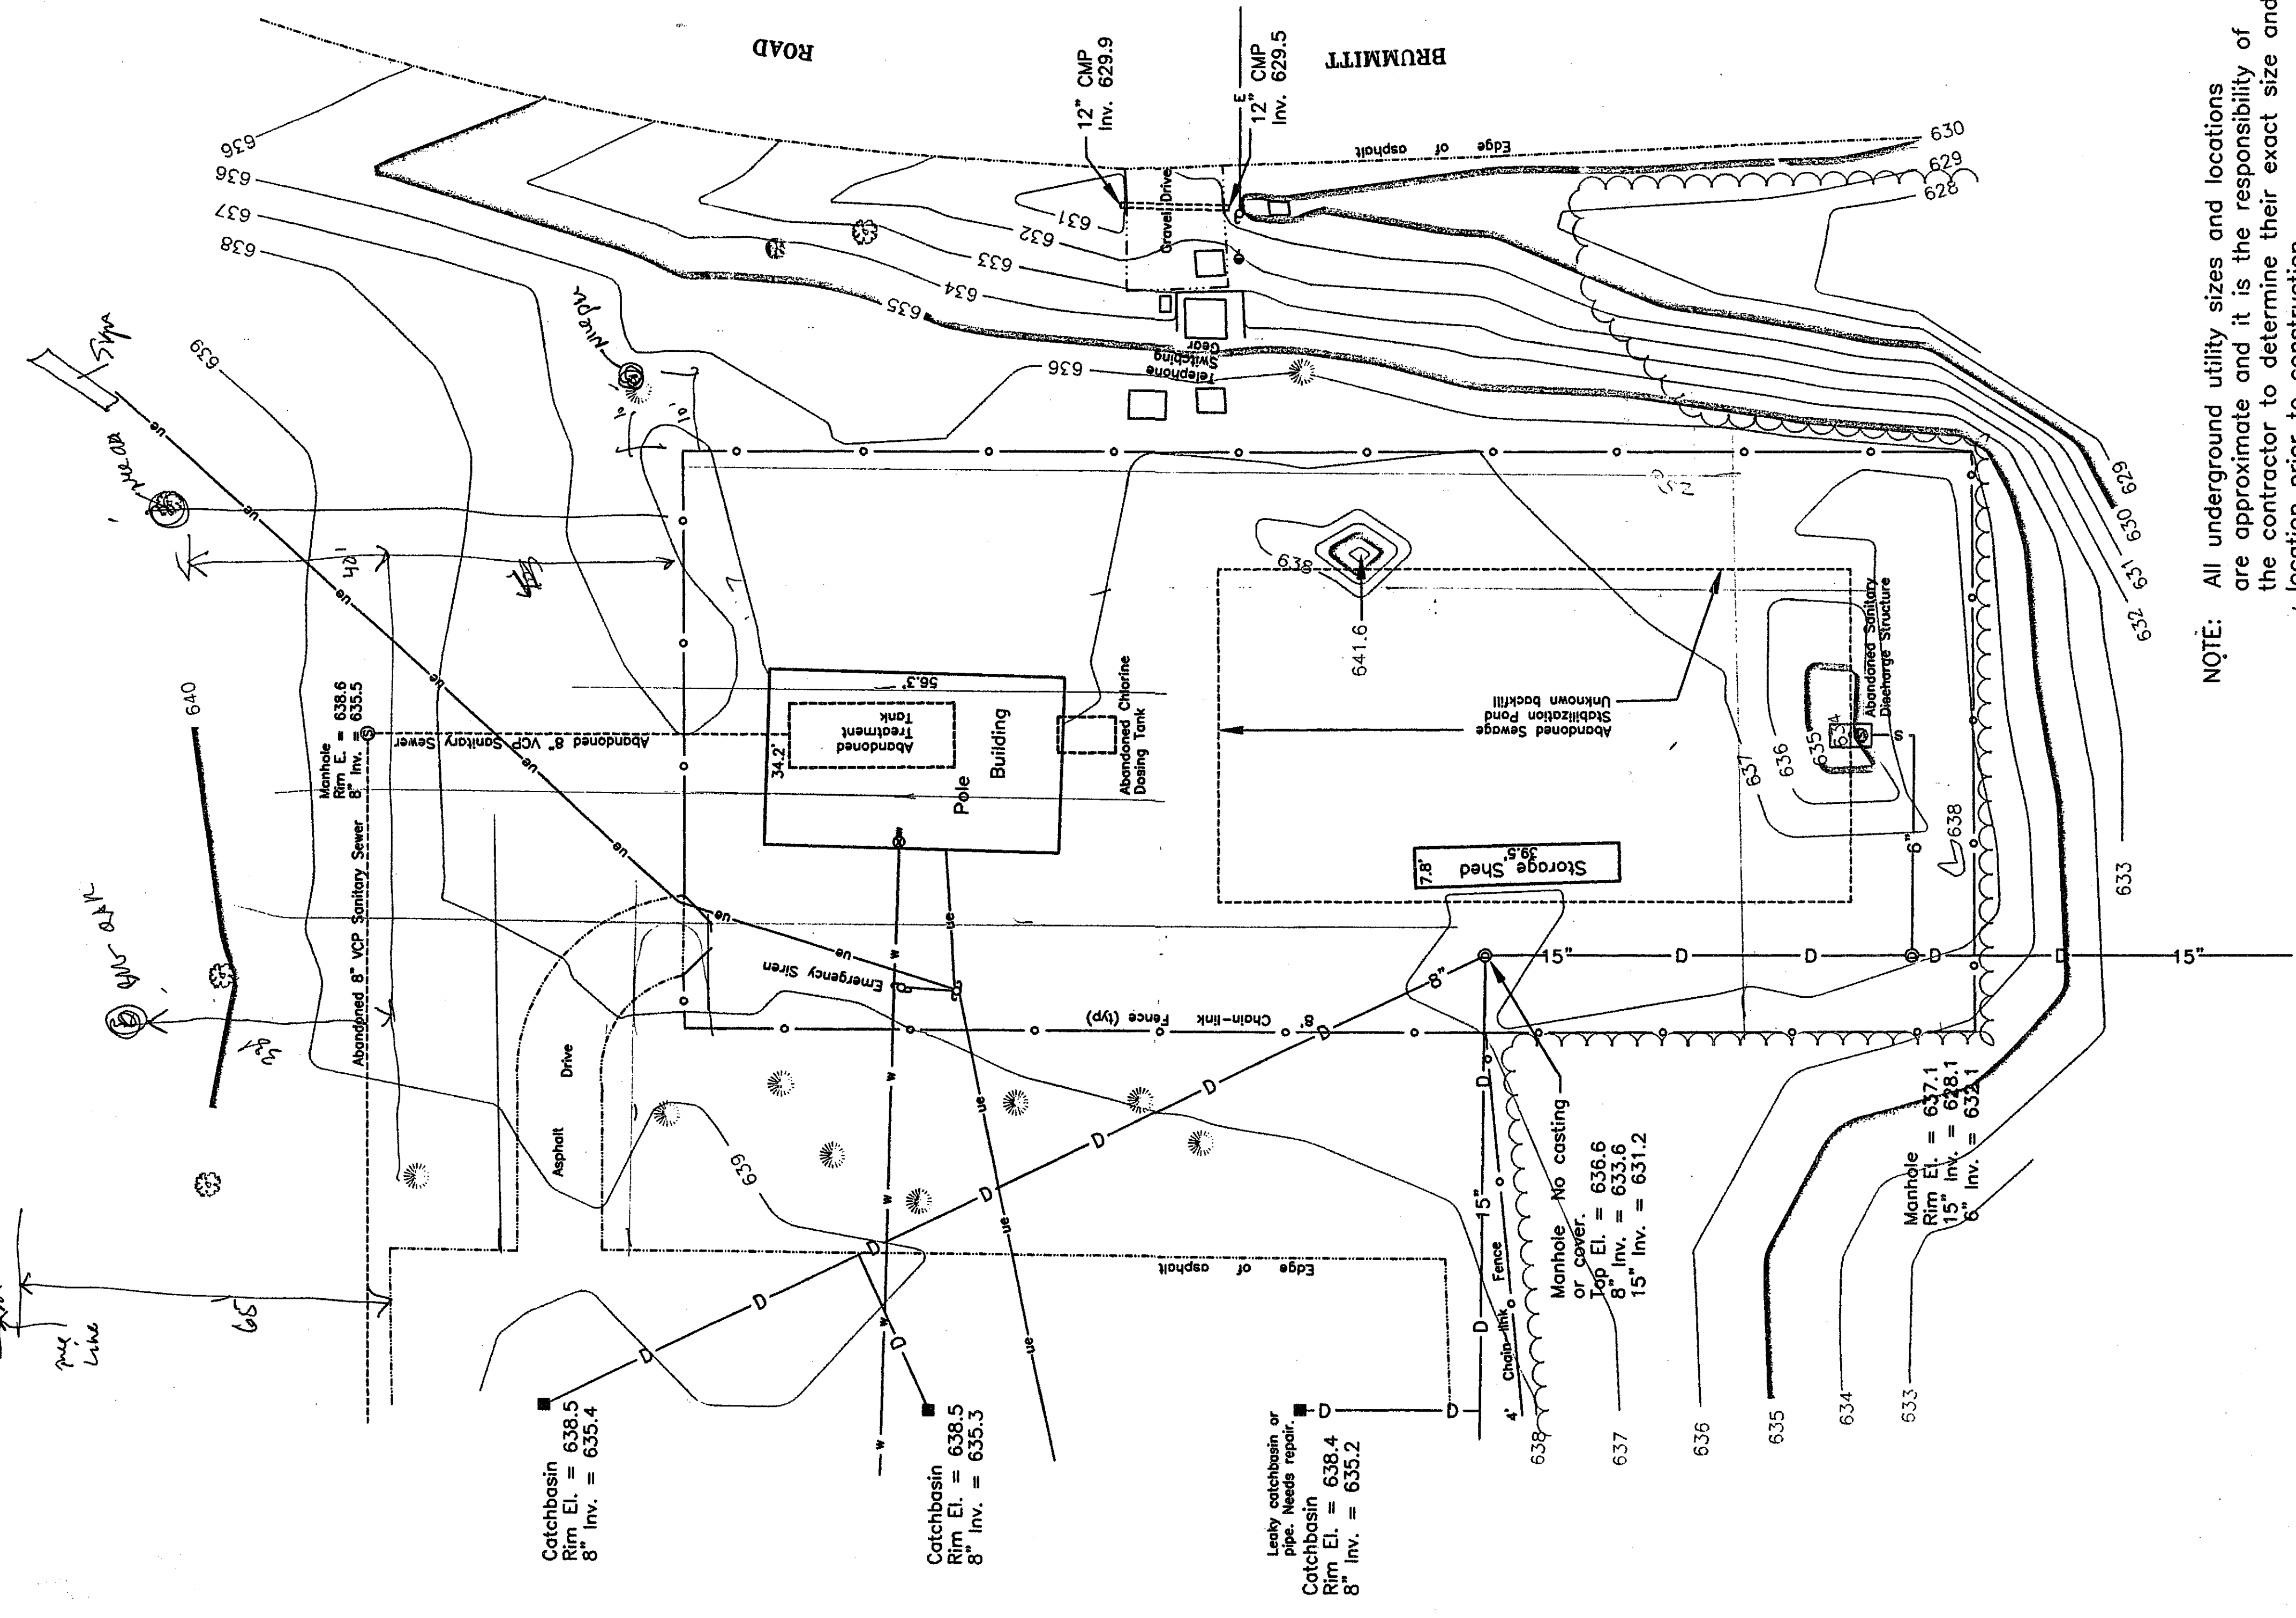

- LEGEND**
- Found Monument
 - Found Iron Marker
 - Found PK Nail
 - Found Railroad Spike
 - Set Railroad Spike
 - Set Monument
 - Set PK Nail
 - Set Iron Marker & Cap
 - Deed, Plat or Record
 - Fence
 - Utility Pole
 - Light Pole
 - Guy
 - Electric Meter
 - Gas Meter
 - Storm Sewer Manhole
 - Sanitary Sewer Manhole
 - Telephone Manhole
 - Cable TV Riser
 - Water Valve
 - Water Shut Off
 - Well
 - Electric Line
 - Gas Line
 - Storm Sewer Line
 - Sanitary Sewer Line
 - Telephone Line
 - Water Line

STATE OF INDIANA: S.S.
COUNTY OF PORTER:
This is to certify that I have or under my direct supervision completed a partial topographic survey of the property shown hereon and to the best of my knowledge and belief this is a correct plat of said survey.
Edward J. Hutson
Edward J. Hutson, RLS #50208

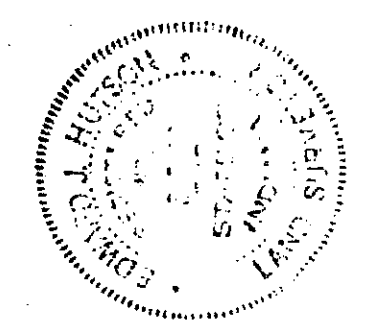

67-b-01

PARTIAL TOPOGRAPHIC SURVEY			
DATE: 11-9-05	PROJECT: Brummitt Elementary School	DATE: 11-9-05	FILE: 2214
SCALE: 1" = 20'			
NE 1/4, SECTION 32, T37N, R5W			
For: Dunceland School Corp.		JOB NUMBER: 60255	
E. J. HUTSON & ASSOCIATES		601 CHESTNUT BLVD. CHESTERTON, INDIANA 46304 PHONE 219-926-2358	

NOTE: All underground utility sizes and locations are approximate and it is the responsibility of the contractor to determine their exact size and location prior to construction.