
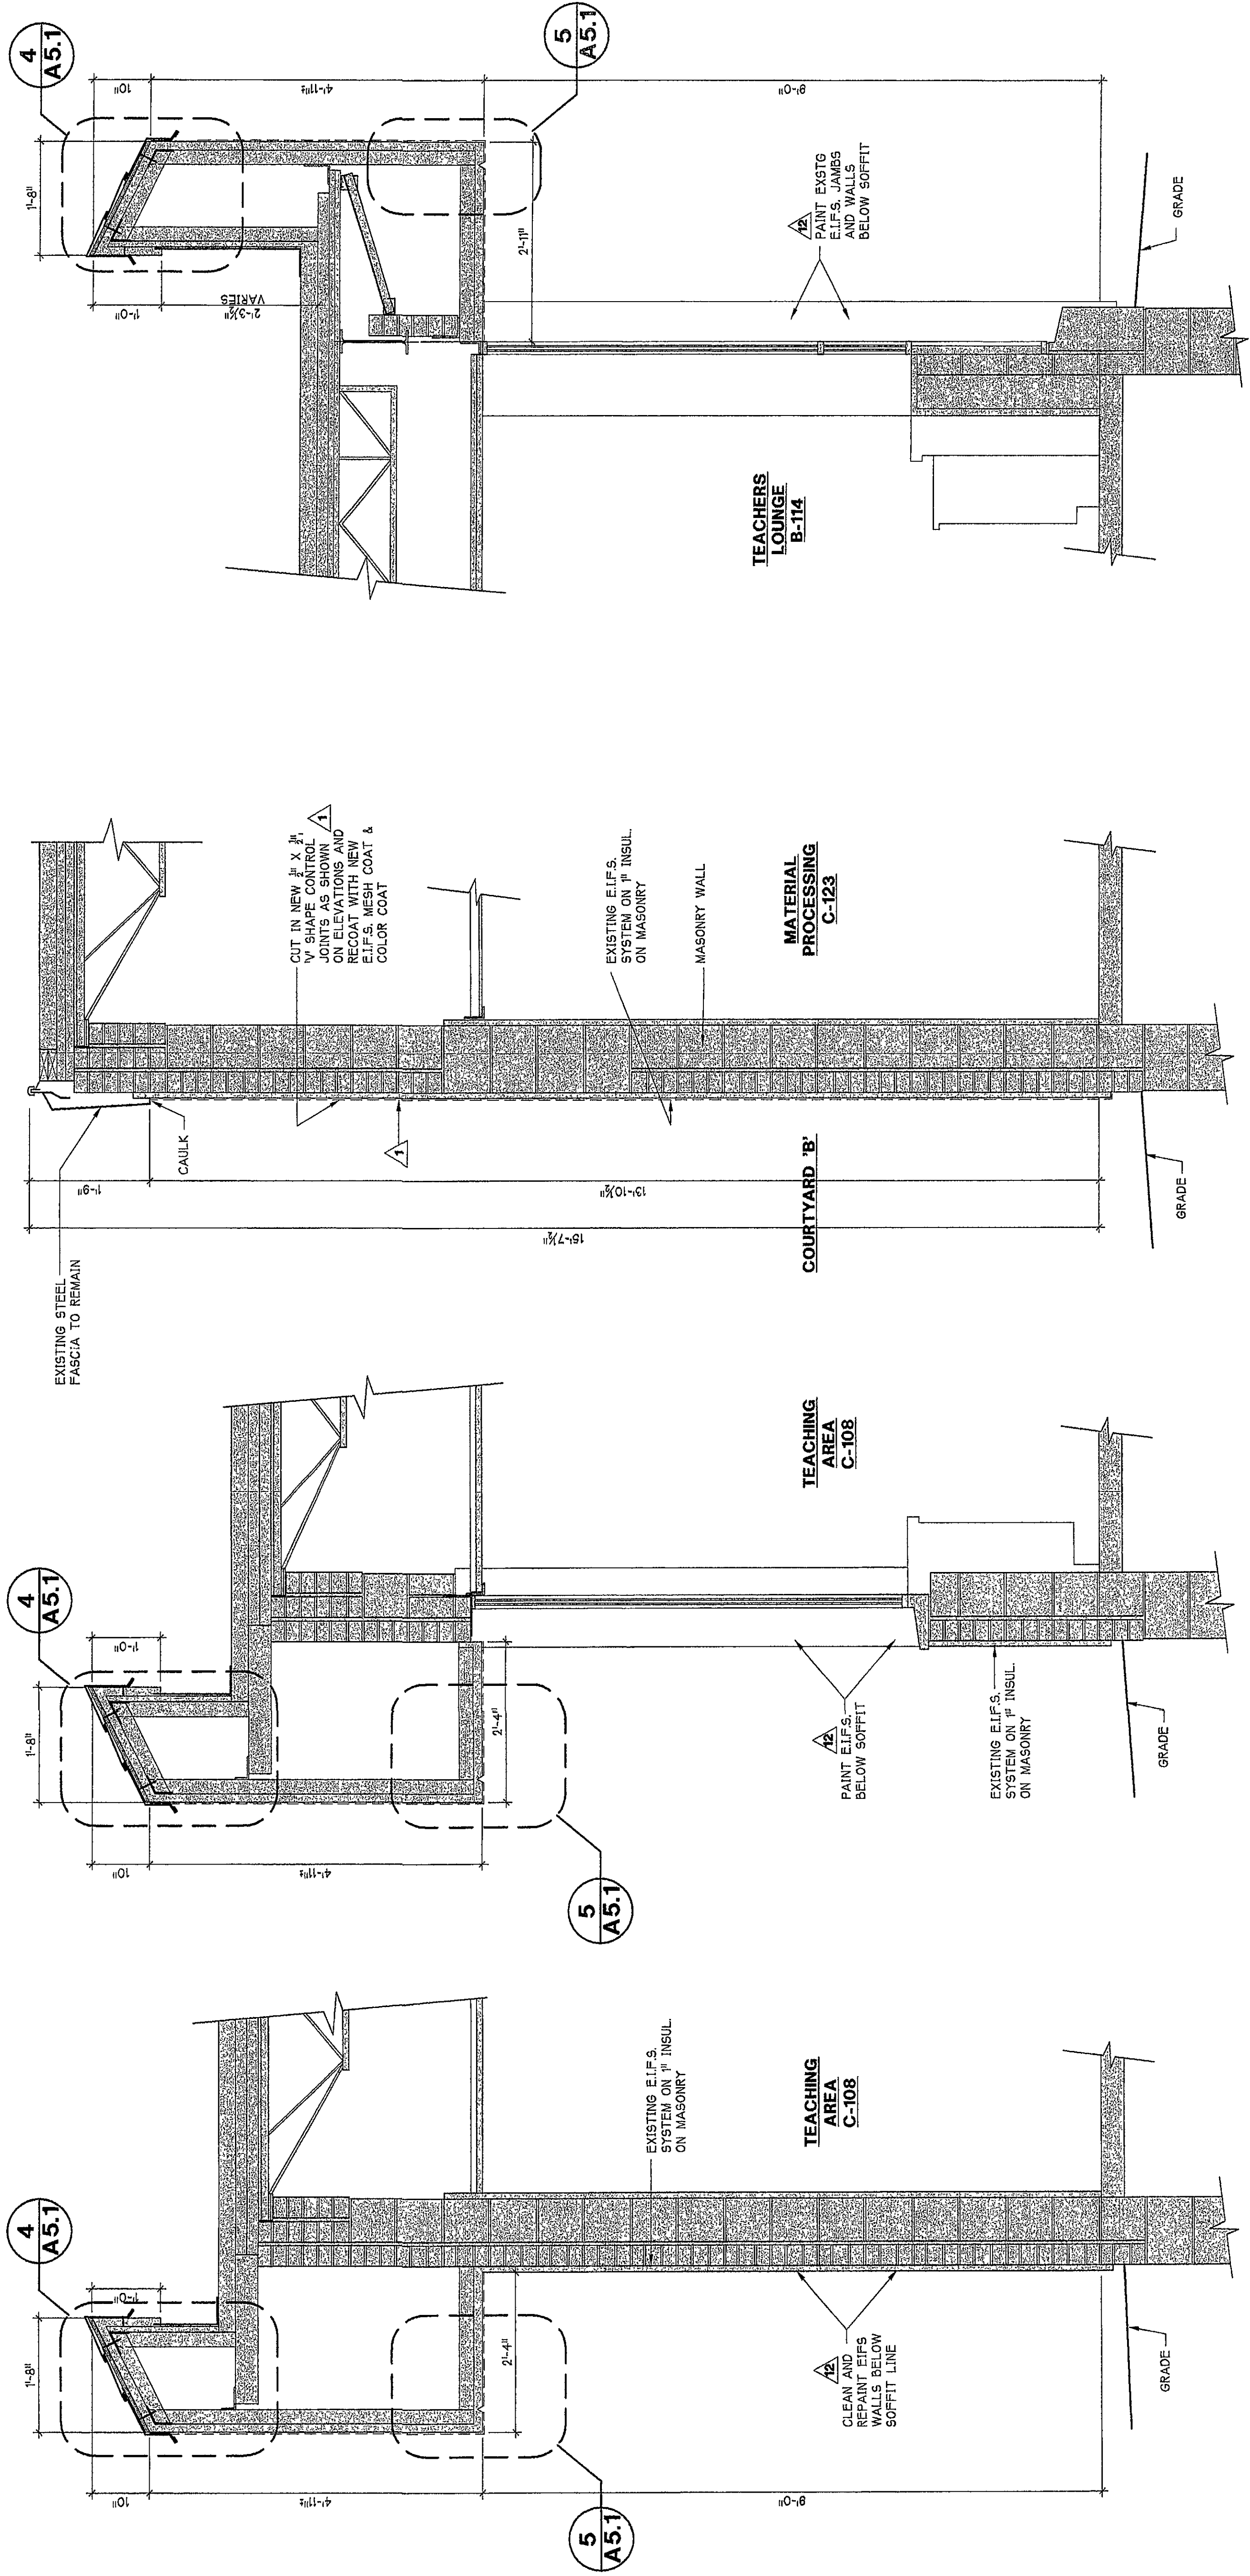


REVISIONS	BY

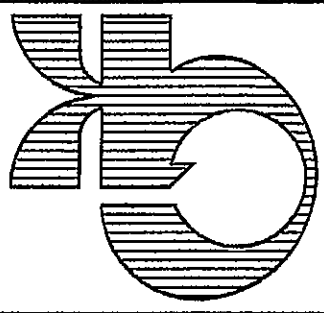

4 WALL SECTION 3/4" = 1'-0" A4.2

3 WALL SECTION 3/4" = 1'-0" A4.2

2 WALL SECTION 3/4" = 1'-0" A4.2

1 WALL SECTION 3/4" = 1'-0" A4.2