



REVISIONS	BY



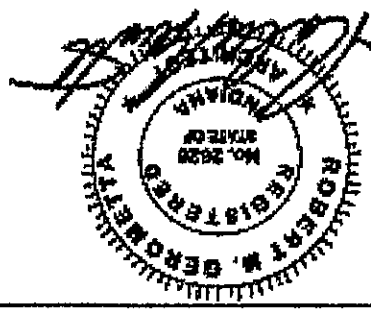


LIBERTY INTERMEDIATE SCHOOL - EXTERIOR WALL RENOVATION
50 WEST 900 NORTH
CHESTERSTON, INDIANA
gerometta & kinsel architects, inc.
chesterston, indiana

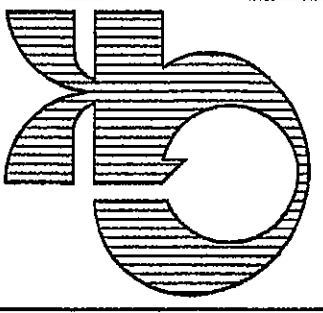


DATE	5-14-08
SCALE	3/4" = 1'-0"
DRAWN	LAS/NJK/JAV
JOB	2811


A5.1

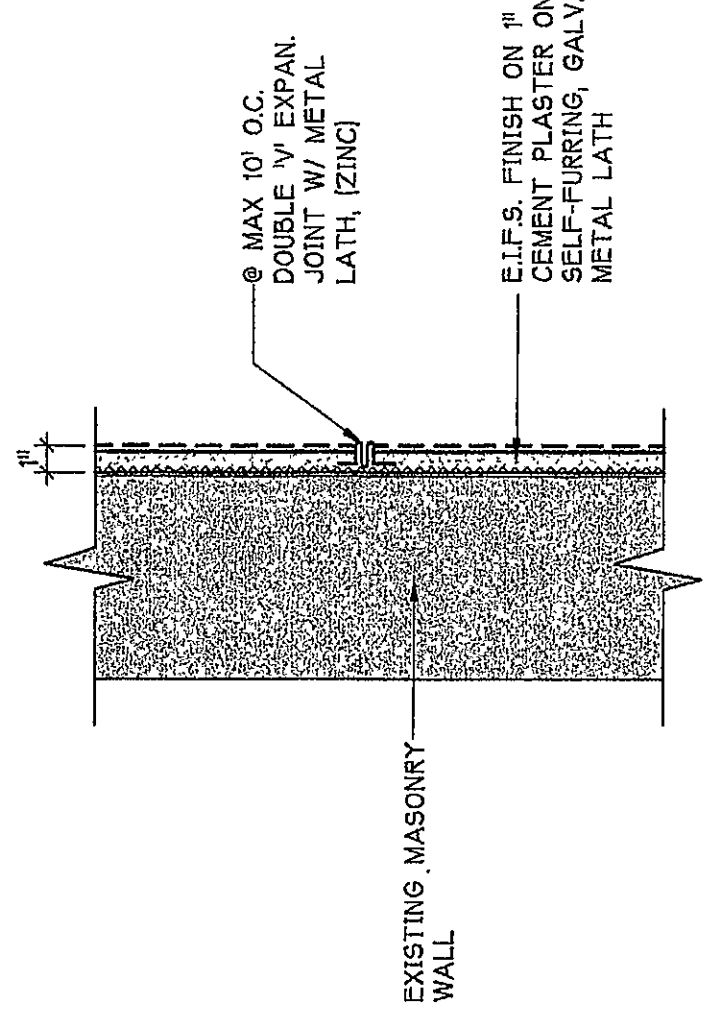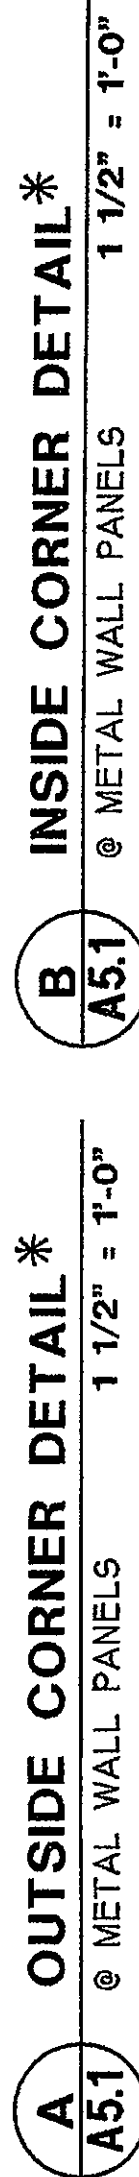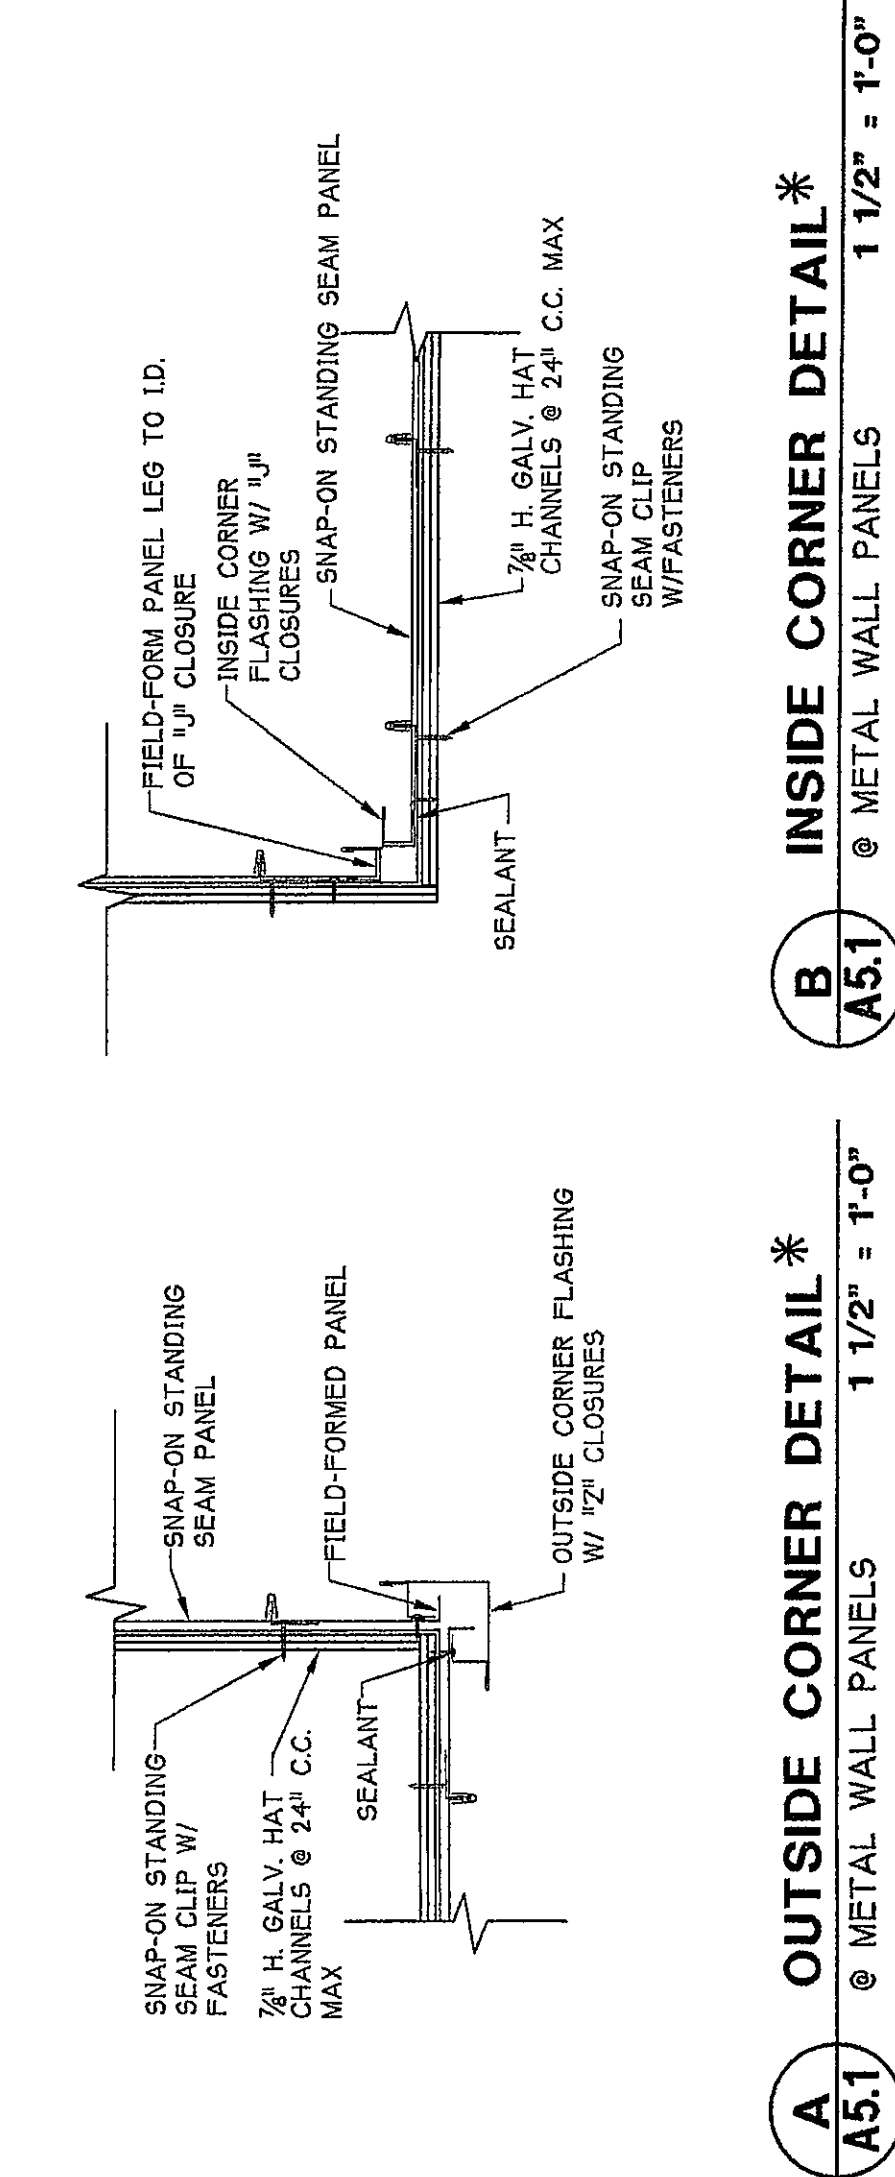

10 PLASTER DETAIL
A5.1 @ VERTICAL EXPANSION JOINT **1 1/2" = 1'-0"**

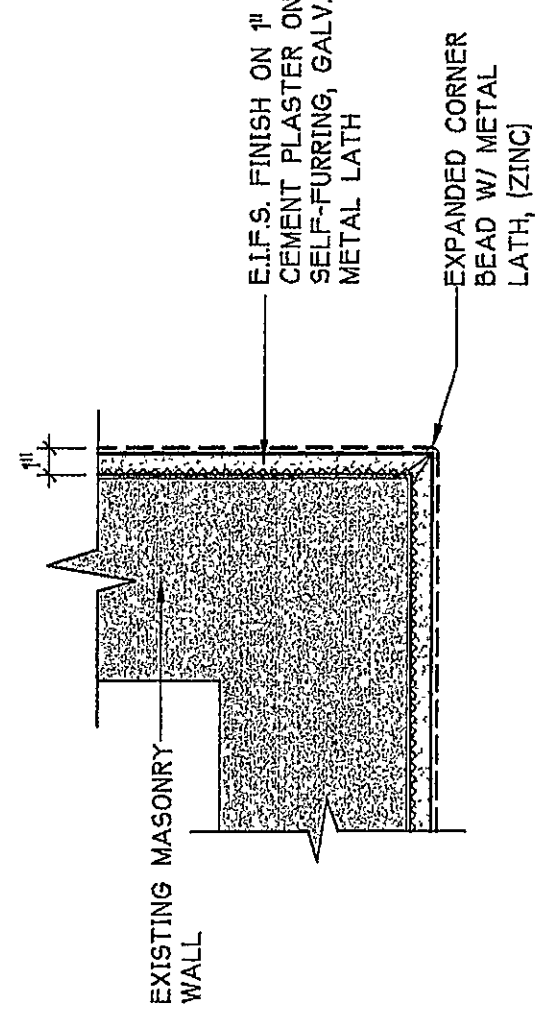


9 PLASTER CORNER DETAIL
A5.1 @ PLASTER INFILL **1 1/2" = 1'-0"**

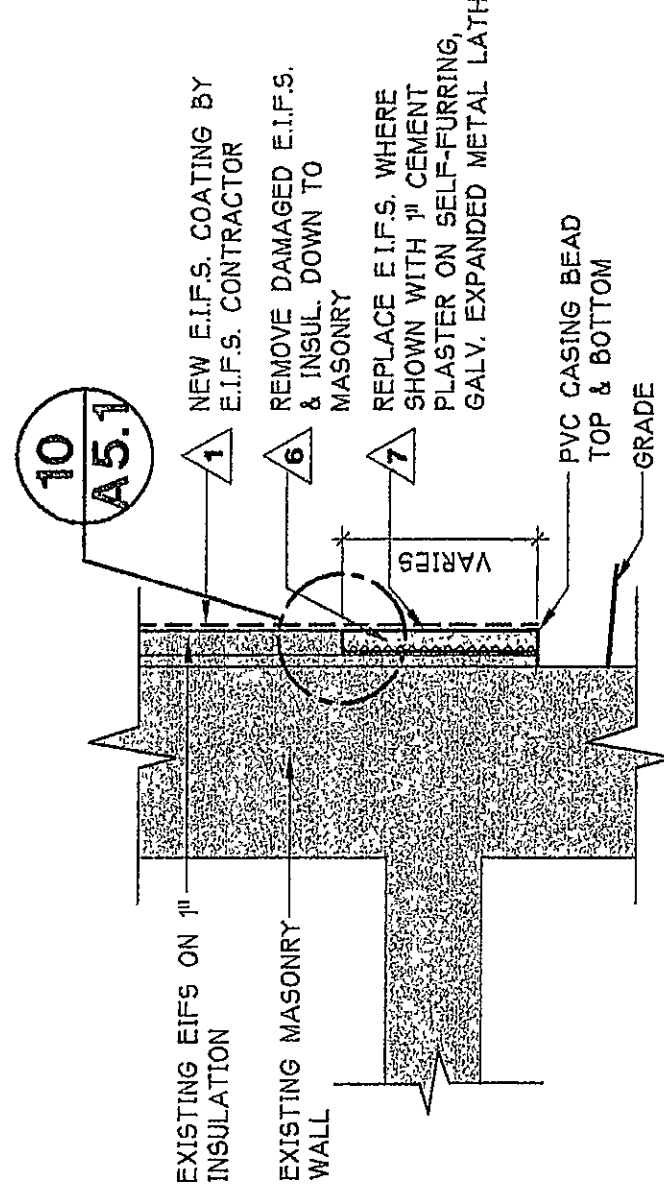


8 WALL BASE DETAIL


A5.1 @ PLASTER INFILL **1 1/2" = 1'-0"**

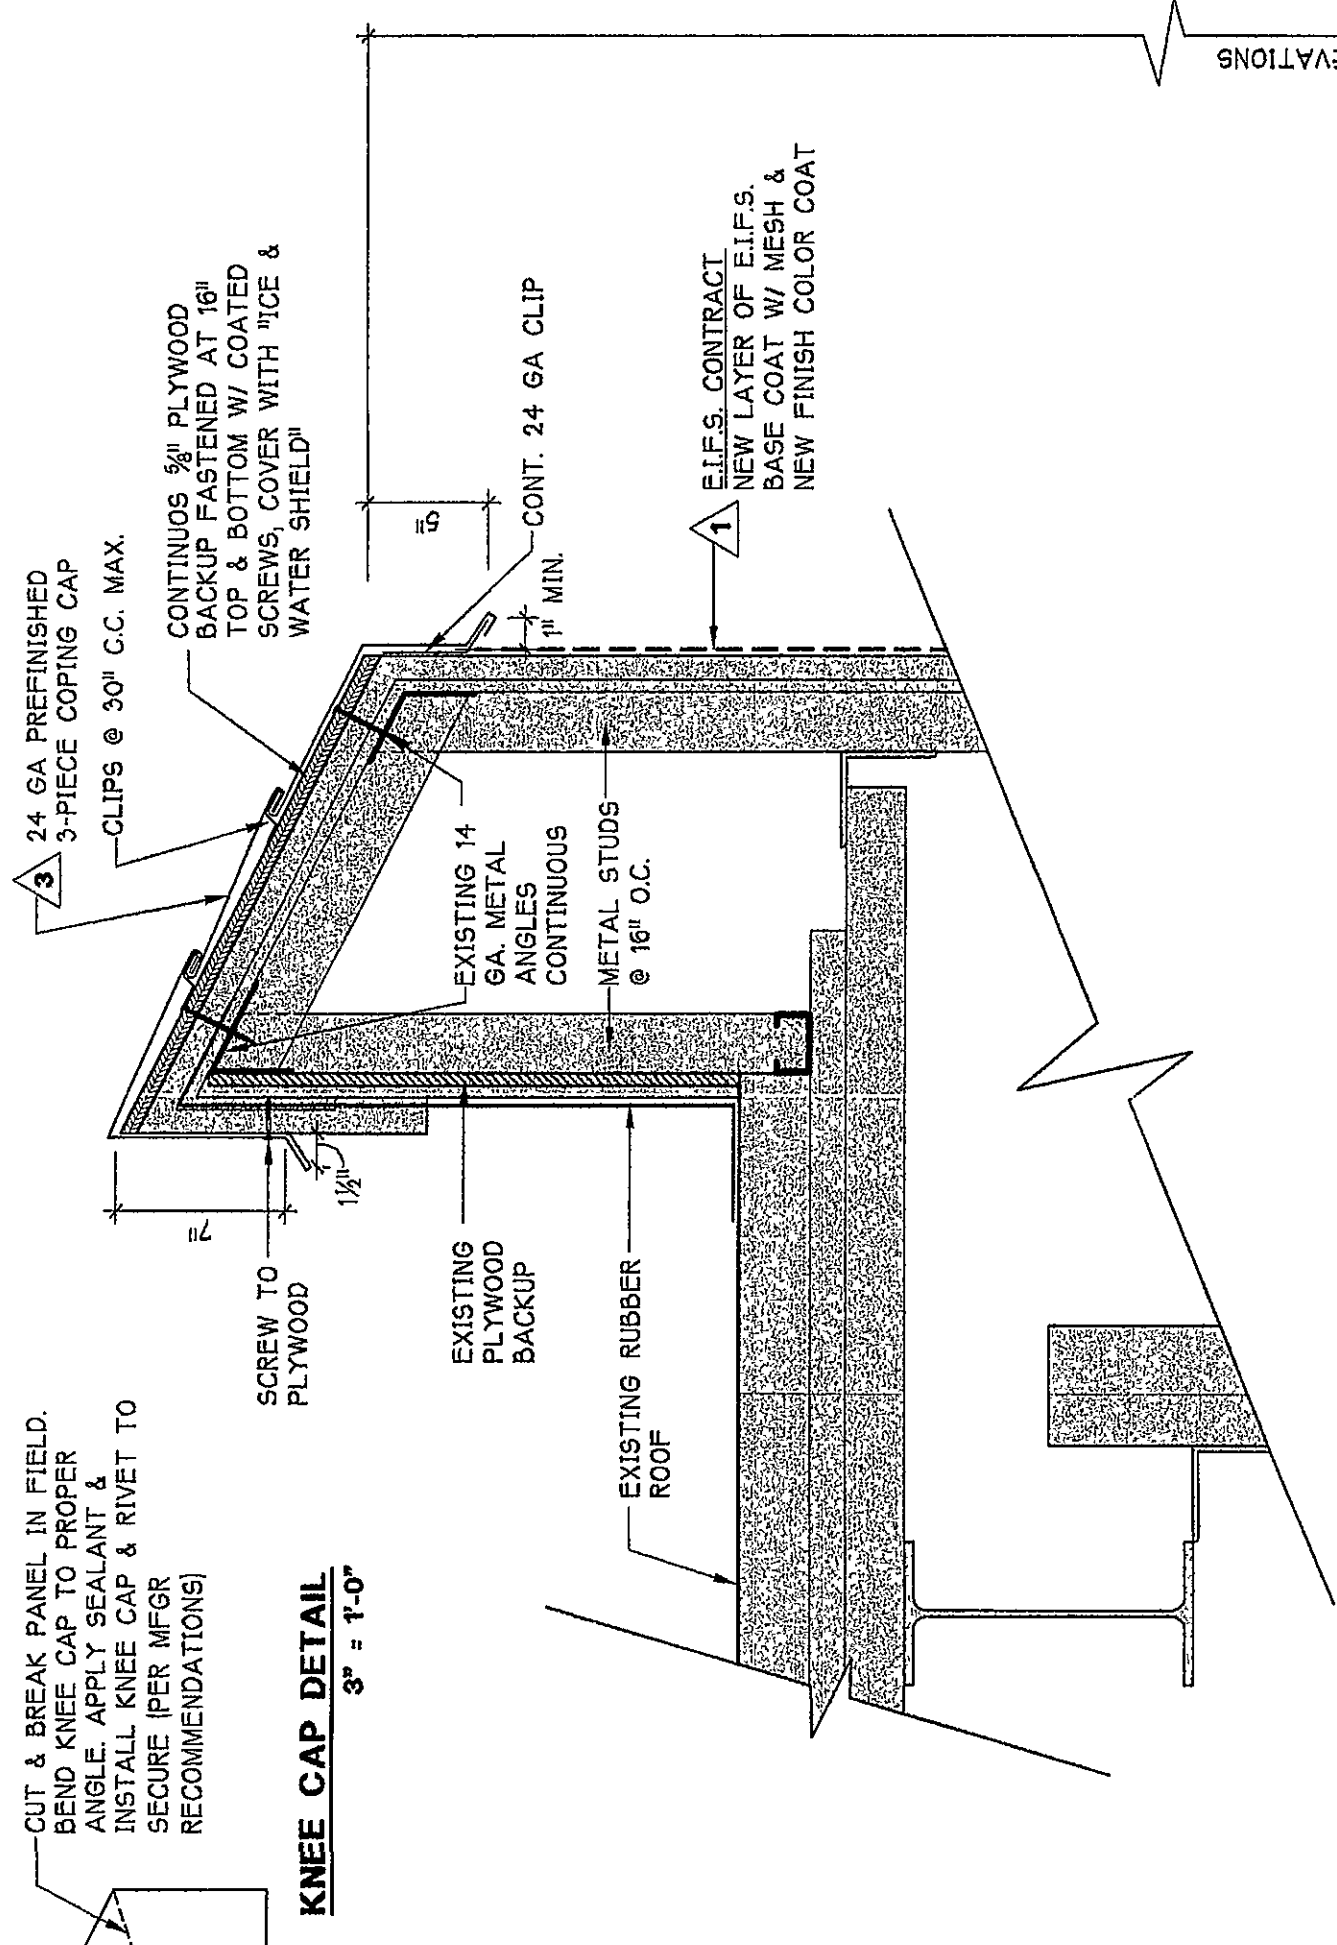


4 COPING CAP DETAIL
A5.1 @ E.I.F.S. WALLS & FASCIAS **1 1/2" = 1'-0"**

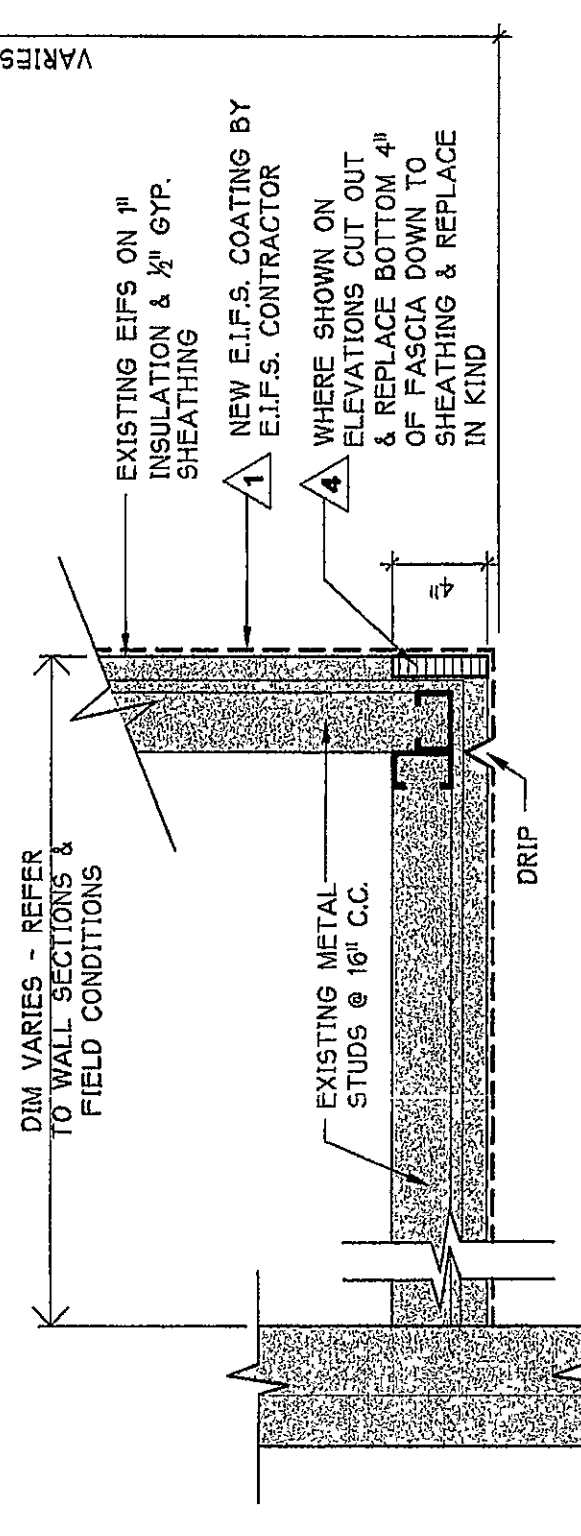


5 SOFFIT DETAIL
A5.1 @ FASCIA BOTTOM **1 1/2" = 1'-0"**

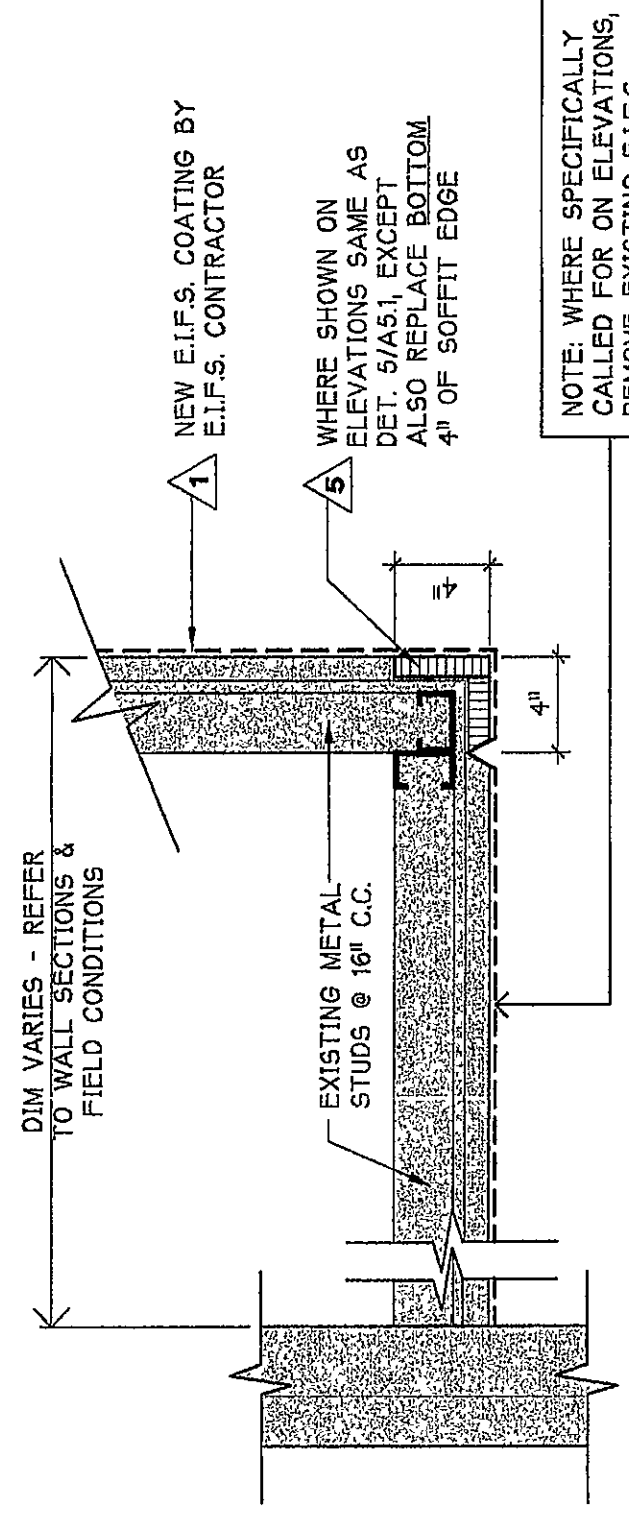


6 SOFFIT DETAIL
A51 @ FASCIA BOTTOM **1 1/2" = 1'-0"**

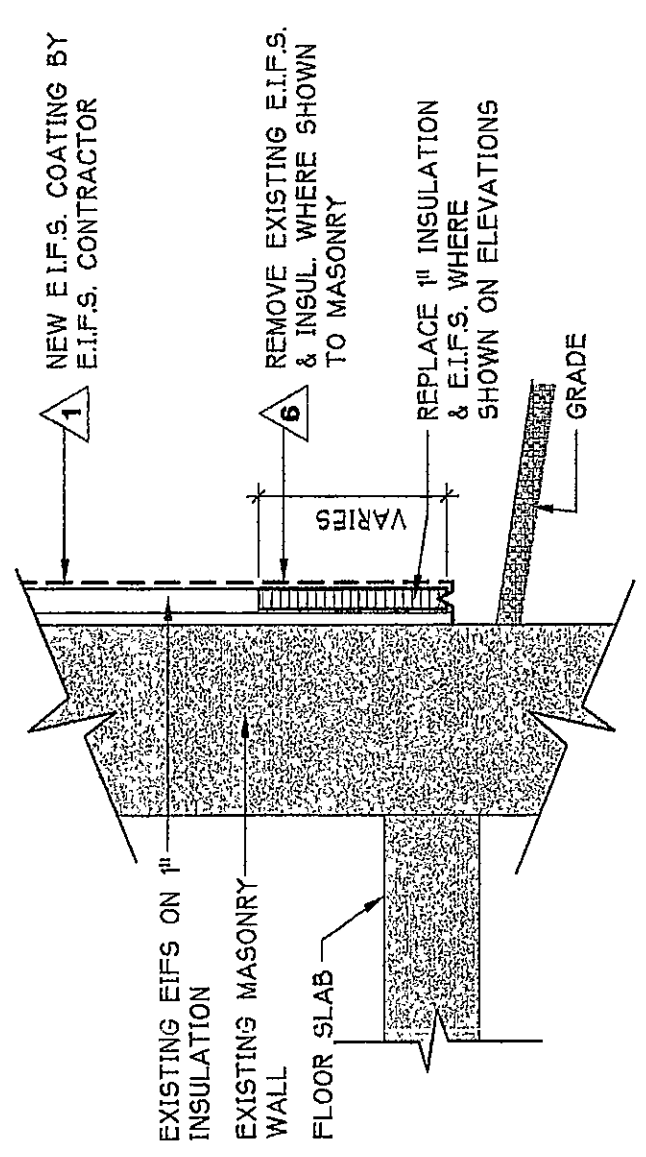


7 WALL BASE DETAIL

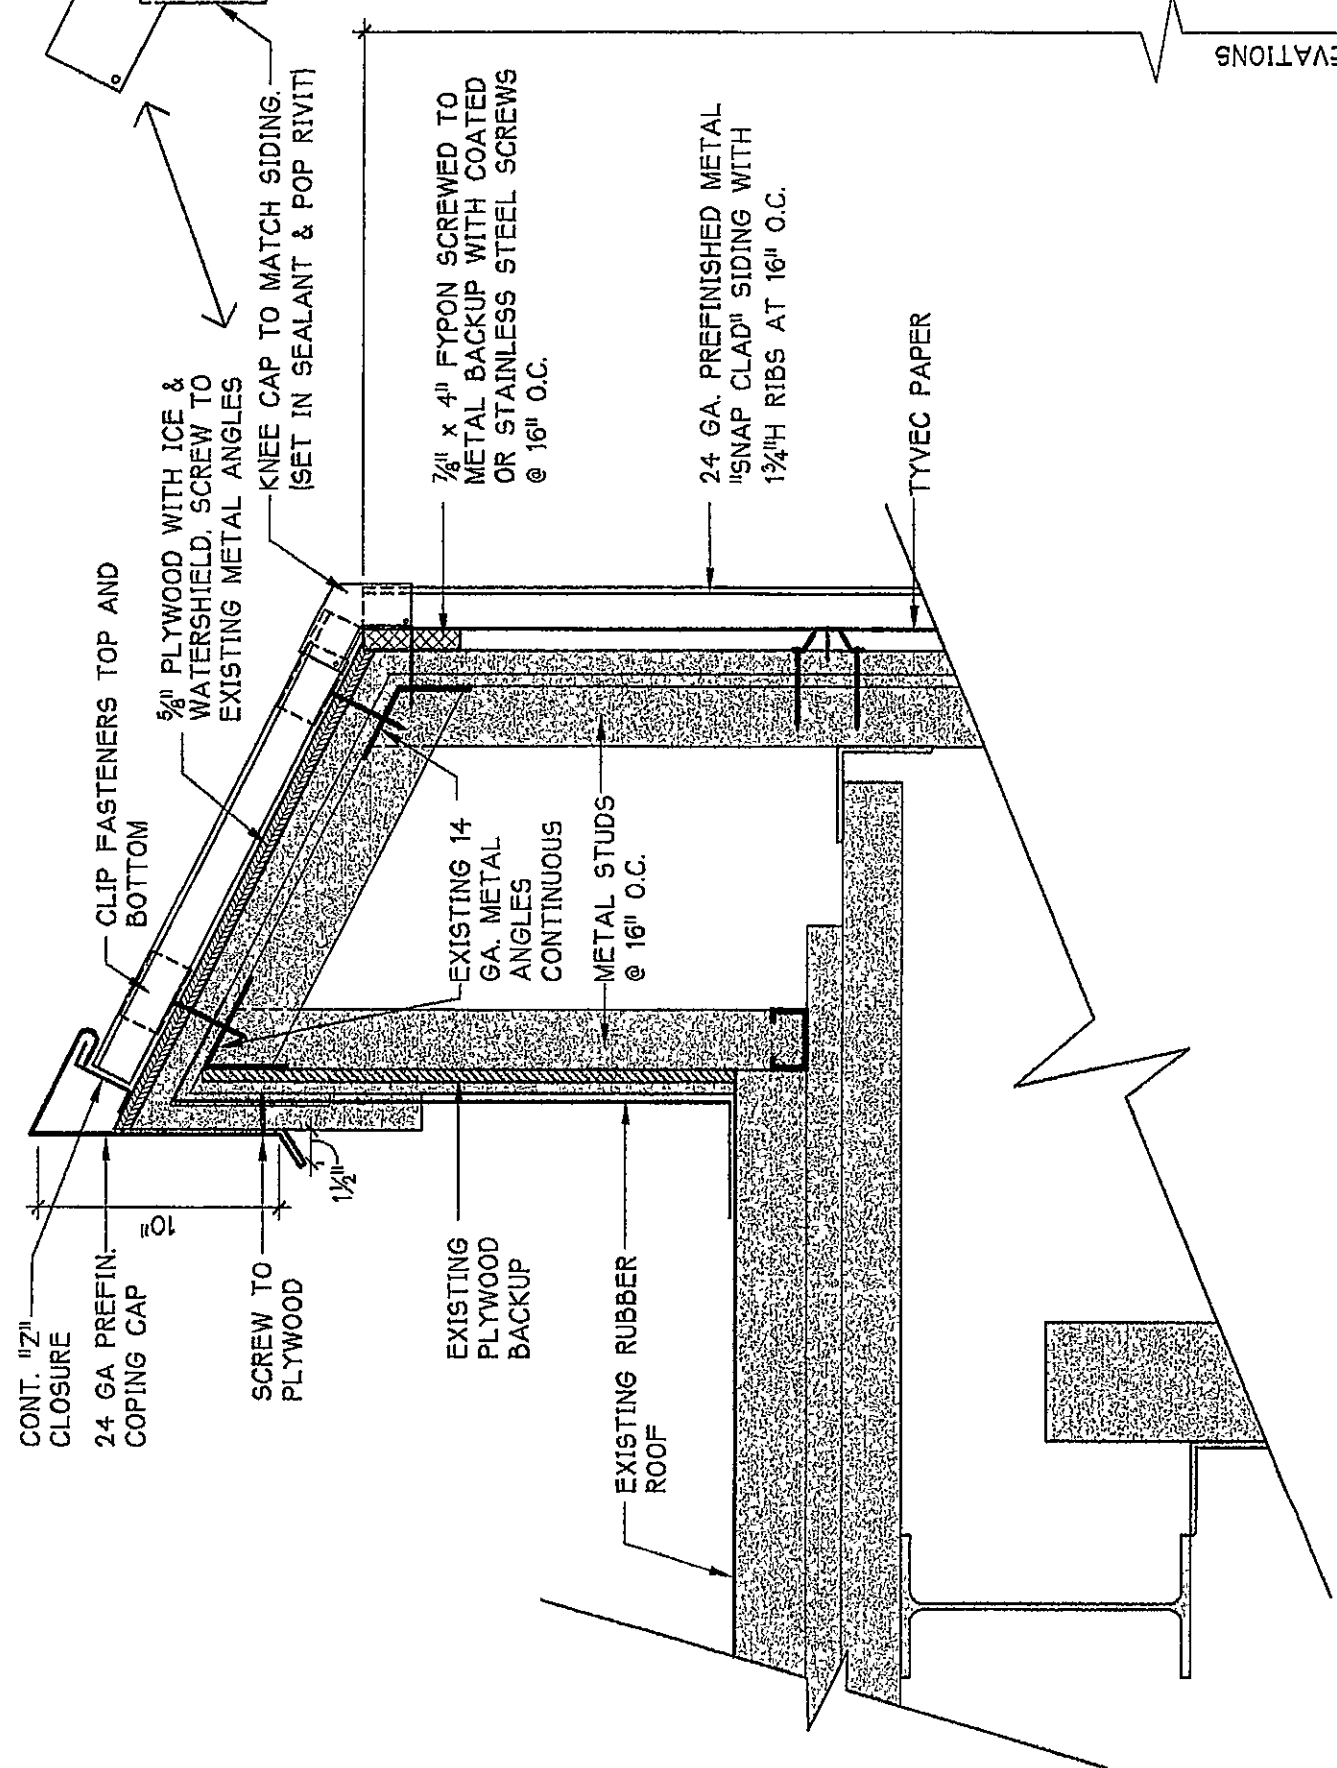

1 **COPING CAP DETAIL**
A5.1 @ METAL FASCIA **1 1/2" = 1'-0"**

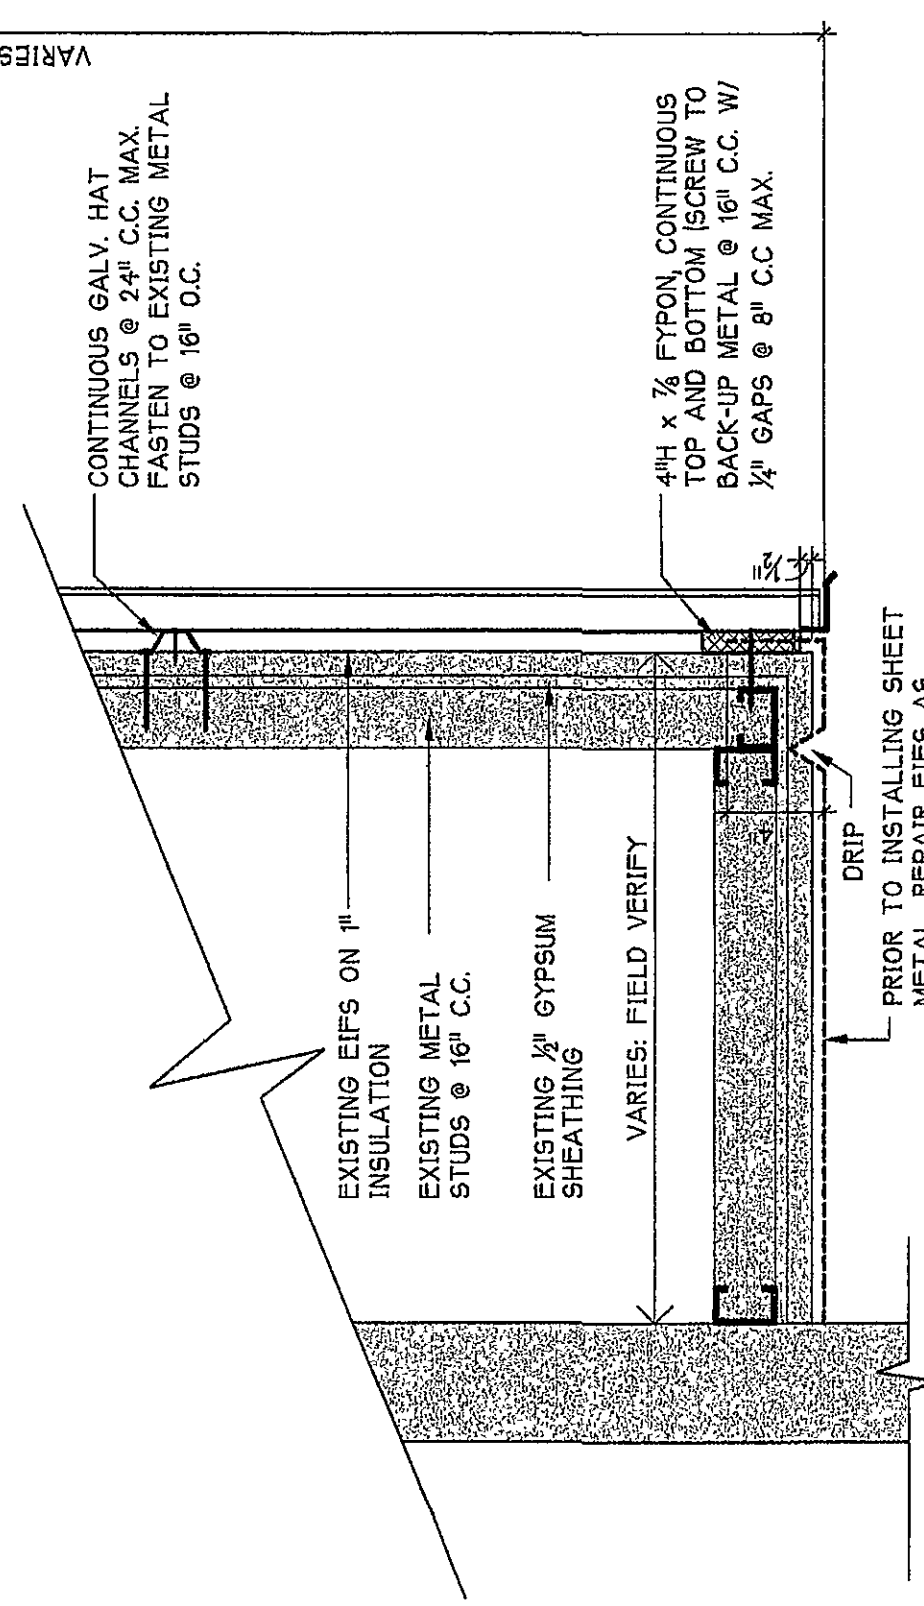

2 SOFFIT DETAIL
A5.1 @ METAL FASCIA SILL **1 1/2" = 1'-0"**

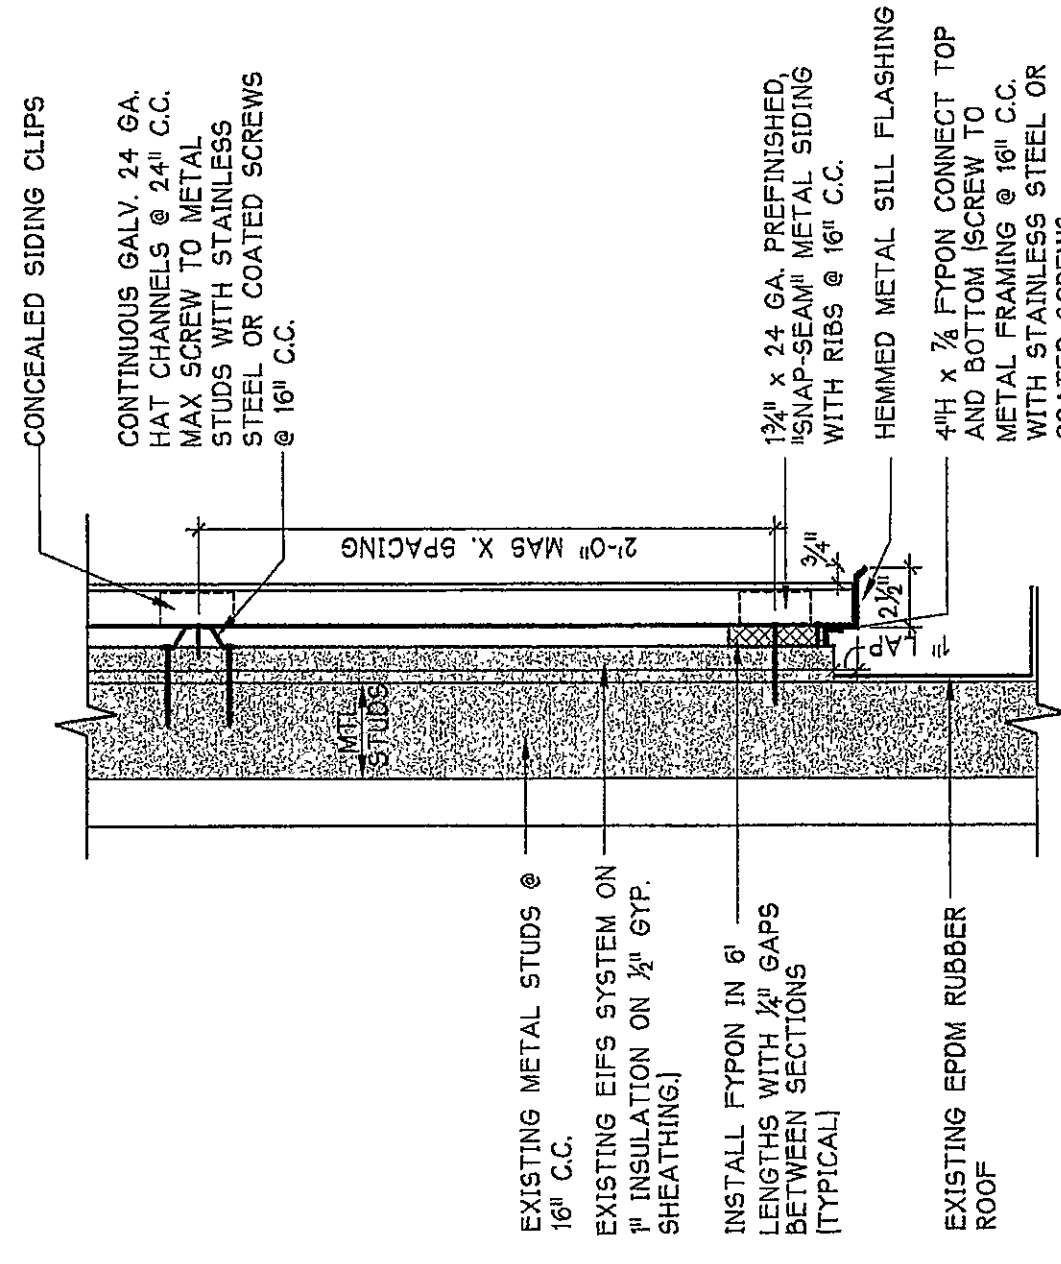

3 SILL DETAIL
A5.1 @ METAL FASCIA ABOVE ROOF 1 1/2" = 1'-0"