

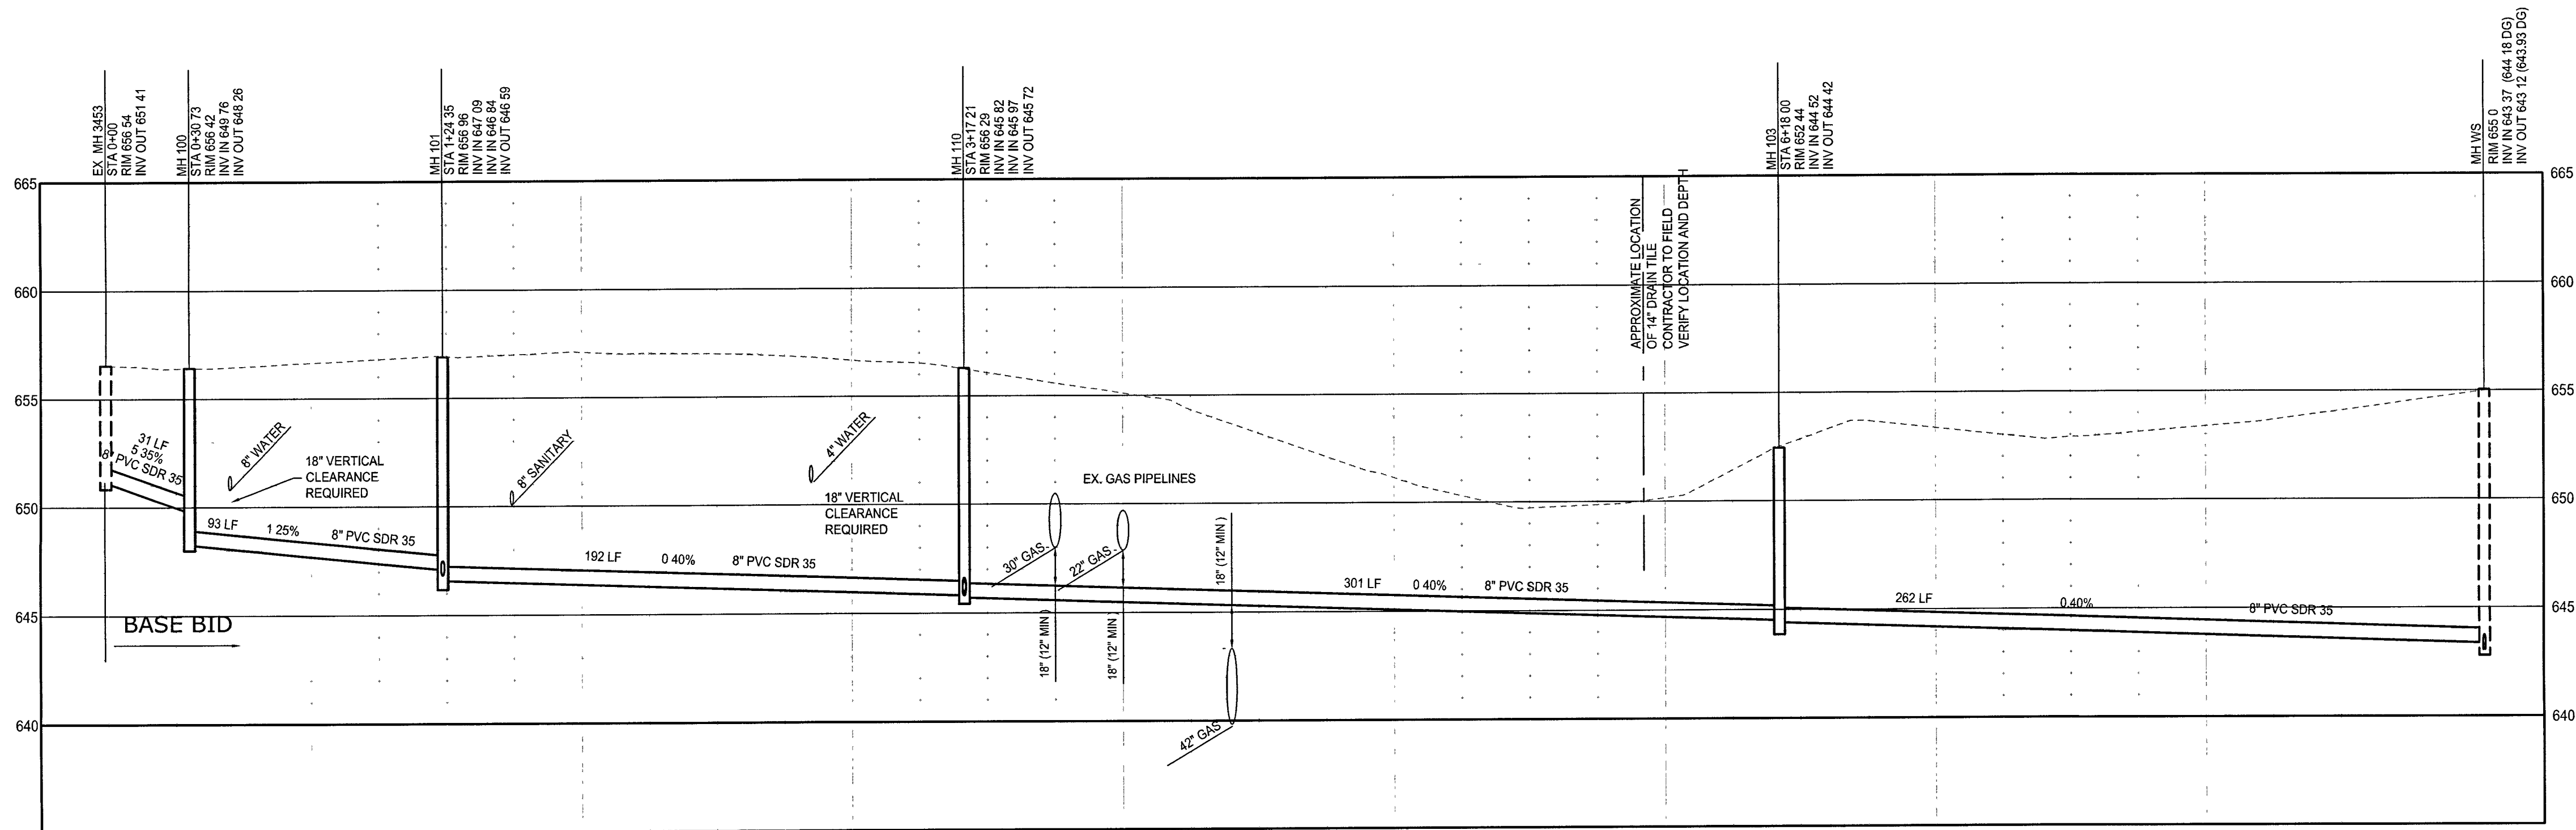


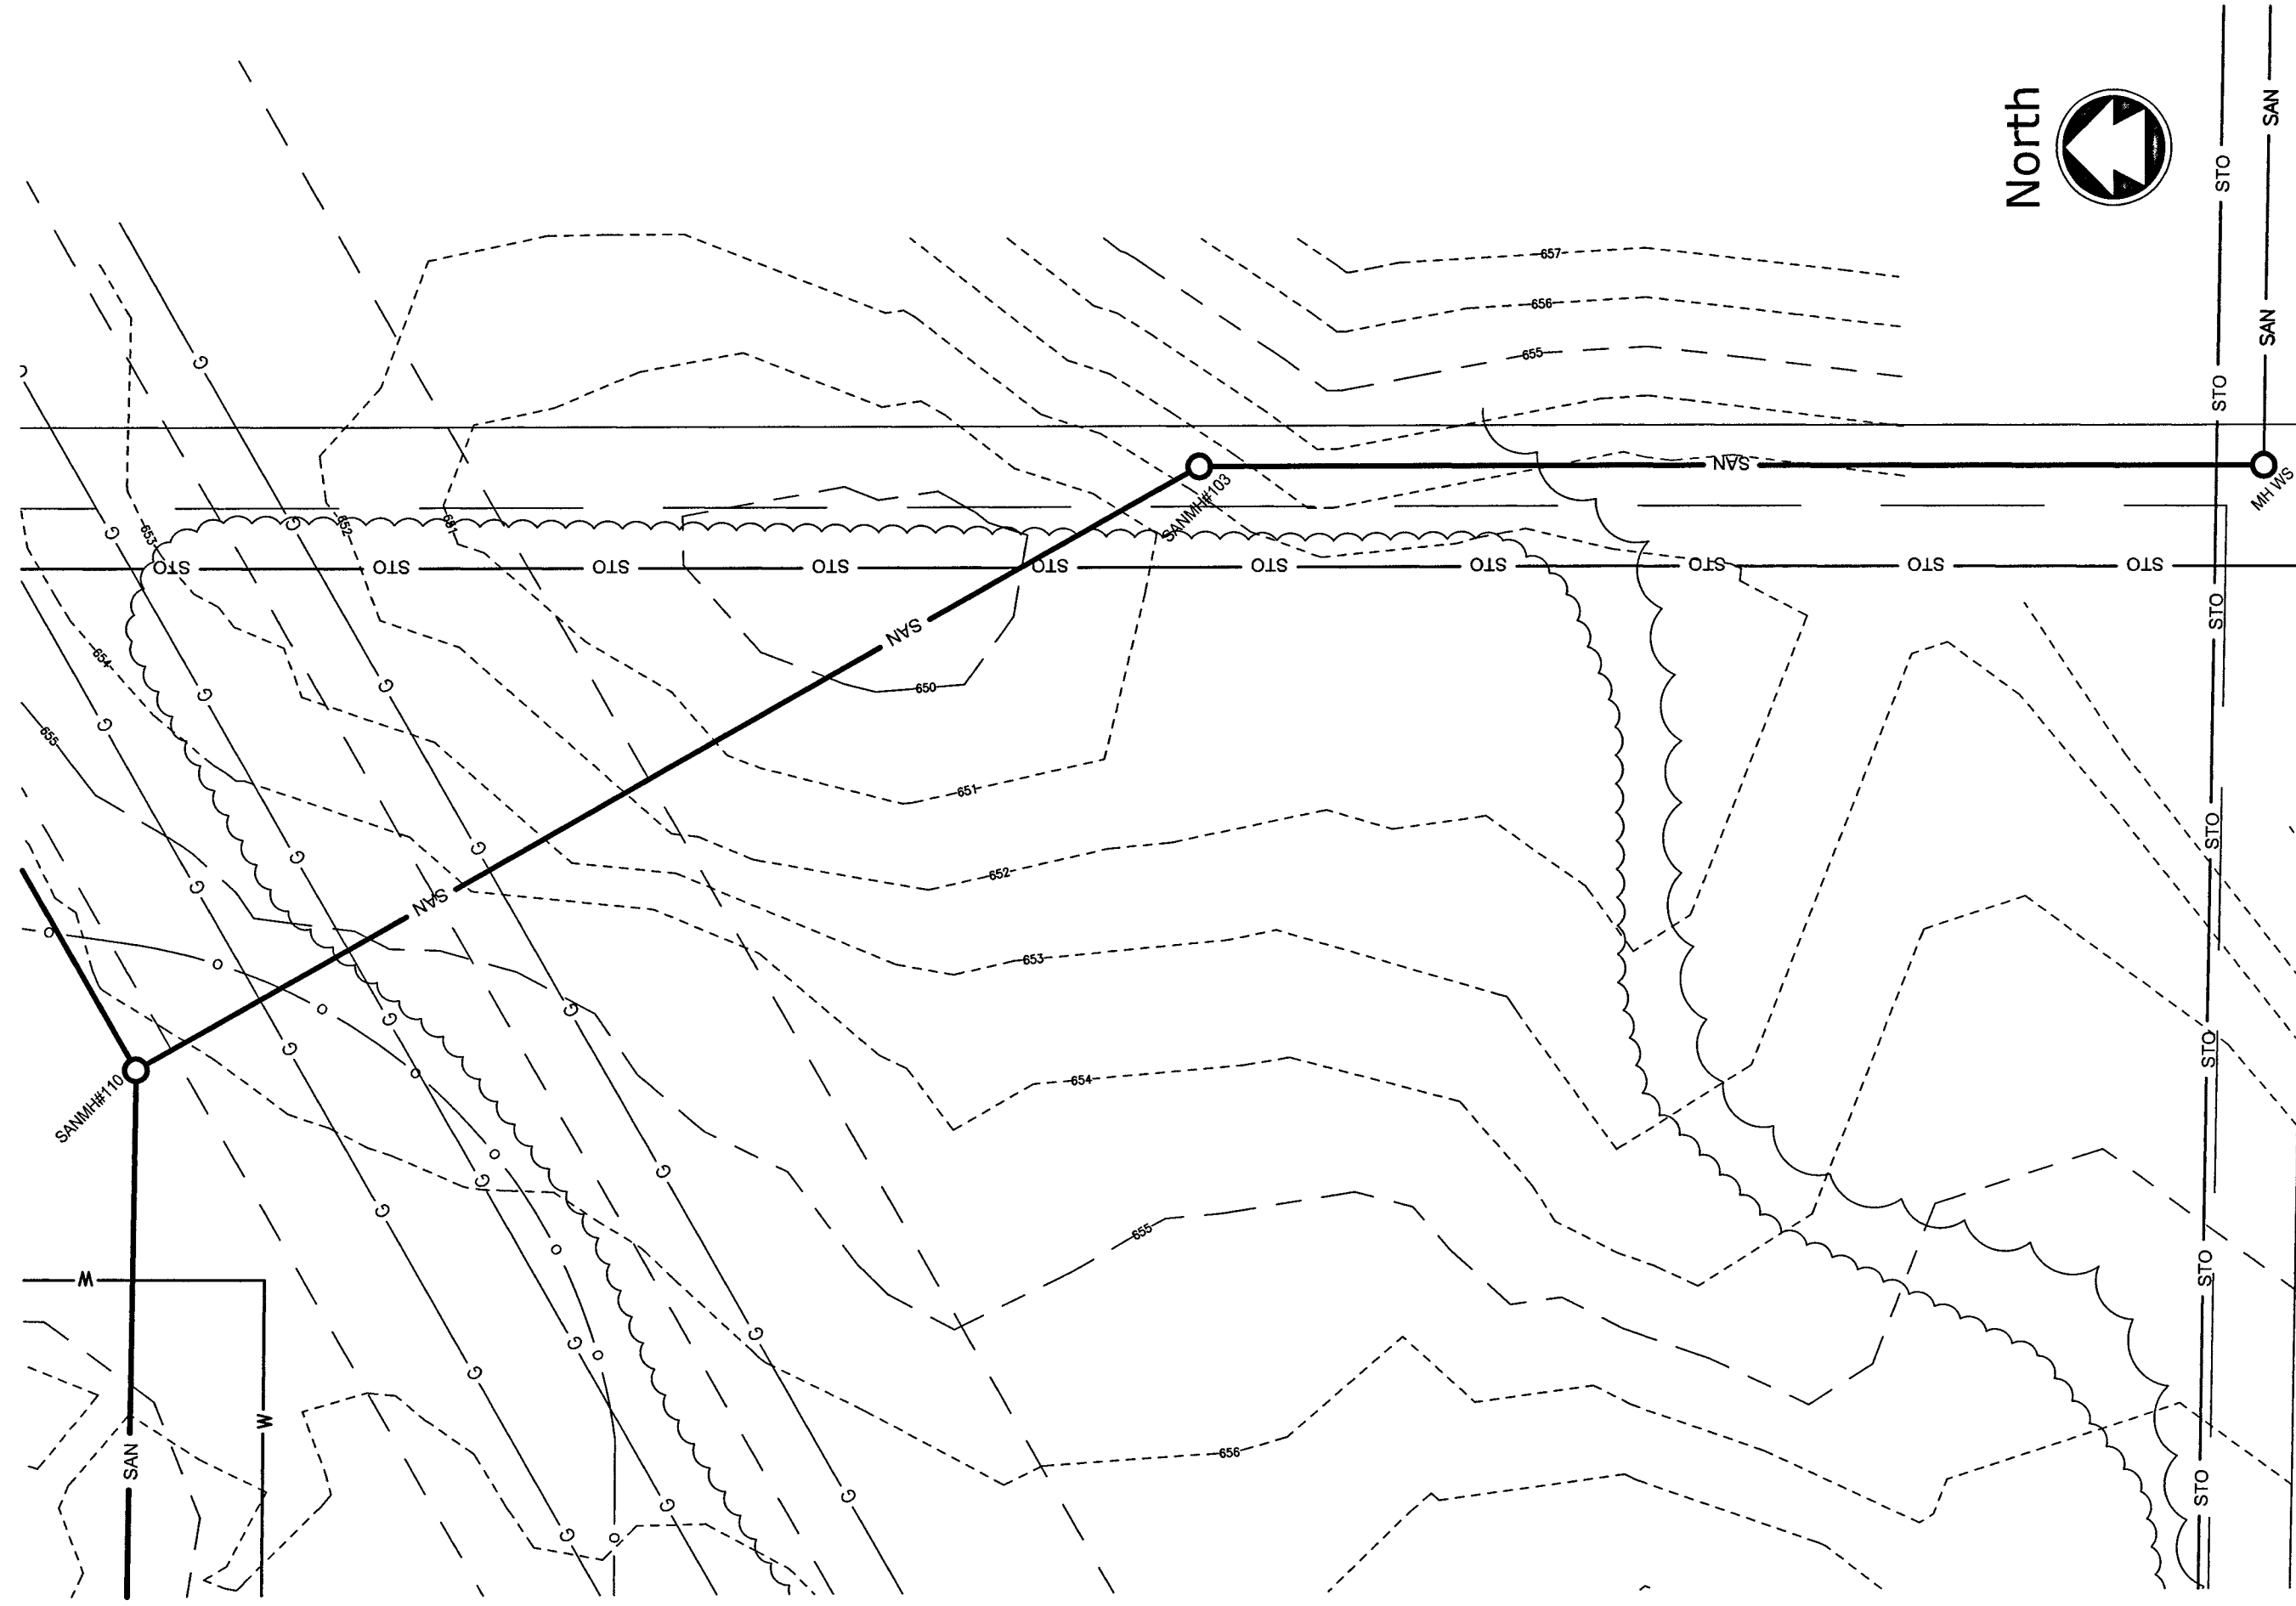

DATUM NOTE.
THERE IS A 0.8 FOOT DIFFERENCE IN DATUM BETWEEN THE MCMAHON PLANS AND THE DUNELAND GROUP PLANS. THE RELATIONSHIP IS DEFINED AS FOLLOWS
MCMAHON ELEVATION = DUNELAND ELEVATION - 0.80 FEET

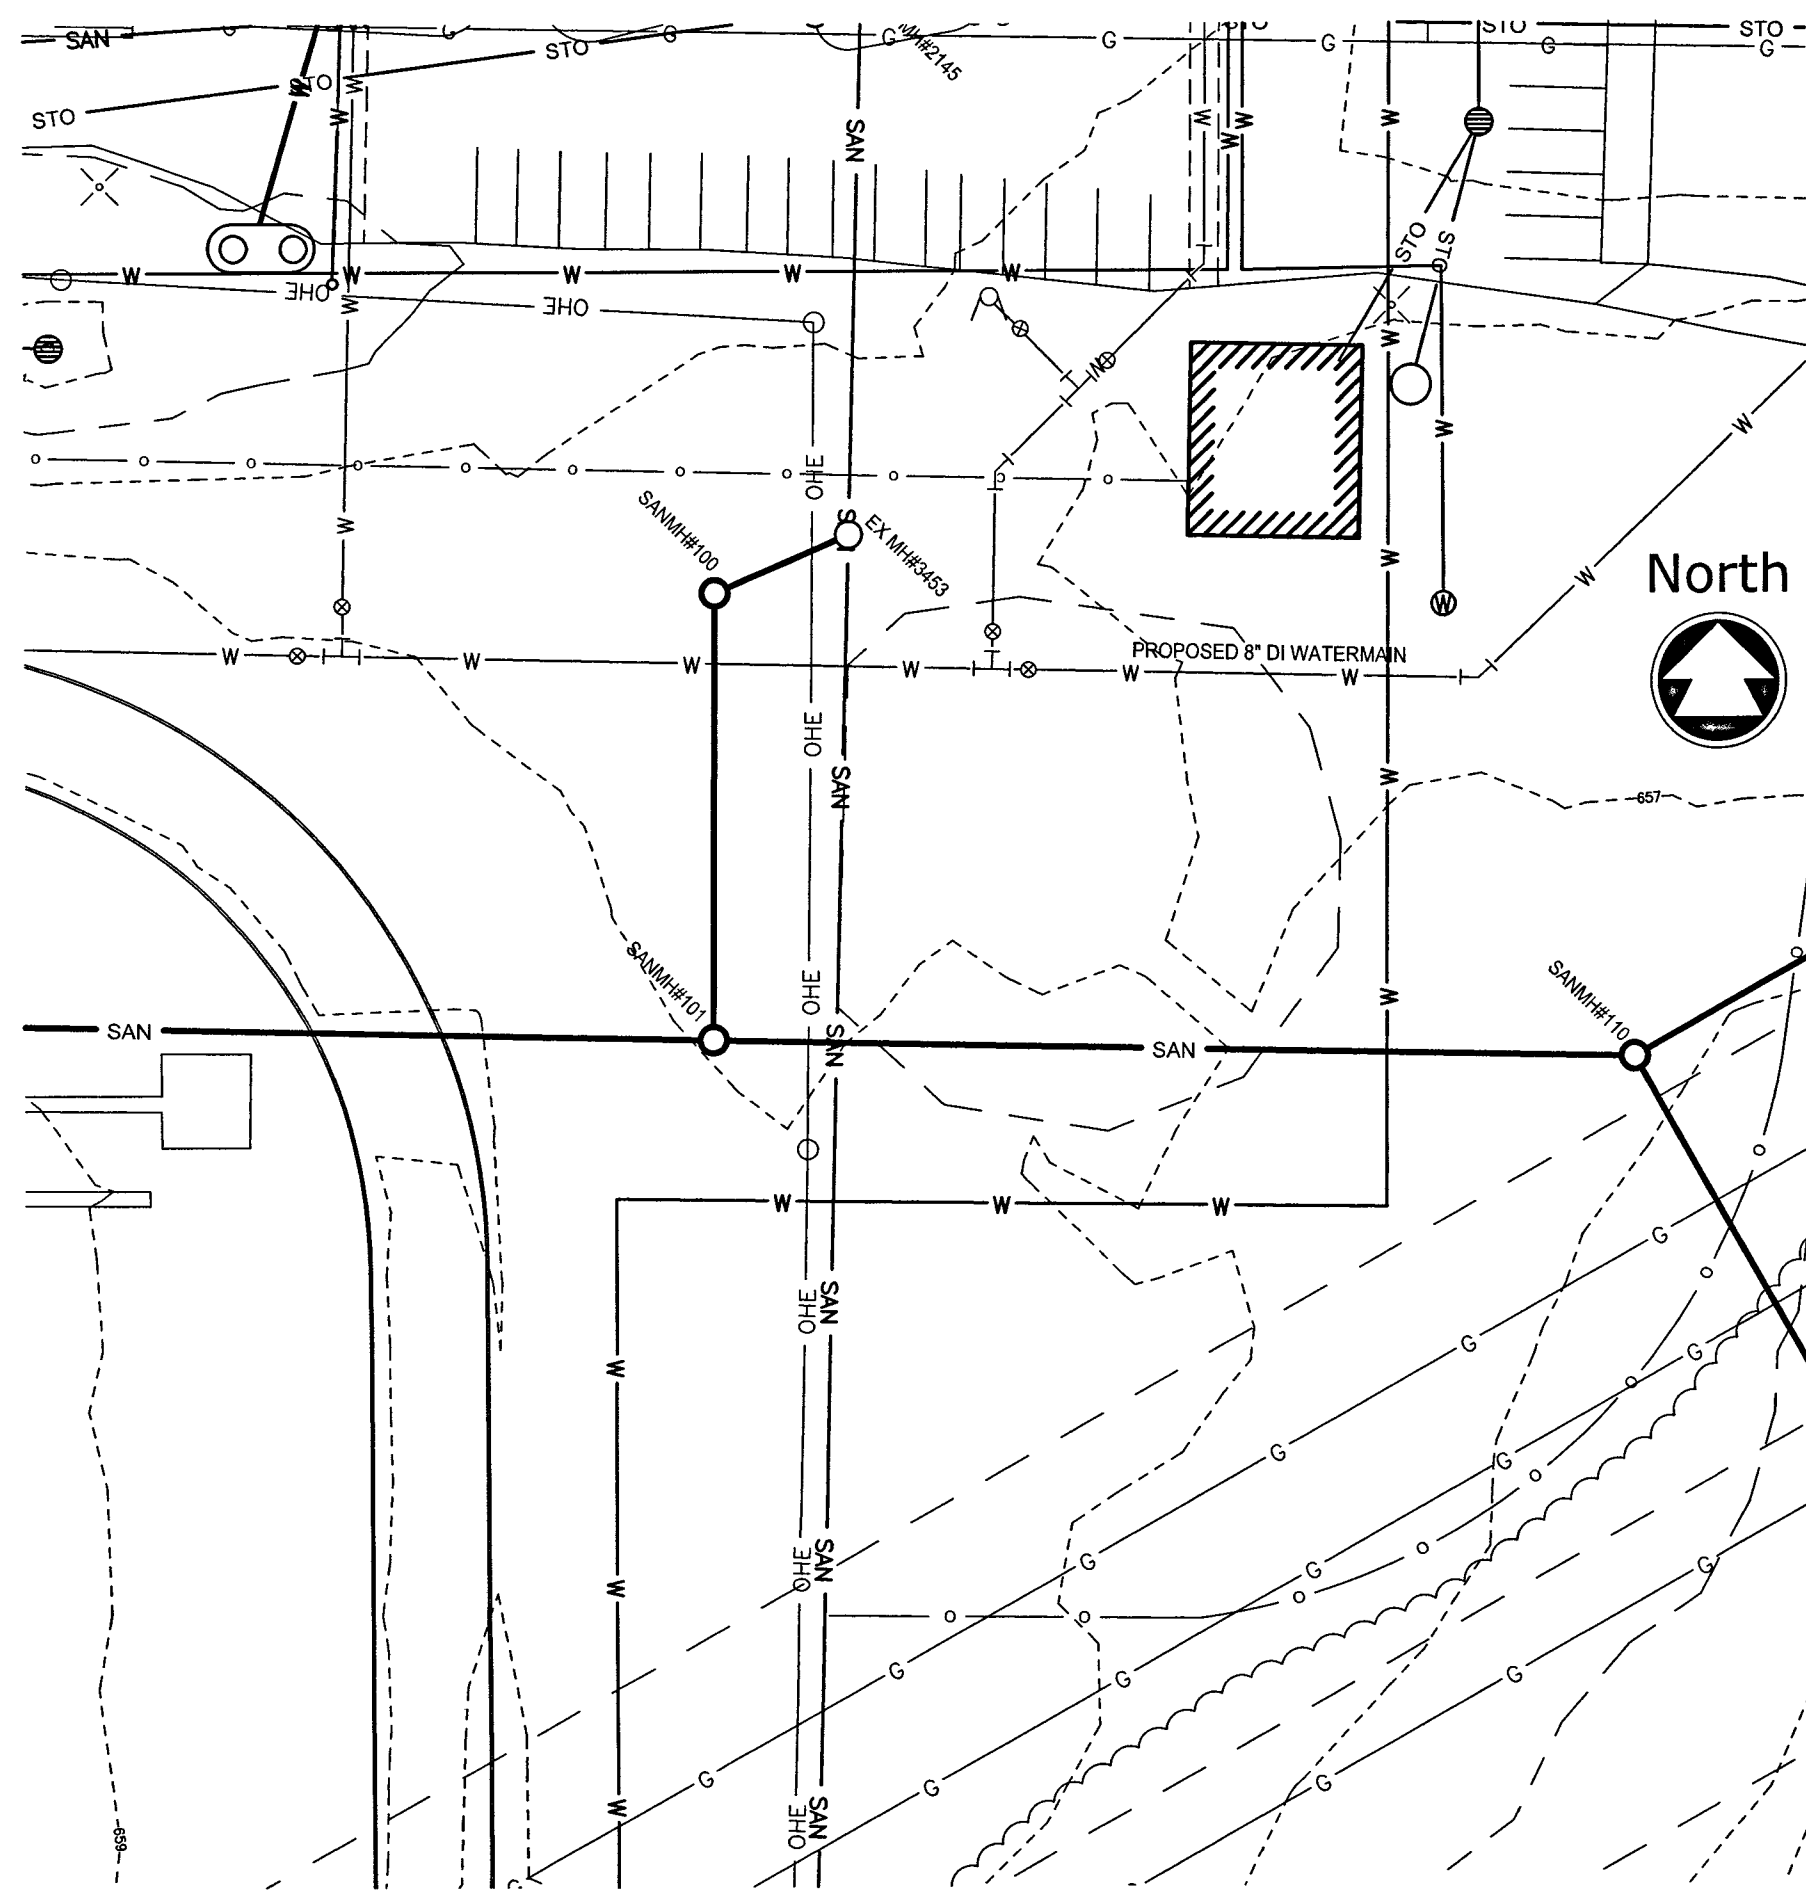

Rell S. Pierson

Liberty Elementary and Intermediate Schools
Liberty Township, Porter County, Indiana
Sanitary Sewer Profile - Base Bid

DESIGNED RSP	DRAWN RSP
PROJECT NO D0528-59-0151.00	
DATE	
SHEET NO	

C201

McMAHON
ENGINEERS ARCHITECTS
952 South State Road 2
Valparaiso, Indiana 46385
Tel: (219) 462-7743 Fax: (219) 464-8248
mcm@mcmgrp-in.com

McMAHON provides the drawing and data, regardless of form, as instruments of service. The client and/or architect shall retain all copyrights in the drawing and data. The client and/or architect shall not permit the drawing and data to be reproduced or transmitted in any form or by any means electronic or mechanical, including photocopying, recording, or by any information storage or retrieval system, without the prior written consent by McMAHON.

NO	DATE	REVISION
1	3/4/10	Revised sanitary to avoid pipelines