


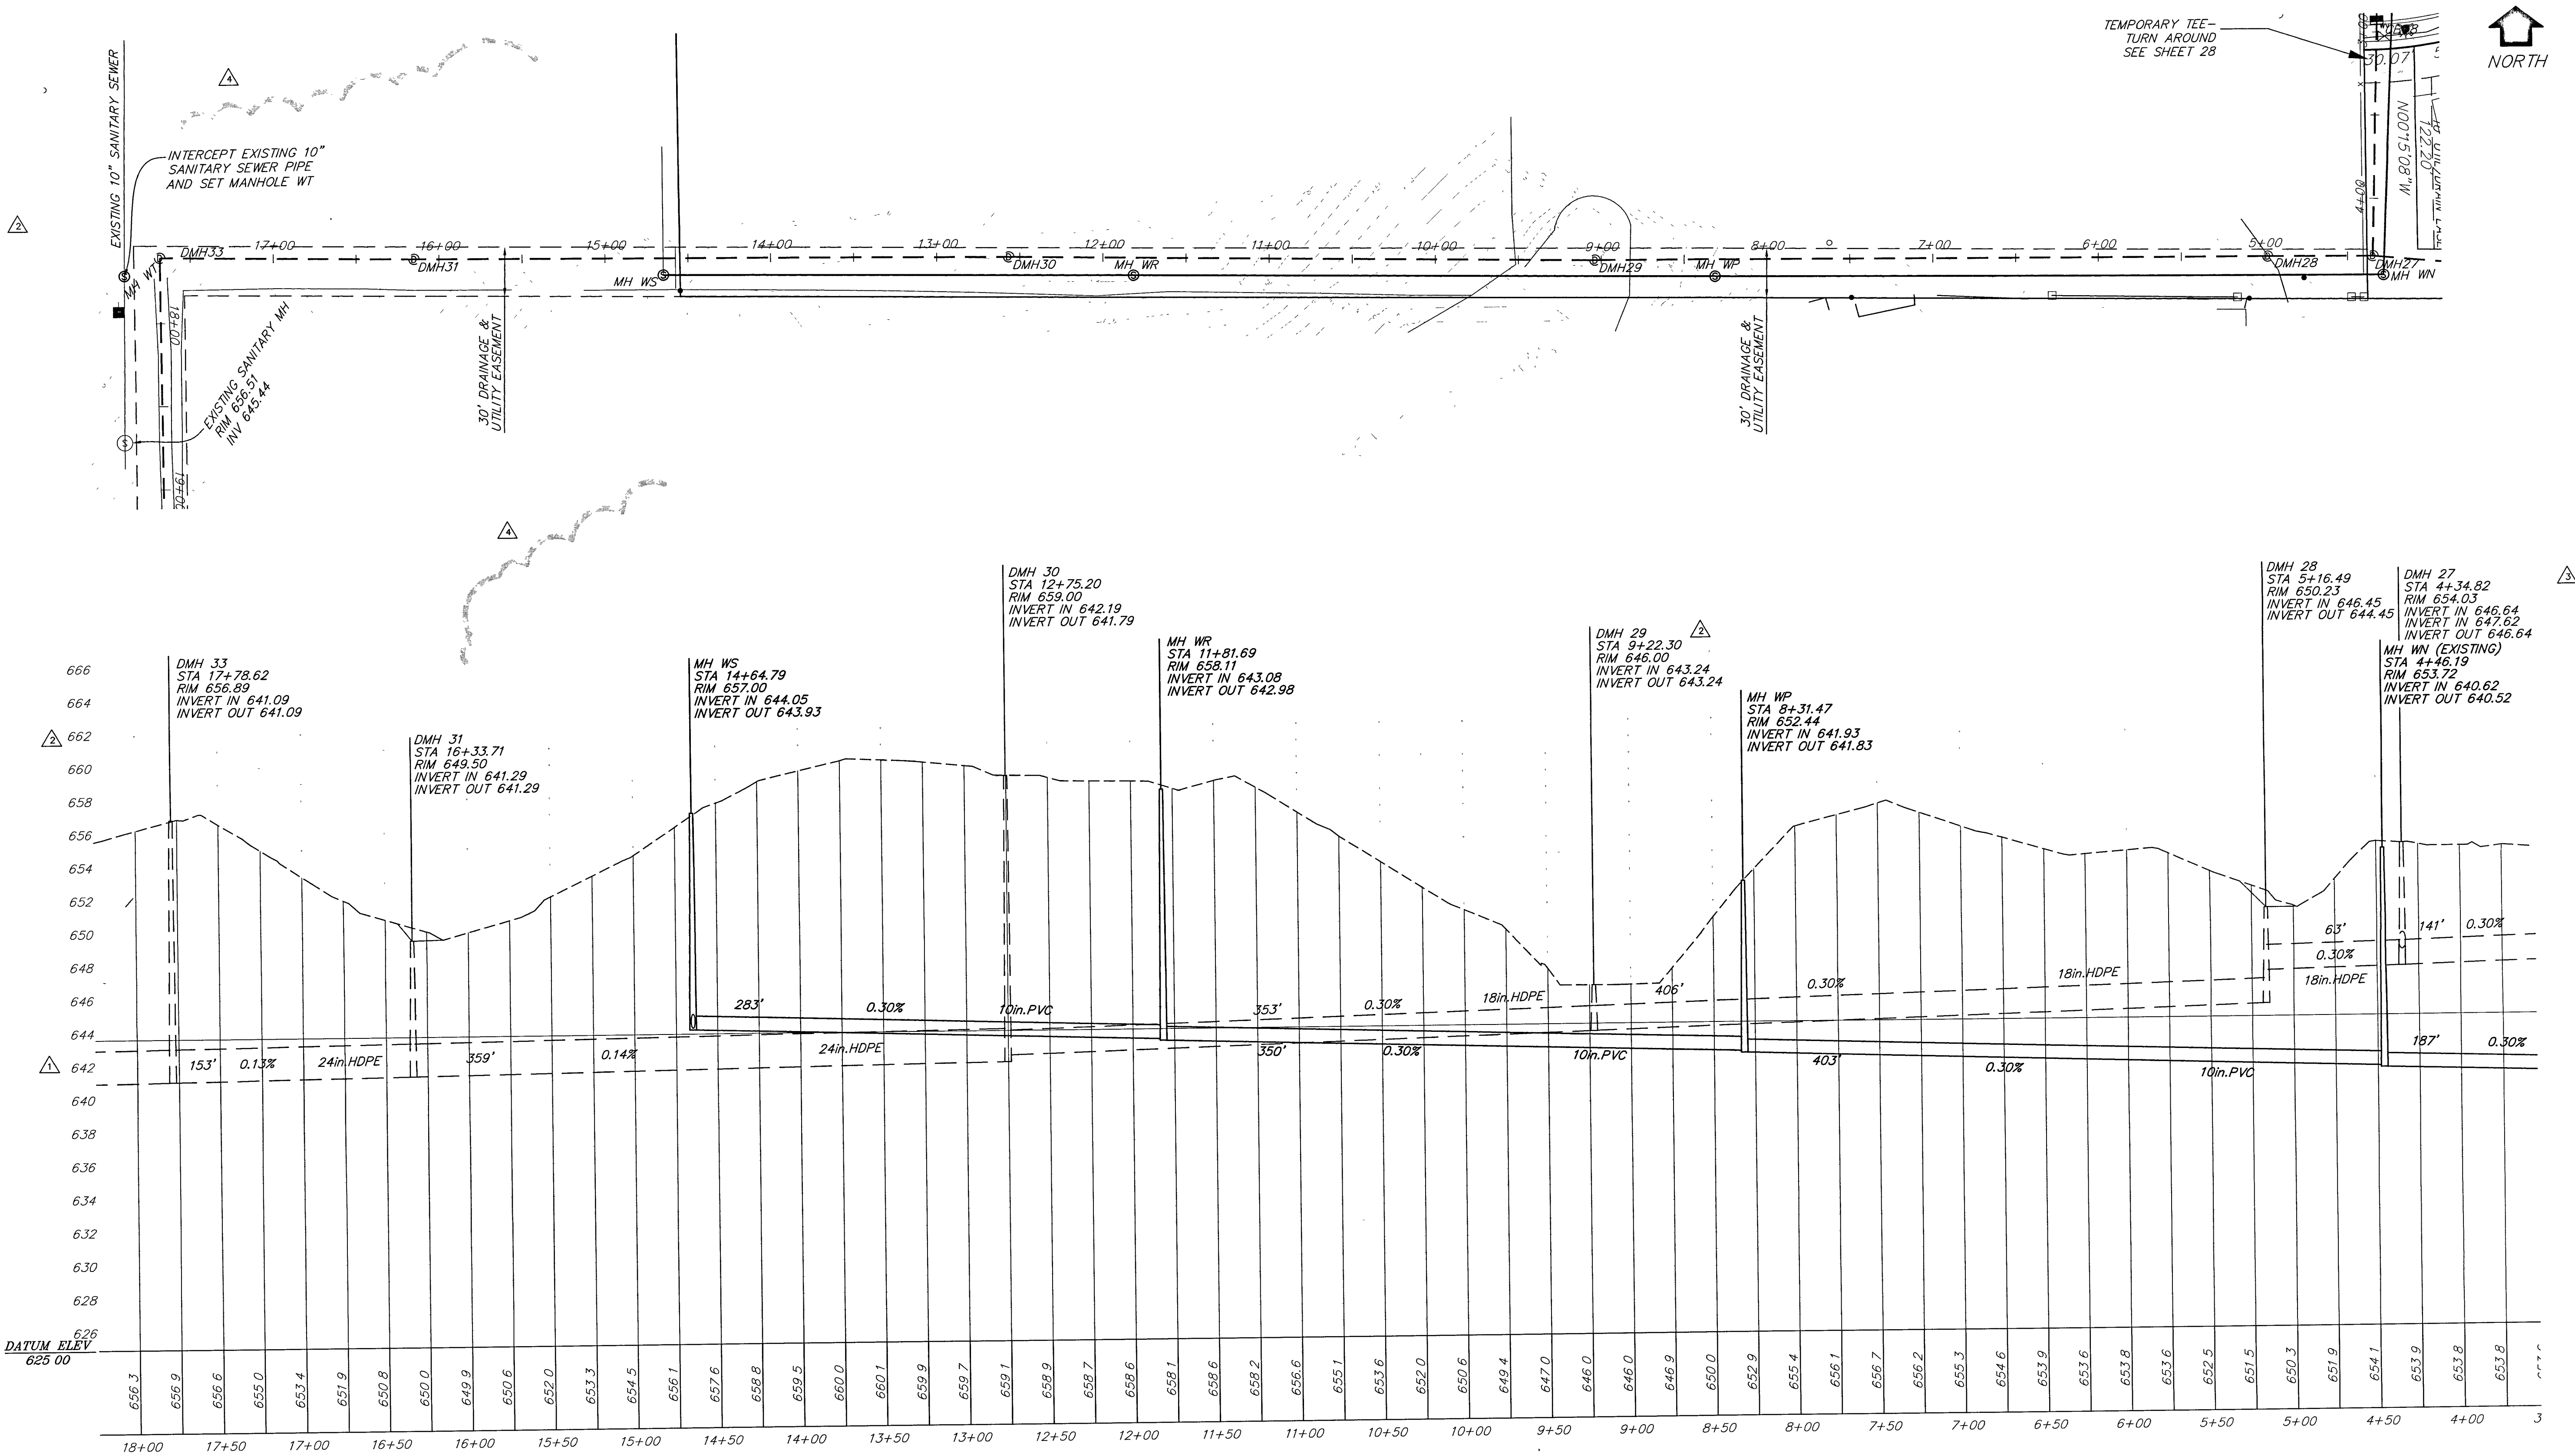

REVISION	DESCRIPTION	DATE
1	REMOVED MH WT AND RELOCATED MH WS FOR LIBERTY SCHOOL TIE-IN	11/30/09
2	ADDED ADDITIONAL INVERT IN FROM RY 21 ON DMH 27	6/30/09
3	REVISED INVERTS OF DMH 27 AND THE SLOPE BETWEEN RY 21 TO DMH 27	6/10/09
4	REVISED STORM OUTFALL, UPSIZED PIPE AND ADDED SWALE DETAIL	5/30/08

STORM		TIMBERLAND FARMS POND D OUTLET & UTILITY PIPING (WEST)		DATE: 4/29/08	
SANITARY		REVISIONS	BY	SCALE: 1" = 50'	
WATER		5/30/08	MSK		PROJECT: 2378
ROAD		6/10/09	JWD		SHEET: 18
	6/30/09	SWB			
		11/30/09	JWD		

DUNELAND GROUP
 ENGINEERING & SURVEYING
 1498 POPE COURT
 CHESTERTON, INDIANA 46304
 219-926-1007 fax 219-926-1544
 E-MAIL: dg@dunelandgroup.com