


REVISIONS	BY	DATE




JACKSON ELEMENTARY SCHOOL
VLA PARARISO, IN
chesteron, Indiana


gerometta & kniel architects, inc.
118 N. 400 EAST
JACKSON ELEMENTARY SCHOOL
VLA PARARISO, IN

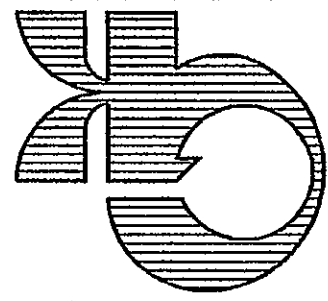


DATE	1-25-09
SCALE	AS SHOWN
DRAWN	MMO
CHECKED	JOS
DATE	2/10
SHEET	R-4
OF	17

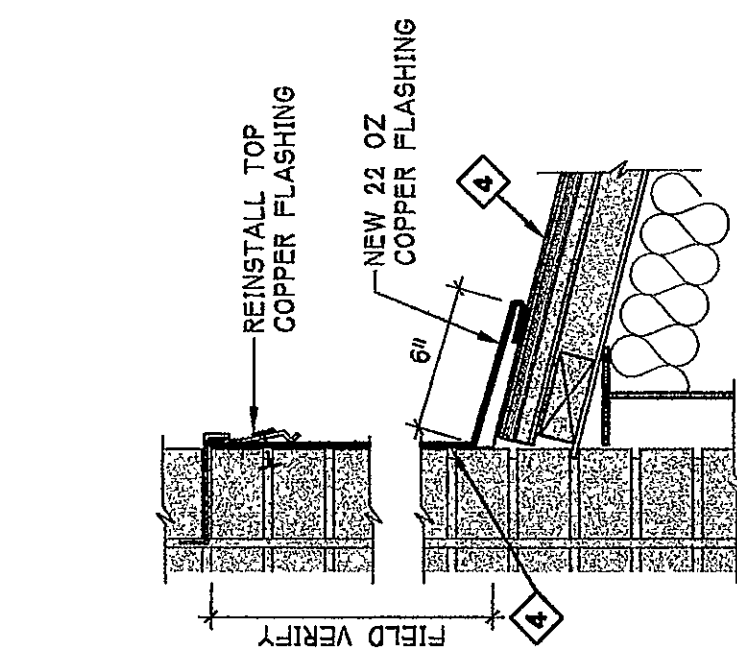


1 EXIST. FLASHING DTL.
R-4 @ 4 FLAT ROOF ENTRIES 1 1/2'-1'-0"

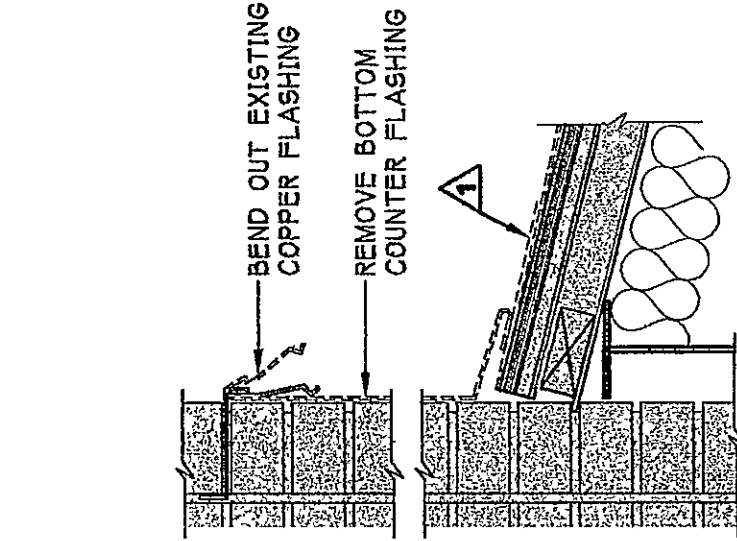



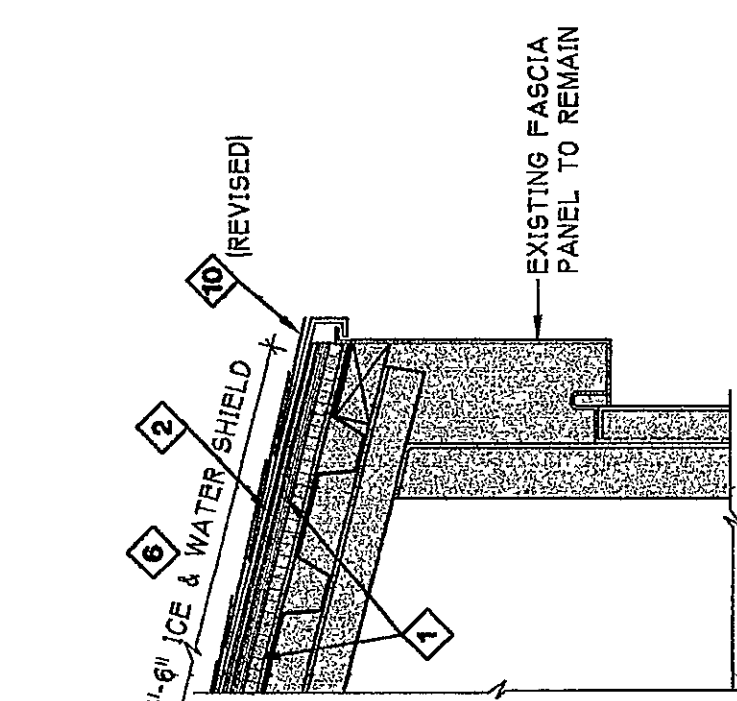



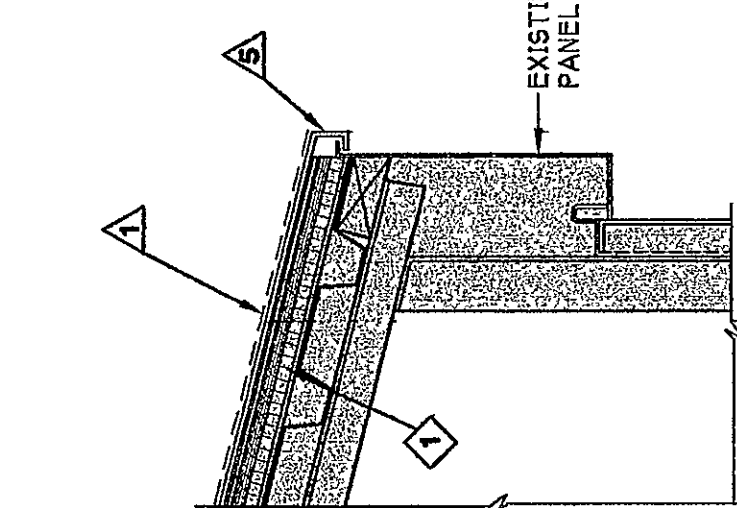



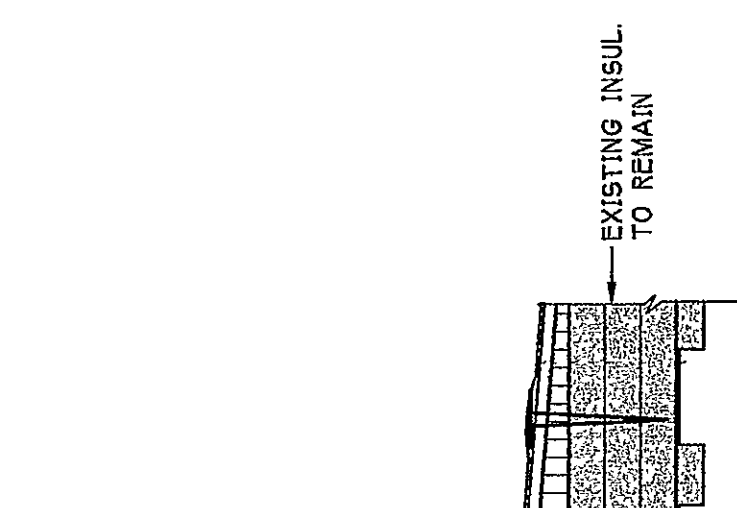



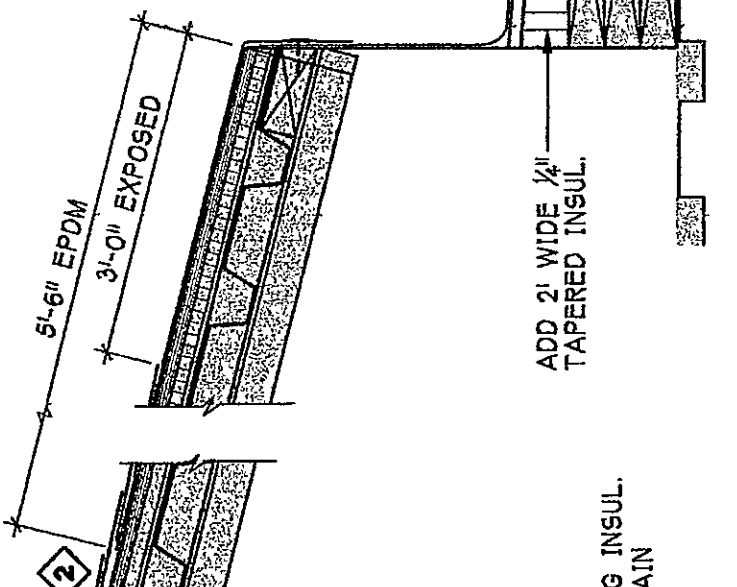



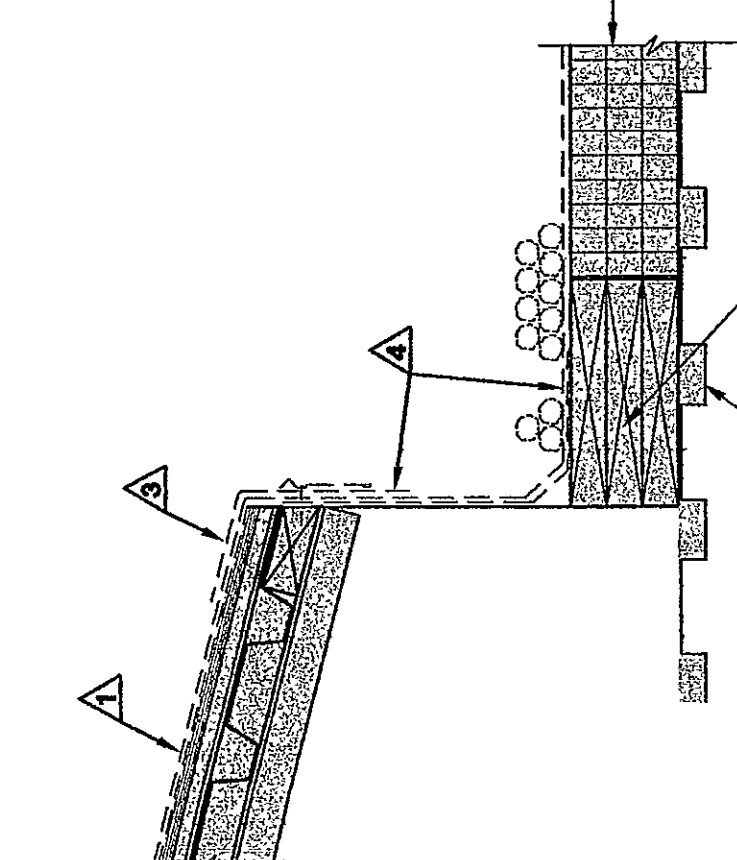



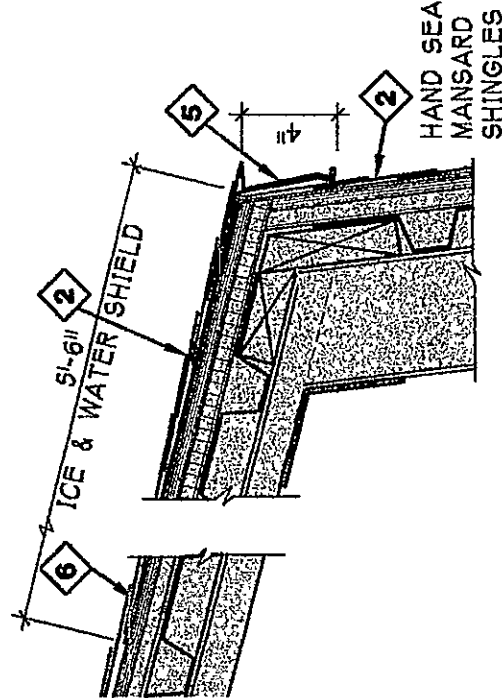



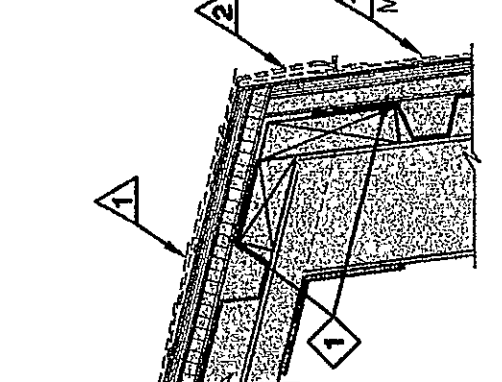



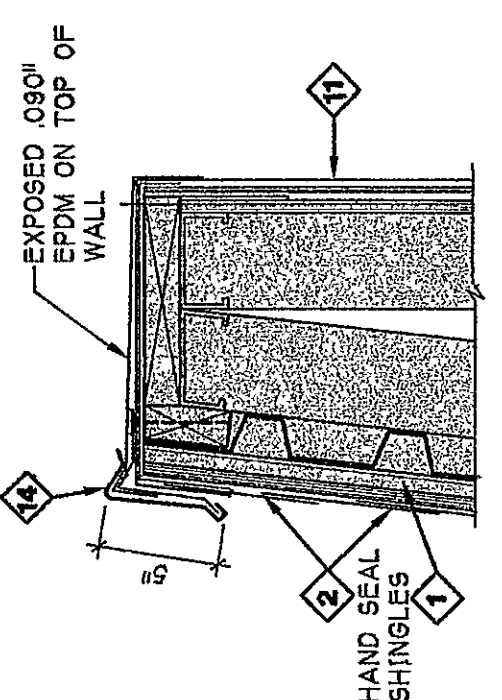



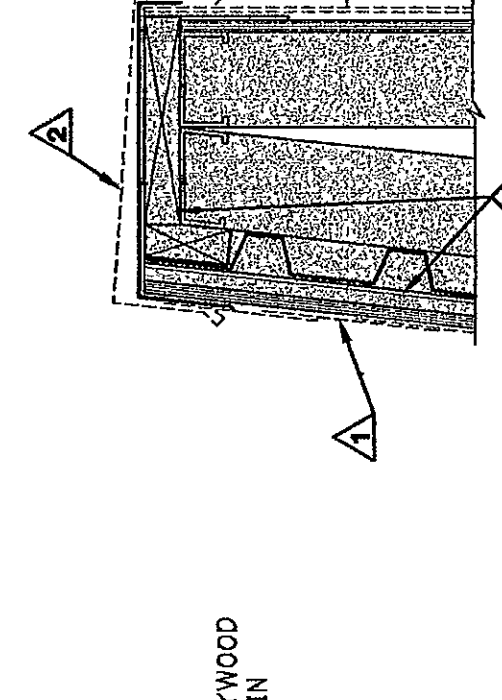



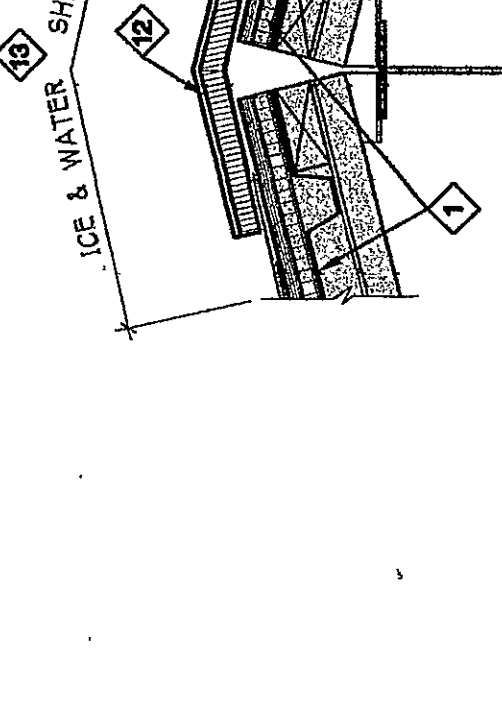



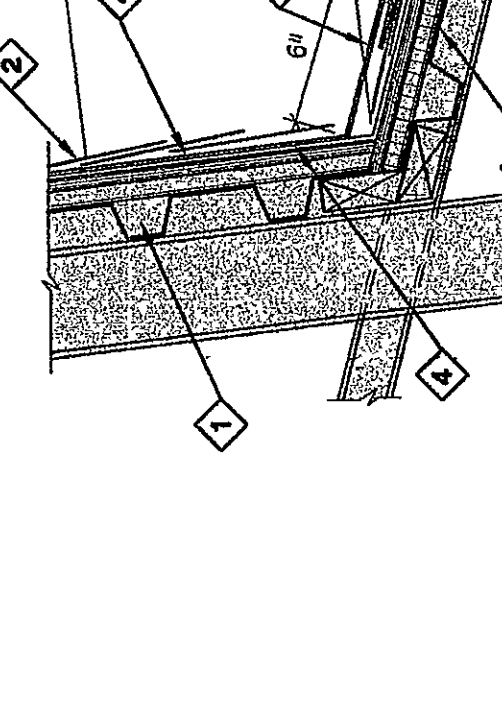



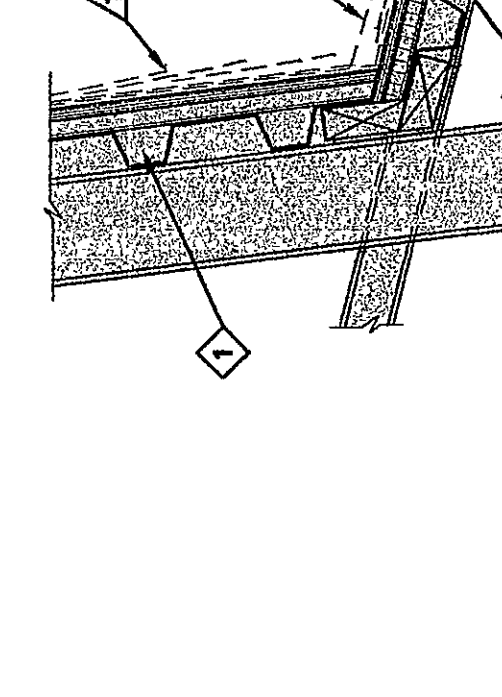



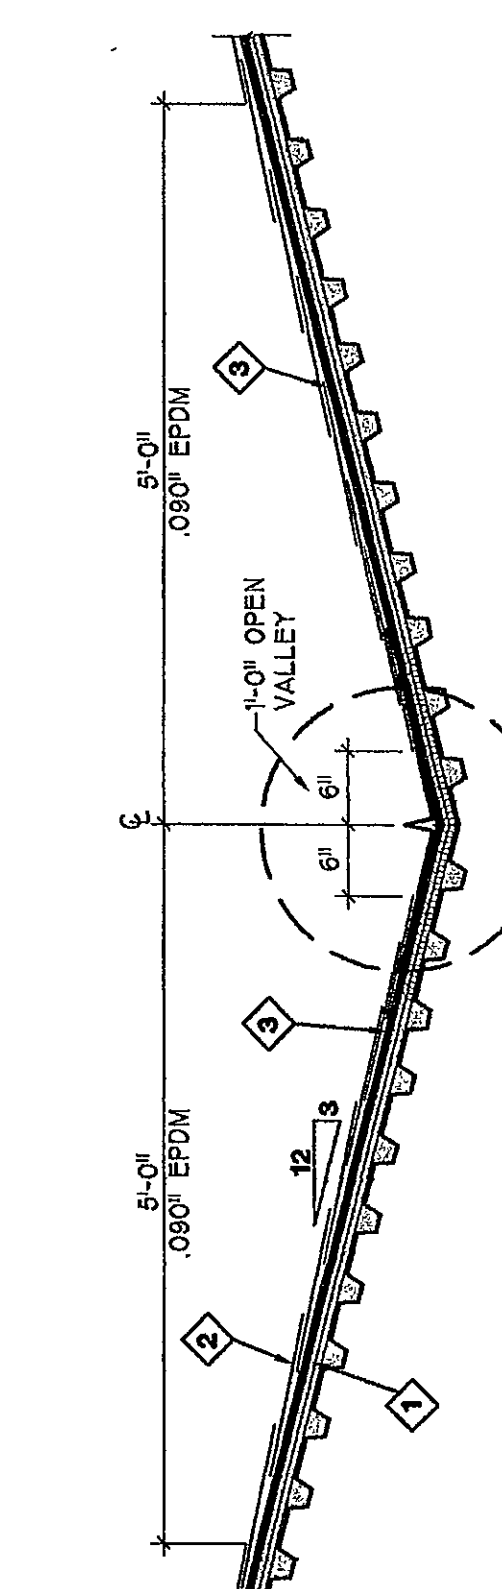



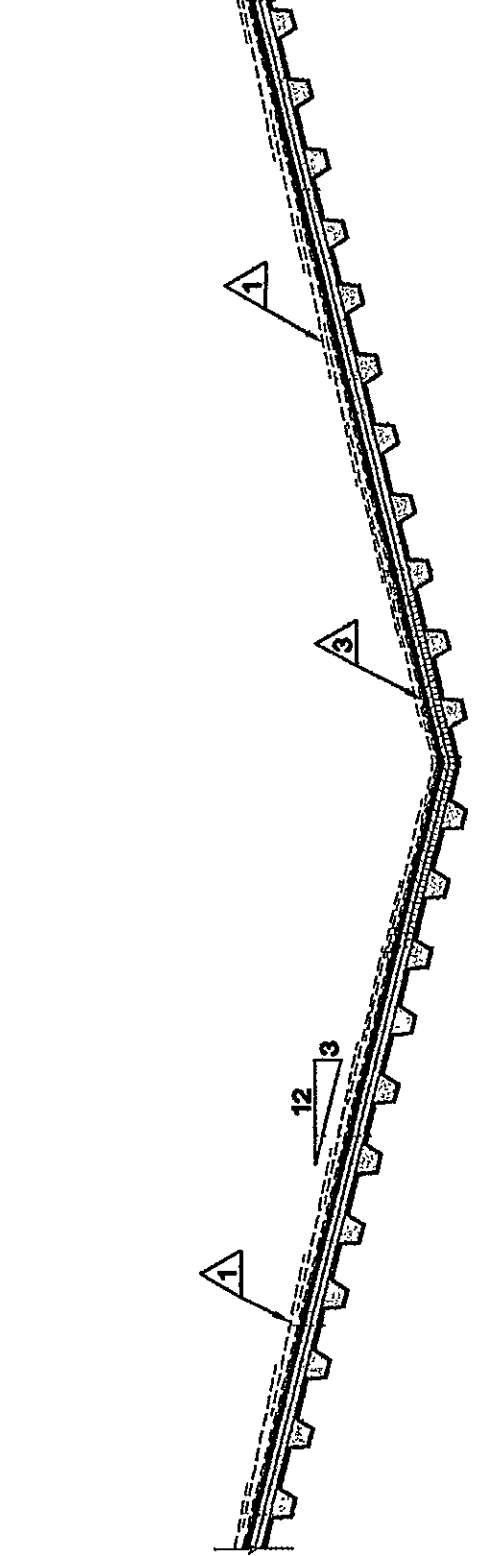



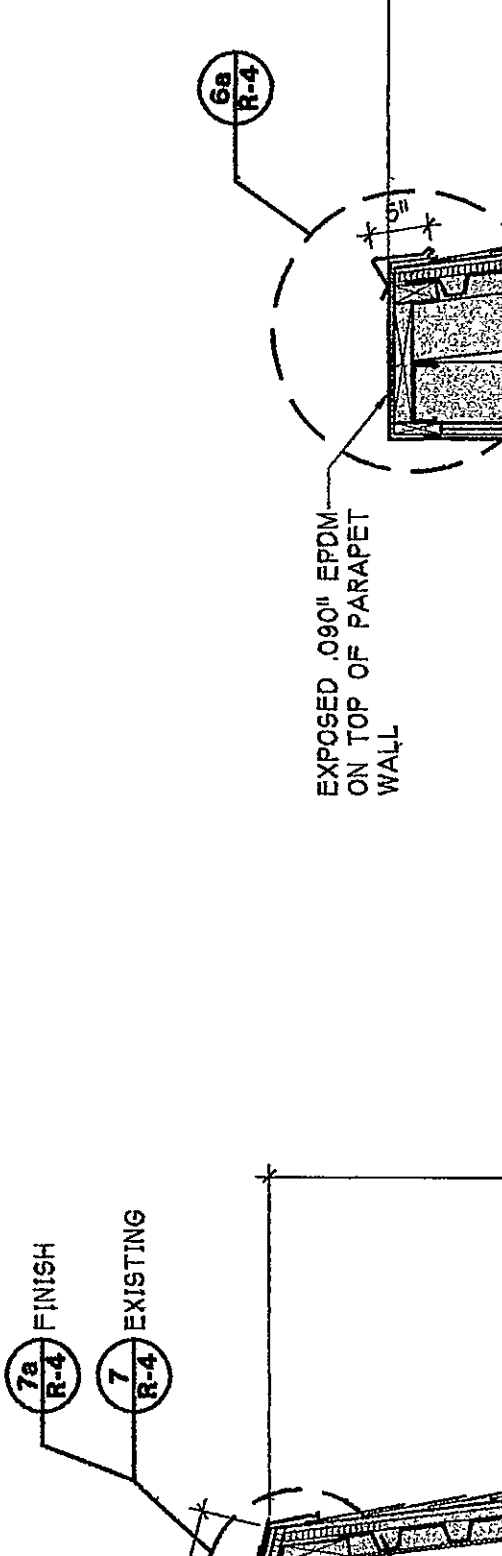



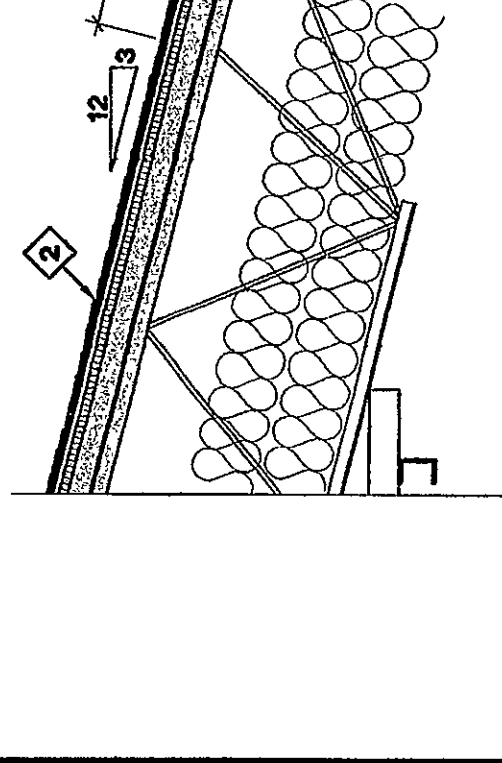


18 EXIST. FLASHING DTL.
R-4 @ 4 FLAT ROOF ENTRIES 1 1/2'-1'-0"

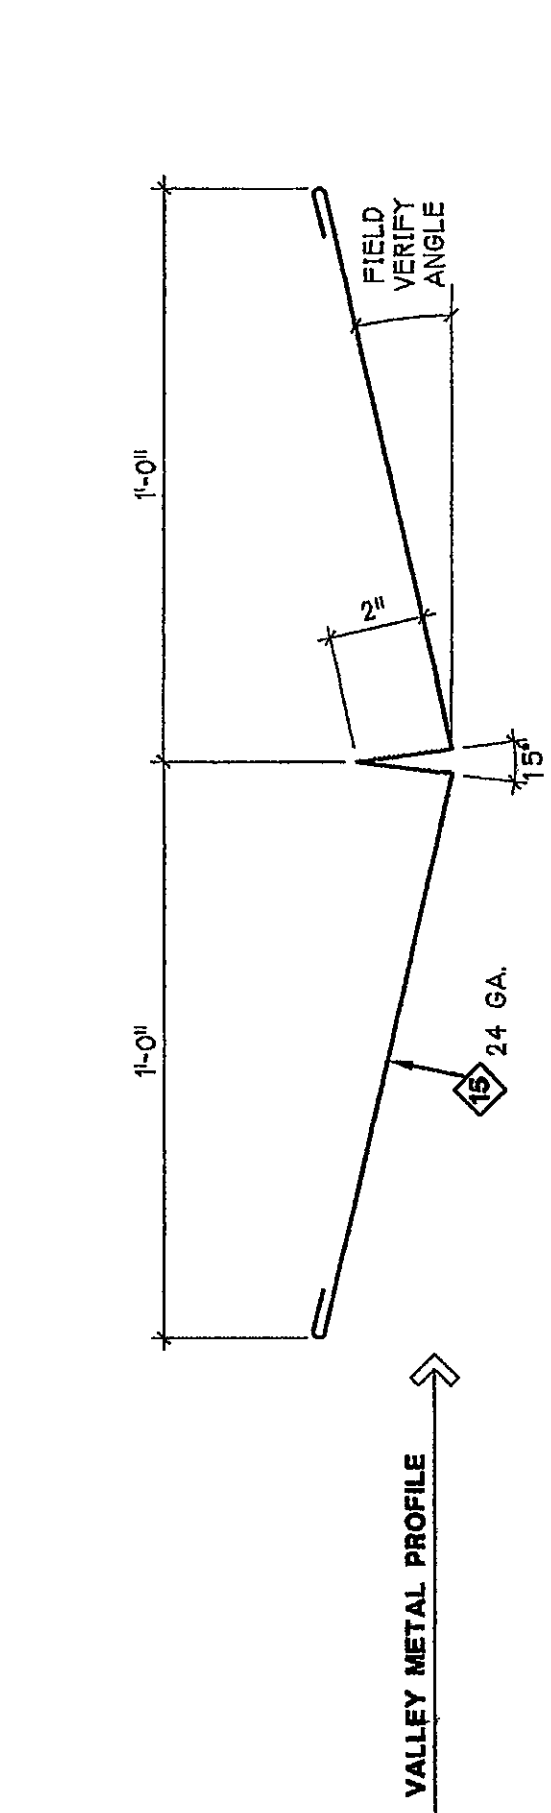



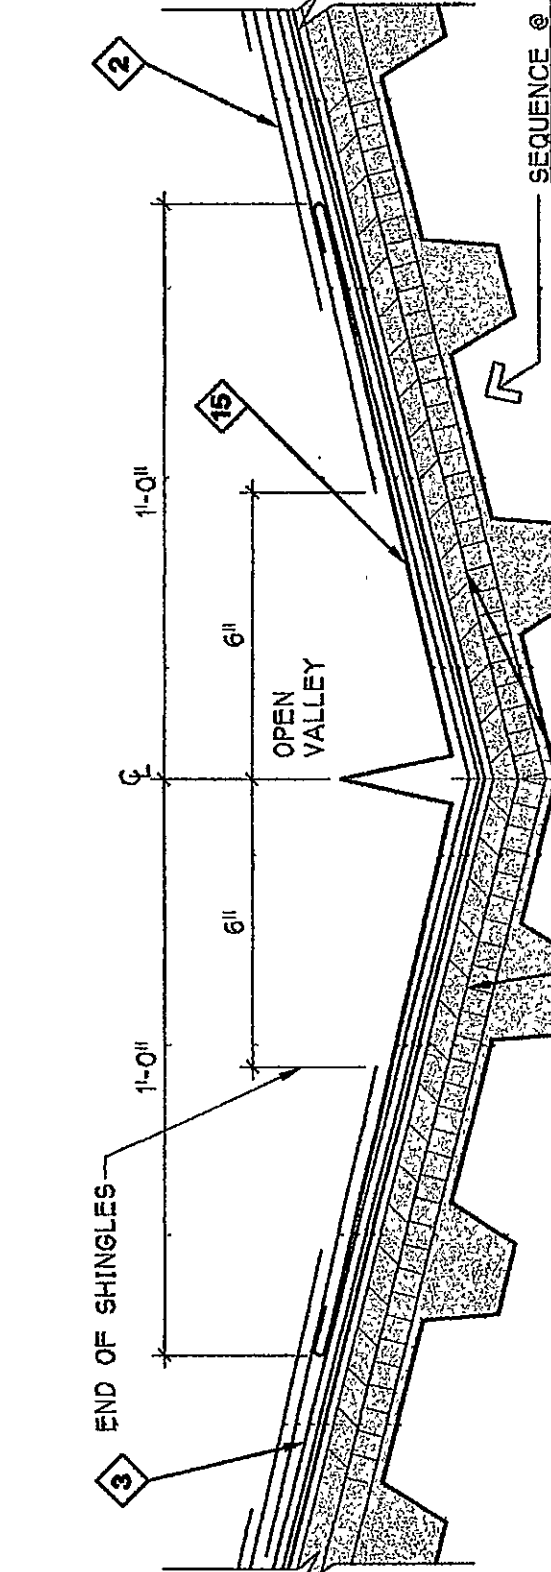


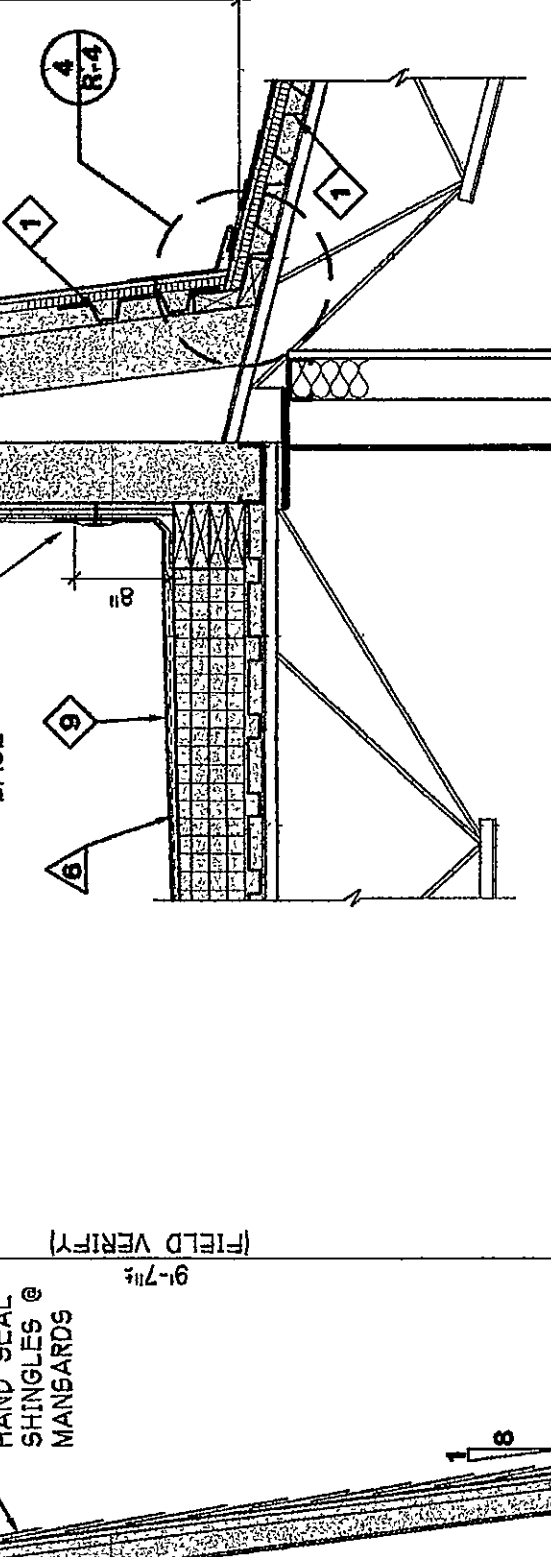


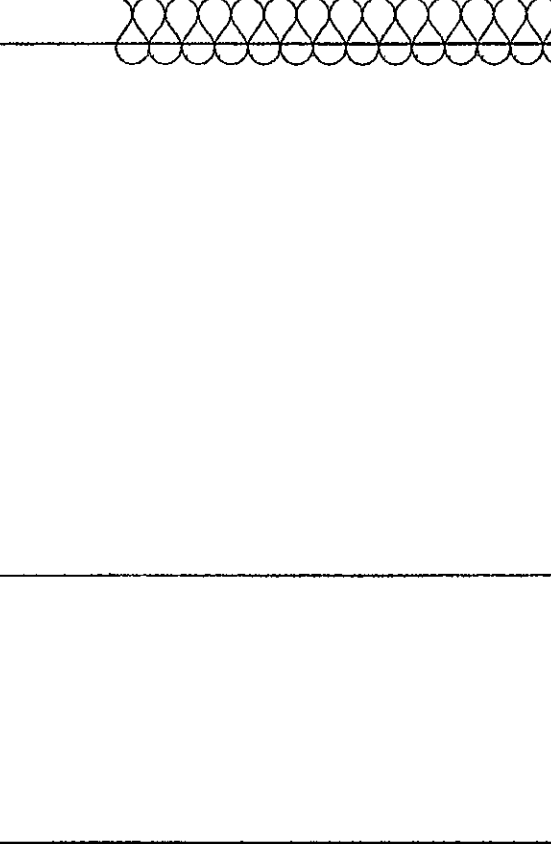









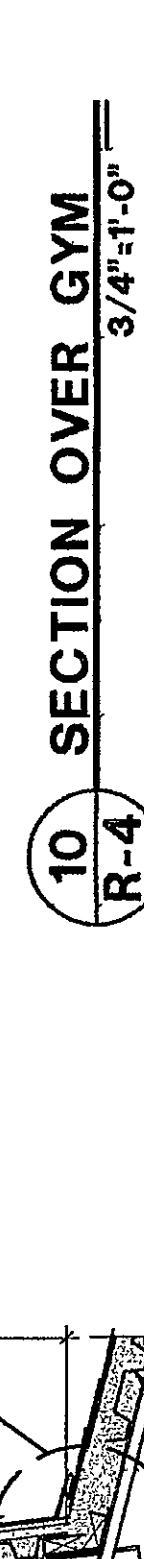











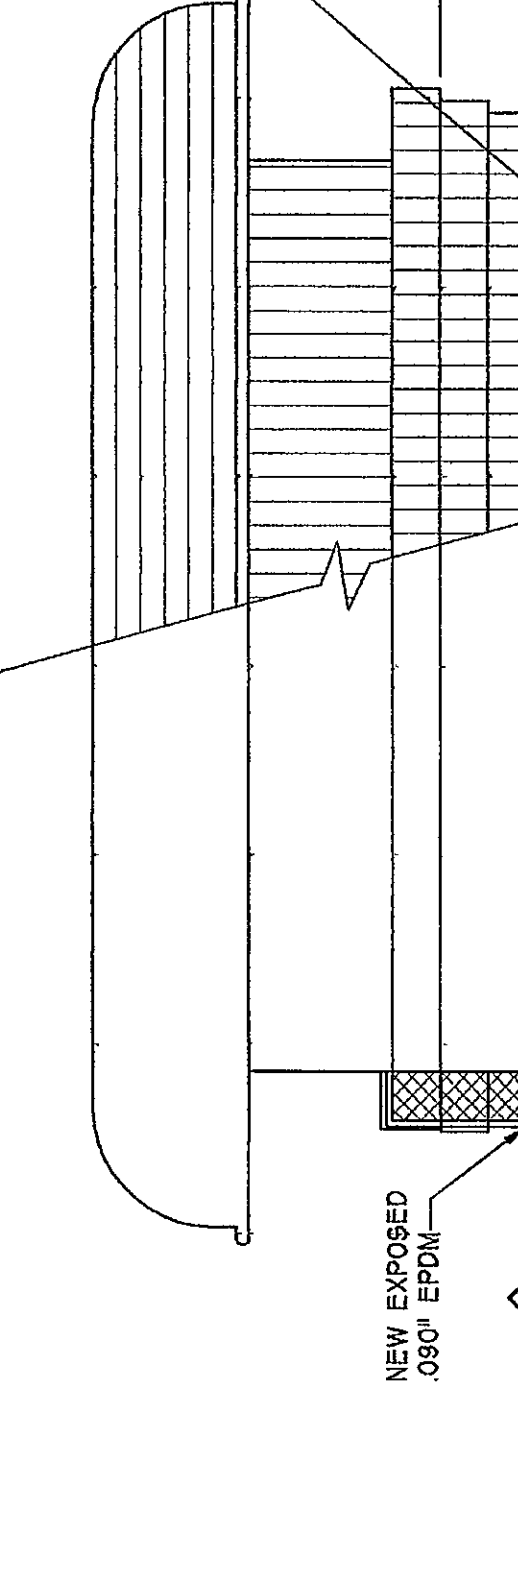


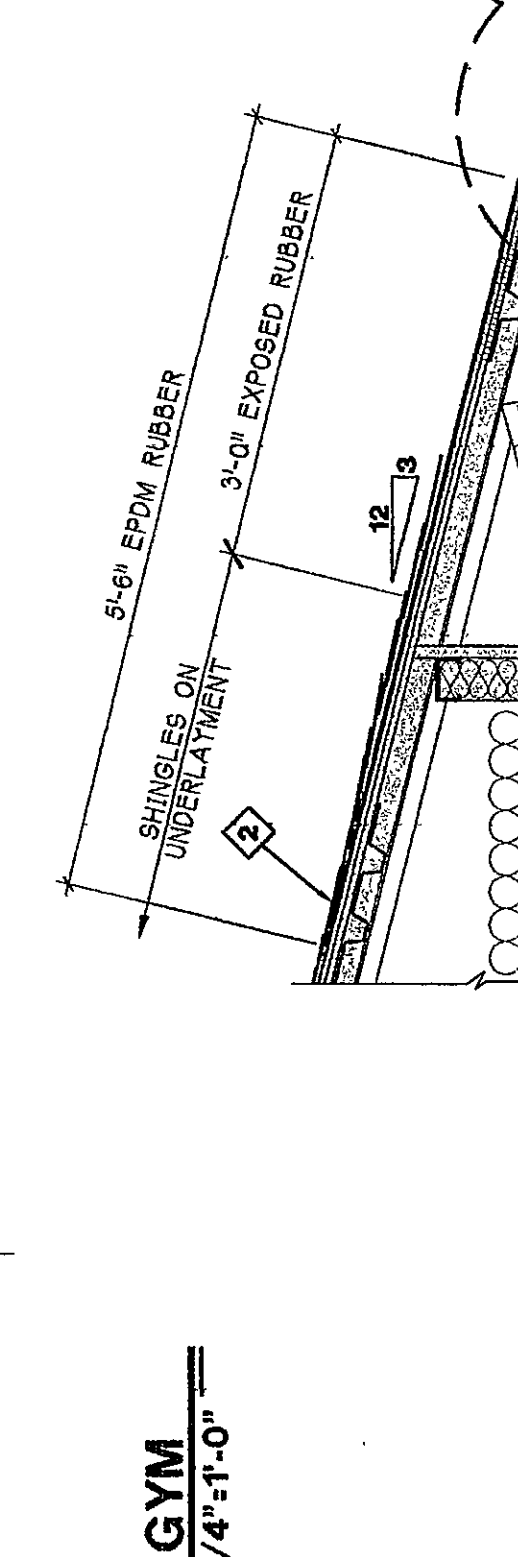



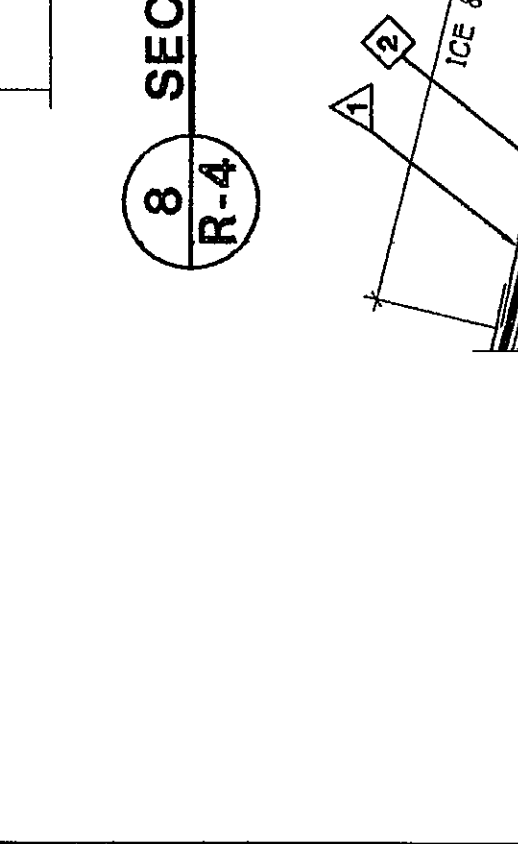







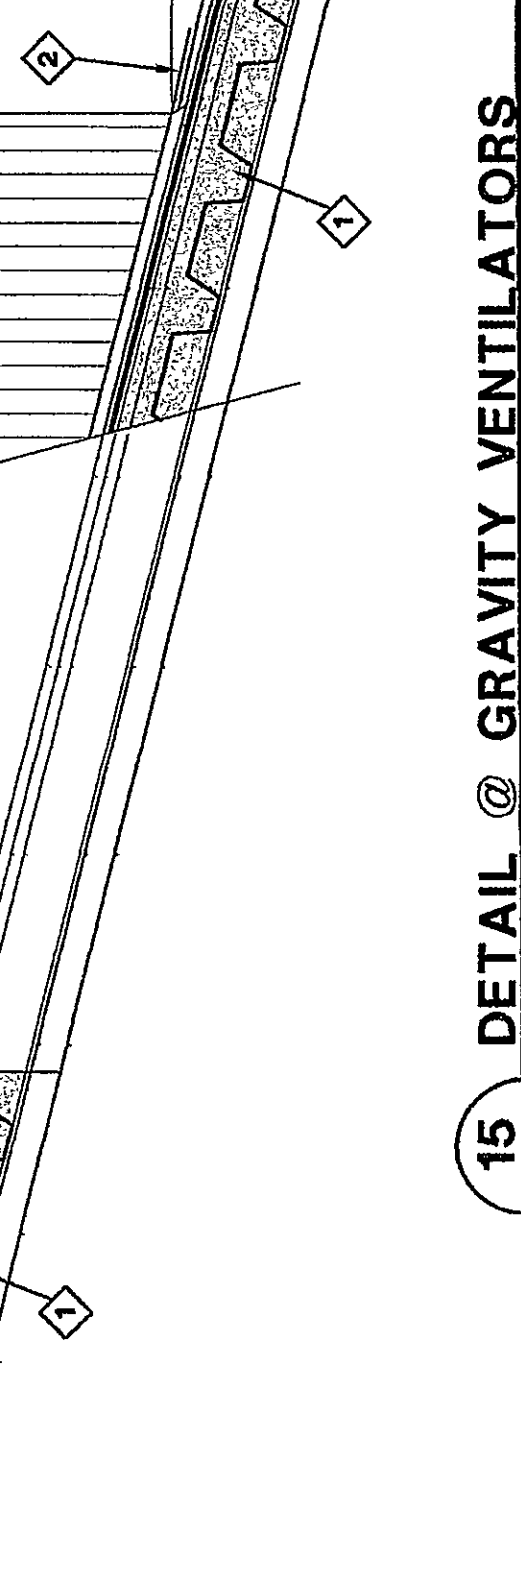


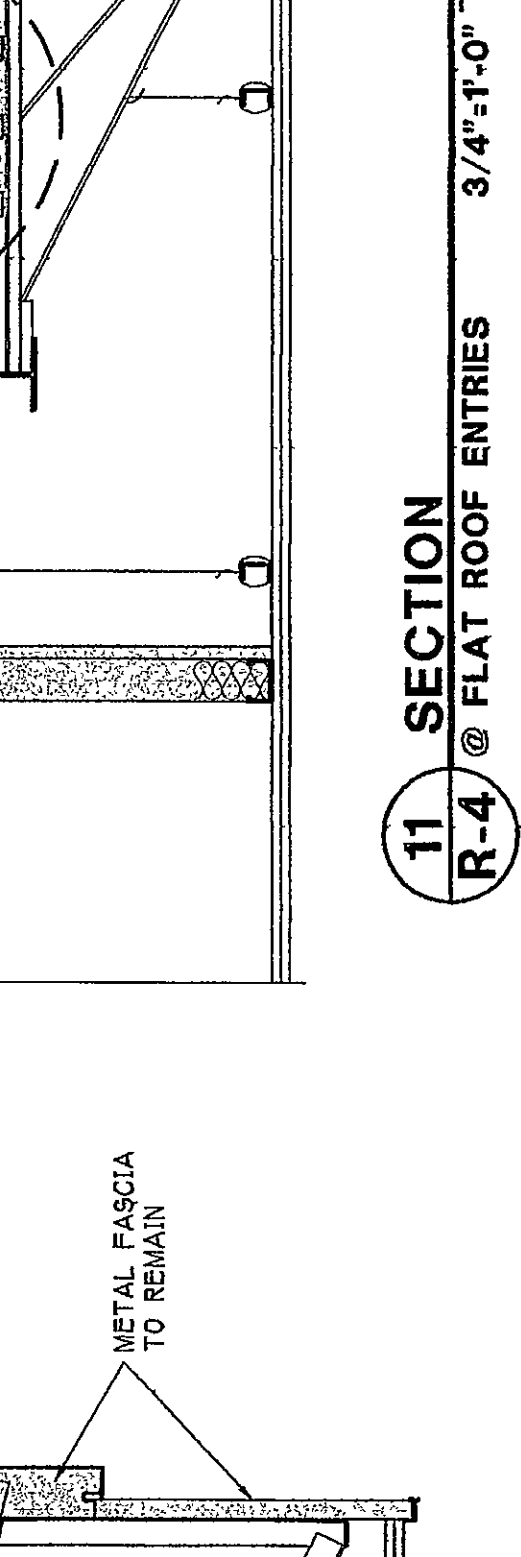


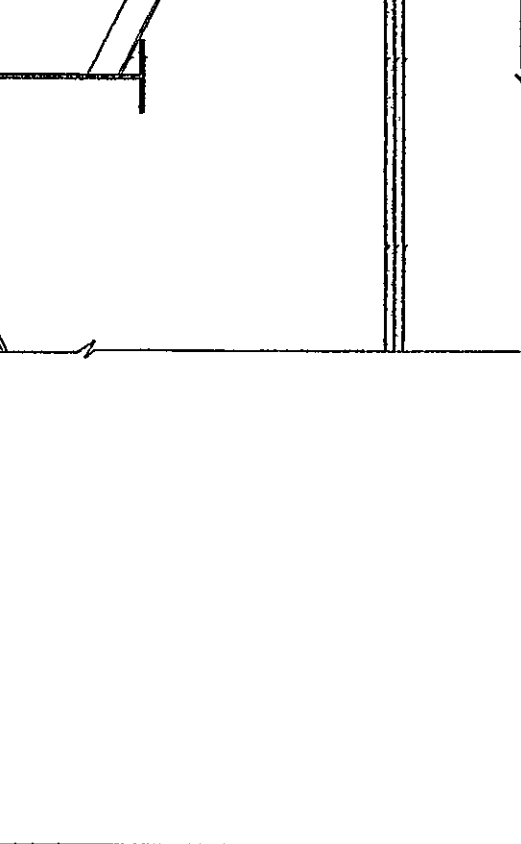



SPECIFIC DEMOLITION NOTES


- 1 REMOVE EXISTING SHINGLES, FELTS AND RUBBER FLASHING DOWN TO PLYWOOD DECK, INCLUDING FASTENERS.
- 2 REMOVE EXISTING SHEET METAL, COPING FLASHING OR INSULATION AS NOTED.
- 3 REMOVE EXISTING RUBBER ROOFING DOWN TO PLYWOOD DECK.
- 4 REMOVE EXISTING NEUMANE ROOFING & STONE BALLAST. INSULATION TO REMAIN.
- 5 REMOVE EXISTING PASCIA CAP PIECE ONLY. IT SHALL BE SALVAGED AND REUSED.
- 6 REMOVE EXISTING MANSARD ROOFING, INSULATION AND STONE BALLAST DOWN TO STEEL DECK.

SPECIFIC REROOFING NOTES


- 1 EXISTING 1/2" TYP. PLYWOOD SHEATHING AND 3/4" TYP. INSULATION TO REMAIN.
- 2 NEW 60 YEAR SHINGLES ON SYNTHETIC UNDERLAYMENT (SPEC. SECTION 07500) HAND-SEAL AT MANSARD.
- 3 NEW 1/2" WIDE 60 MIL EPDM RUBBER ADHERED TO PLYWOOD TYPICAL AT VALLEYS.
- 4 NEW 1/2" WIDE ICE & WATER SHIELD AT TOP EDGE AND BASE OF MANSARD ROOF (AS DETAILED) UP TO 2 FT. AND OUT 2 FT.
- 5 NEW CONT. 24 GA. PREFINISHED METAL DRIP EDGE AT TOP EDGE OF MANSARD ROOF.
- 6 NEW 5'-6" WIDE 'ICE & WATER' SHIELD AT EAVES (TYPICAL).
- 7 NEW 24 GA. PREFINISHED METAL FLASHING AT BASE OF MANSARD ROOF. (12" VERTICAL LEG & 6" HORIZONTAL).
- 8 REMOVE COPPER FLASHING AT MASONRY CHIMNEY WALLS. INSTALL NEW COPPER FLASHING W/ NEW ROOFING.
- 9 NEW .030 EPDM RUBBER ROOFING, ADHERED DIRECTLY TO NEW MECHANICALLY ATTACHED 1/2" RECOVERY BOARD OVER EXISTING INSULATION.
- 10 RE-INSTALL .030 ALUM. DRIP CAP OVER EXISTING METAL PASCIA PANELS. SALVAGE EXISTING PASCIA PANELS.
- 11 NEW PREFINISHED .030 EPDM RUBBER FLASHING ADHERED TO NEW ROOFING. REMOVE EXISTING FLASHING AT INSIDE FACE OF HIGH MANSARD ROOF.
- 12 NEW 'COBBAN' RIDGE VENT COVERED W/ SHINGLES.
- 13 NEW 5'-0" WIDE 'ICE & WATER' SHIELD BELOW HIPS & RIDGE AND AROUND CHIMNEY VENTS.
- 14 NEW 24 GA. PREFIN. METAL COPING CAP AT HIGH MANSARDS.
- 15 NEW 2 FT. WIDE X 24 GA. PREFIN. VALLEY METAL. SEE DETAIL 13/R-4.
- 16 ADD 1/4" PER FT. TAPERED INSULATION SLOPE TO ROOF DRAIN AT EACH END OF THE FOUR (4) ENTRY CANOPIES.

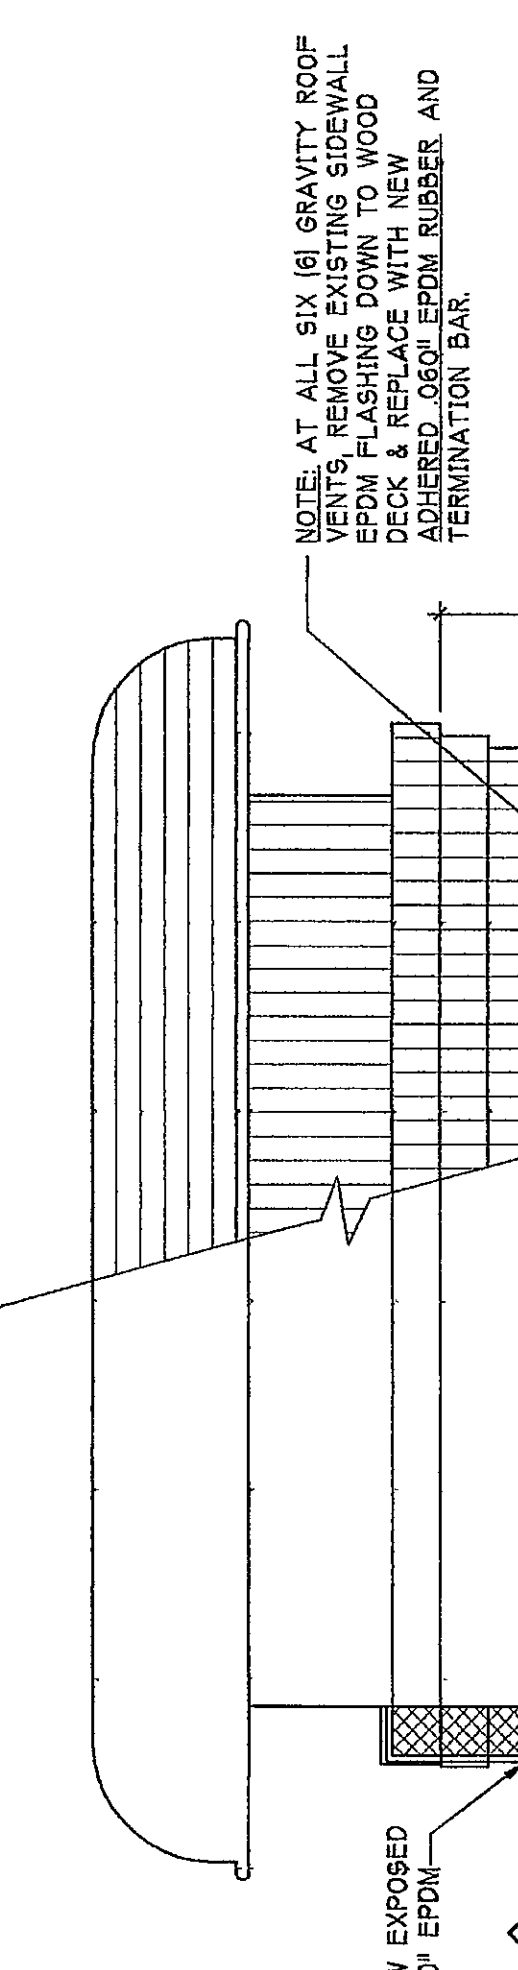

15 DETAIL @ GRAVITY VENTILATORS
R-4 1 1/2'-1'-0"

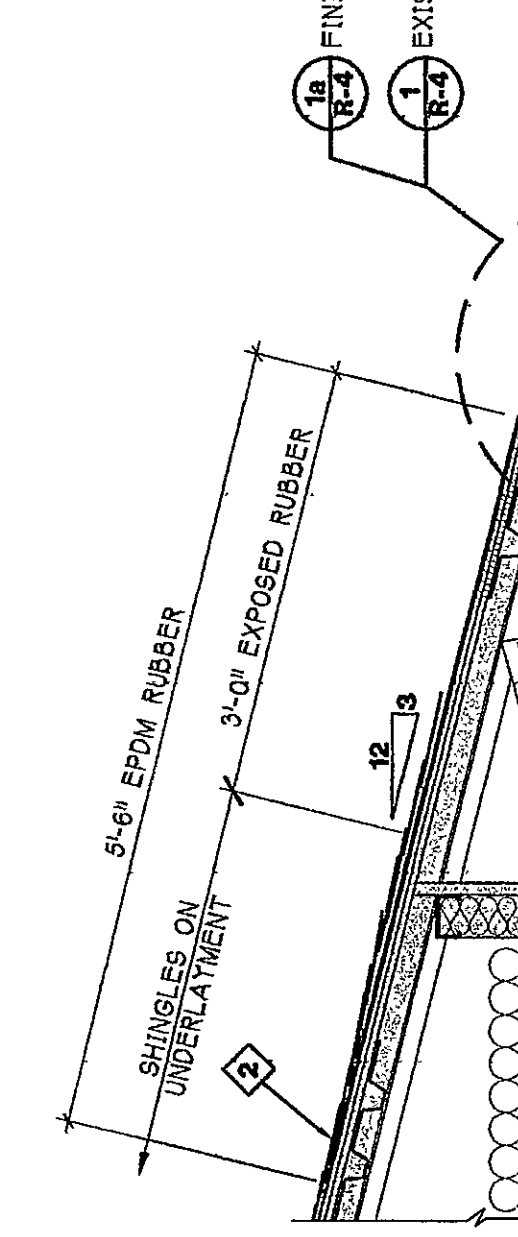

11 SECTION
R-4 @ FLAT ROOF ENTRIES 3/4'-1'-0"

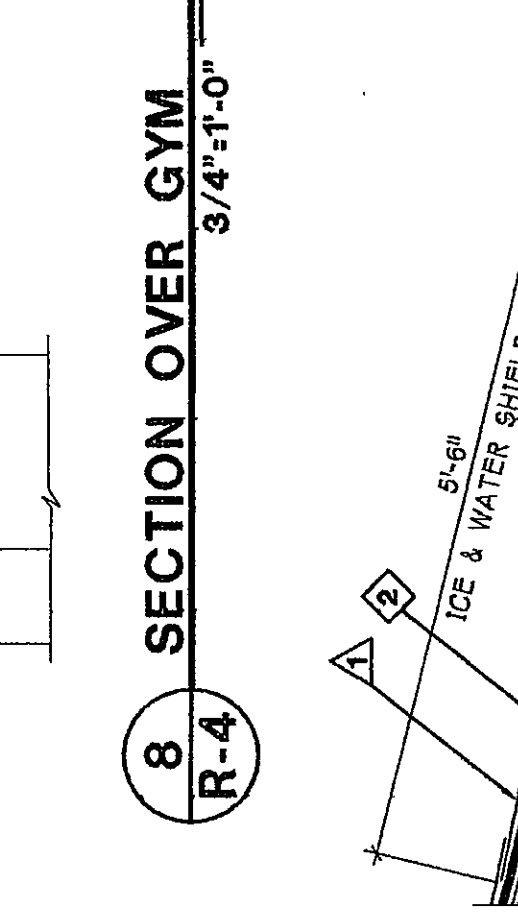

9 TYPICAL SECTION
R-4 @ EAVES 3/4'-1'-0"