


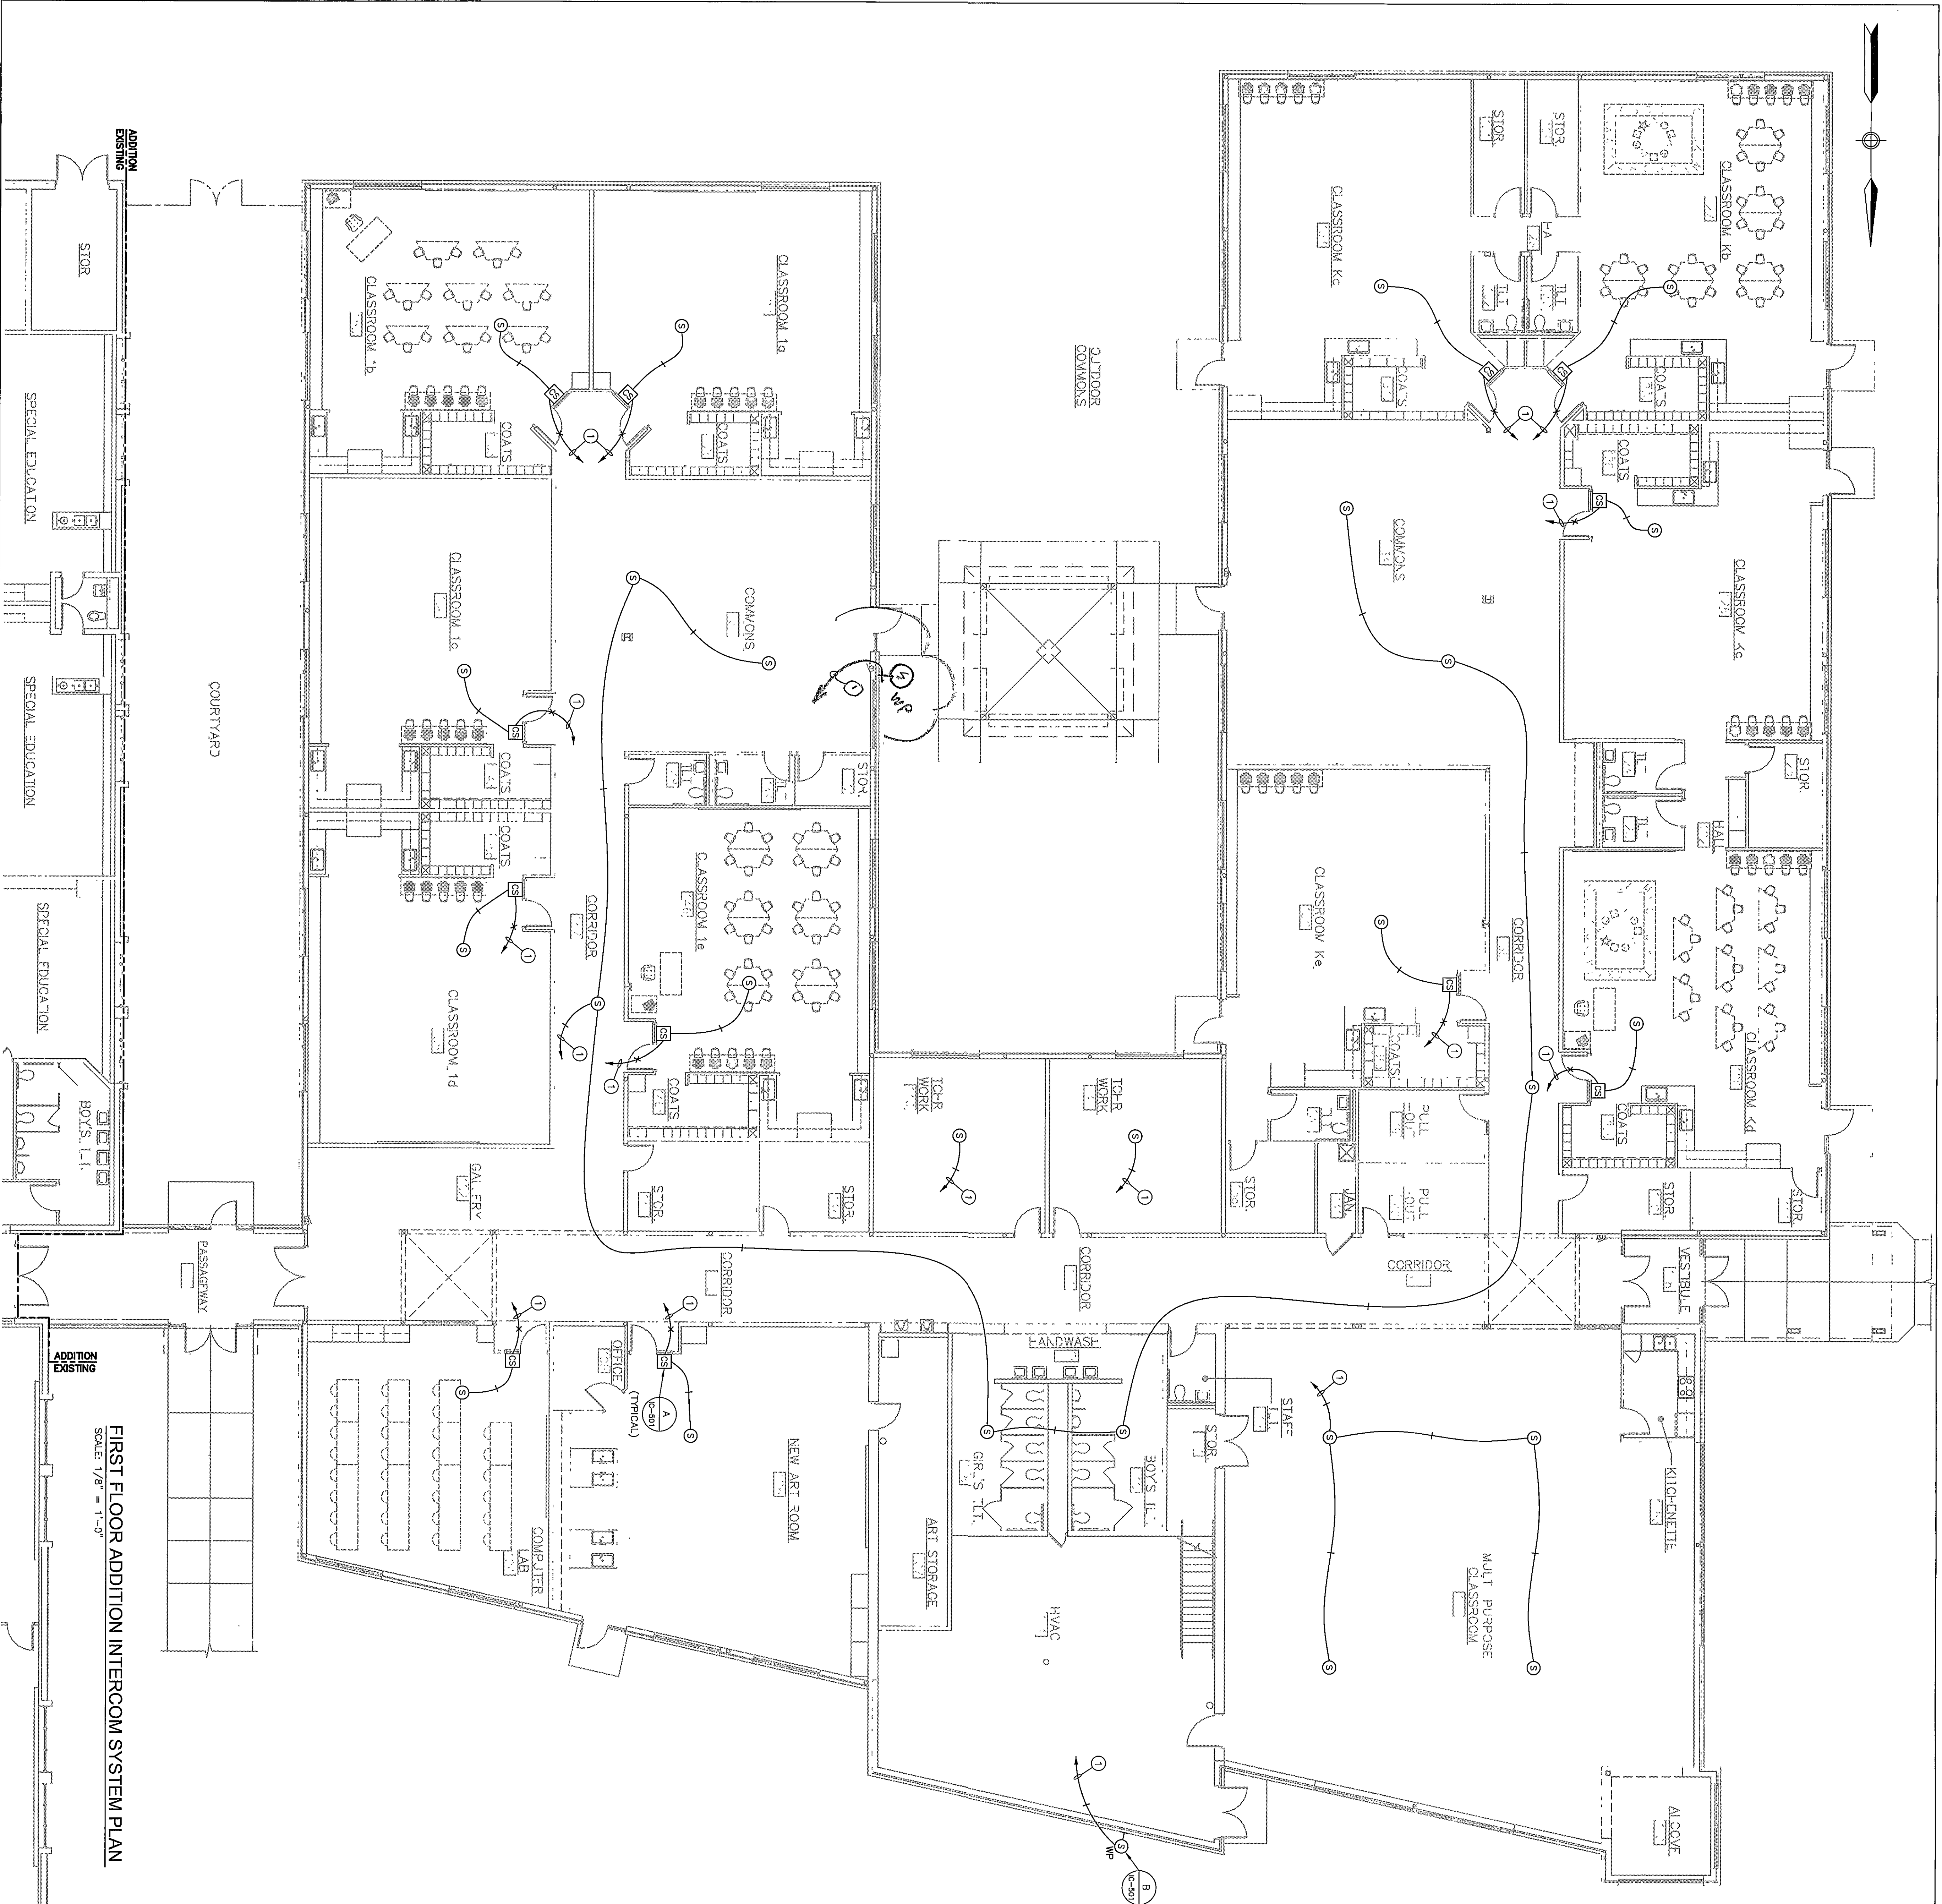

INTERCOM SYMBOL LEGEND					QUANTITY
SYMBOL	DESCRIPTION	MFG/MODEL	ROUGH-IN	IC-111	
Ⓢ	CEILING MOUNTED SPEAKER	BOSSEN S861/251/28W	BOSSEN REAR BACK CAN W/35 TIE BRIDGE		26
Ⓢ _{WP}	OUTDOOR PAGING HORN	BOSSEN SPT8A	W/ONE GANG RING		1
CS	CALL-IN SWITCH	BOSSEN CA150	4" SQUARE BOX W/ONE GANG RING		12

INTERCOM WIRE SCHEDULE	
SYMBOL	DESCRIPTION
22 AWG 2	CONDUCTOR SHIELDED W/252918
22 AWG 3	CONDUCTOR SHIELDED W/253528

- GENERAL NOTES:
1. THESE DRAWINGS DO NOT REPRESENT ACTUAL WIRE ROUTES, BUT INSTEAD ARE INTENDED TO ILLUSTRATE EACH CIRCUIT'S POINT-TO-POINT WIRING.
 2. TAP ALL CEILING SPEAKERS AT 5 WATTS, UNLESS NOTED OTHERWISE.
 3. TAP ALL HORNS AT 1 WATT, UNLESS NOTED OTHERWISE.

- PLAN NOTES:
- ① TO EXISTING INTERCOM RACK.

REVISIONS:	
01/20/2010	DRAWING SUBMITTALS

LIBERTY ELEMENTARY SCHOOL
50-1 W. COUNTY ROAD 900 N.
CHESTERTON, INDIANA

FIRST FLOOR ADDITION
INTERCOM SYSTEM PLAN

PROJECT NAME:

DRAWING TITLE:

DATE: 01/08/2010
DESIGN BY: TLA
CHECKED BY: SWA

PROJECT NO.: 91358

IC-111

10-FR-04