


LIBERTY ELEMENTARY SCHOOL
50-1 W. COUNTY ROAD 900 N.
CHESTERTON, INDIANA

FAIRCHILD
COMMUNICATION SYSTEMS
3185 N. Shadeland Avenue
Indianapolis, IN 46206
Tel: 317-576-5115
Fax: 317-576-5014

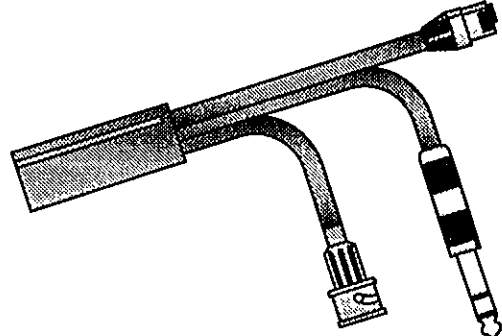

<u>OWNER</u>	<u>ARCHITECT / ENGINEER</u>	<u>ELECTRICAL CONTRACTOR</u>	<u>SYSTEMS SUB CONTRACTOR</u>
DUNELAND SCHOOL CORPORATION 691 W. MORGAN AVENUE CHESTERTON, INDIANA 46304 TEL: (219) 983-3600	GEROMETTA & KINEL ARCHITECTS, INC. 1200 N. STATE ROAD 49 CHESTERTON, IN 46304 TEL: (219) 926-6655	CONTINENTAL ELECTRIC COMPANY, INC. 9501 E. FIFTH AVENUE GARY, IN 46403 TEL: (219) 938-3460 FAX: (219) 938-3469	FAIRCHILD COMMUNICATION SYSTEMS, INC. 3185 N. SHADELAND AVENUE INDIANAPOLIS, IN 46226 TEL: (317) 576-9115 FAX: (317) 576-9014

BY APPROVED AS NOTED 1
DATE 11/15/10
BY K. Connelley

FIRE ALARM SYSTEM		INTERCOM SYSTEM	
FA-111	FIRST FLOOR ADDITION FIRE ALARM SYSTEM PLAN	IC-111	FIRST FLOOR ADDITION INTERCOM SYSTEM PLAN
FA-121	FIRST FLOOR ADDITION FIRE ALARM SYSTEM PLAN	IC-501	INTERCOM SYSTEM DETAILS
FA-501	FIRE ALARM SYSTEM DETAILS		

REVIEWED
REVISIONS
CORRECTED
DATE 11/15/10
BY K. Connelley

LIBERTY ELEMENTARY SCHOOL
50-1 W. COUNTY ROAD 900 N.
CHESTERTON, INDIANA